
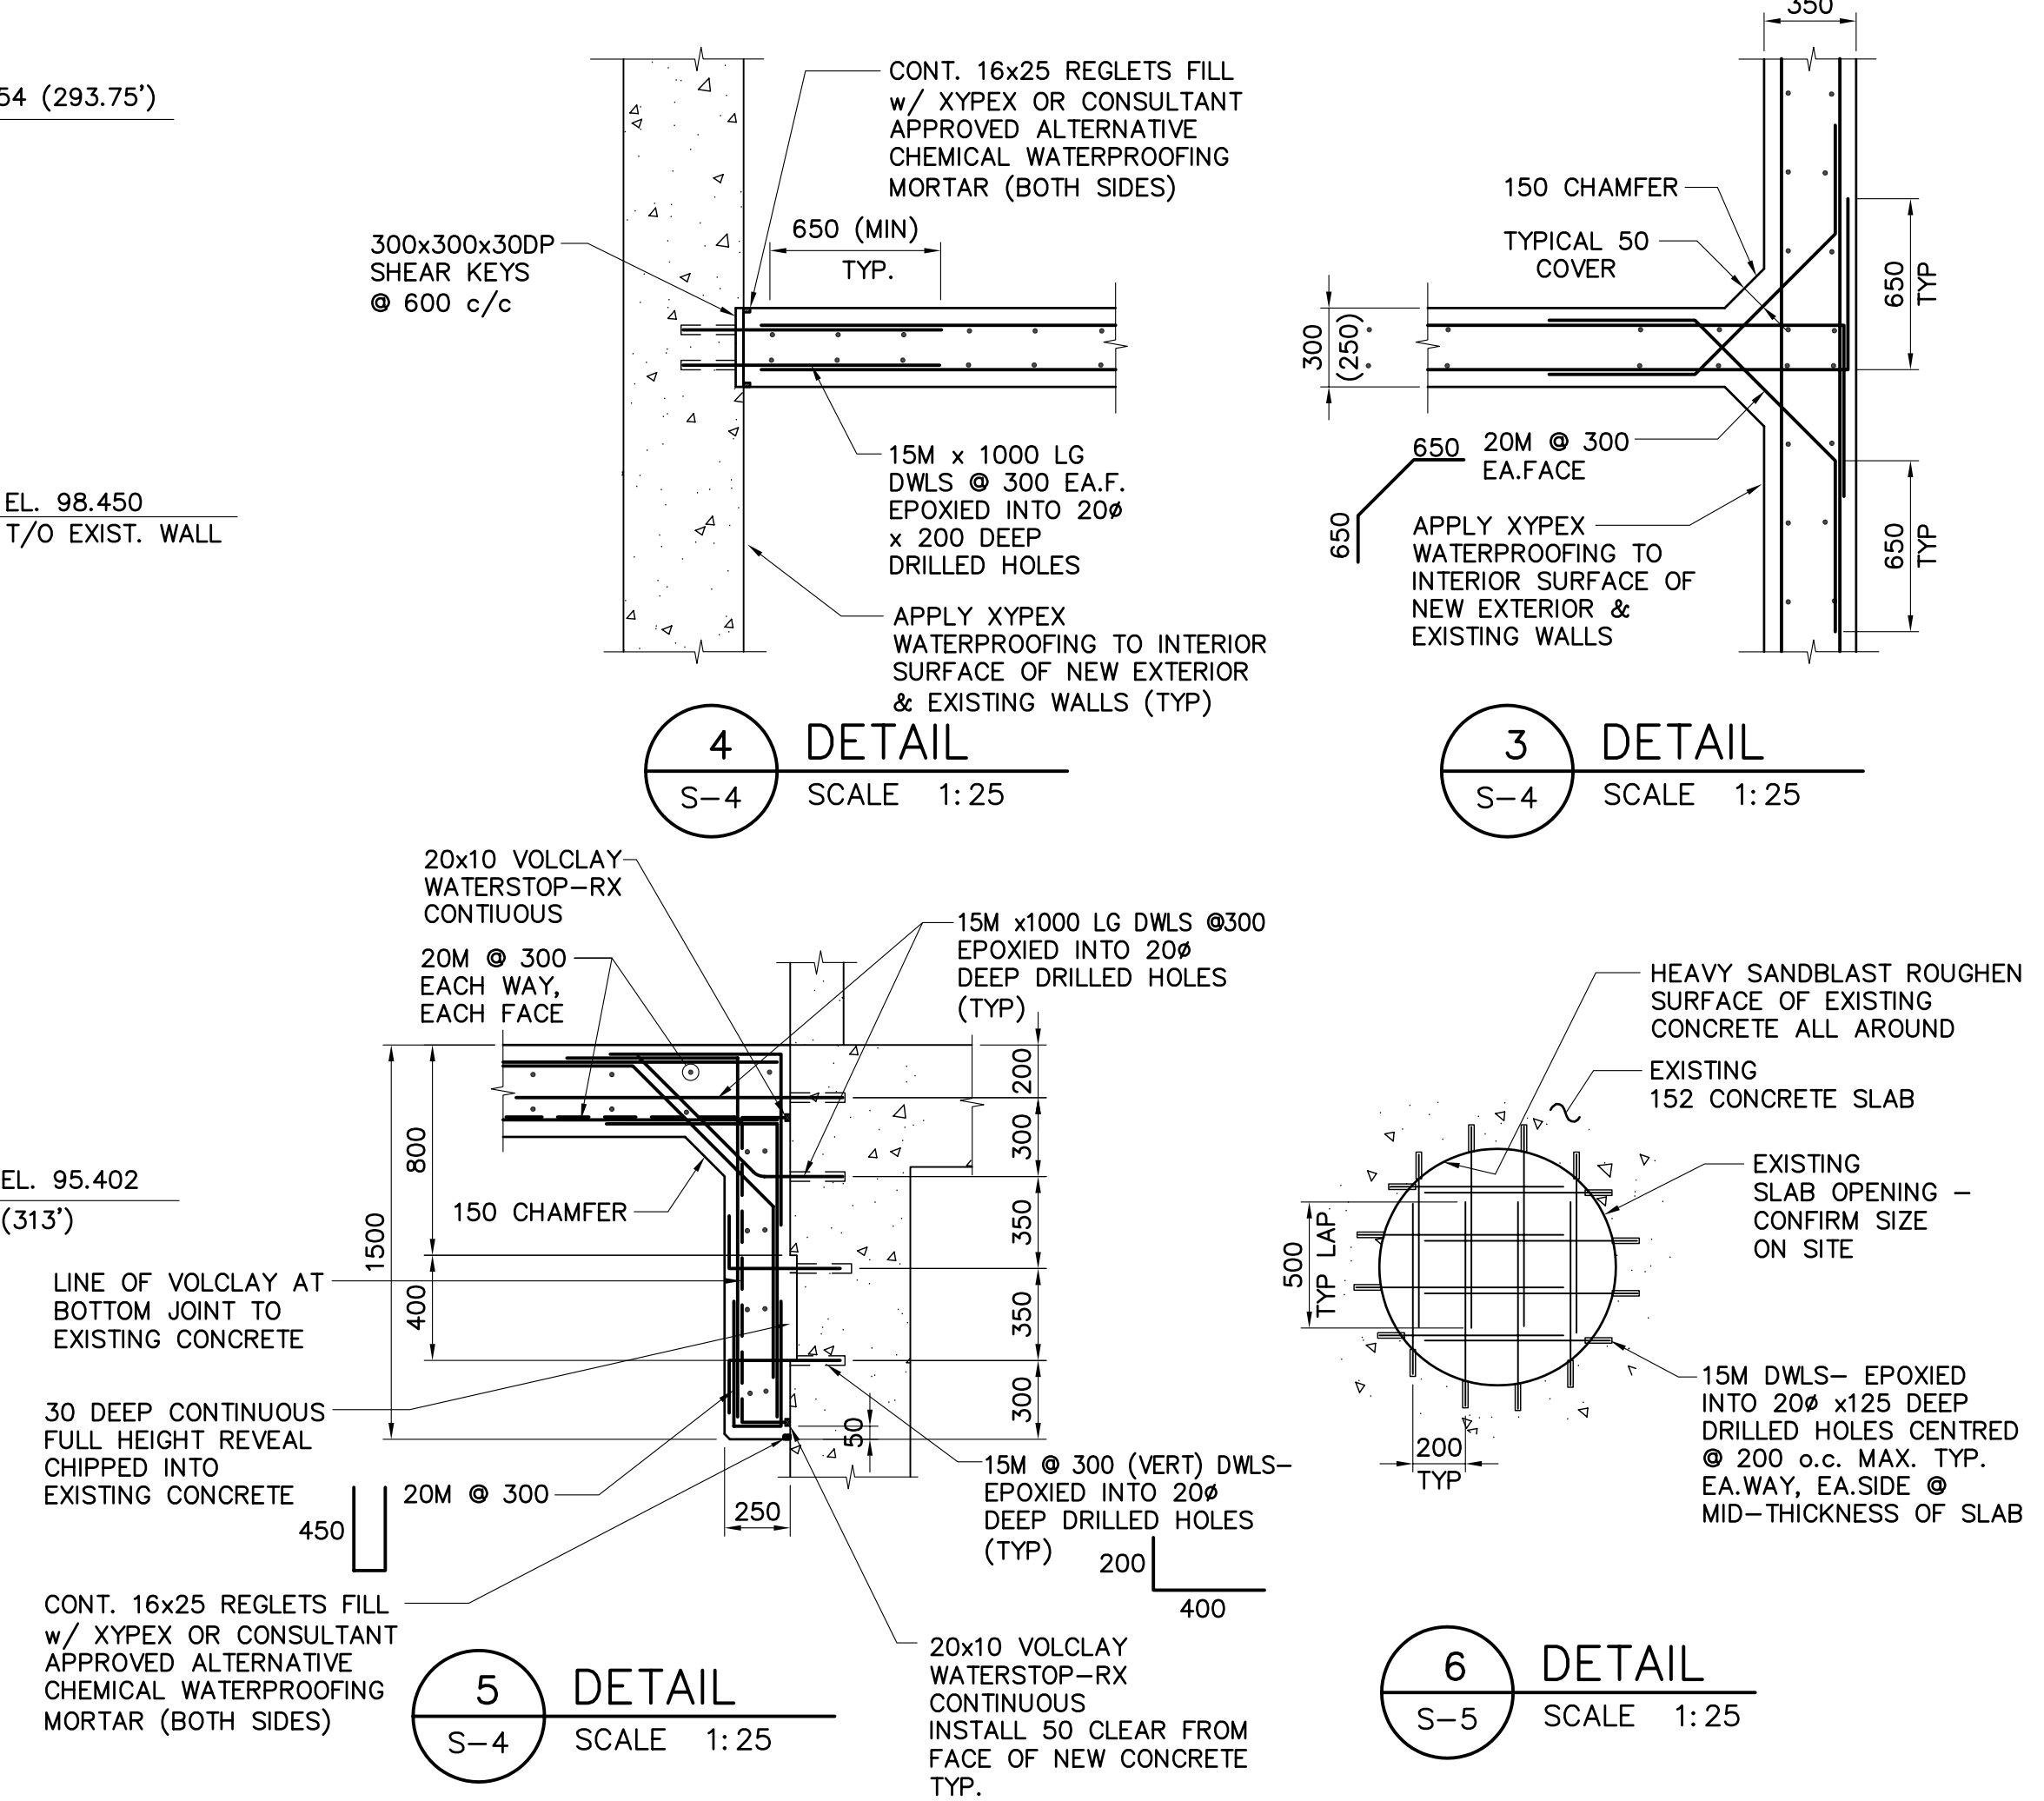
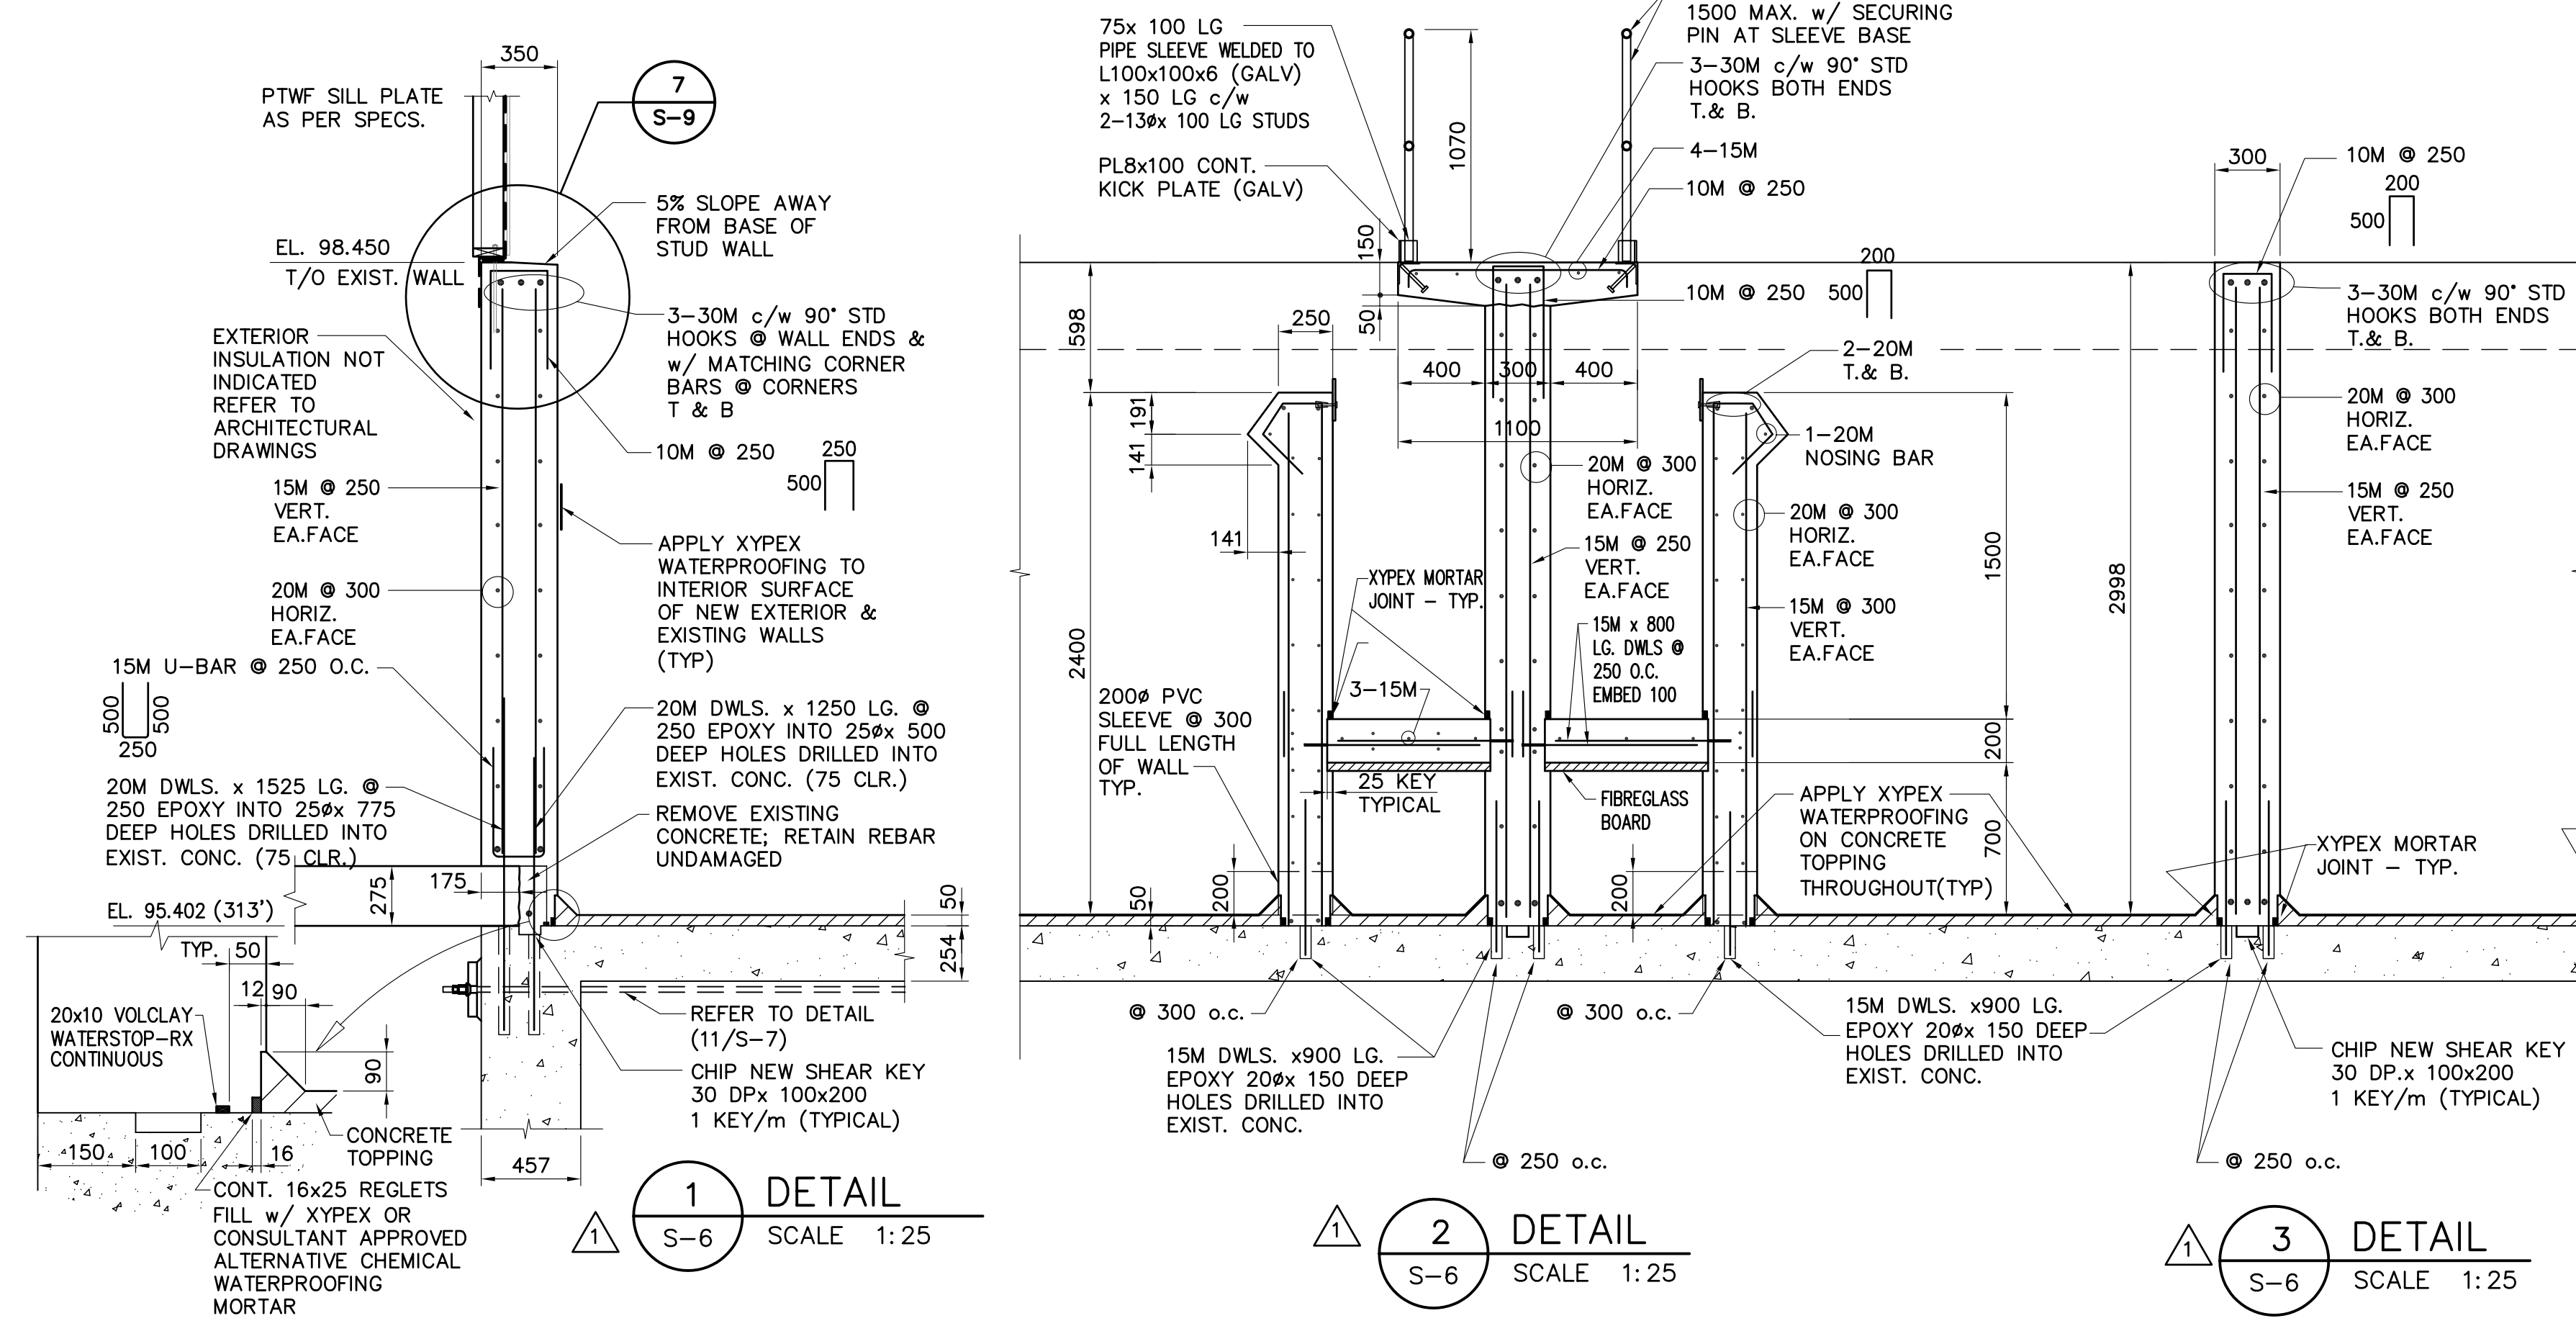
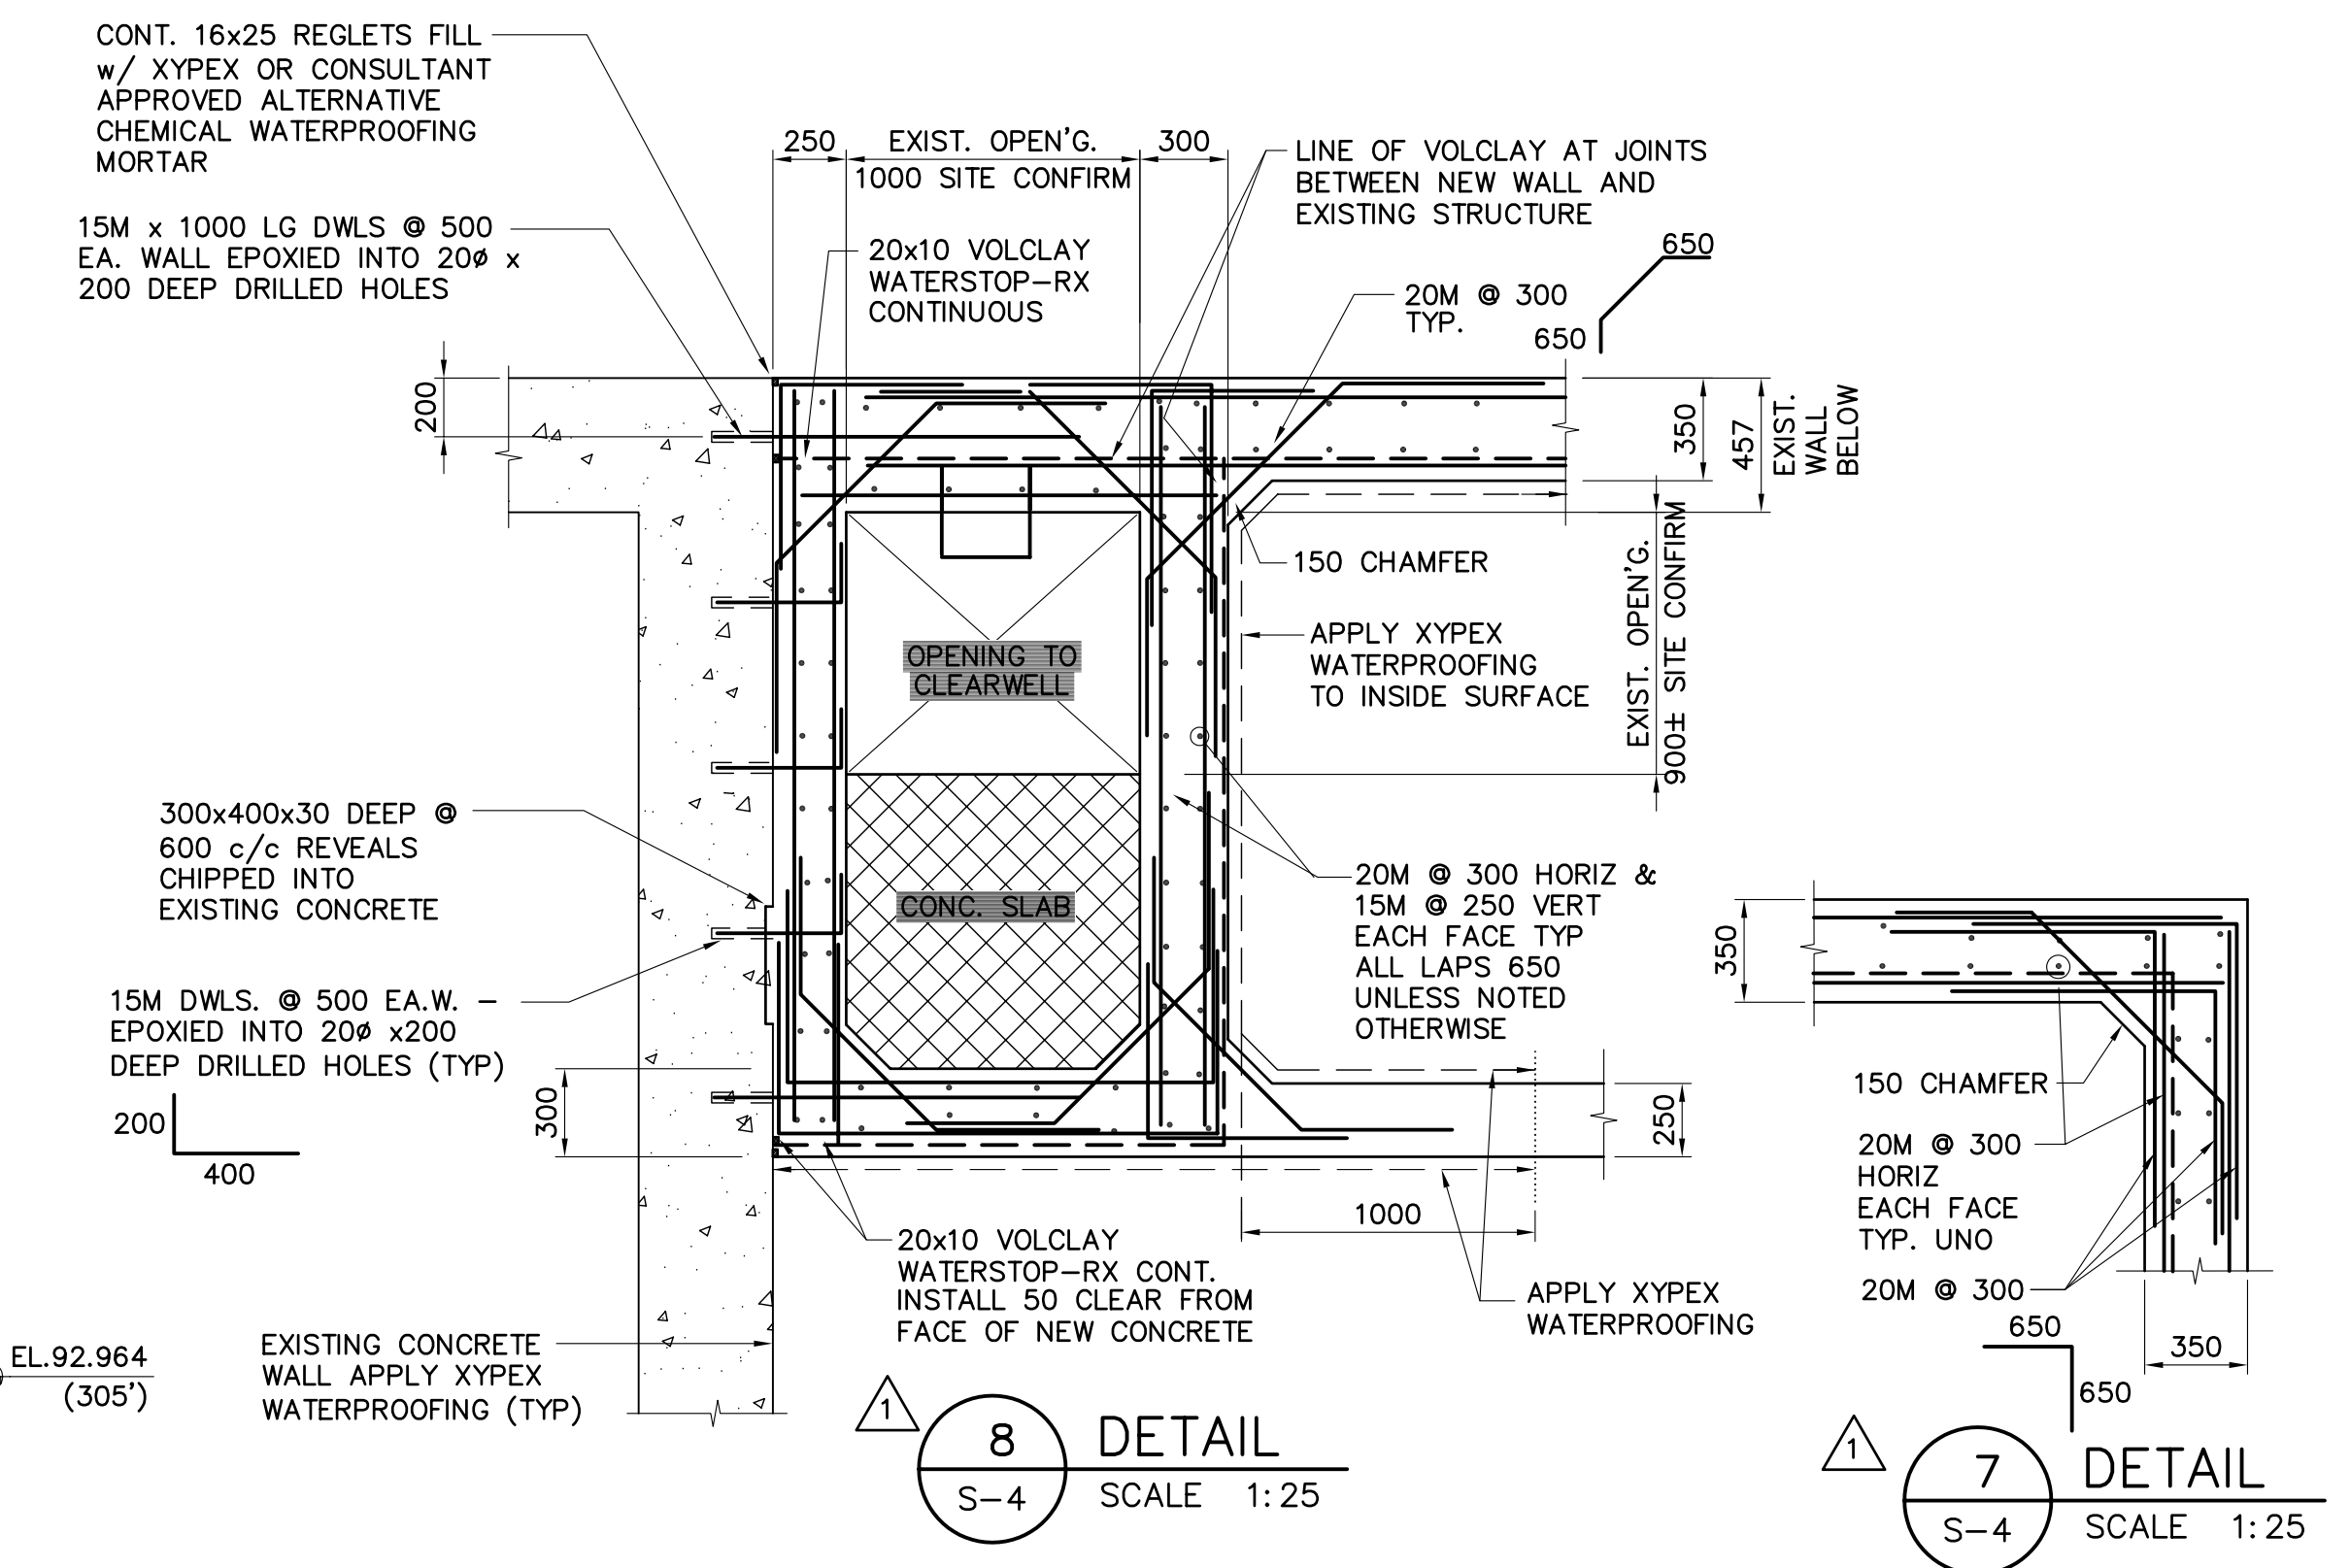


ET:55524/Cadd File: 55524-506 to S07.dwg/Last Edit: 2003-04-22 (12:00)/Plot Scale: 1:1 (A1)

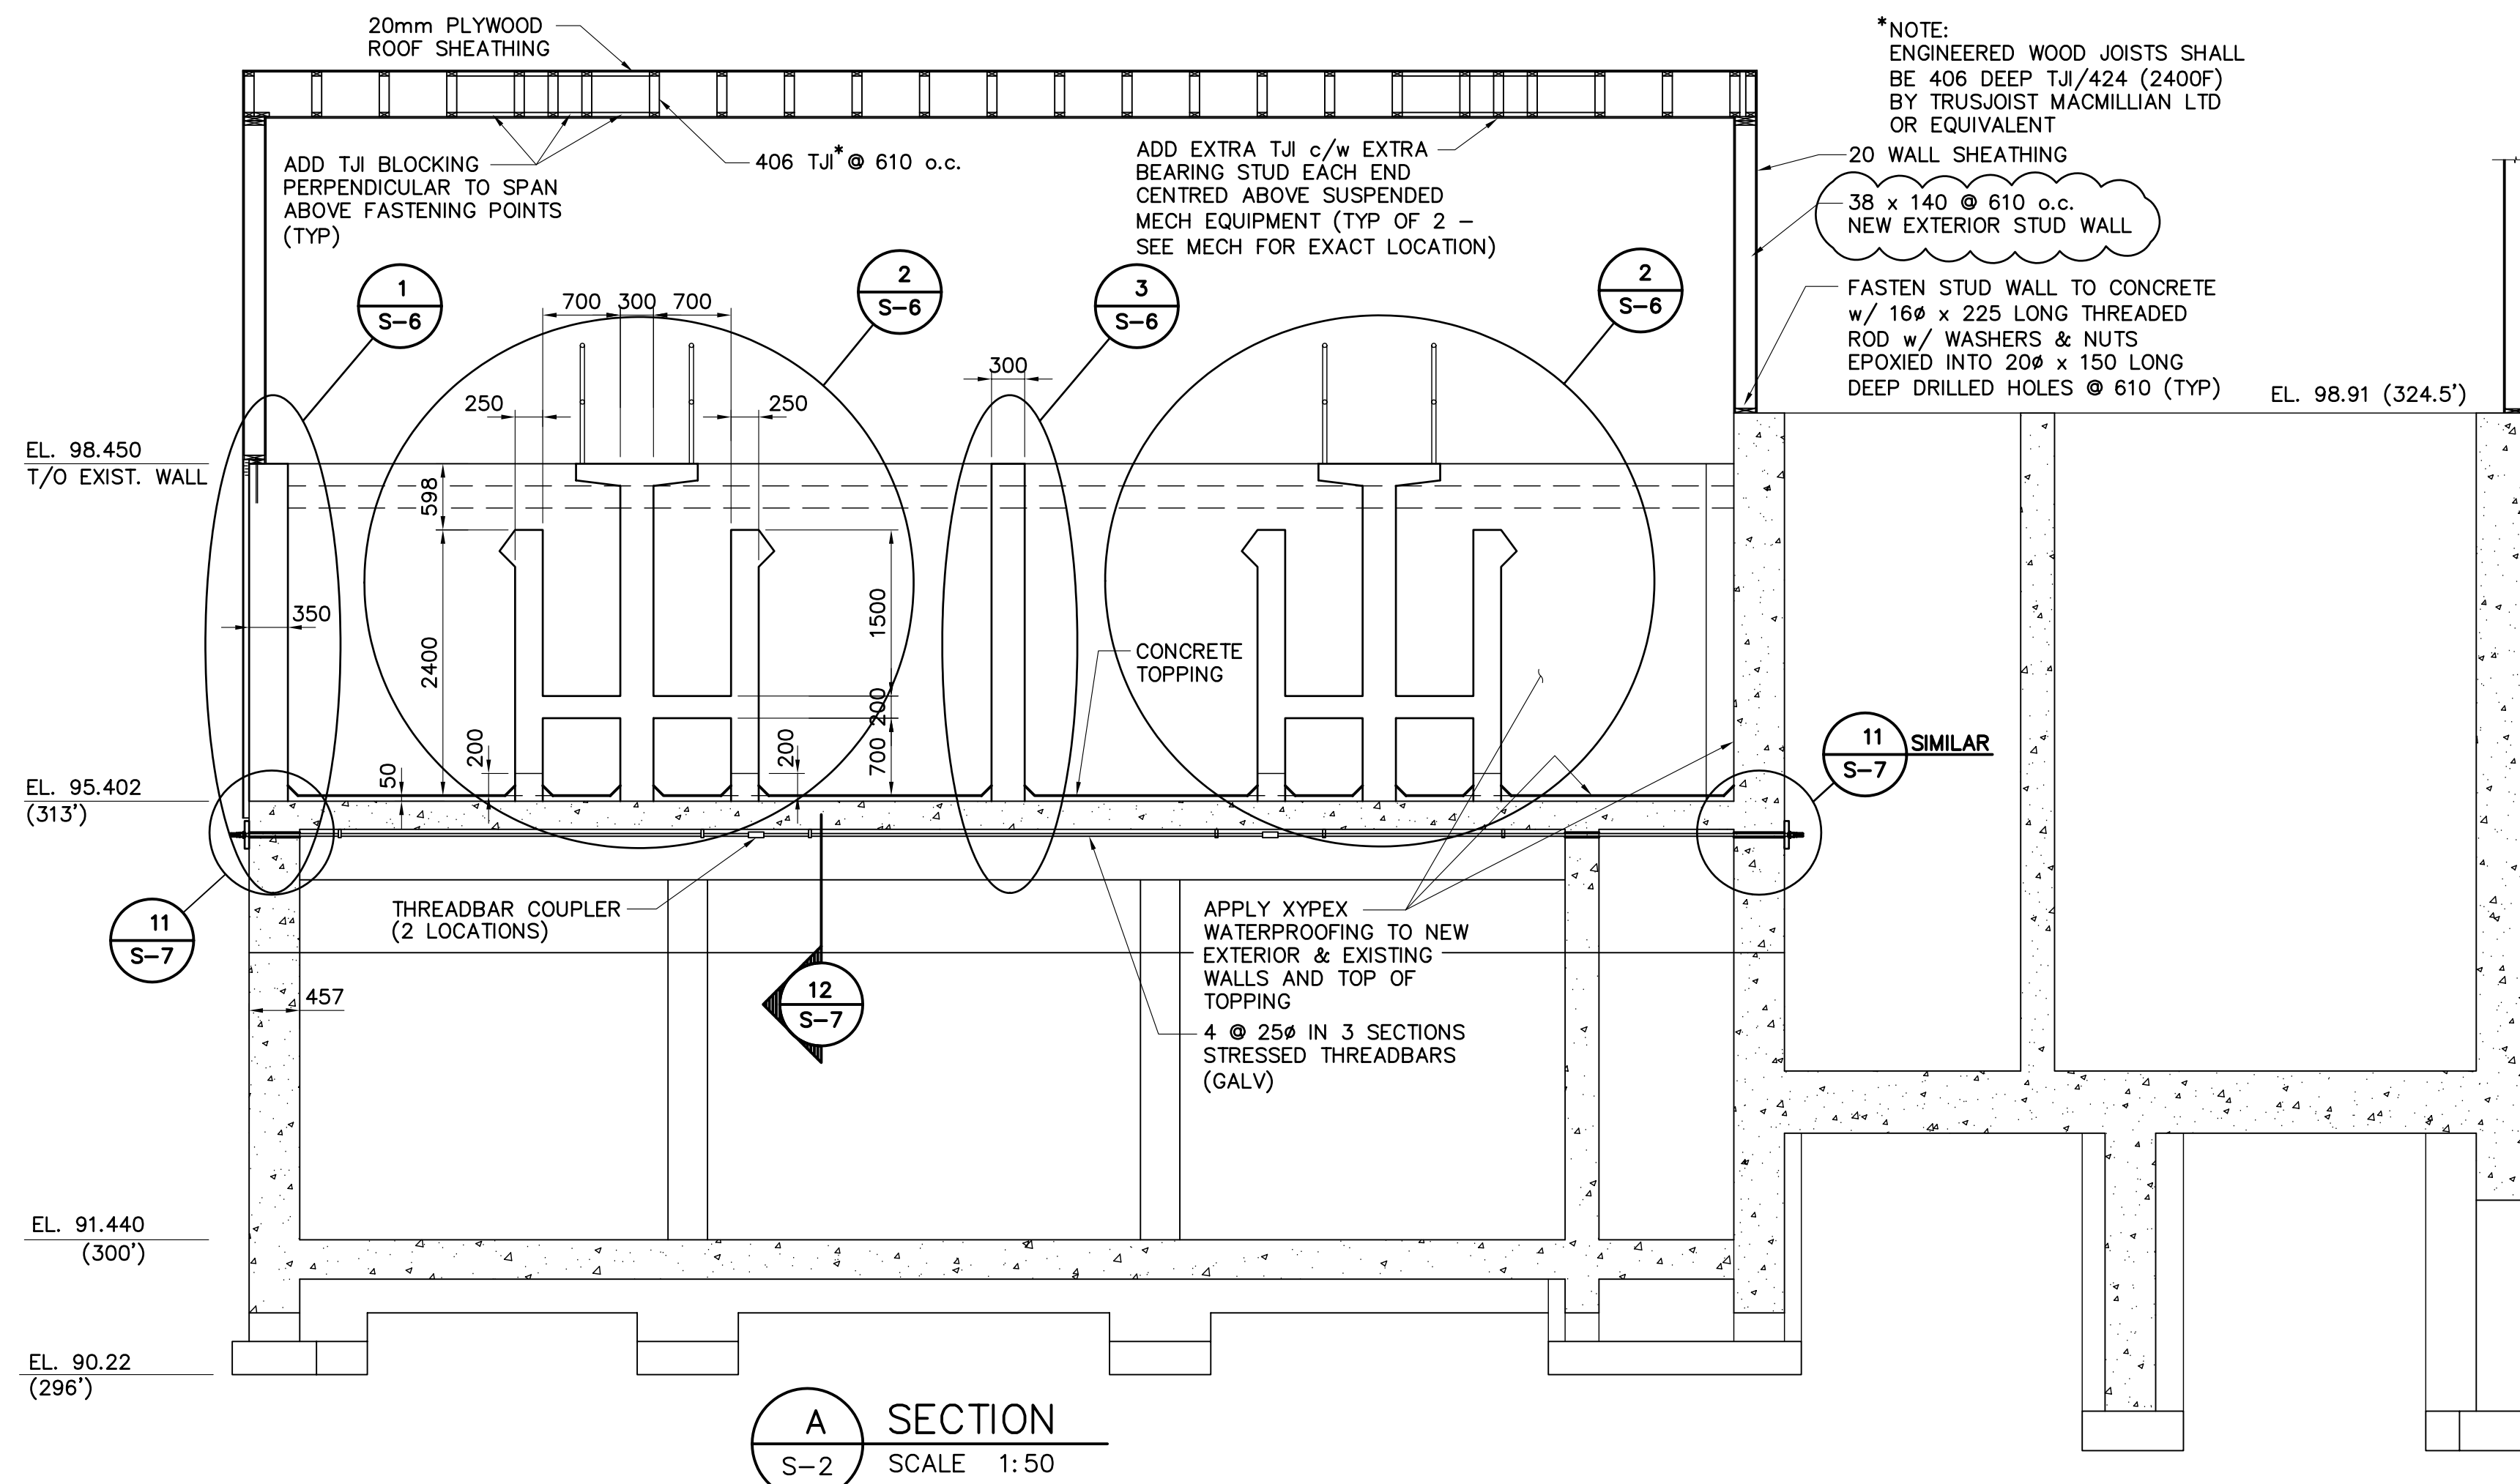

NO.	REVISION	DATE	INITIAL
2	RECORD DRAWING	23/04/04	
1	ISSUED FOR CONSTRUCTION	22/04/03	
0	ISSUED FOR TENDER	19/02/03	
A	ISSUED FOR FINAL REVIEW	03/02/03	

Company Permit	Engineer Seal
RECORD DRAWING	INFORMATION CONTAINED IN THESE DRAWINGS IS AS SUPPLIED BY: NINETY NORTH CONSTRUCTION & DEVELOPMENT LTD.
	THE COMPLETENESS AND ACCURACY OF THIS RECORD DRAWING IS NOT GUARANTEED. INFORMATION SHOULD BE VERIFIED AT THE ACTUAL LOCATION BEFORE USE.

STRUCTURAL
SECTIONS AND DETAILS



CITY OF IQALUIT
IQALUIT WATER TREATMENT PLANT

E A R T H				T E C H			
Earth Tech (Canada) Inc.				Edmonton, Alta.			
DRAWN BY: BL		SCALE:		DATE:		SHEET NO.	
CHECKED BY: GJK		AS NOTED		FEB. 19, 2003			
CADD SYSTEM AutoCAD		DWG NO.		S-6		REV. 1	
						CONTRACT 55524	