
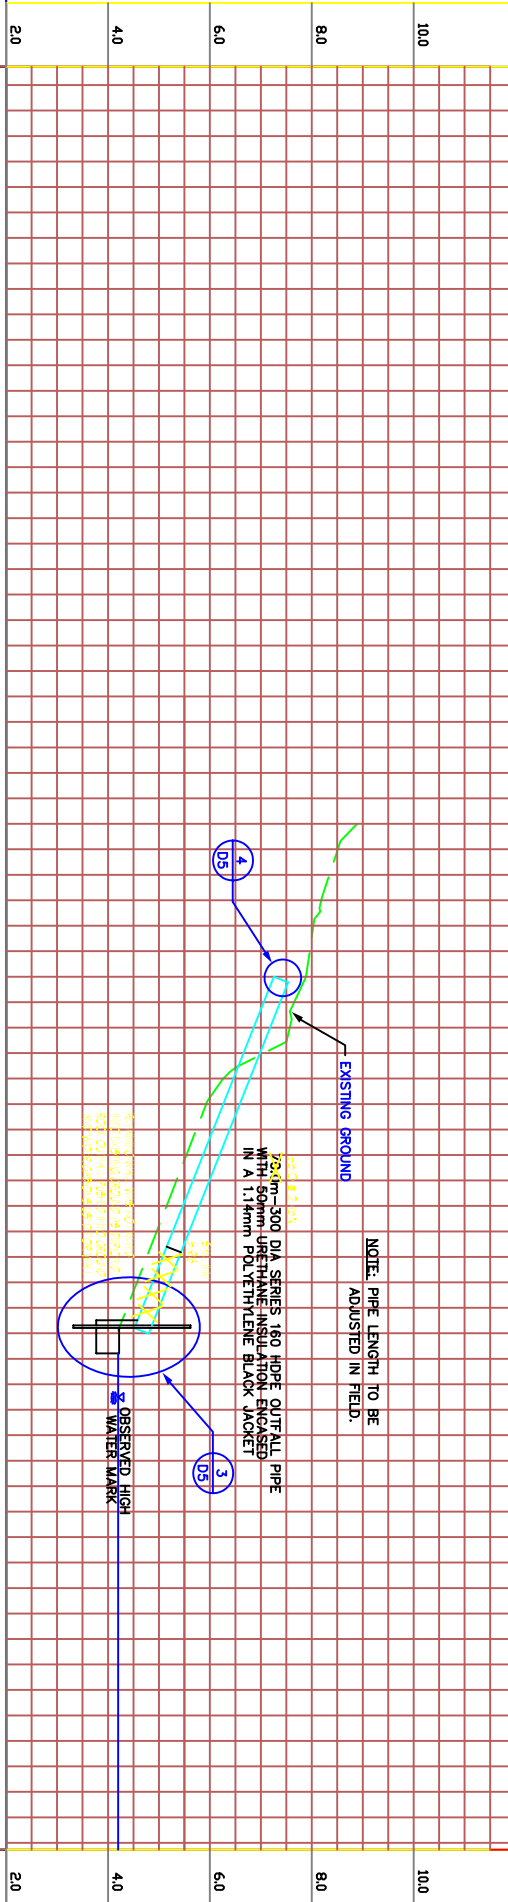


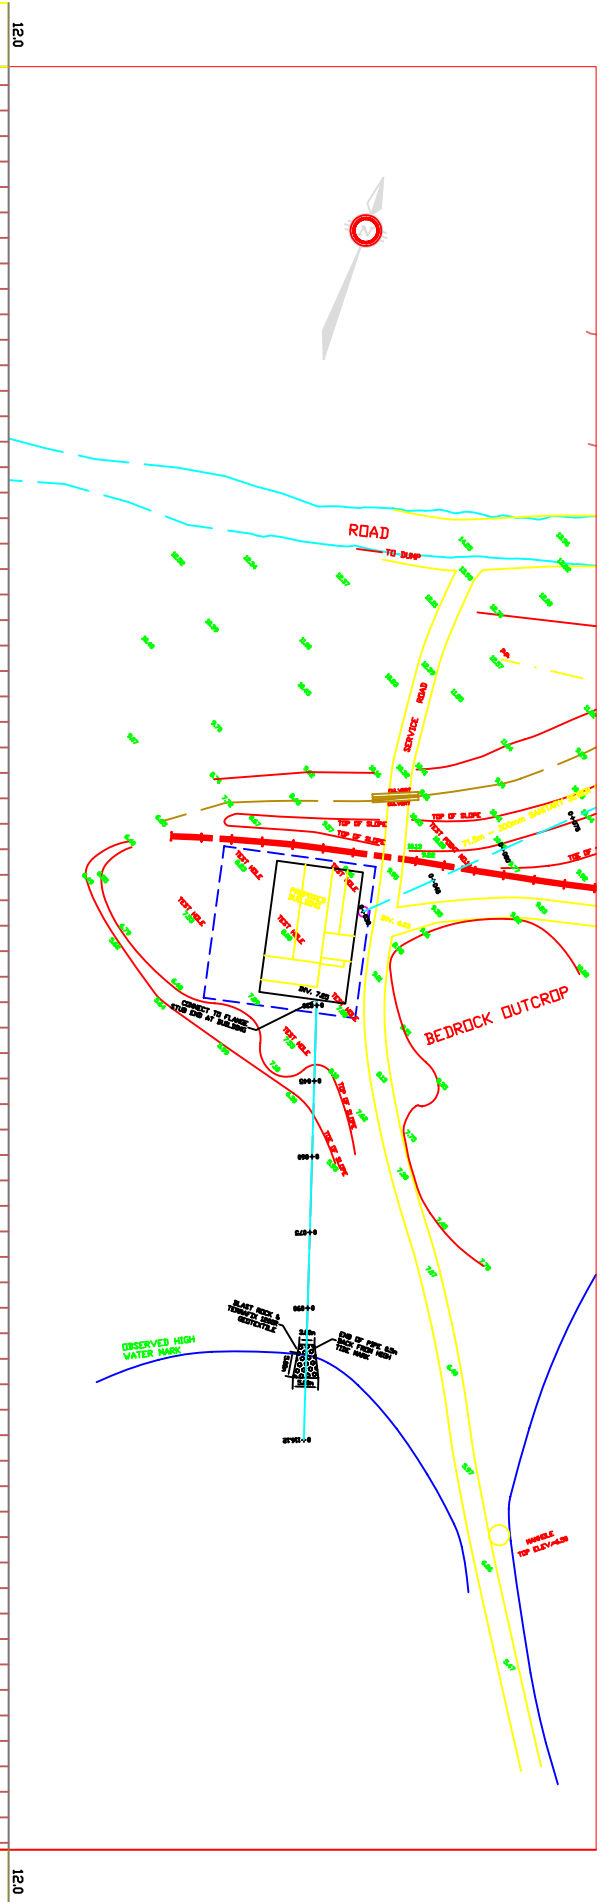

NOTE: PIPE LENGTH TO BE
ADJUSTED IN FIELD.

700mm-300 DIA SERIES 160 HDPE OUTFALL PIPE
WITH 50mm URETHANE INSULATION ENCASED
IN A 1.1mm POLYETHYLENE BLACK JACKET

EXISTING GROUND
OBSERVED HIGH
WATER MARK

STATION	EXISTING GROUND	OUTFALL INVERT
0+00	2.0	2.0
0+10	2.0	2.0
0+20	2.0	2.0
0+30	2.0	2.0
0+40	2.0	2.0
0+50	2.0	2.0
0+60	2.0	2.0
0+70	2.0	2.0
0+80	2.0	2.0
0+90	2.0	2.0
0+100	2.0	2.0

AS CONSTRUCTED
BY OMM/TROW - NOVEMBER 1999

PROJECT

QUALITY WATER RECLAMATION FACILITY

CLIENT

HILL MURRAY

DATE

NOVEMBER, 1999

SCALE

HORIZONTAL: 1:500
VERTICAL: 1:500

PROJECT NO.

MD13153A-PP2

REV.

2

DATE

NOVEMBER, 1999

SCALE

HORIZONTAL: 1:500
VERTICAL: 1:500

PROJECT NO.

MD13153A-PP2

REV.

2

PROJECT

QUALITY WATER RECLAMATION FACILITY

CLIENT

HILL MURRAY

DATE

NOVEMBER, 1999

SCALE

HORIZONTAL: 1:500
VERTICAL: 1:500

PROJECT NO.

MD13153A-PP2

REV.

2

PROJECT

QUALITY WATER RECLAMATION FACILITY

CLIENT

HILL MURRAY

DATE

NOVEMBER, 1999

SCALE

HORIZONTAL: 1:500
VERTICAL: 1:500

PROJECT NO.

MD13153A-PP2

REV.

2