


DATE: 2013-06-27  
DRAWN BY: J. B. BROWN  
CHECKED BY: J. B. BROWN  
DATE: 2013-06-27  
PROJECT: WASTE WATER TREATMENT PLANT UPGRADE PANGNIERTUNG, NU  
DRAWN BY: J. B. BROWN  
CHECKED BY: J. B. BROWN  
DATE: 2013-06-27

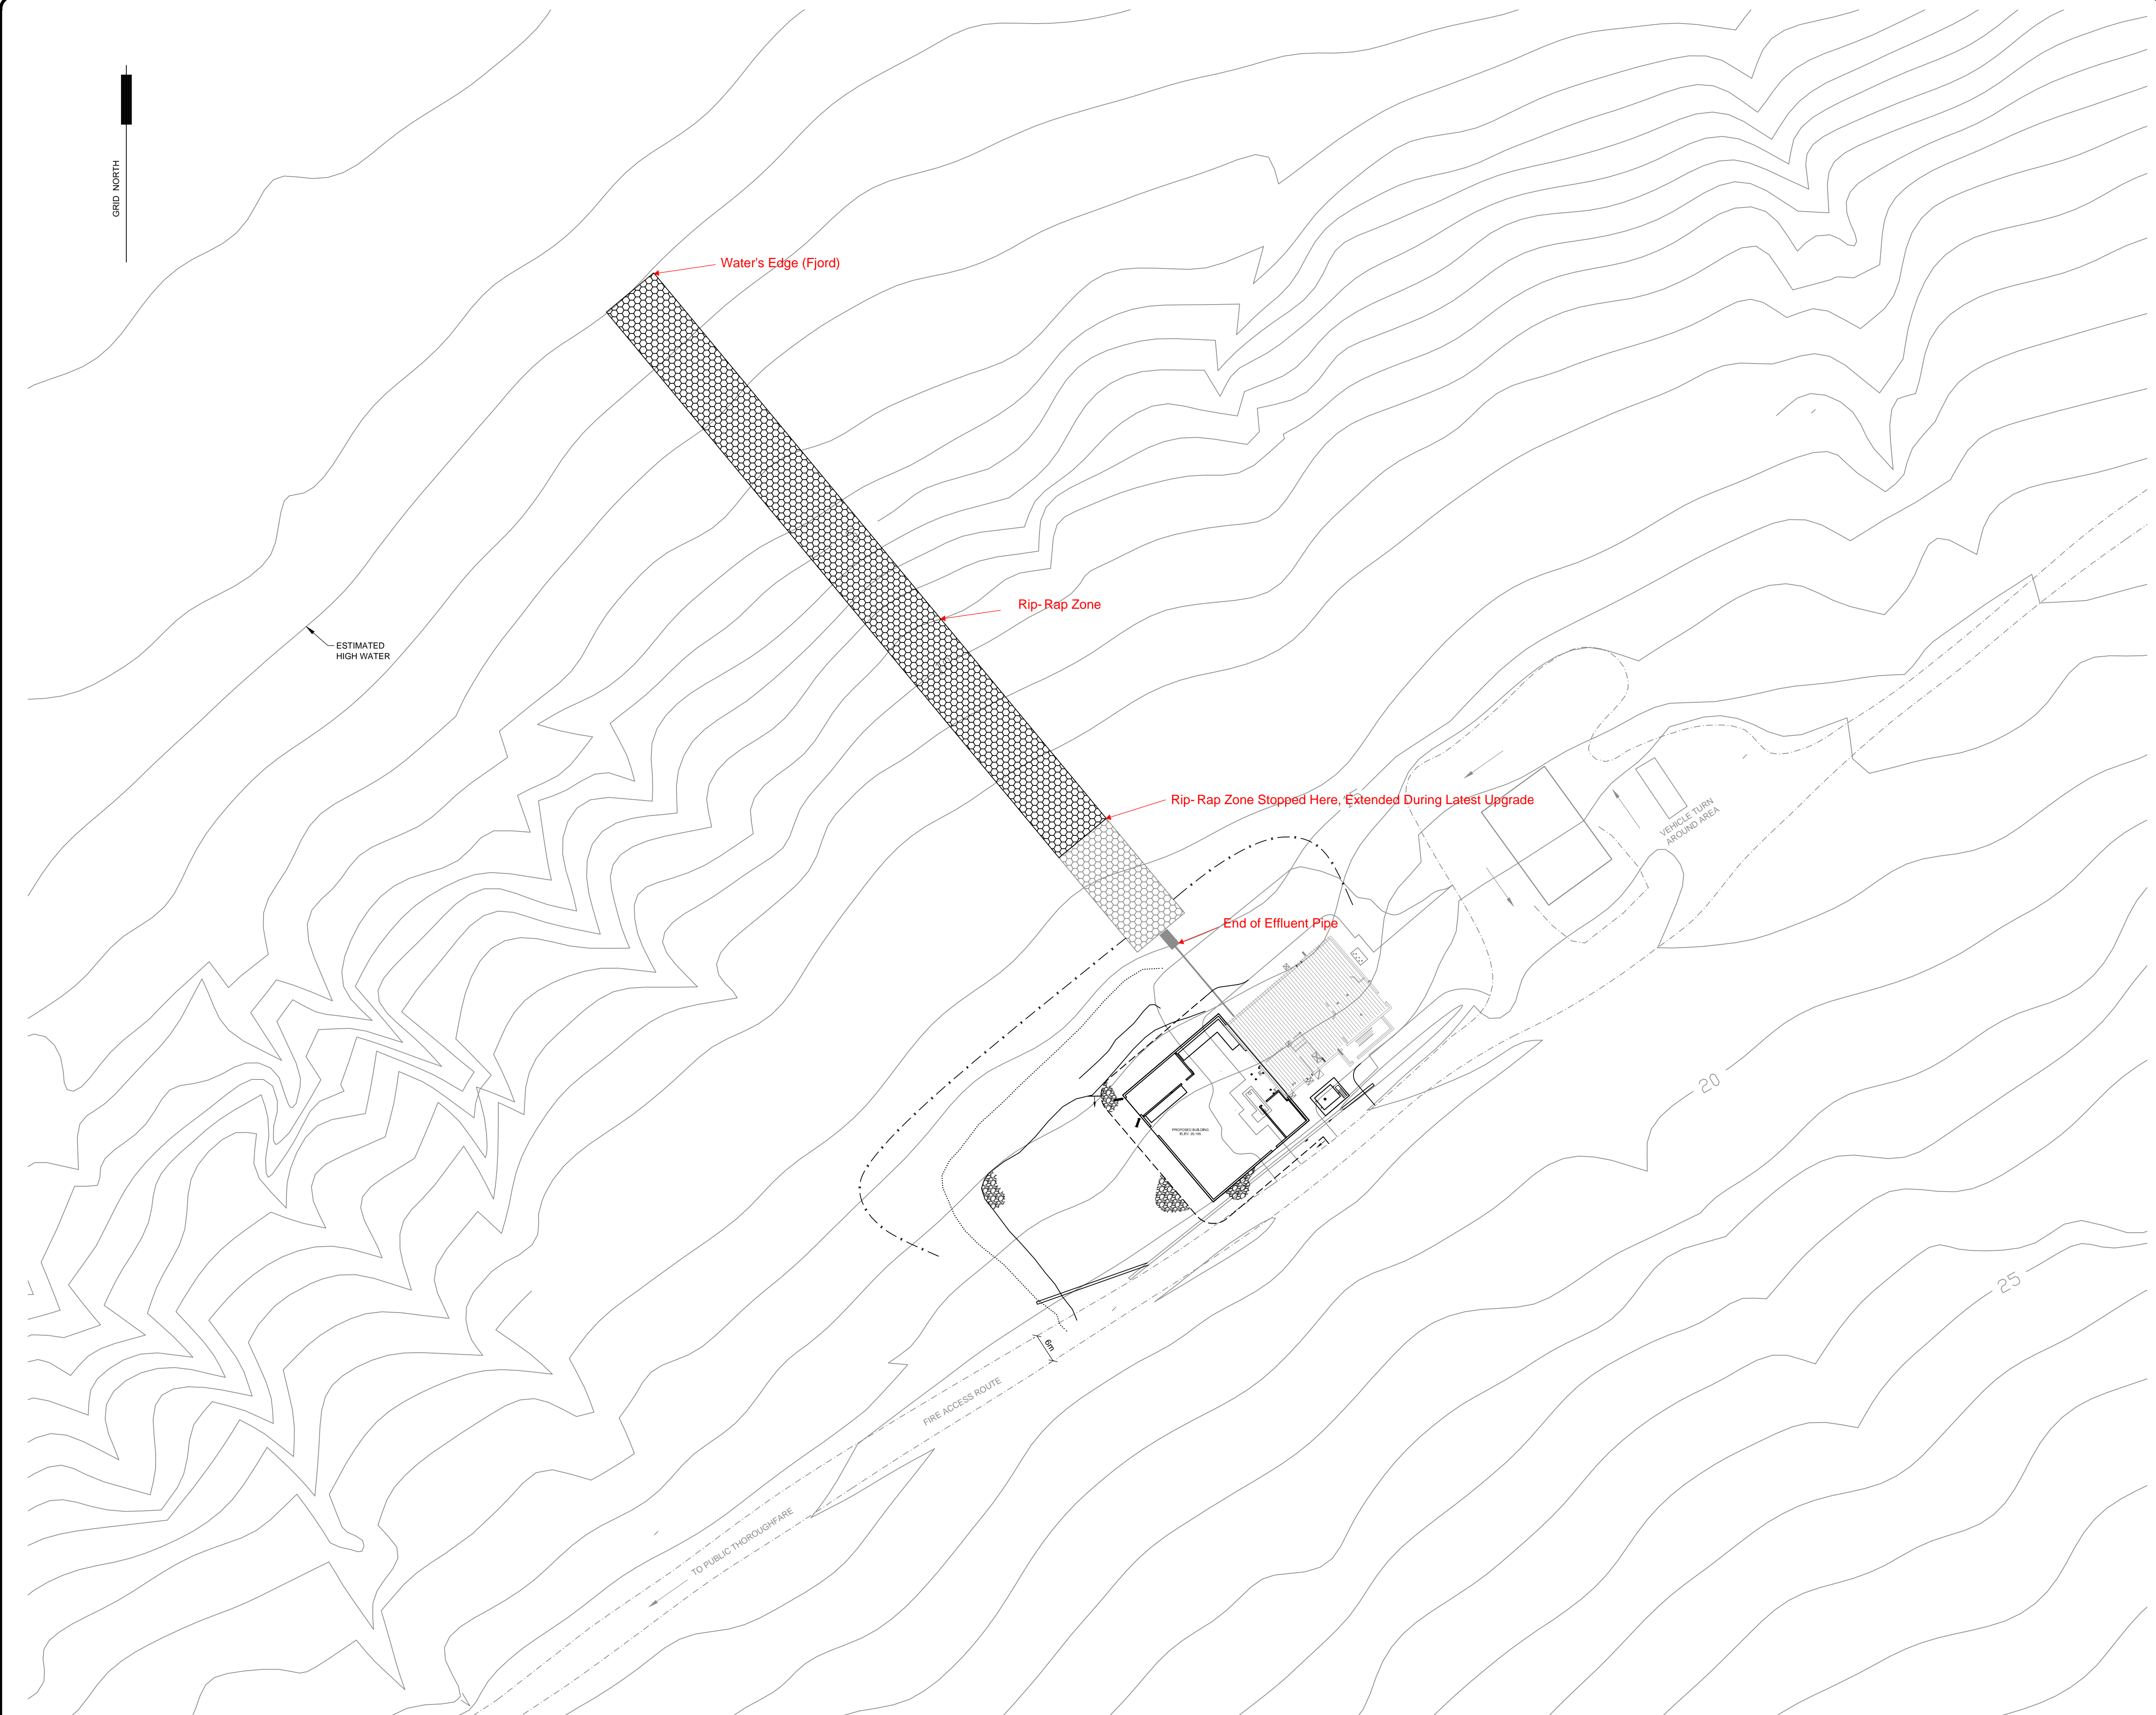

SITE PLAN

SCALE 1:500

exp Services Inc. © 2013

| No. | Issue                     | Date          |
|-----|---------------------------|---------------|
| 1   | 60% REVIEW SUBMISSION     | 2013-MAR-08   |
| 2   | ISSUED FOR TENDER         | 2013-APRIL-11 |
| 3   | RELEASED FOR CONSTRUCTION | 2013-JUNE-27  |



| No. | Revision       | Ckd. By | Date        |
|-----|----------------|---------|-------------|
| 1   | RECORD DRAWING | MAB     | 2015-OCT-16 |

THIS RECORD DRAWING WAS PRODUCED USING INFORMATION PROVIDED BY OTHERS. exp Services Inc. AND ITS EMPLOYEES TAKE NO RESPONSIBILITY FOR ITS ACCURACY AND CORRECTNESS.

RECORD DRAWING

|              |                            |
|--------------|----------------------------|
|              | Const. North               |
|              | Drawn By: KW               |
|              | Dwg. Standards Ckd. By: PD |
|              | Designed By: MAB           |
| Date Printed | Dwg. Design Ckd. By: SGB   |

exp Services Inc.  
t: +1.613.688.1899 | f: +1.613.225.7330  
2650 Queensview Drive, Unit 100  
Ottawa, ON K2B 6H6  
CANADA  
www.exp.com



- BUILDINGS • EARTH & ENVIRONMENT • ENERGY •
- INDUSTRIAL • INFRASTRUCTURE • SUSTAINABILITY •

|  |  |
|--|--|
| Project Title  |  |
| WASTE WATER TREATMENT PLANT UPGRADE PANGNIERTUNG, NU |  |
| Dwg. Title   |  |
| WASTEWATER TREATMENT PLANT OVERALL PLAN              |  |
| Project No.  | OTT-00204430-A0                              |
| Dwg. No.   | C201-1                                       |
| Rev. No.   | 1  |
| Scale  | AS SHOWN<br>This drawing is not to be scaled |