



FILE: N:\PROJECTS\2016\RESOLUTE BAY\NEW UTILIDOR\DWG\NEW UTILIDOR PLAN AND PROFILE.dwg
DATE: 2016-04-26 14:00
DRAWN BY: I.CRAWFORD
CHECKED BY: S.BURDEN
APPROVED BY: A.ZARAD
PROJECT: NEW UTILIDOR DESIGN
SHEET: 1 OF 1

NO DATA BEYOND 40+200
INTERSECTION: 40+200

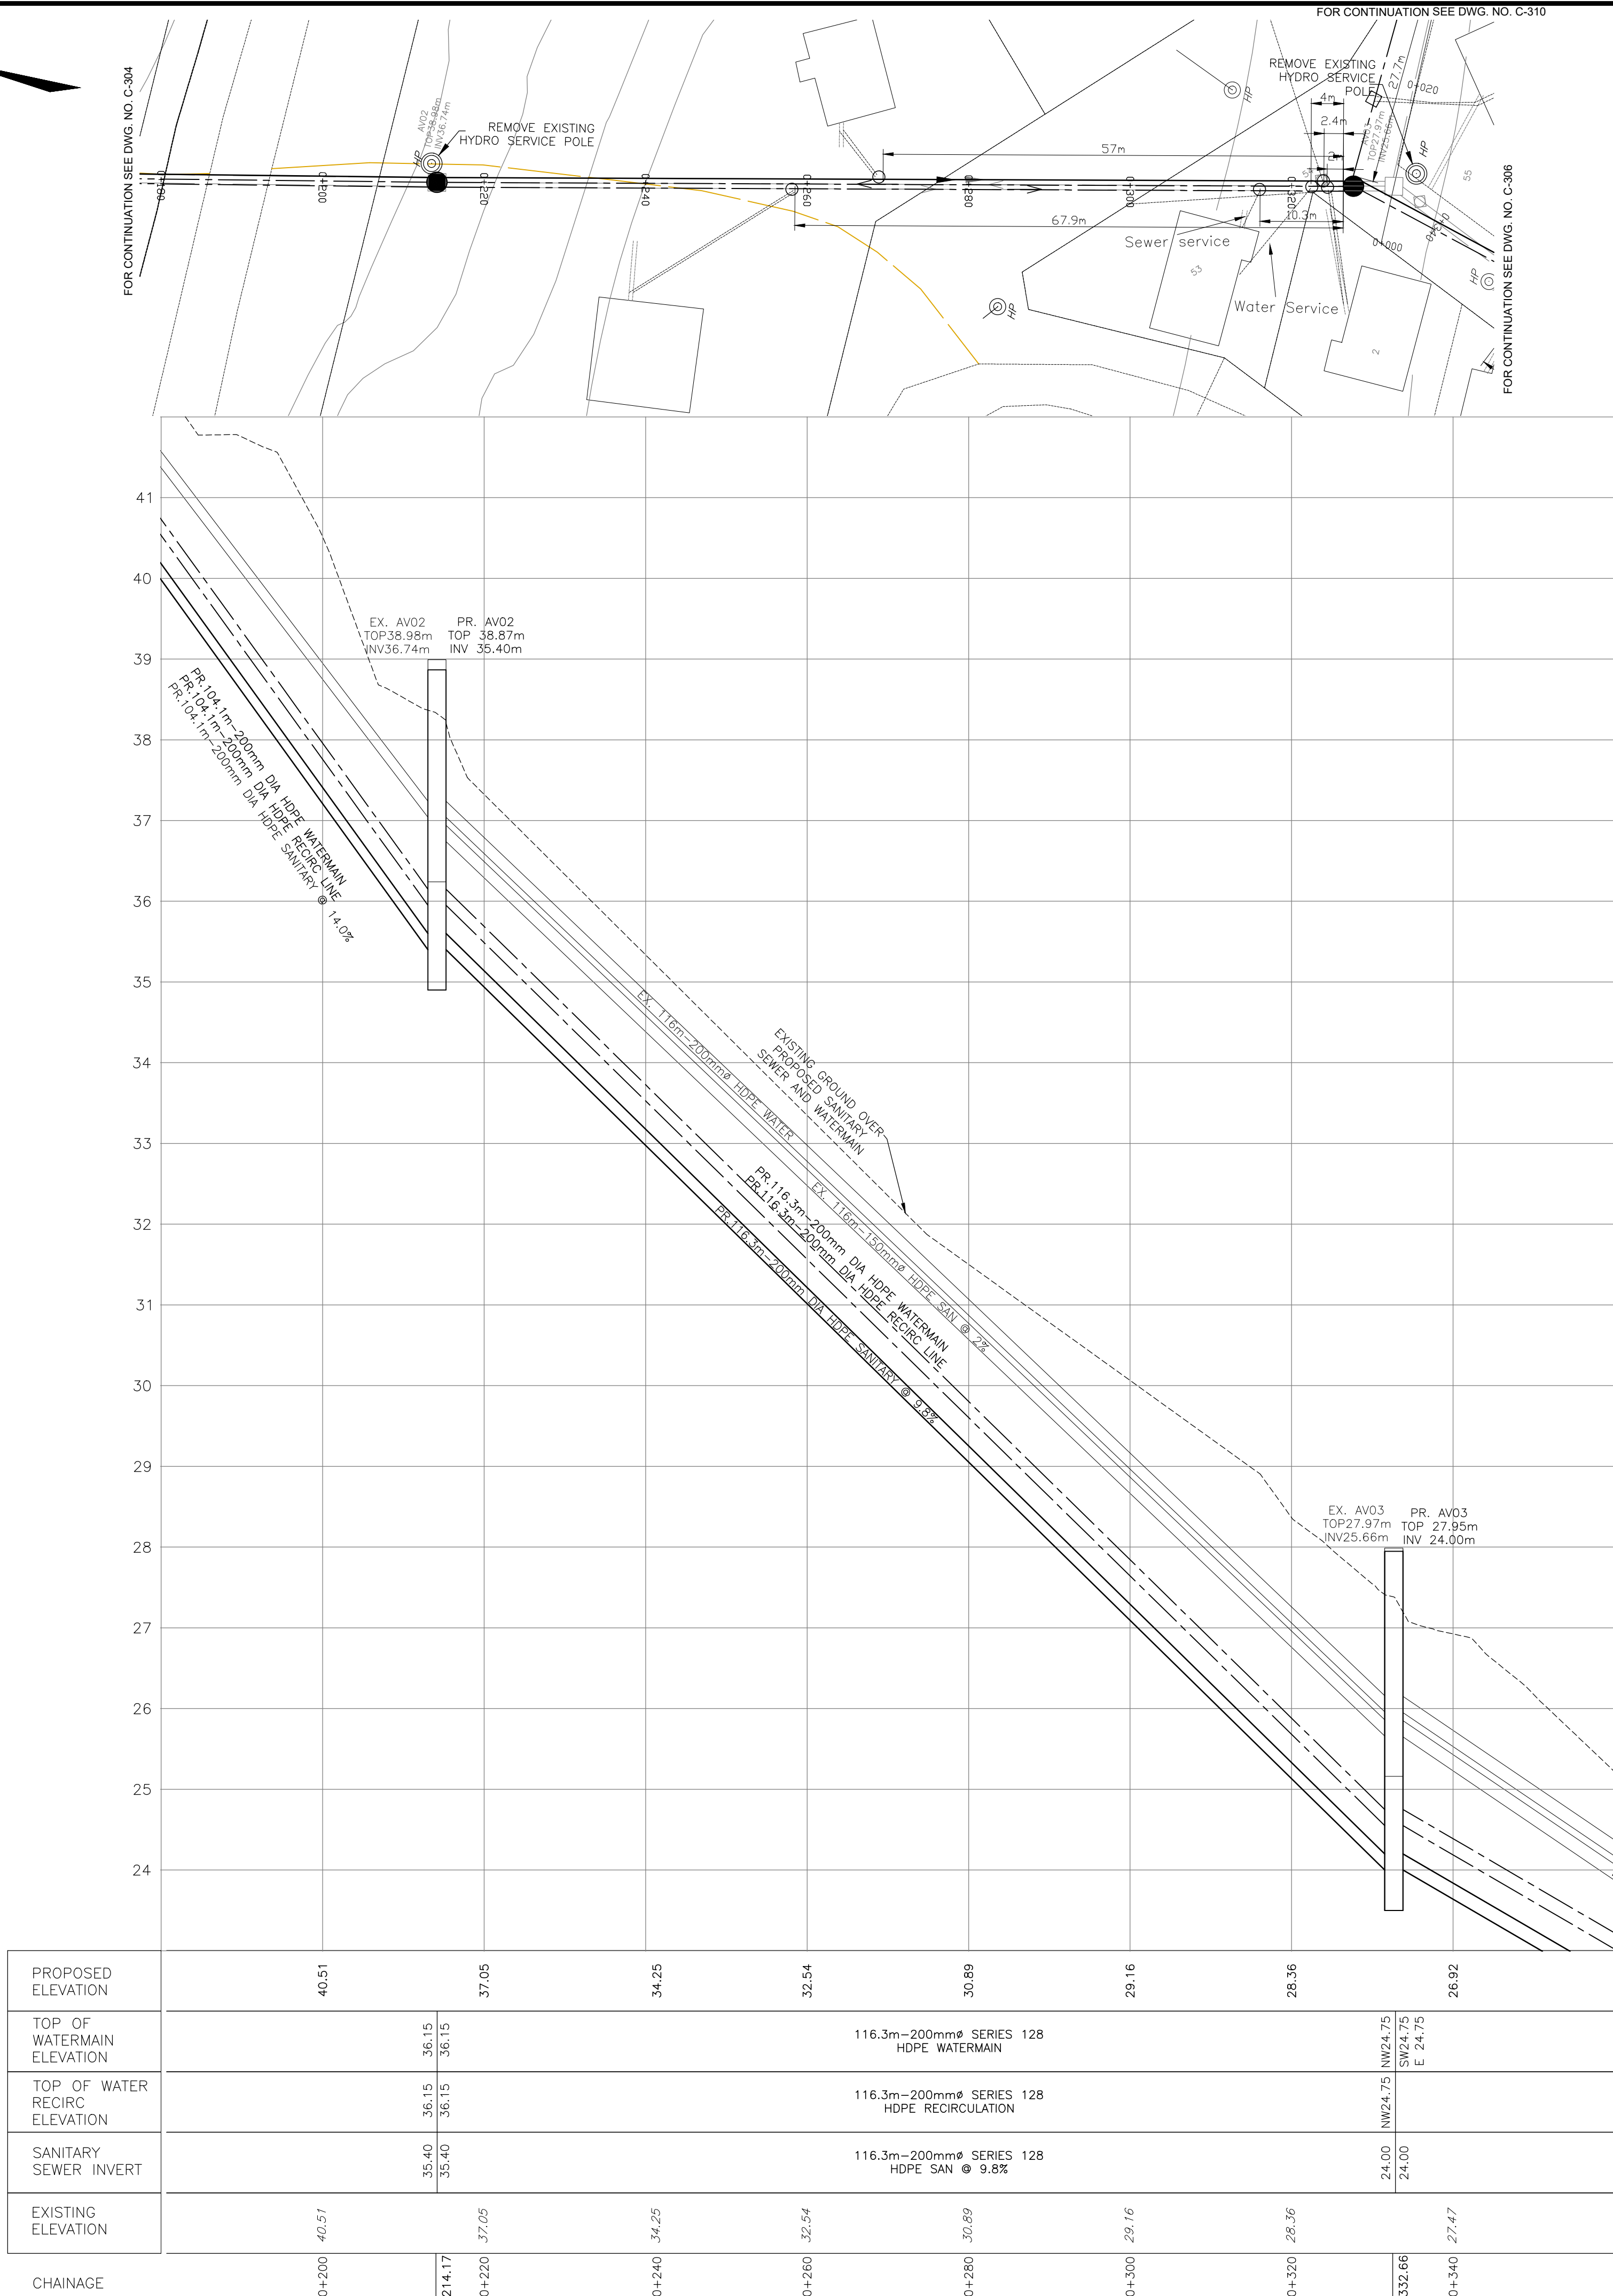

No.	Issue	Date
01	ISSUED FOR TENDER	2013-MAR-25
02	REISSUED FOR TENDER	2013-OCT-25
03	ISSUED FOR CONSTRUCTION	2014-APR-21
04	ISSUED FOR AS-BUILT	2016-APR-26

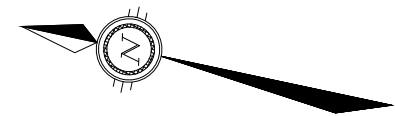

AS-BUILT

DATE: APRIL 26, 2016

No.	Revision	Ckd. By	Date
00	100% SUBMISSION	SLB	2013-MAR-04

Const. North

Drawn By:
I.CRAWFORD

Dwg. Standards
Ckd. By:

Designed By:
A. ZARAD

Date Printed

Dwg. Design
Ckd. By: S. BURDEN

exp Services Inc.
t: +1.613.688.1899 | f: +1.613.225.7330
2650 Queensview Drive, Unit 100
Ottawa, ON K2B 8H6
CANADA
www.exp.com



• BUILDINGS • EARTH & ENVIRONMENT • ENERGY •
• INDUSTRIAL • INFRASTRUCTURE • SUSTAINABILITY •

Project Title

**NEW UTILIDOR DESIGN
RESOLUTE BAY, NU**

Dwg. Title

**PLAN AND PROFILE
AV02 TO AV03**

Project No. **OTT-00206333-A0**


Dwg. No. C-305	Rev. No. 03
-----------------------	--------------------

Scale **1:500**
This drawing is not to be scaled

DATE: 13-03-2016 10:40:00 AM PROJECT: NEW UTILIDOR DESIGN RESOLUTE BAY, NU PROJECT NO: OTT-00206333-A0 DRAWN BY: I. CRAWFORD CHECKED BY: A. ZARAD

NO DATA BEYOND 1000M

EXP SERVICES INC.

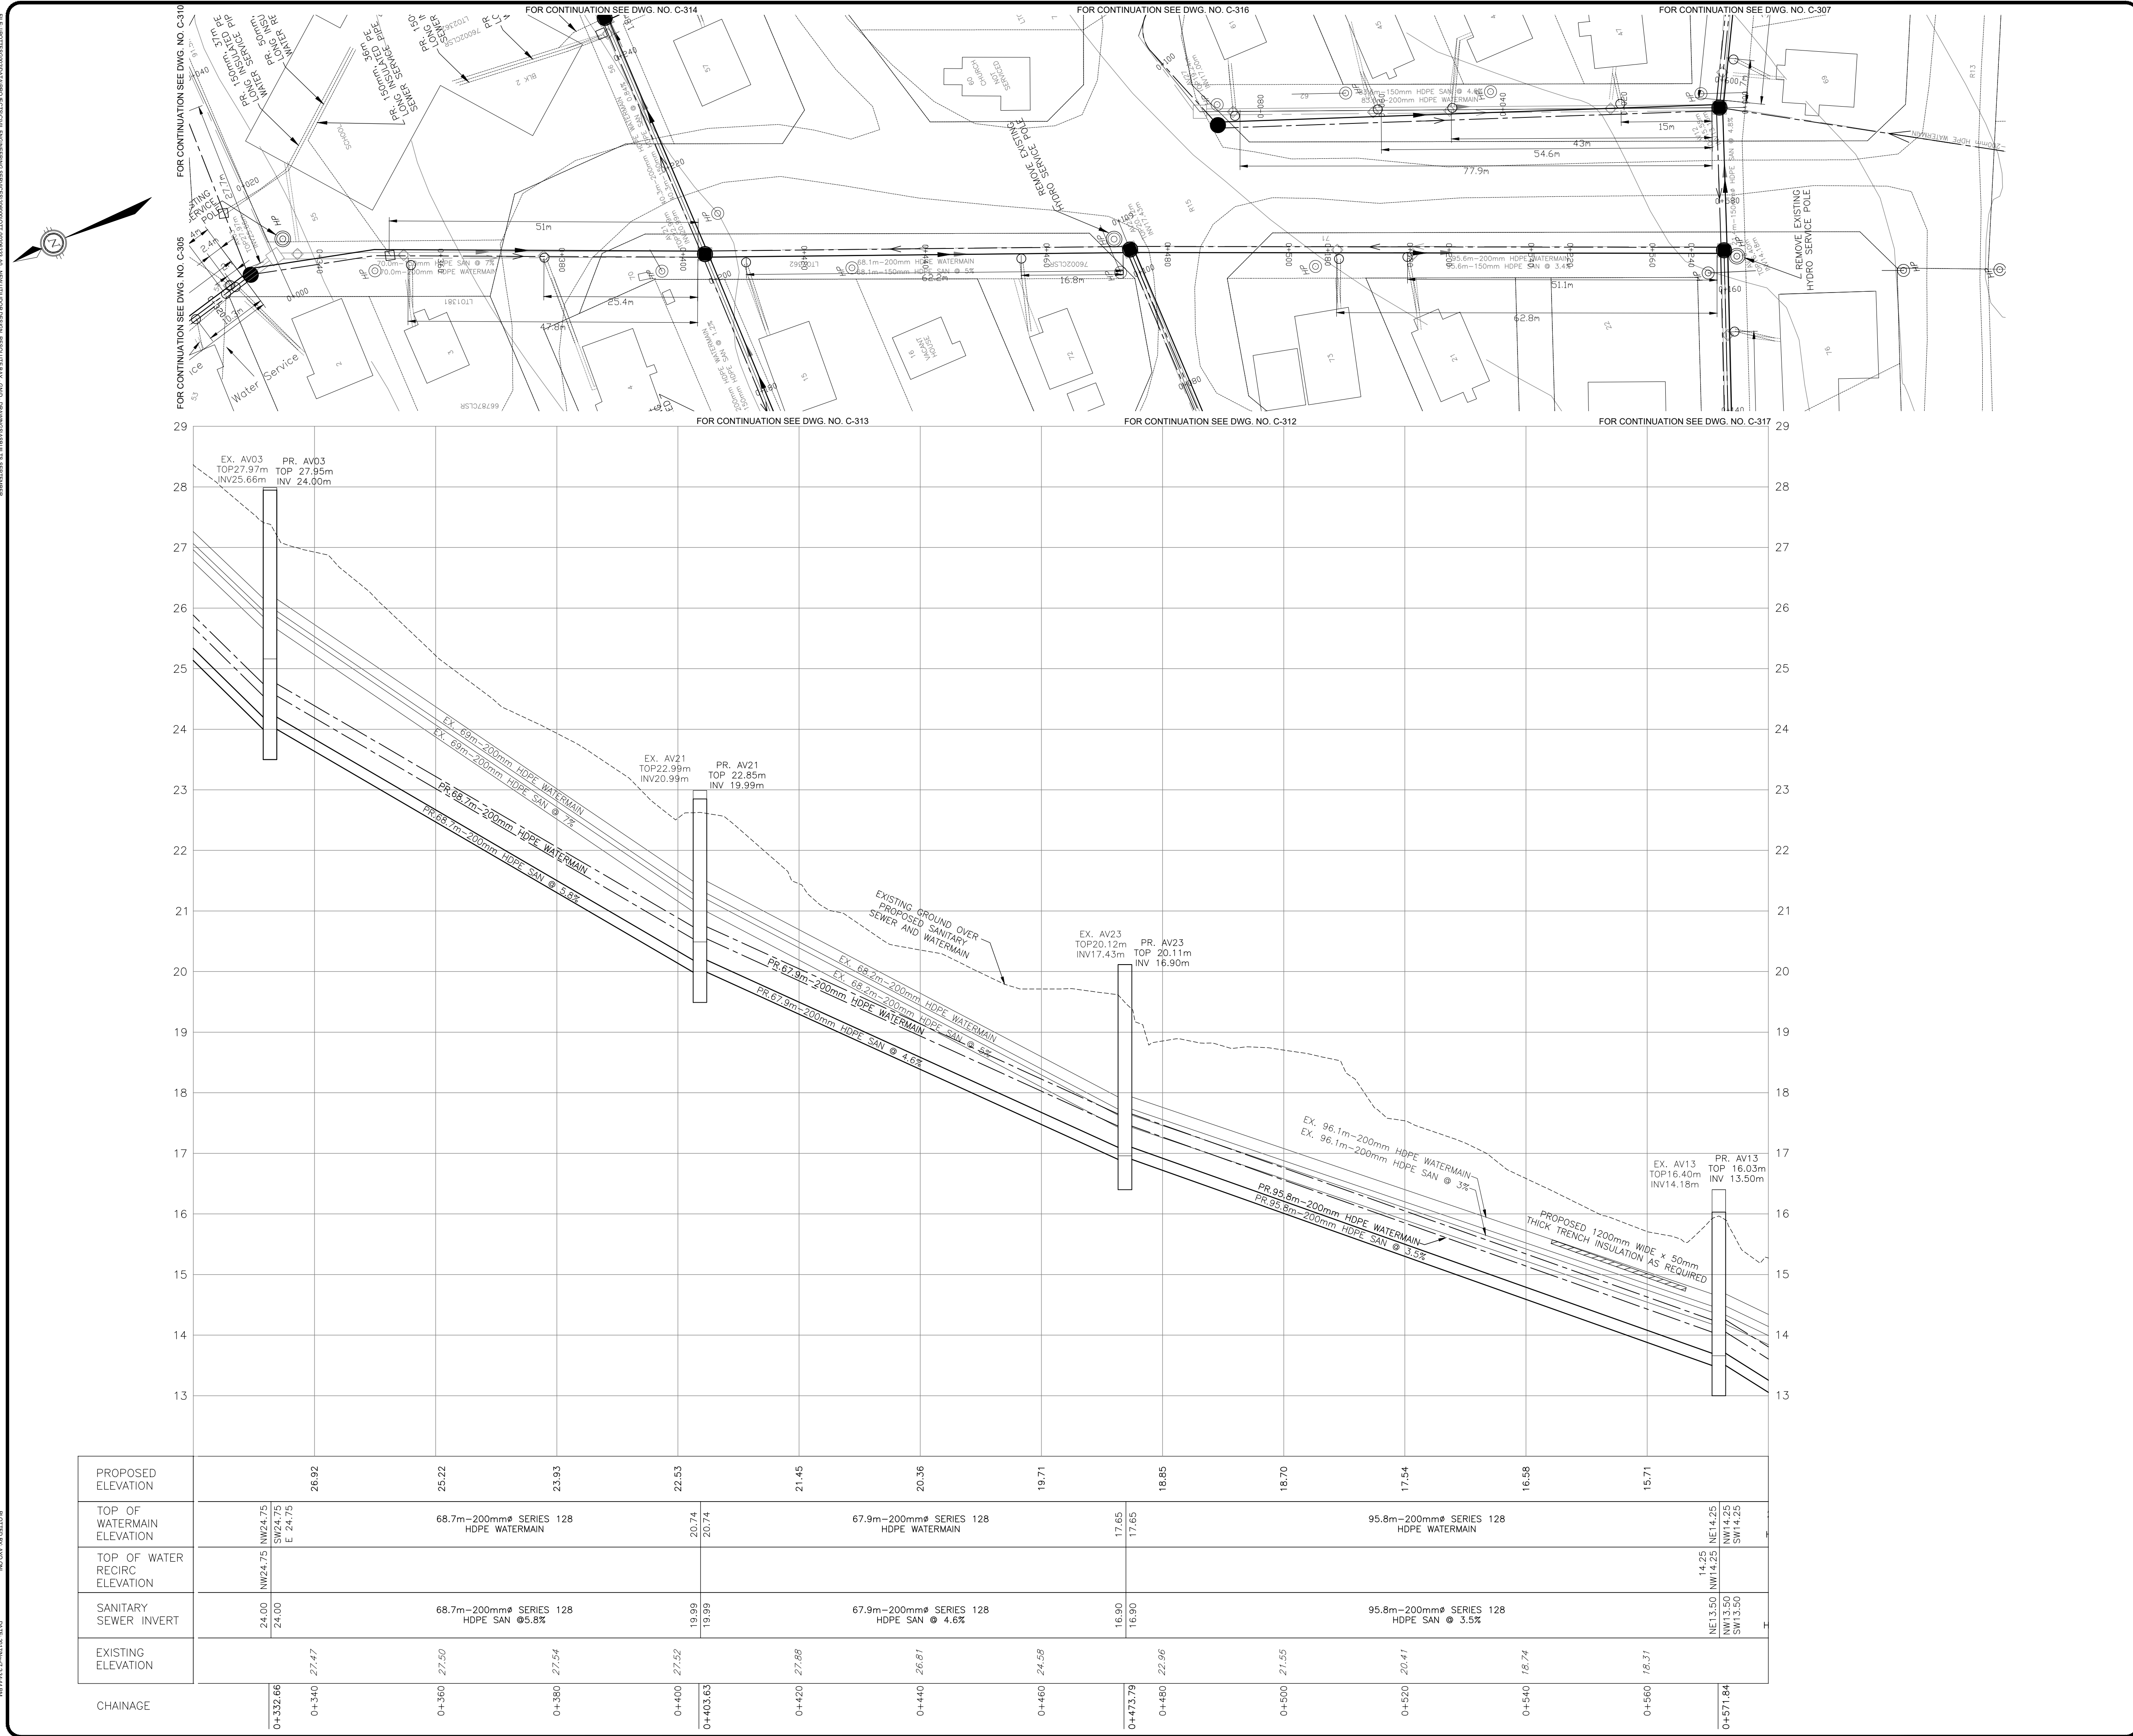

PROPOSED ELEVATION			26.92			25.22			23.93			22.53			21.45			20.36			19.71			18.85			18.70			17.54			16.58			15.71		
TOP OF WATERMAIN ELEVATION			NW24.75 SW24.75 E 24.75	68.7m-200mmØ SERIES 128 HDPE WATERMAIN										20.74 20.74	67.9m-200mmØ SERIES 128 HDPE WATERMAIN										17.65 17.65	95.8m-200mmØ SERIES 128 HDPE WATERMAIN										NE14.25 NW14.25 SW14.25		
TOP OF WATER RECIRC ELEVATION			NW24.75																																	NE14.25 NW14.25 SW14.25		
SANITARY SEWER INVERT			24.00 24.00	68.7m-200mmØ SERIES 128 HDPE SAN @5.8%										19.99 19.99	67.9m-200mmØ SERIES 128 HDPE SAN @ 4.6%										16.90 16.90	95.8m-200mmØ SERIES 128 HDPE SAN @ 3.5%										NE13.50 NW13.50 SW13.50		
EXISTING ELEVATION			27.47			27.50			27.54			27.52			27.68			26.81			24.58			22.96			21.55			20.41			18.74			18.31		
CHAINAGE	0+332.66	0+340		0+360		0+380		0+400	0+403.63		0+420		0+440		0+460		0+473.79	0+480		0+500		0+520		0+540		0+560		0+571.84										

No.

Issue

Date

01

ISSUED FOR TENDER

2013-MAR-25

02

REISSUED FOR TENDER

2013-OCT-25

03

ISSUED FOR CONSTRUCTION

2014-APR-21

04

ISSUED FOR AS-BUILT

2016-APR-26



AS-BUILT

DATE: APRIL 26, 2016

00	100% SUBMISSION	SLB	2013-MAR-04
No.	Revision	Ckd. By	Date

Const. North

Drawn By: I. CRAWFORD

Dwg. Standards Ckd. By:

Designed By: A. ZARAD

Date Printed

Dwg. Design Ckd. By: S. BURDEN

exp Services Inc.

t: +1.613.688.1899 | f: +1.613.225.7330

2650 Queensview Drive, Unit 100

Ottawa, ON K2B 8H6

CANADA

www.exp.com



BUILDINGS • EARTH & ENVIRONMENT • ENERGY • INDUSTRIAL • INFRASTRUCTURE • SUSTAINABILITY

Project Title

NEW UTILIDOR DESIGN
RESOLUTE BAY, NU

Dwg. Title

PLAN AND PROFILE
AV03 TO AV13

Project No.

OTT-00206333-A0

Dwg. No.

C-306

Rev. No.

03

Scale

1:500



This drawing is not to be scaled

exp Services Inc. © 2012

DATE: 13-10-2016 10:00:00 PROJECT: NEW UTILIDOR DESIGN RESOLUTE BAY, NU DRAWN BY: I. CRAWFORD CHECKED BY: S. BURDEN

NO. 004 48 000000

PROJECT: NEW UTILIDOR DESIGN RESOLUTE BAY, NU

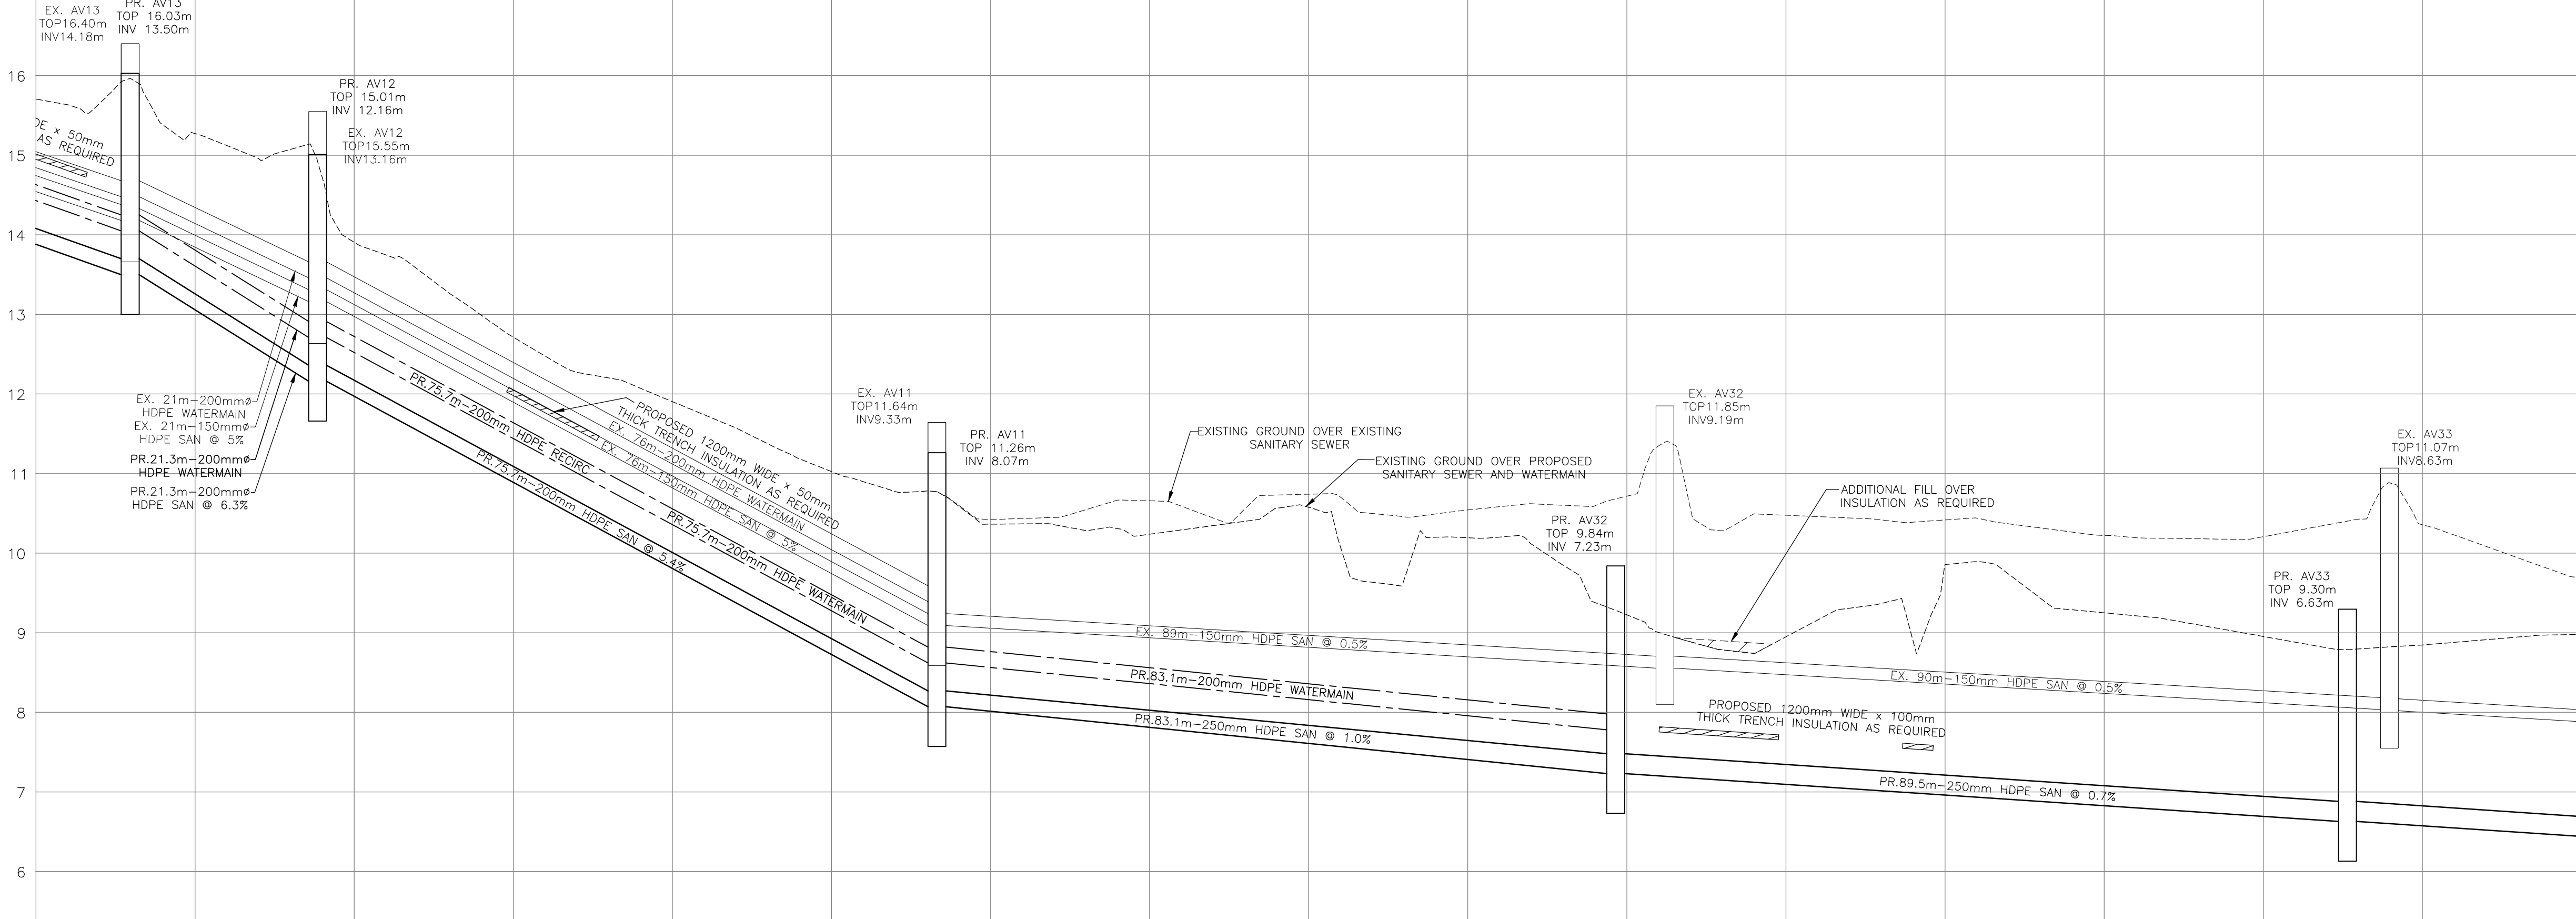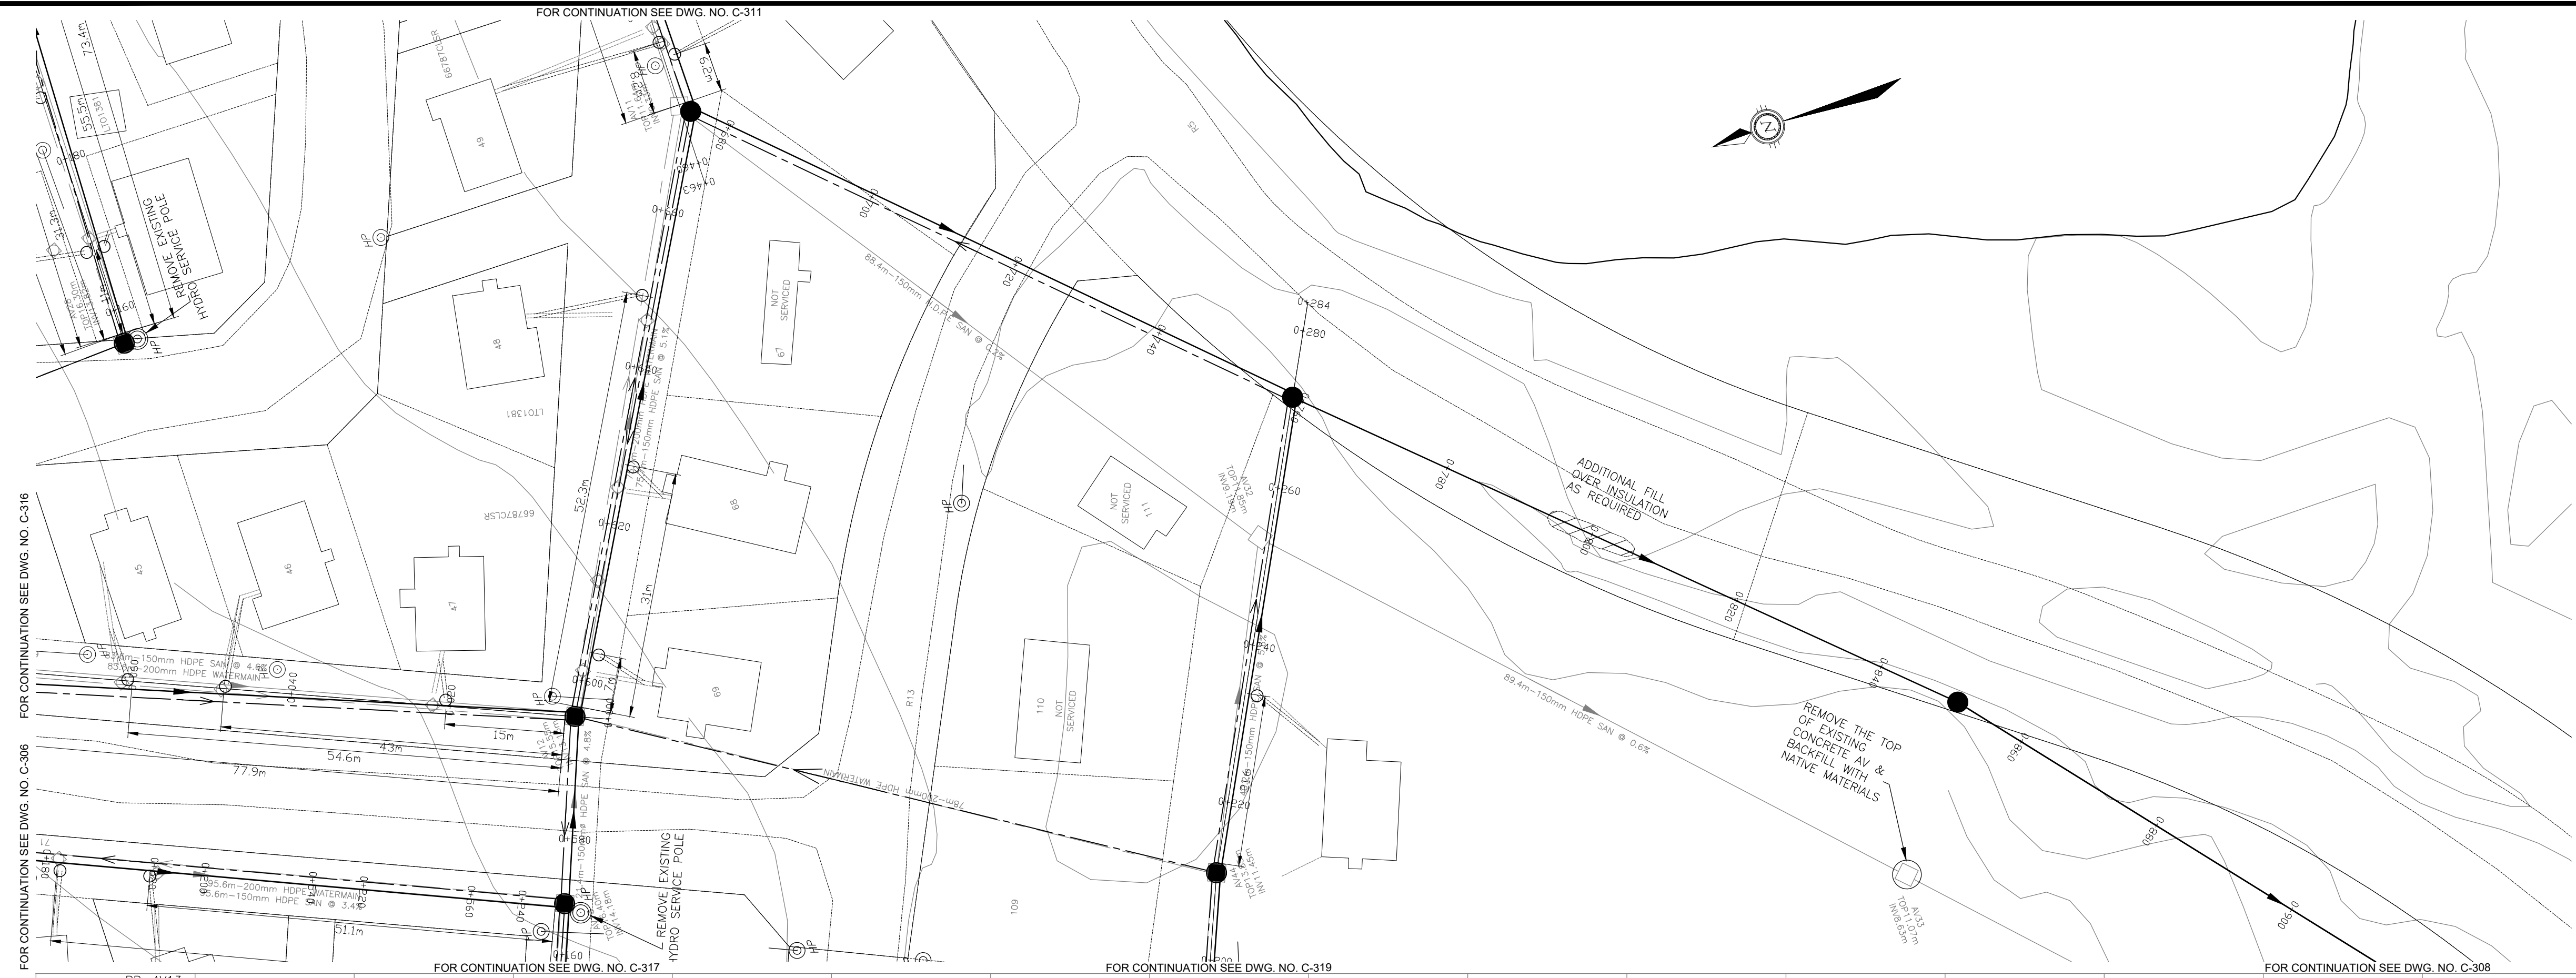

PROPOSED ELEVATION	15.27	13.91	12.71	11.90	11.02	10.36	10.24	10.58	10.19	9.22	8.95	9.86	9.25	8.95	8.85
TOP OF WATERMAIN ELEVATION	NE 14.25 NW 14.25 SW 14.25	21.3m-200mm ϕ SERIES 128 HDPE WATERMAIN	75.7m-200mm ϕ SERIES 128 HDPE WATERMAIN	83.1m-200mm ϕ SERIES 128 HDPE WATERMAIN	8.03 NW 7.98										
TOP OF WATER RECIRC ELEVATION	14.25 NW 14.25 SW 14.25	21.3m-200mm ϕ SERIES 128 HDPE WATERMAIN	75.7m-200mm ϕ SERIES 128 HDPE RECIRCULATION	83.1m-250mm ϕ SERIES 128 HDPE SAN @ 1.0%	8.03 NW 7.98										
SANITARY SEWER INVERT	NE 13.50 NW 13.50 SW 13.50	21.3m-200mm ϕ SERIES 128 HDPE SAN @ 6.3%	75.7m-200mm ϕ SERIES 128 HDPE SAN @ 5.4%	83.1m-250mm ϕ SERIES 128 HDPE SAN @ 0.7%	6.63 6.63										
EXISTING ELEVATION	17.17	16.53	15.24	14.04	12.44	10.99	10.25	10.31	10.11	10.64	10.23	10.45	9.90	6.04	6.04
CHAINAGE	0+571.84	0+580	0+595.41	0+600	0+620	0+640	0+660	0+680	0+700	0+720	0+740	0+760	0+780	0+800	0+860

No.	Issue	Date
01	ISSUED FOR TENDER	2013-MAR-25
02	REISSUED FOR TENDER	2013-OCT-25
03	ISSUED FOR CONSTRUCTION	2014-APR-21
04	ISSUED FOR AS-BUILT	2016-APR-26



AS-BUILT

DATE: APRIL 26, 2016

No.	Revision	Ckd. By	Date
00	100% SUBMISSION	SLB	2013-MAR-04

Const. North	Drawn By: I. CRAWFORD
Dwg. Standards Ckd. By:	Designed By: A. ZARAD
Date Printed	Dwg. Design Ckd. By: S. BURDEN

exp Services Inc.
t: +1.613.688.1899 | f: +1.613.225.7330
2650 Queensview Drive, Unit 100
Ottawa, ON K2B 8H6
CANADA
www.exp.com




• BUILDINGS • EARTH & ENVIRONMENT • ENERGY •
• INDUSTRIAL • INFRASTRUCTURE • SUSTAINABILITY •

Project Title	NEW UTILIDOR DESIGN RESOLUTE BAY, NU	
Dwg. Title	PLAN AND PROFILE AV13 TO AV33	
Project No.	OTT-00206333-A0	
Dwg. No.	C-307	Rev. No. 03
Scale	1:500 This drawing is not to be scaled	


NO DATE AS BELLTOP

PROPOSED SANITARY SEWER

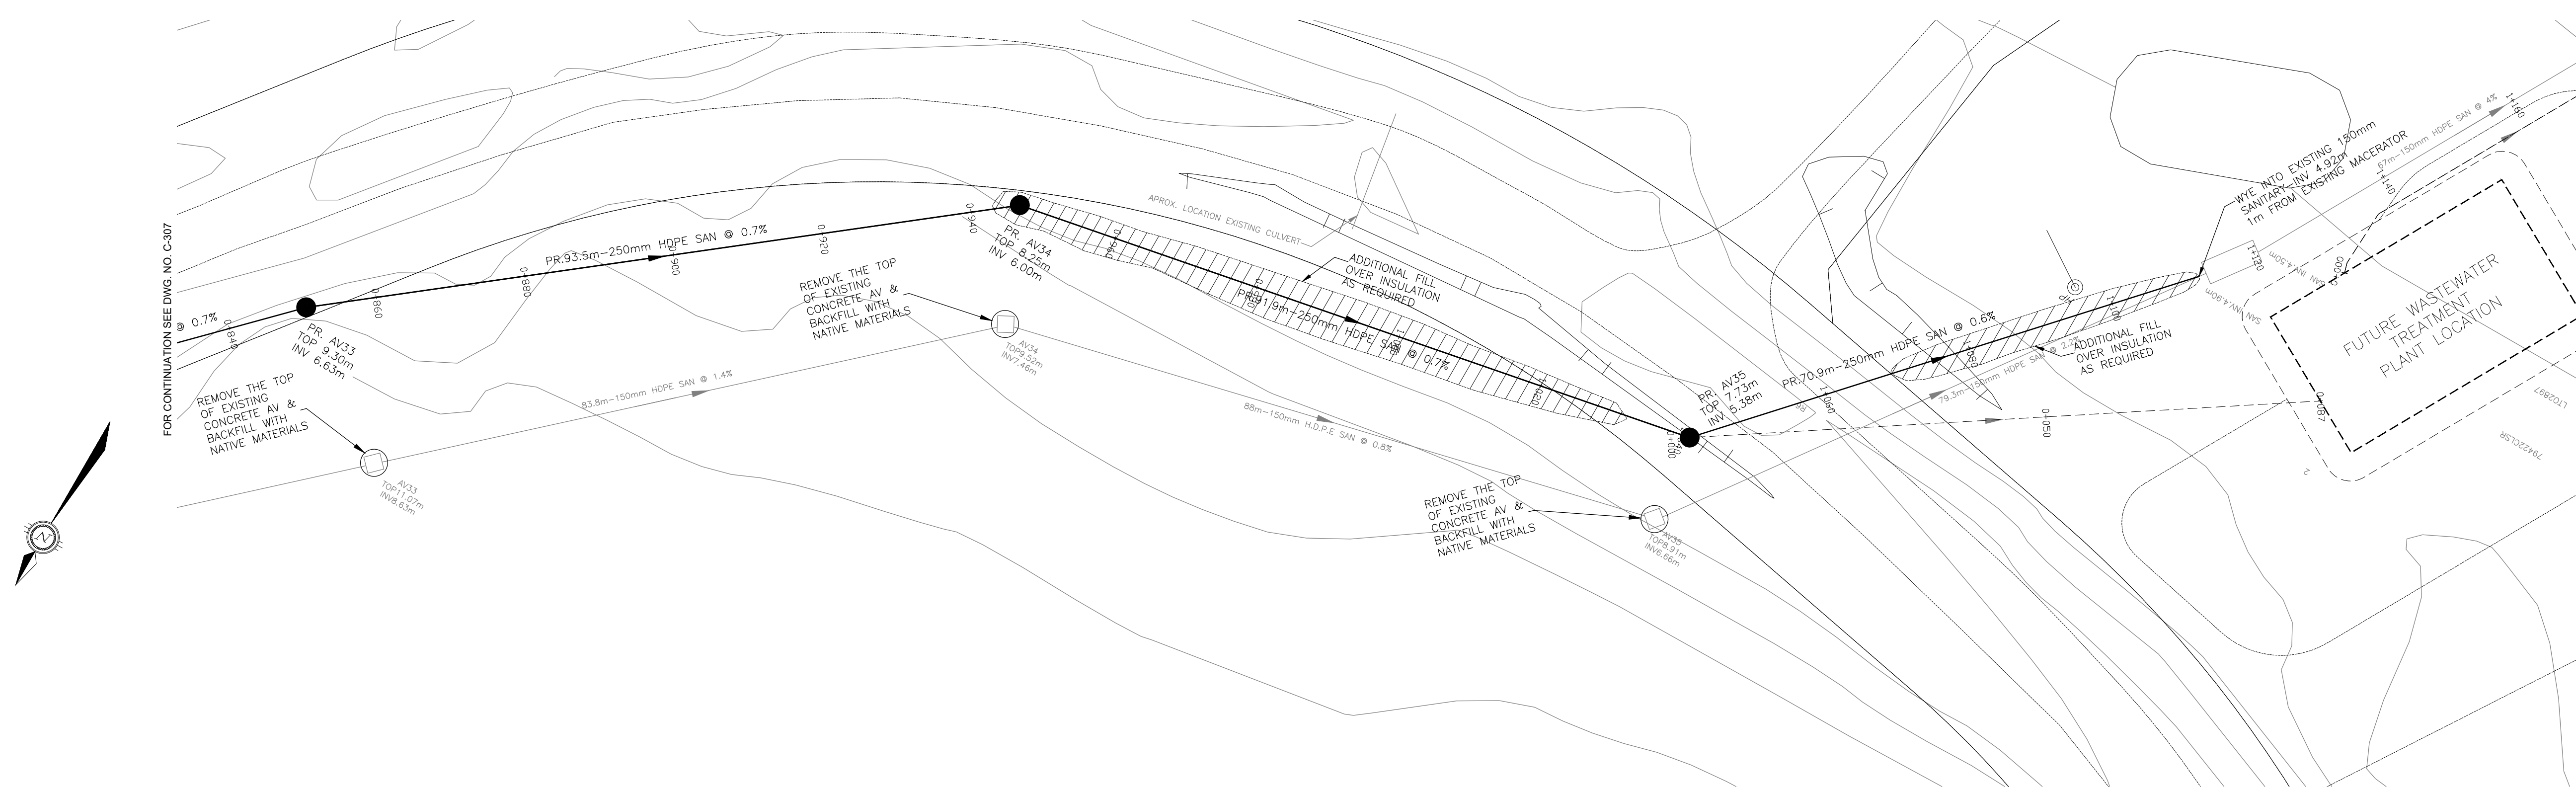

FOR CONTINUATION SEE DWG. NO. C-307

FOR CONTINUATION SEE DWG. NO. C-309

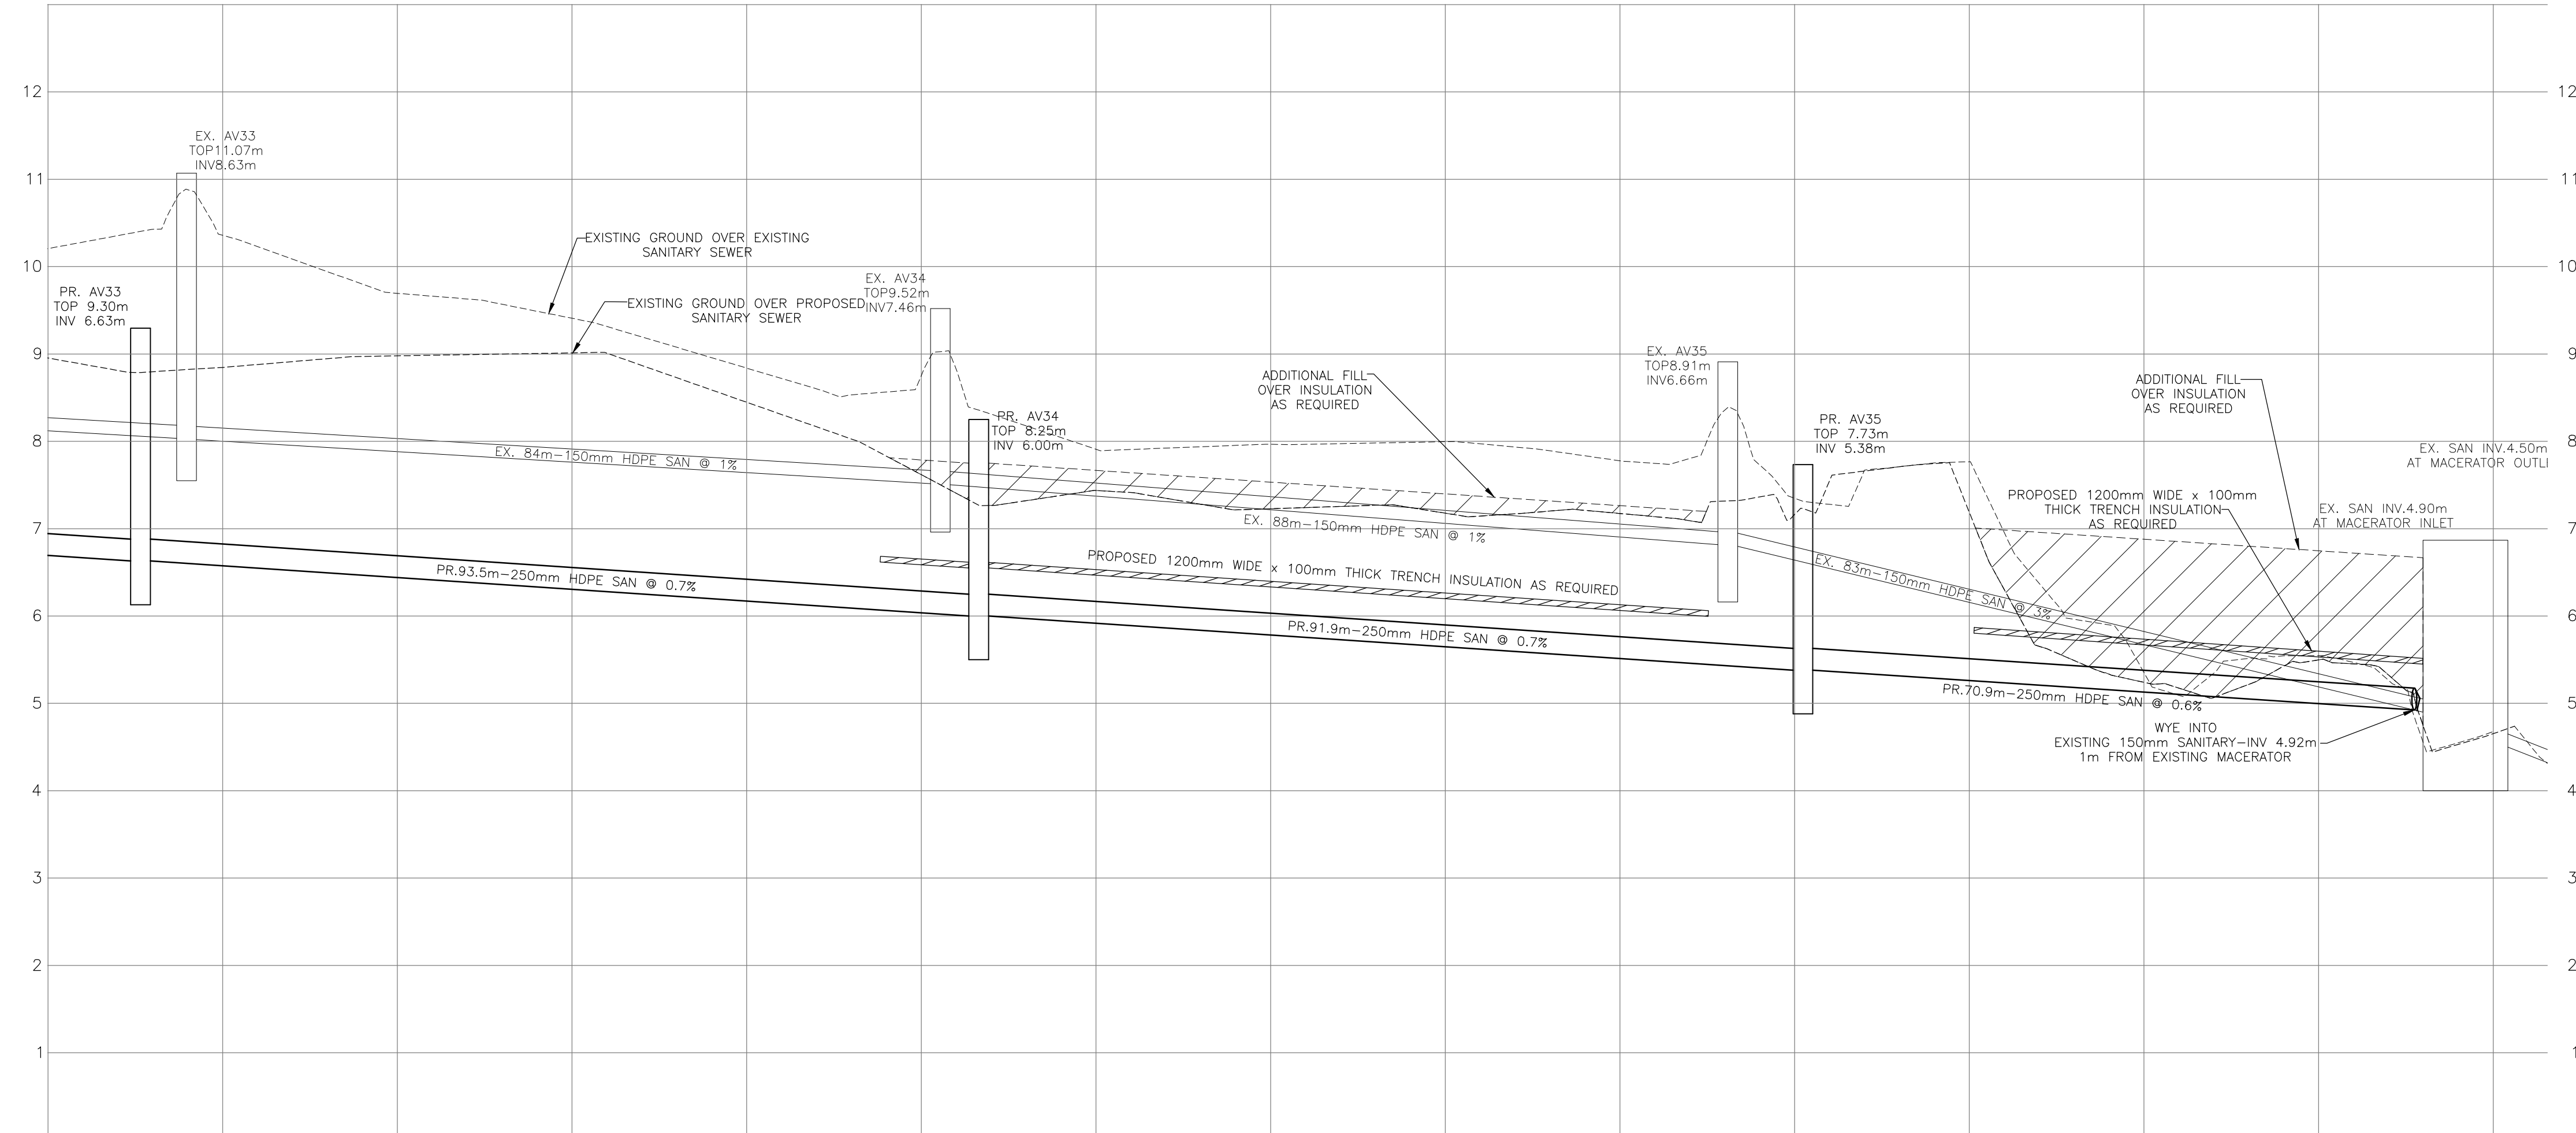

PROPOSED ELEVATION	8.85	8.98	9.01	8.45	7.62	7.44	7.23	7.18	7.17	7.16	7.19	5.24	5.50	4.65
TOP OF WATERMAIN ELEVATION														
TOP OF WATER RECIRC ELEVATION														
SANITARY SEWER INVERT	6.63 6.63	93.5m-250mm# SERIES 128 HDPE SAN @ 0.7%				6.00 6.00	91.9m-250mm# SERIES 128 HDPE SAN @ 0.7%				5.38 5.38	70.9m-250mm# SERIES 128 HDPE SAN @ 0.6%		
EXISTING ELEVATION		8.04	8.73	6.07	6.13	6.07	6.10	6.08	6.04	6.08	6.22	6.41	6.08	6.94
CHAINAGE	0+560.60	0+560	0+580	0+900	0+920	0+940	0+960	0+980	1+000	1+020	1+040	1+060	1+080	1+100
						0+946.58					1+040.96			1+120
														1+121.67

No.	Issue	Date
01	ISSUED FOR TENDER	2013-MAR-25
02	REISSUED FOR TENDER	2013-OCT-25
02	ISSUED FOR CONSTRUCTION	2014-APR-21
04	ISSUED FOR AS-BUILT	2016-APR-26



AS-BUILT
DATE: APRIL 26, 2016

No.	Revision	Ckd. By	Date
00	100% SUBMISSION	SLB	2013-MAR-04



Const. North	Drawn By: I.CRAWFORD
Dwg. Standards	Ckd. By:
Designed By: A. ZARAD	Dwg. Design
Date Printed	Ckd. By: S. BURDEN

exp Services Inc.
t: +1.613.688.1899 | f: +1.613.225.7330
2650 Queensview Drive, Unit 100
Ottawa, ON K2B 8H6
CANADA
www.exp.com



- BUILDINGS • EARTH & ENVIRONMENT • ENERGY •
- INDUSTRIAL • INFRASTRUCTURE • SUSTAINABILITY •

Project Title
**NEW UTILIDOR DESIGN
RESOLUTE BAY, NU**


Dwg. Title
**PLAN AND PROFILE
AV33 TO EXIST. SAN**

Project No.	OTT-00206333-A0
Dwg. No.	C-308
Rev. No.	03



Scale
1:500
This drawing is not to be scaled

DATE: 11/20/2015 10:00:00 AM USER: J. BURDEN PROJECT: NEW UTILIDOR DESIGN RESOLUTE BAY, NU DRAWING: C-309

NO DATA BELOW

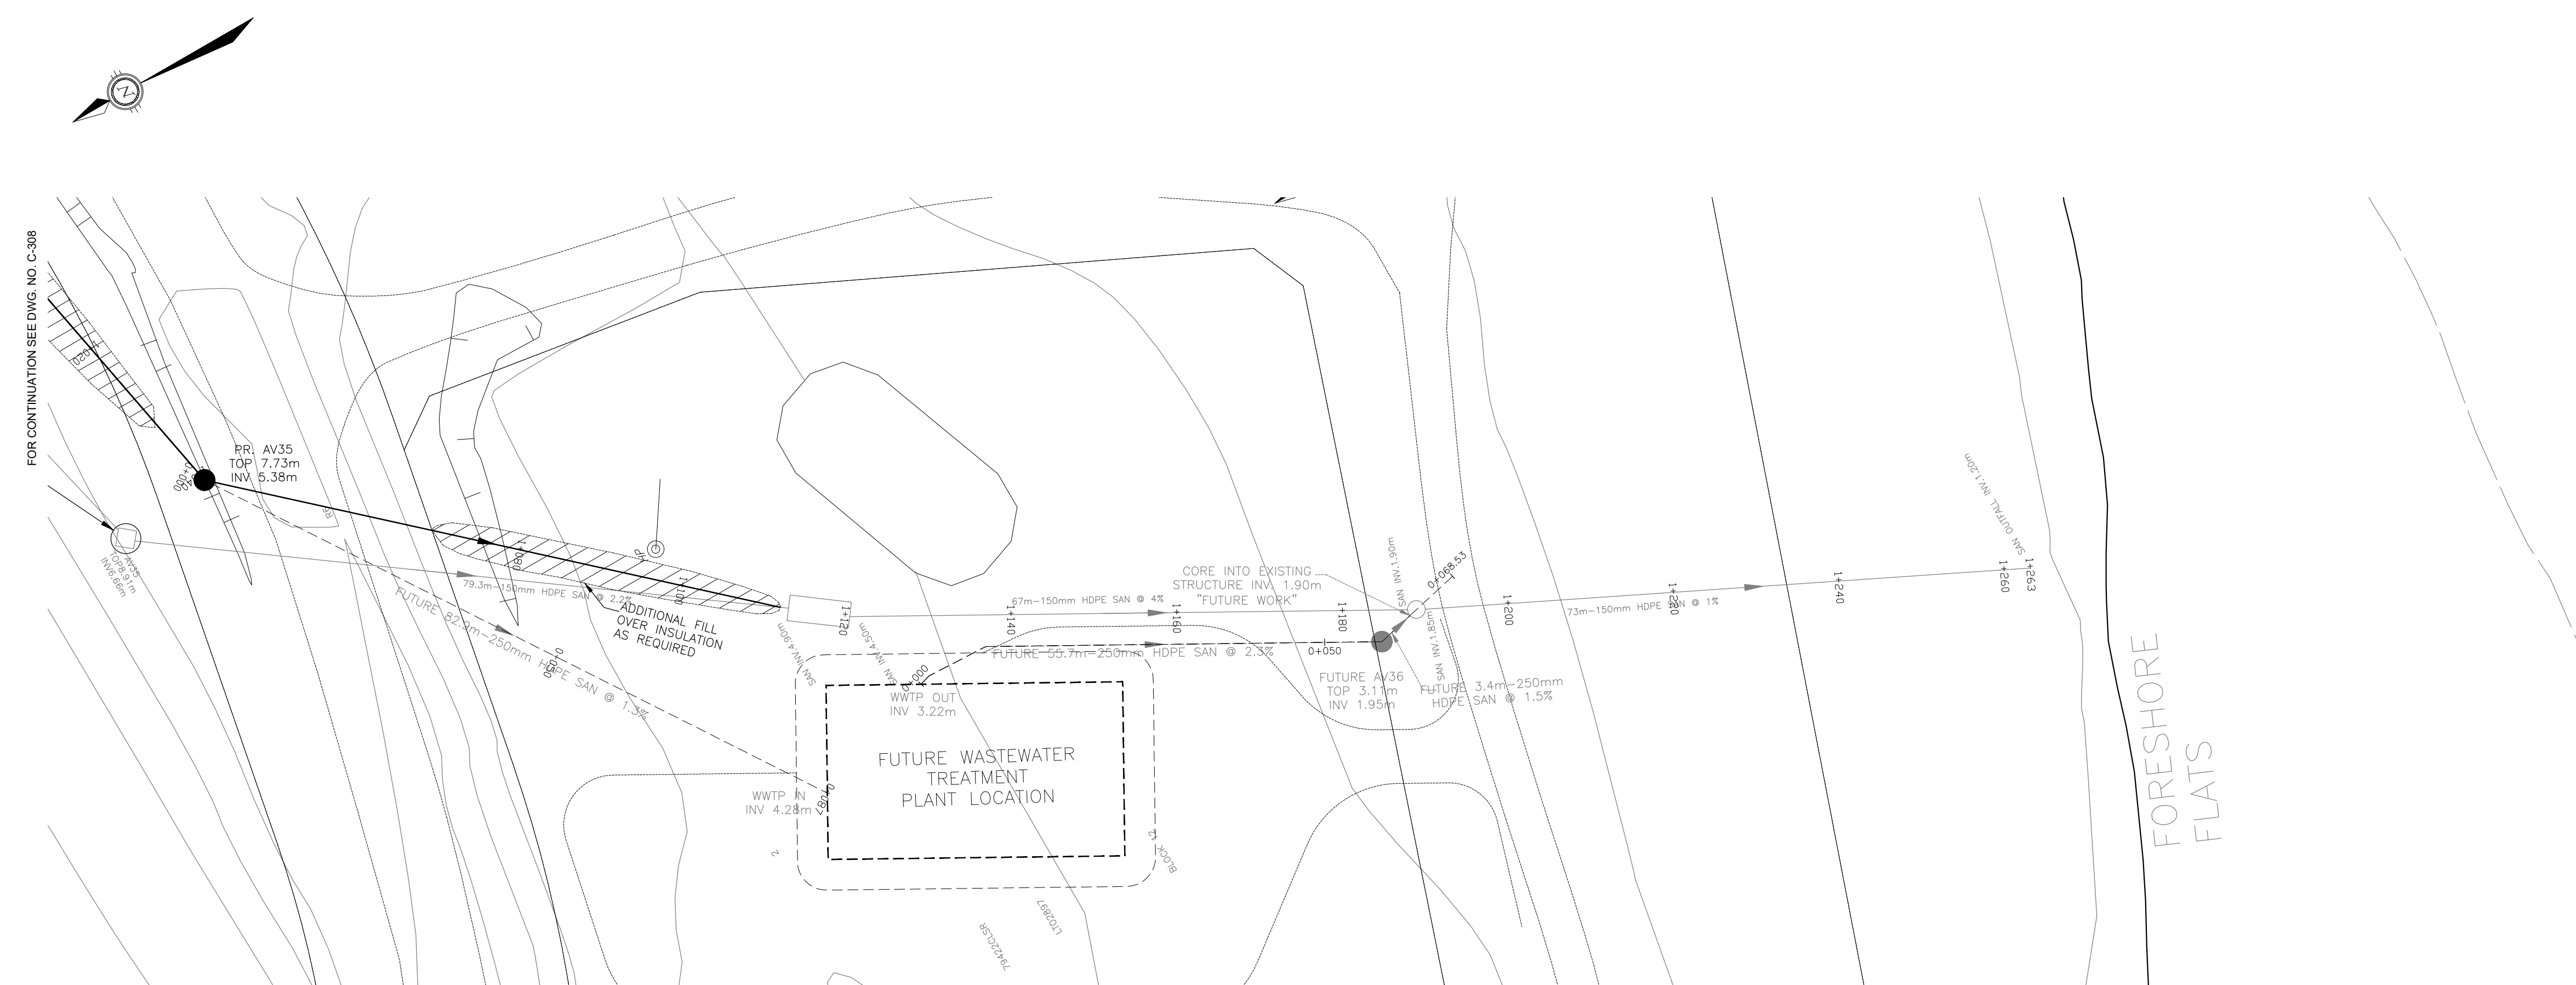

FUTURE WORK FOR INFORMATION PURPOSE ONLY

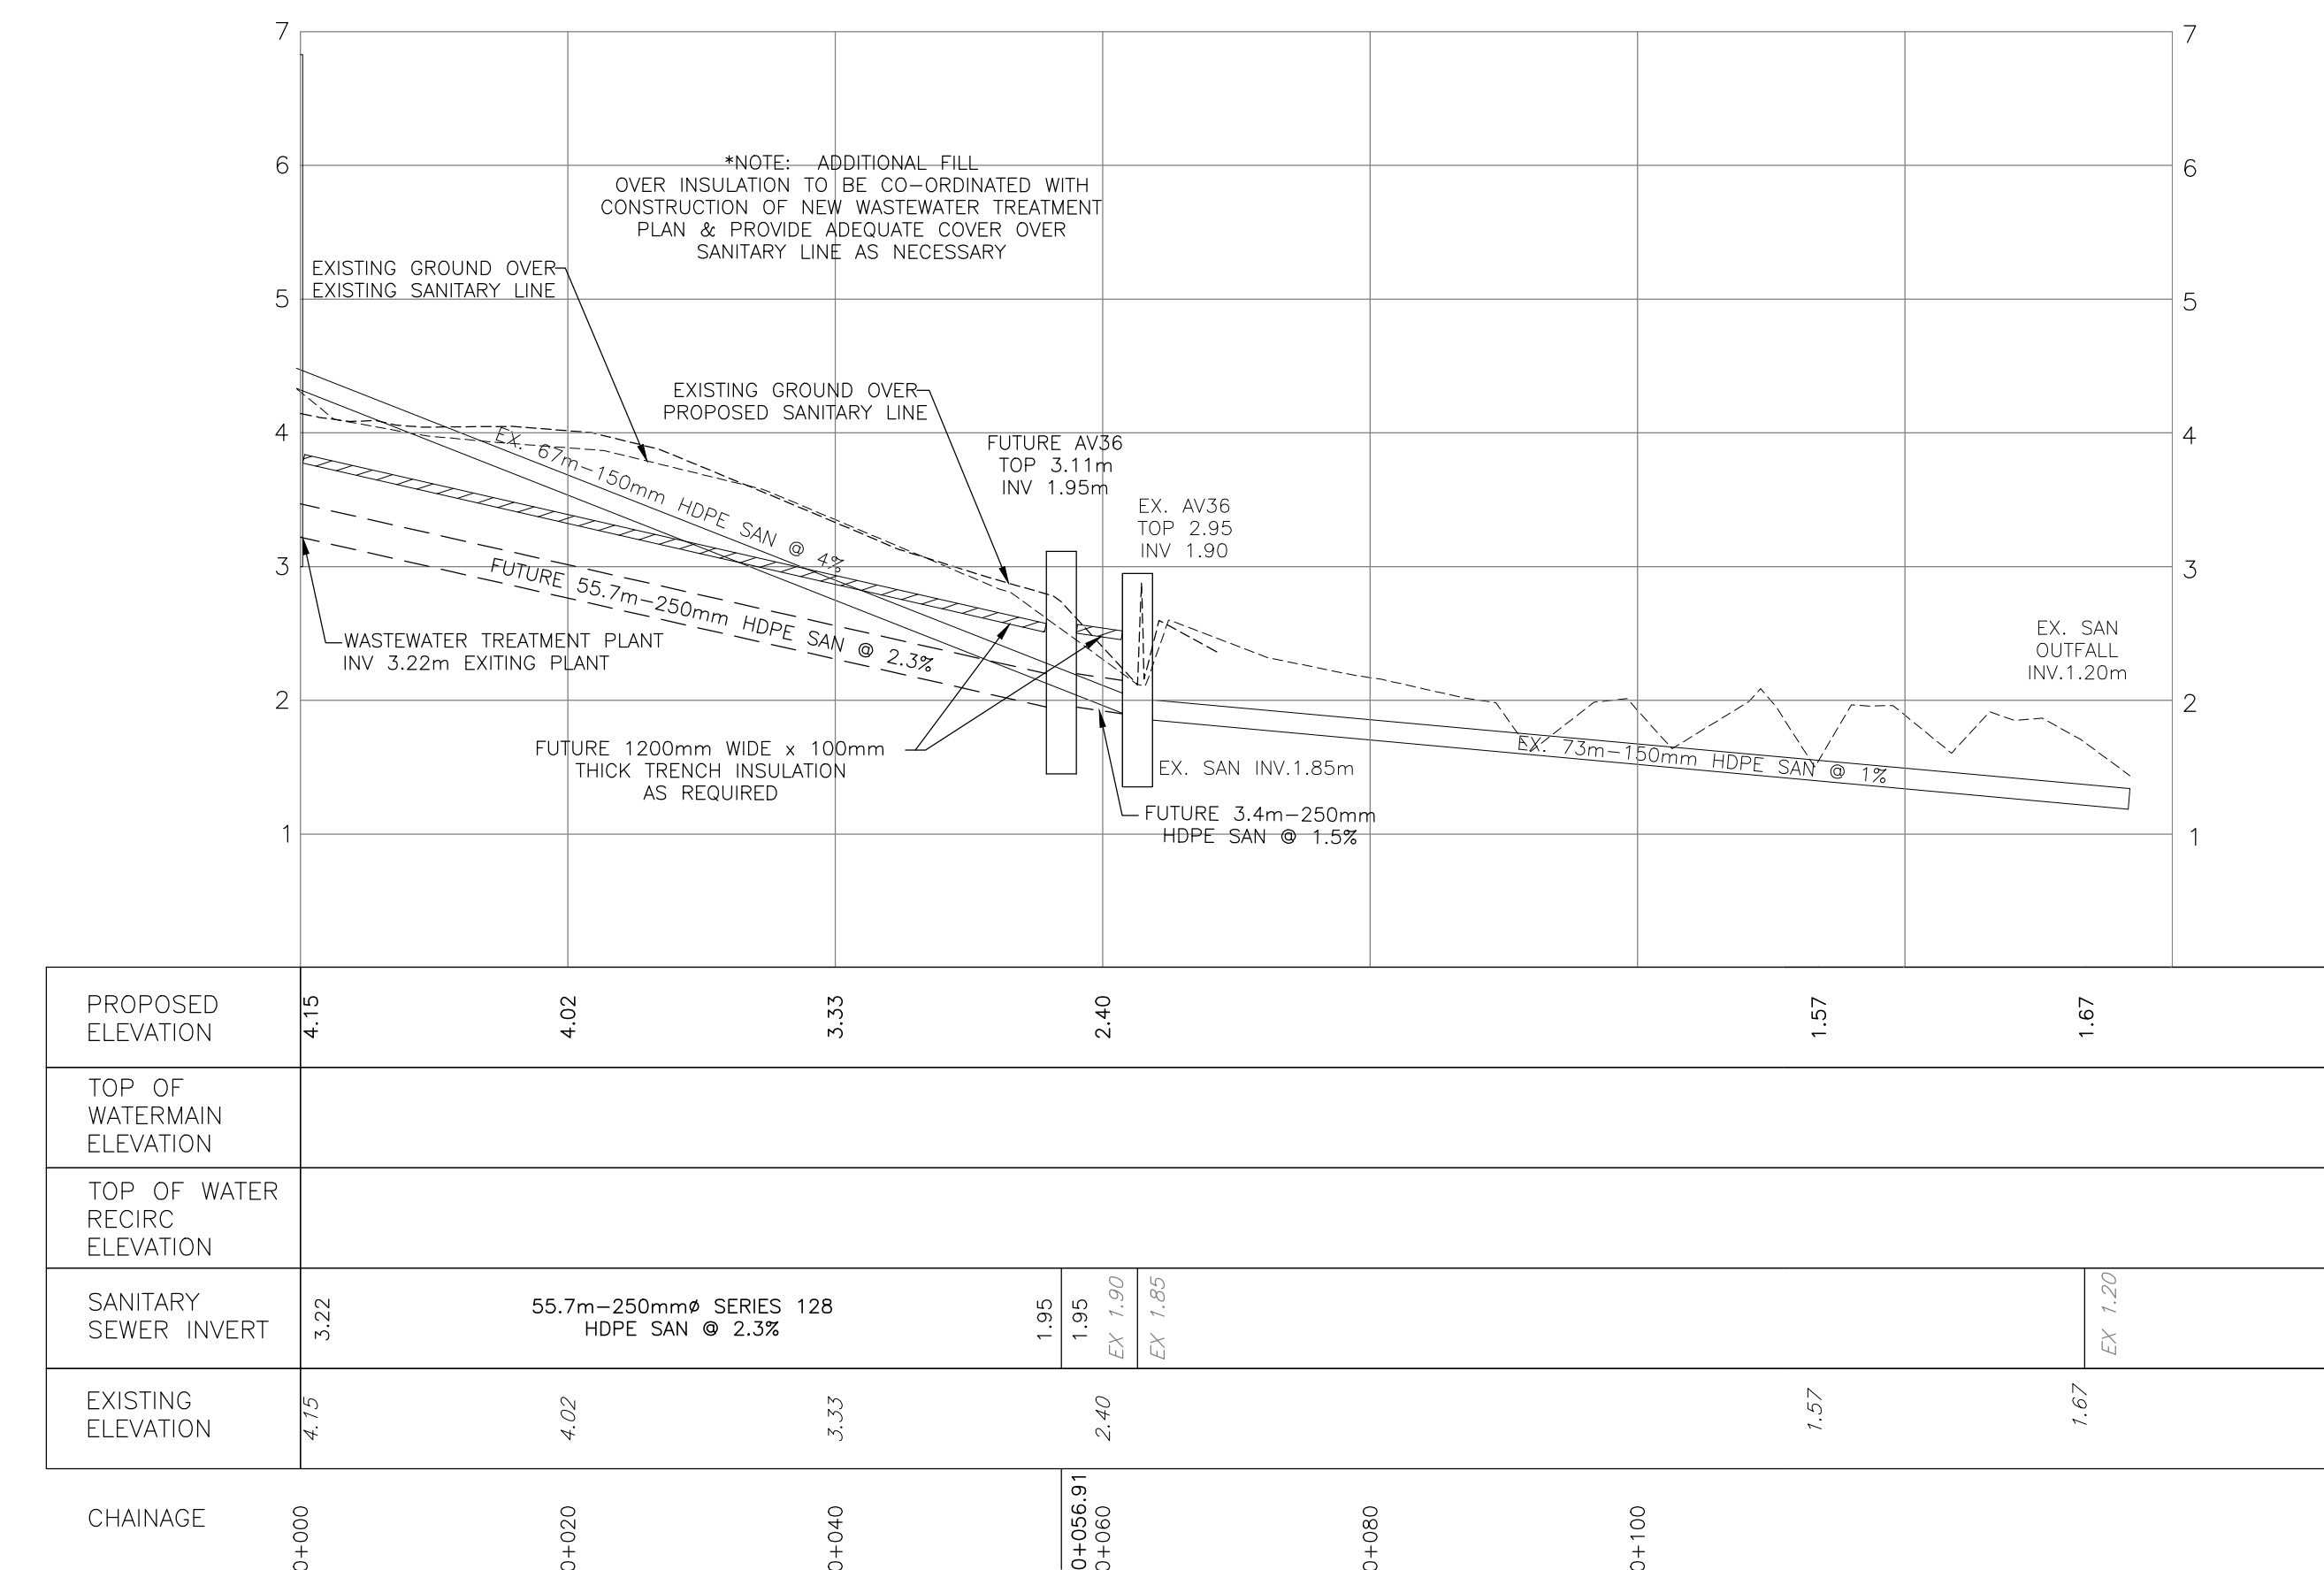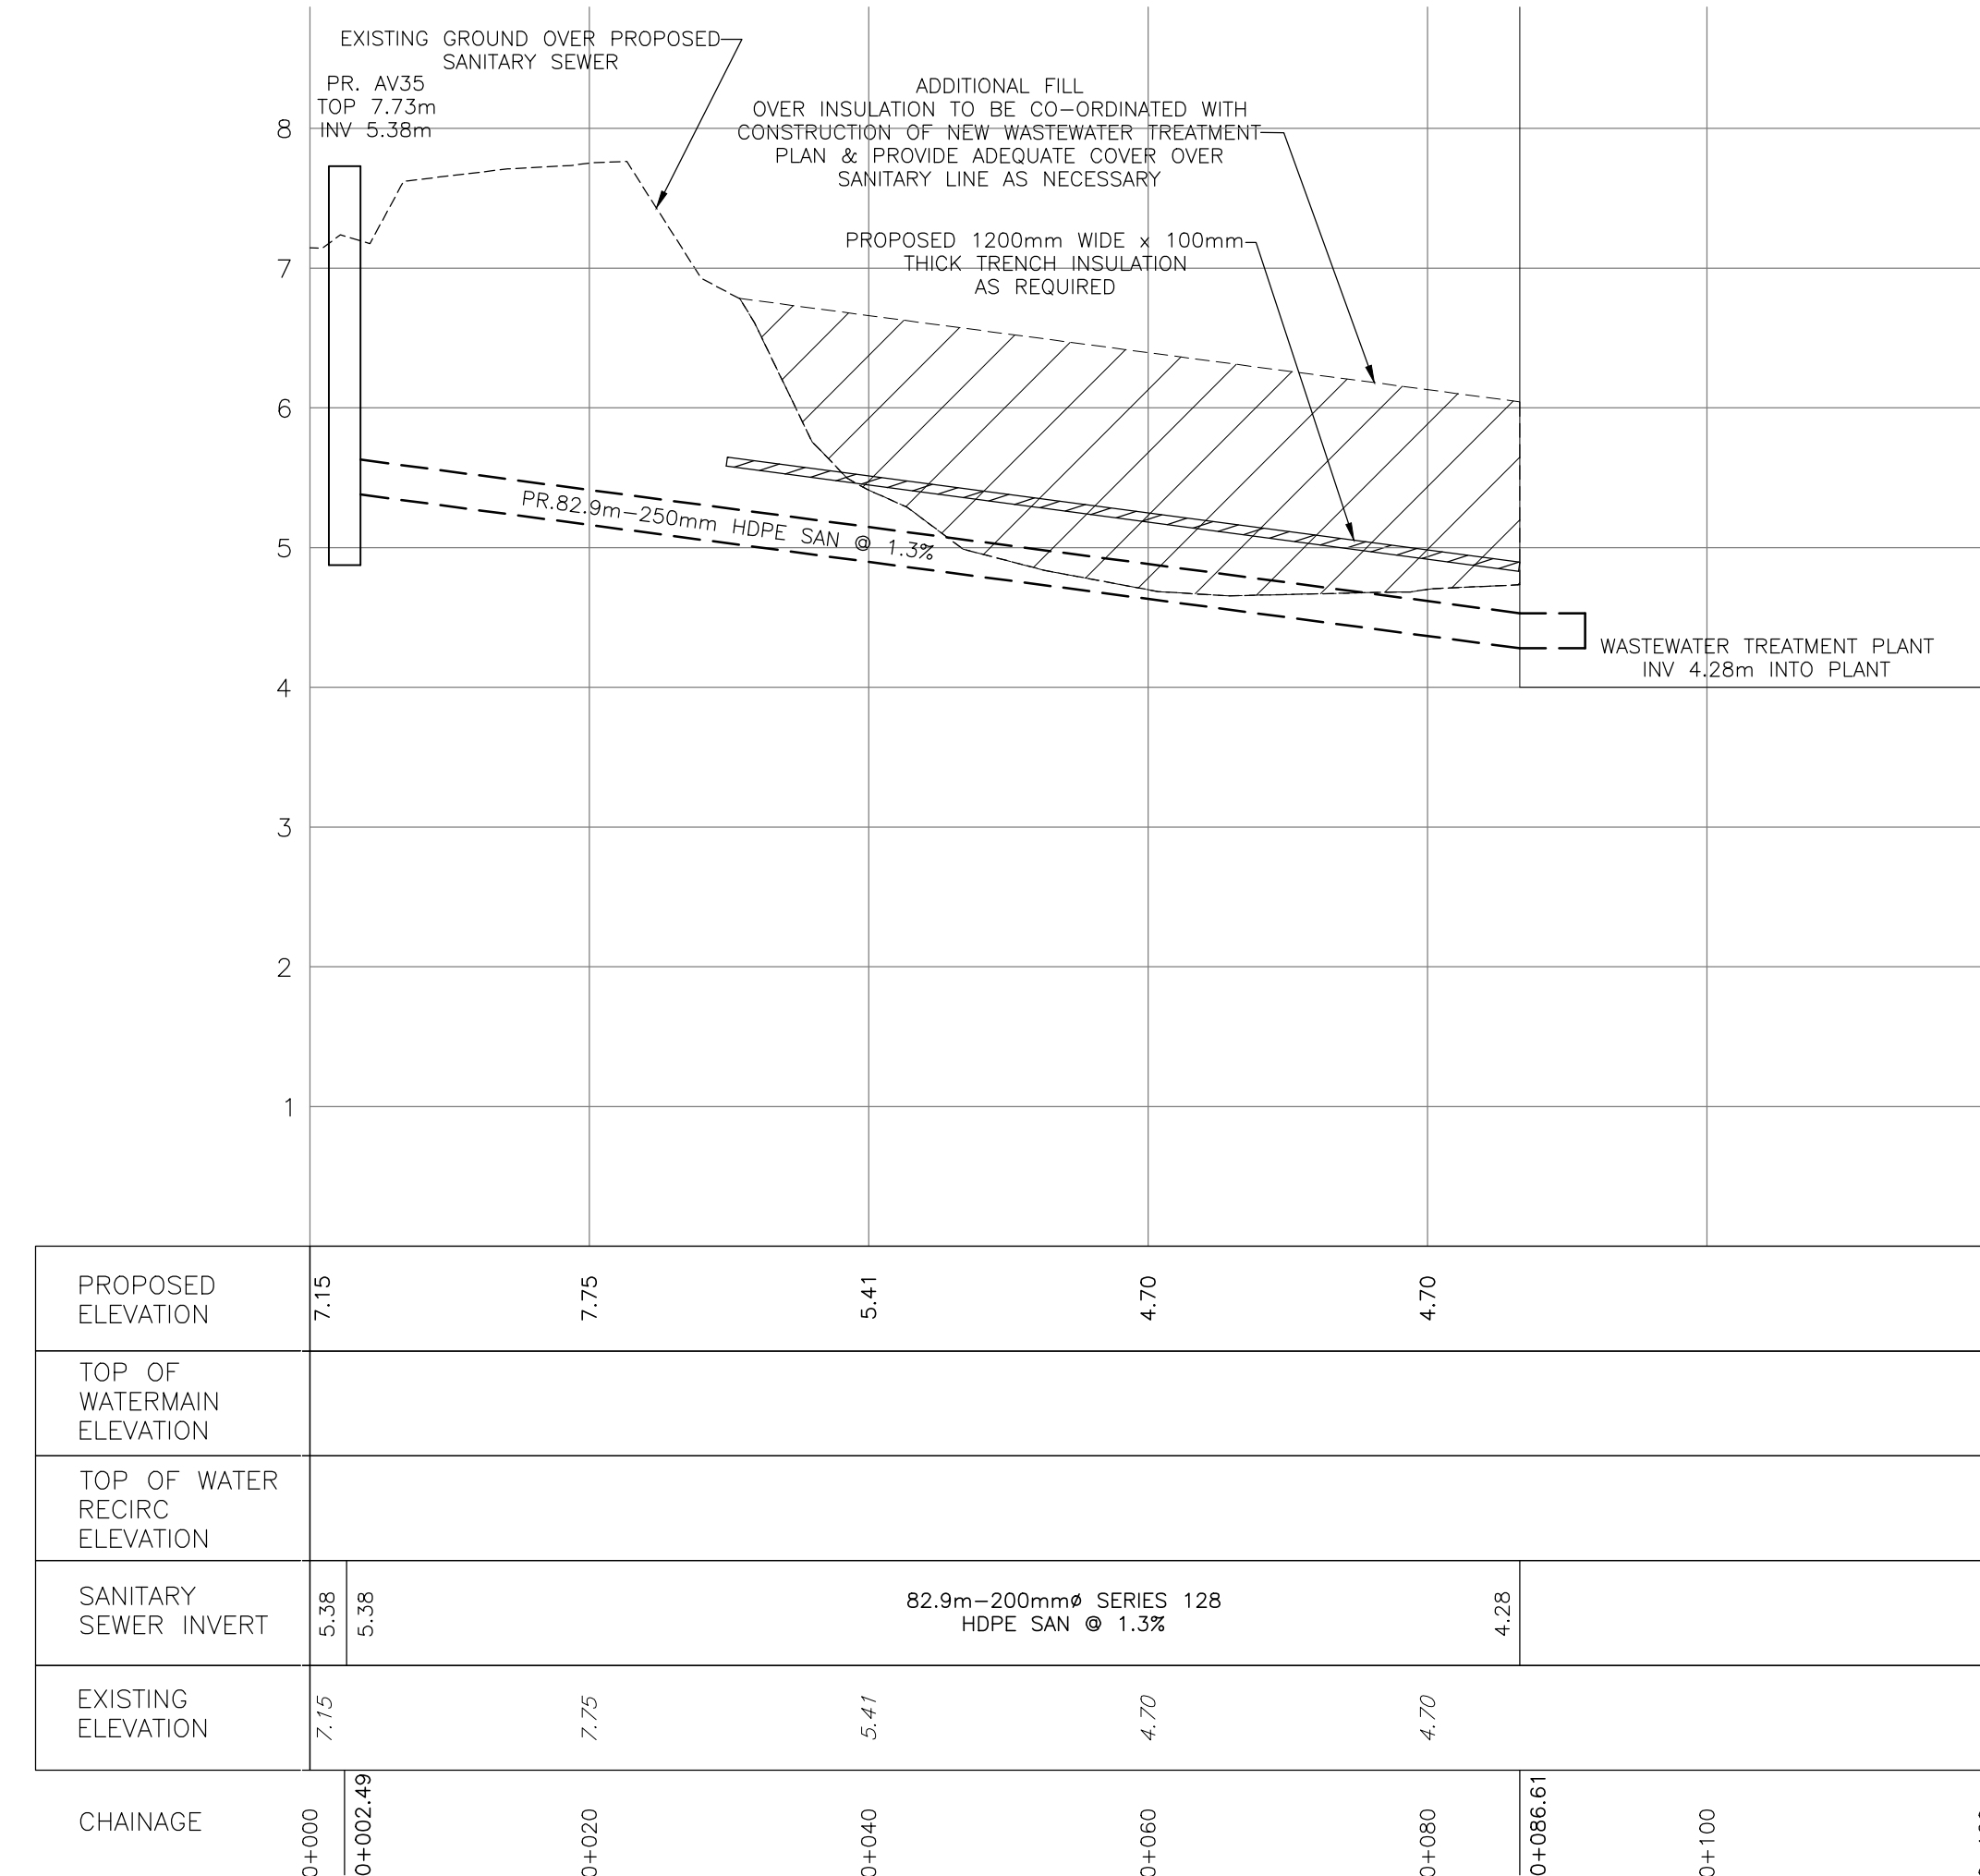

No.

Issue

Date

No.

Revision

Ckd. By

Date



AS-BUILT
DATE: APRIL 26, 2016

Const. North

Drawn By: I.CRAWFORD
Dwg. Standards Ckd. By:
Designed By: A. ZARAD
Dwg. Design Ckd. By: S. BURDEN

Date Printed

exp Services Inc.

t: +1.613.688.1899 | f: +1.613.225.7330
2650 Queensview Drive, Unit 100
Ottawa, ON K2B 8H6
CANADA
www.exp.com



BUILDINGS • EARTH & ENVIRONMENT • ENERGY • INDUSTRIAL • INFRASTRUCTURE • SUSTAINABILITY

Project Title

NEW UTILIDOR DESIGN
RESOLUTE BAY, NU

Dwg. Title

PLAN AND PROFILE
AV35 TO AV36

Project No.

OTT-00206333-A0

Dwg. No.

C-309

Rev. No.

00

Scale




1:500
This drawing is not to be scaled

exp Services Inc. © 2012

THIS DRAWING IS THE PROPERTY OF EXP SERVICES INC. AND IS NOT TO BE REPRODUCED OR TRANSMITTED IN ANY FORM OR BY ANY MEANS, ELECTRONIC OR MECHANICAL, INCLUDING PHOTOCOPYING, RECORDING, OR BY ANY INFORMATION STORAGE AND RETRIEVAL SYSTEM, WITHOUT THE WRITTEN PERMISSION OF EXP SERVICES INC. ANY REPRODUCTION OR TRANSMISSION OF THIS DRAWING WITHOUT THE WRITTEN PERMISSION OF EXP SERVICES INC. IS PROHIBITED.

NO DATA BEYOND 100M

EXP SERVICES INC.

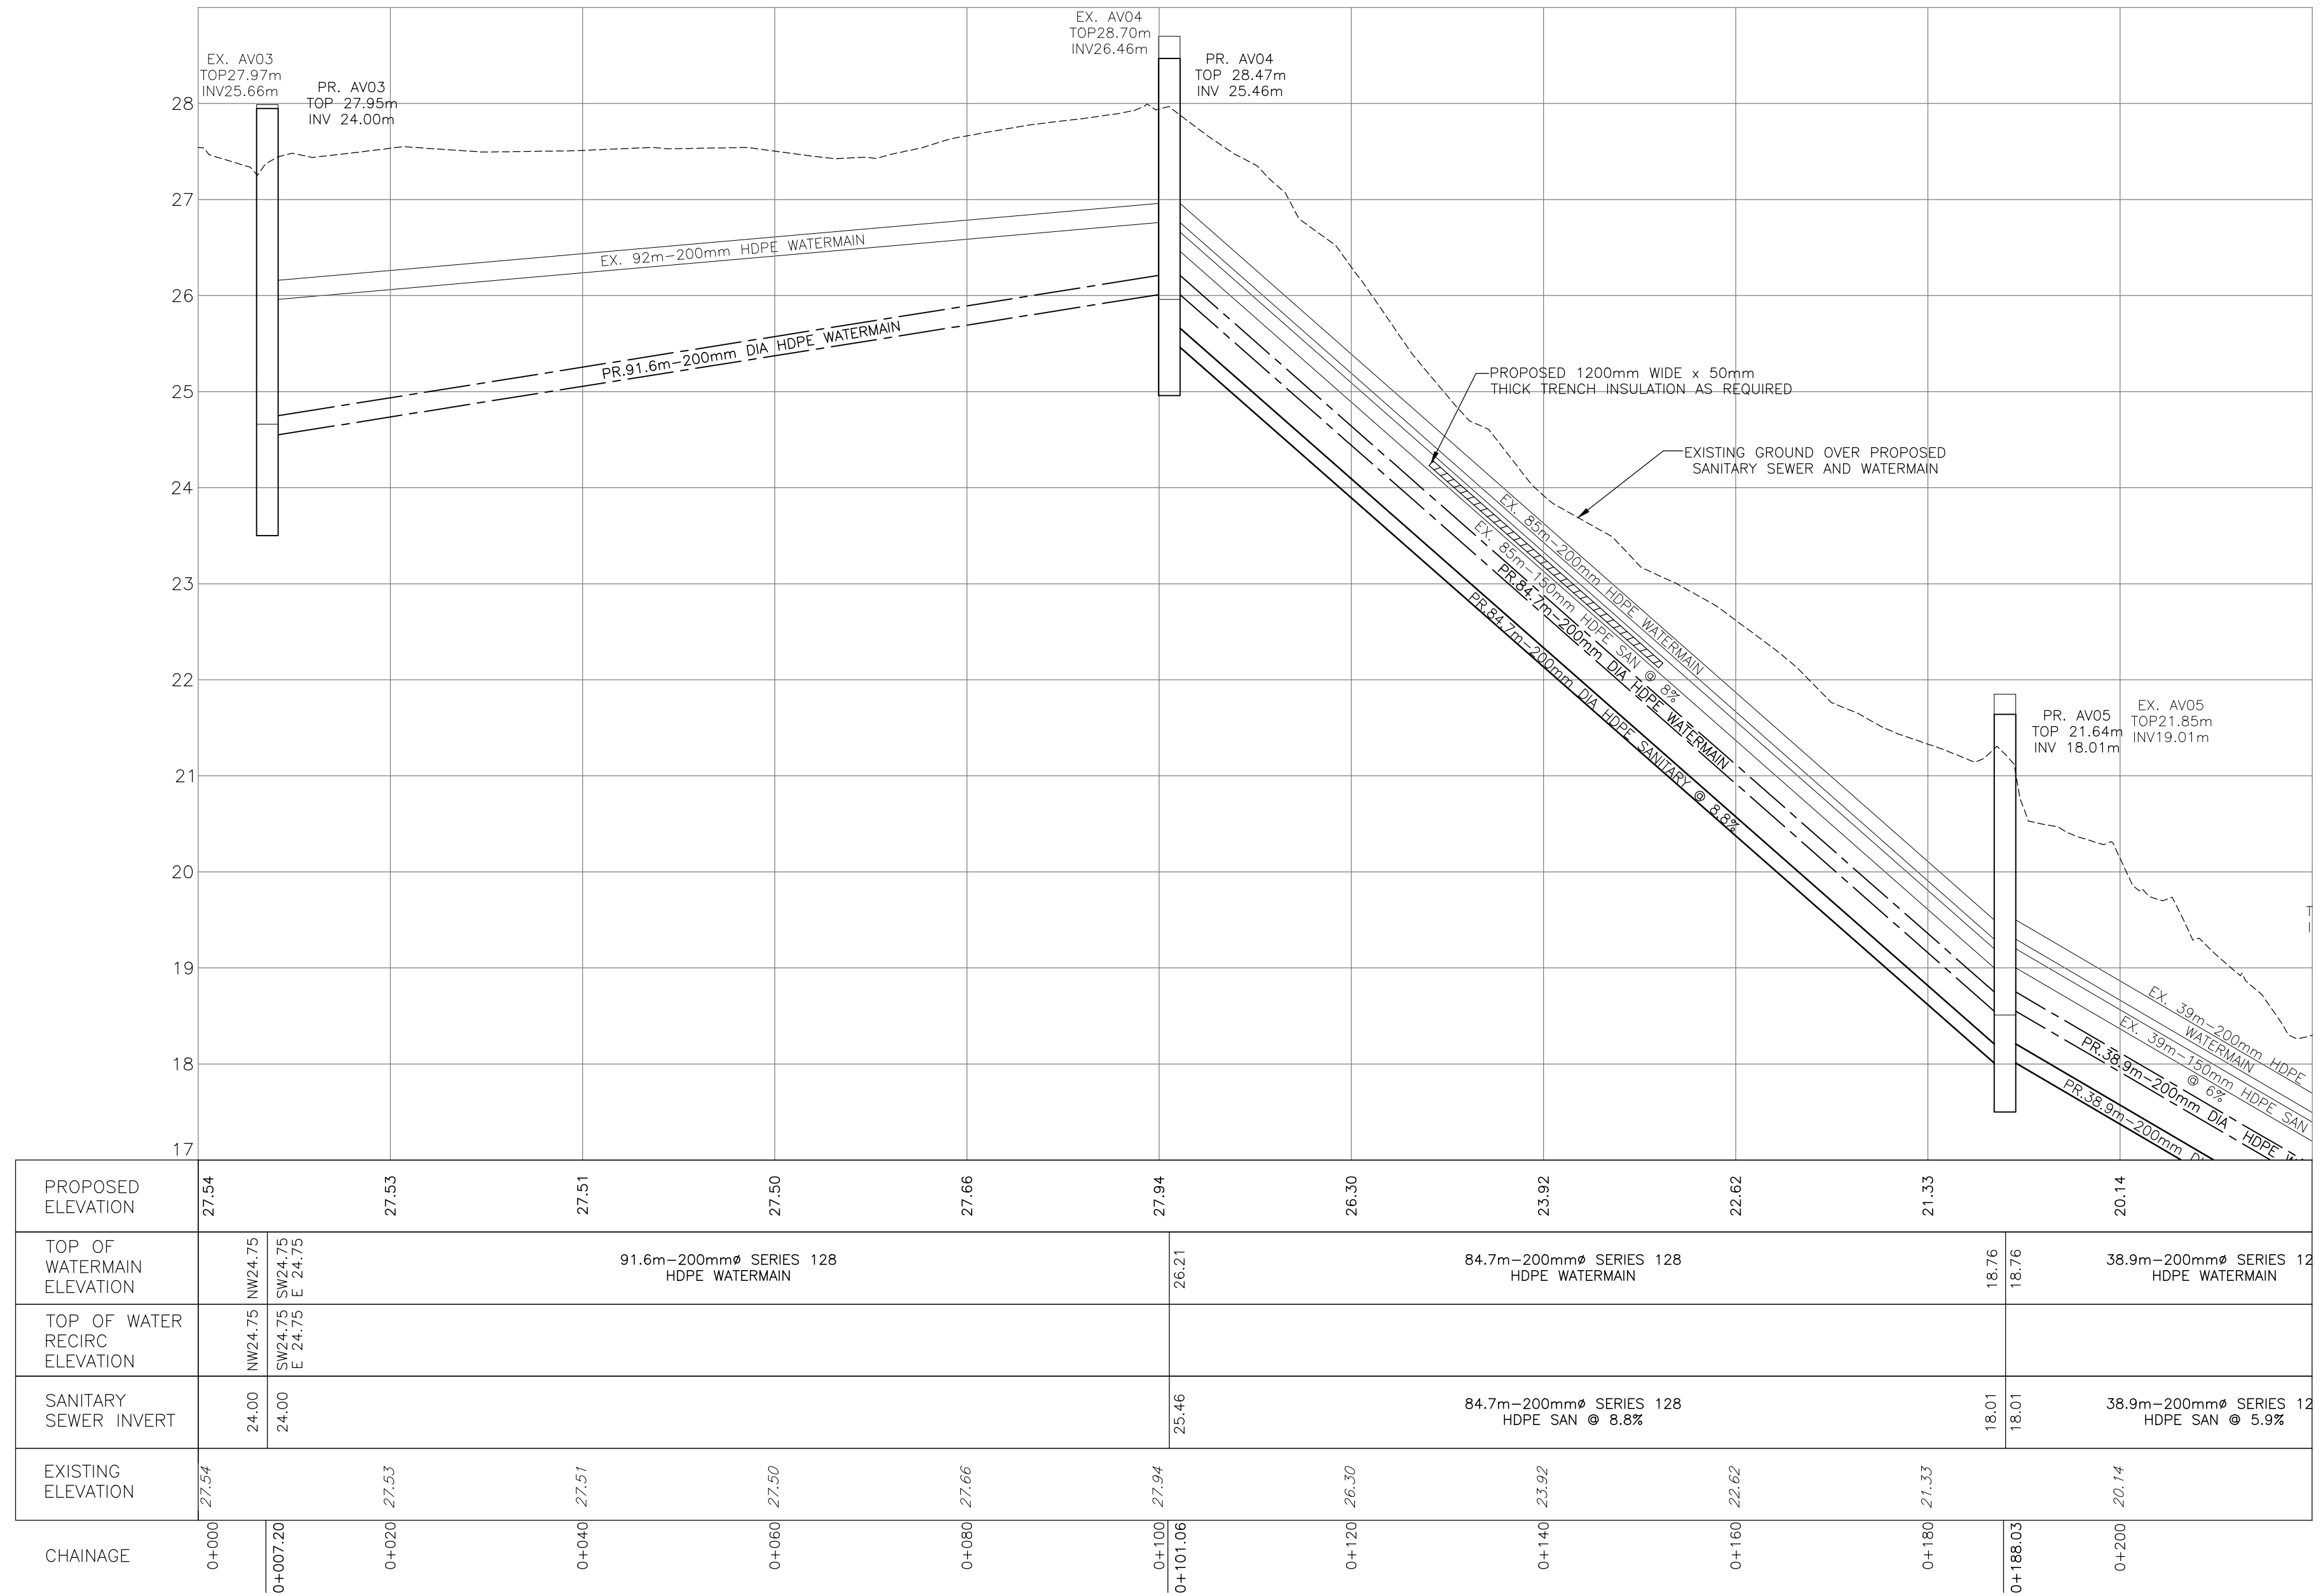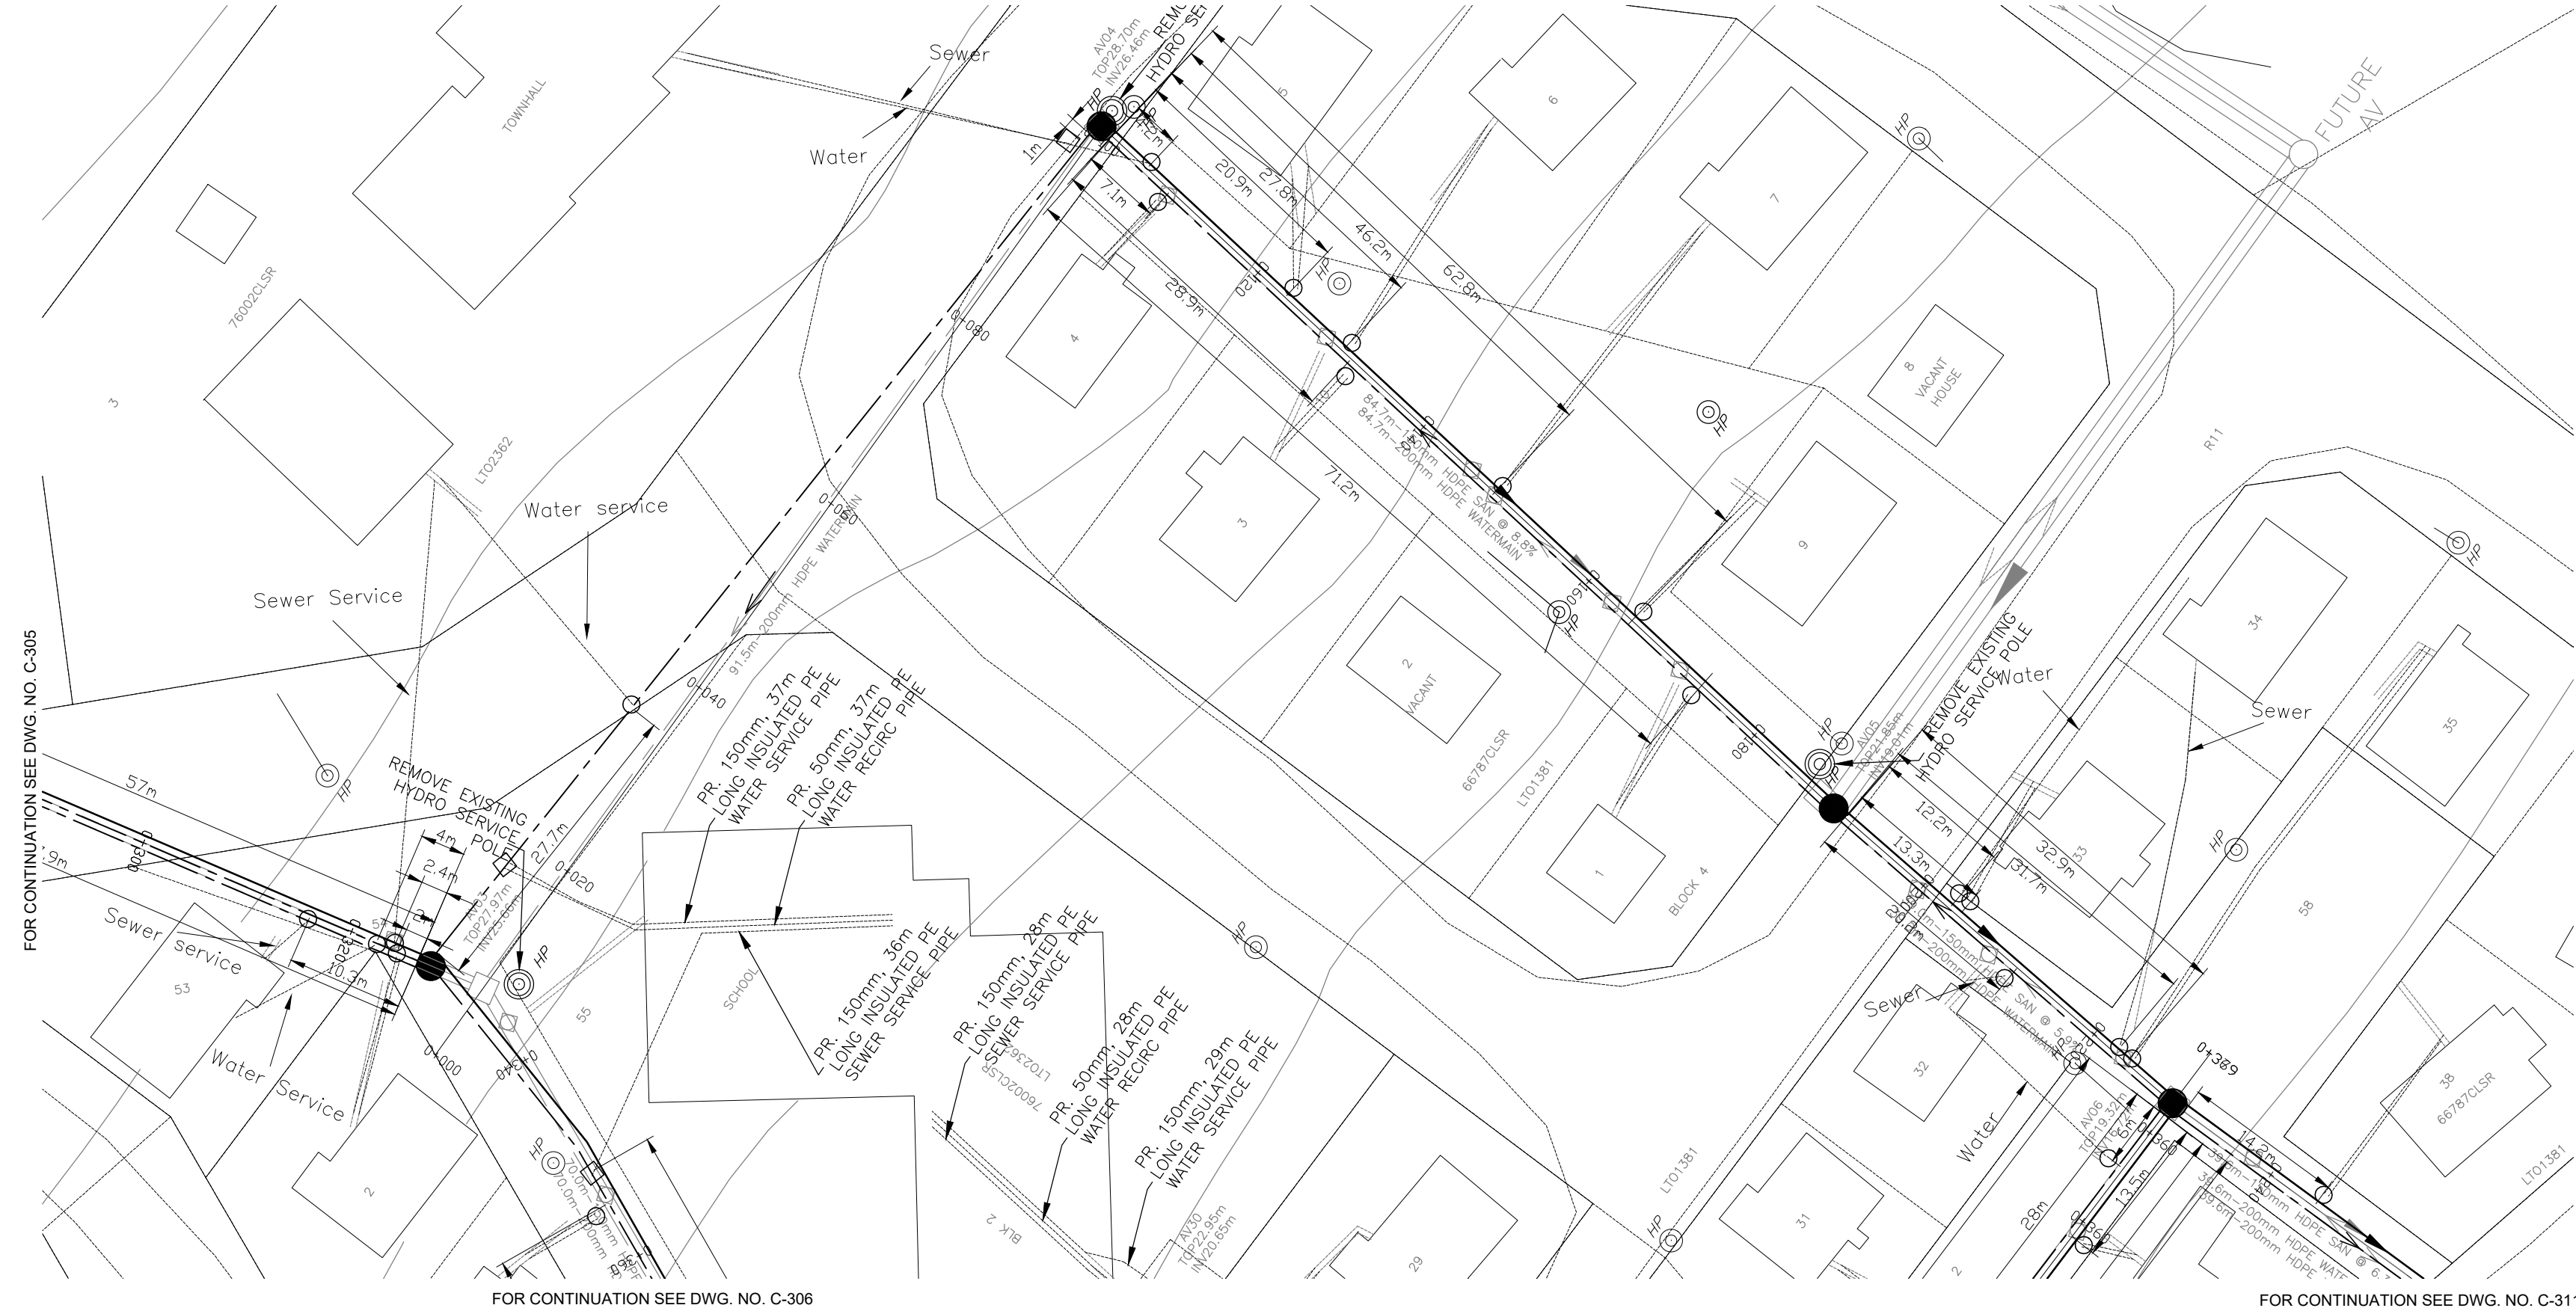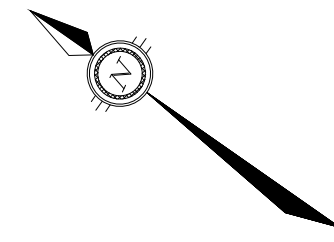

No.	Issue	Date
01	ISSUED FOR TENDER	2013-MAR-25
02	REISSUED FOR TENDER	2013-OCT-25
03	ISSUED FOR CONSTRUCTION	2014-APR-21
04	ISSUED FOR AS-BUILT	2016-APR-26

AS-BUILT

DATE: APRIL 26, 2016

No.	Revision	Ckd. By	Date
00	100% SUBMISSION	SLB	2013-MAR-04

Const. North

Drawn By: I. CRAWFORD

Dwg. Standards Ckd. By:

Designed By: A. ZARAD

Dwg. Design Ckd. By: S. BURDEN

exp Services Inc.

t: +1.613.688.1899 | f: +1.613.225.7330

2650 Queensview Drive, Unit 100

Ottawa, ON K2B 8H6

CANADA

www.exp.com

• BUILDINGS • EARTH & ENVIRONMENT • ENERGY •

• INDUSTRIAL • INFRASTRUCTURE • SUSTAINABILITY •

Project Title

NEW UTILIDOR DESIGN

RESOLUTE BAY, NU

Dwg. Title

PLAN AND PROFILE

AV03 TO AV05



Project No. OTT-00206333-A0

Dwg. No. C-310

Rev. No. 03

Scale 1:500

This drawing is not to be scaled

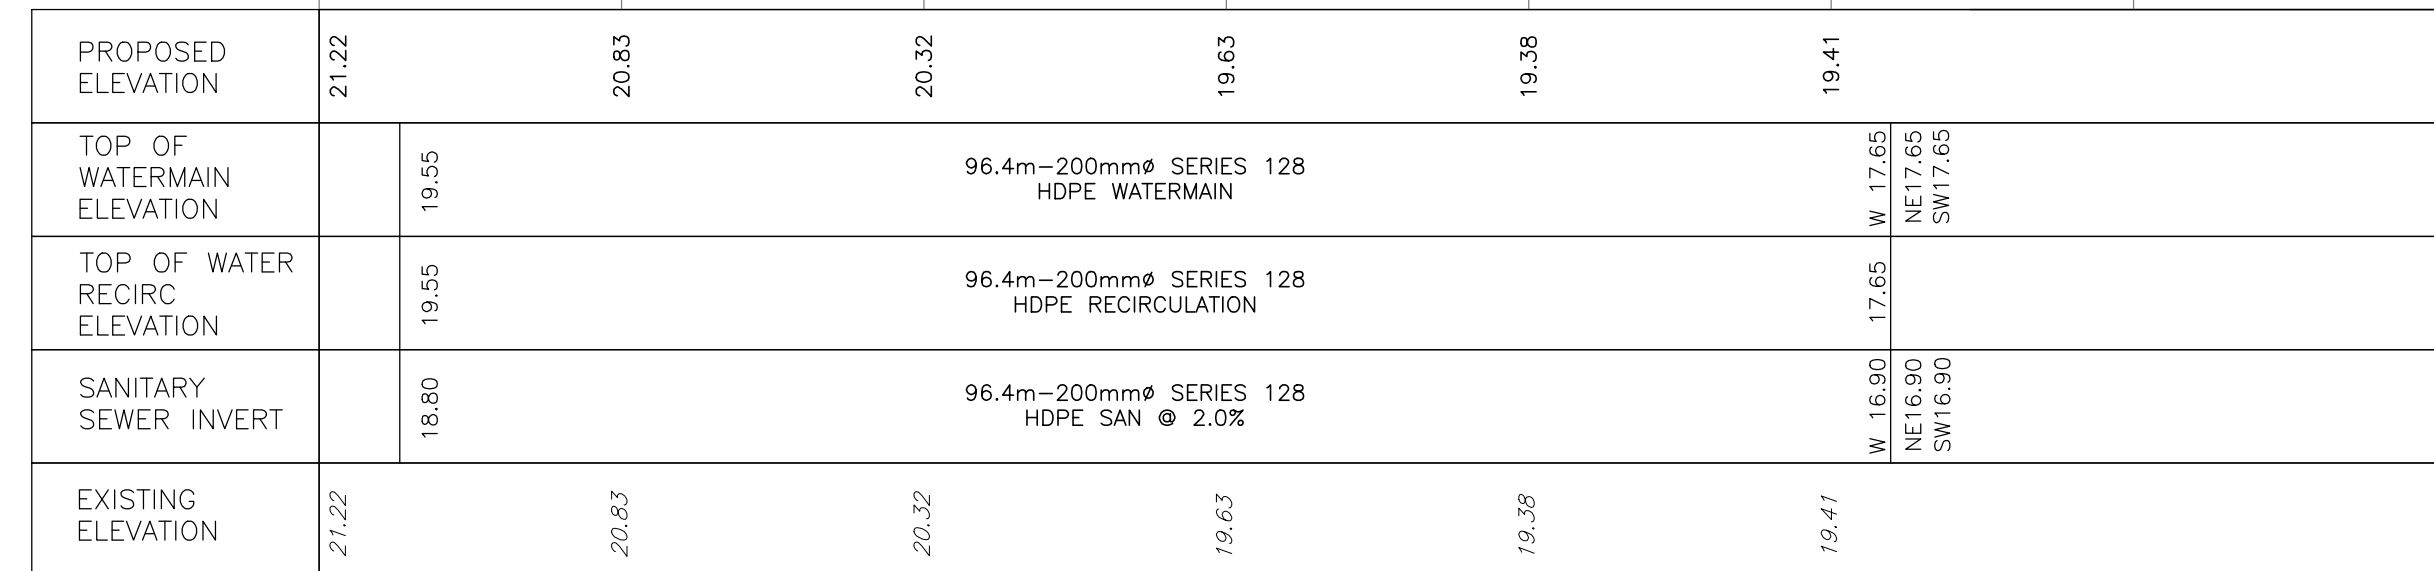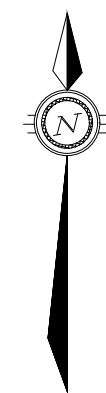

DATE: APRIL 26, 2016

No.	Revision	Ckd. By	Date
-----	----------	---------	------

Date Printed	Dwg. Design
--------------	-------------

www.exp.com



Project Title


Dwg. Title

Project No. **OTT-00206333-A0**

Scale	
-------	--

1:500

This drawing is not to be scaled

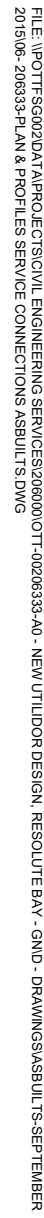

No.	Issue	Date
01	ISSUED FOR TENDER	2013-MAR-25
02	REISSUED FOR TENDER	2013-OCT-25
03	ISSUED FOR CONSTRUCTION	2014-APR-21
04	ISSUED FOR AS-BUILT	2016-APR-26



AS-BUILT

DATE: APRIL 26, 2016

00	100% SUBMISSION	SLB	2013-MAR-04
No.	Revision	Ckd. By	Date

	Const. North
	Drawn By: I. CRAWFORD
	Dwg. Standards Ckd. By:
	Designed By: A. ZARAD
Date Printed	Dwg. Design Ckd. By: S. BURDEN

exp Services Inc.
t: +1.613.688.1899 | f: +1.613.225.7330
2650 Queensview Drive, Unit 100
Ottawa, ON K2B 8H6
CANADA
www.exp.com



• BUILDINGS • EARTH & ENVIRONMENT • ENERGY •
• INDUSTRIAL • INFRASTRUCTURE • SUSTAINABILITY •

Project Title

NEW UTILIDOR DESIGN RESOLUTE BAY, NU


Dwg. Title

PLAN AND PROFILE AV17 TO AV21


Project No.	OTT-00206333-A0
Dwg. No.	C-313
Rev. No.	03
Scale	

1:500

This drawing is not to be scaled

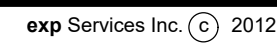


Project Title		
NEW UTILIDOR DESIGN RESOLUTE BAY, NU		
Dwg. Title		
PLAN AND PROFILE AV21 TO AV06		
Project No.		
OTT-00206333-A0		
Dwg. No.	C-314	Rev. No.
Scale		03

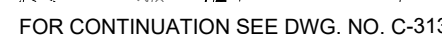

DATE: APRIL 26, 2016

--

exp Services Inc.
t: +1.613.688.1899 | f: +1.613.225.7330
2650 Queensview Drive, Unit 100
Ottawa, ON K2B 8H6
CANADA
www.exp.com

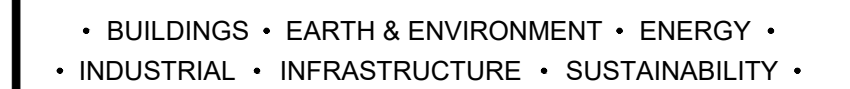




Dwg. Title

Project No.	OTT-00206333-A0
-------------	-----------------

Scale	1:500
-------	-------

NO DATA BEYOND 0+180

NO DATA BEYOND 0+180

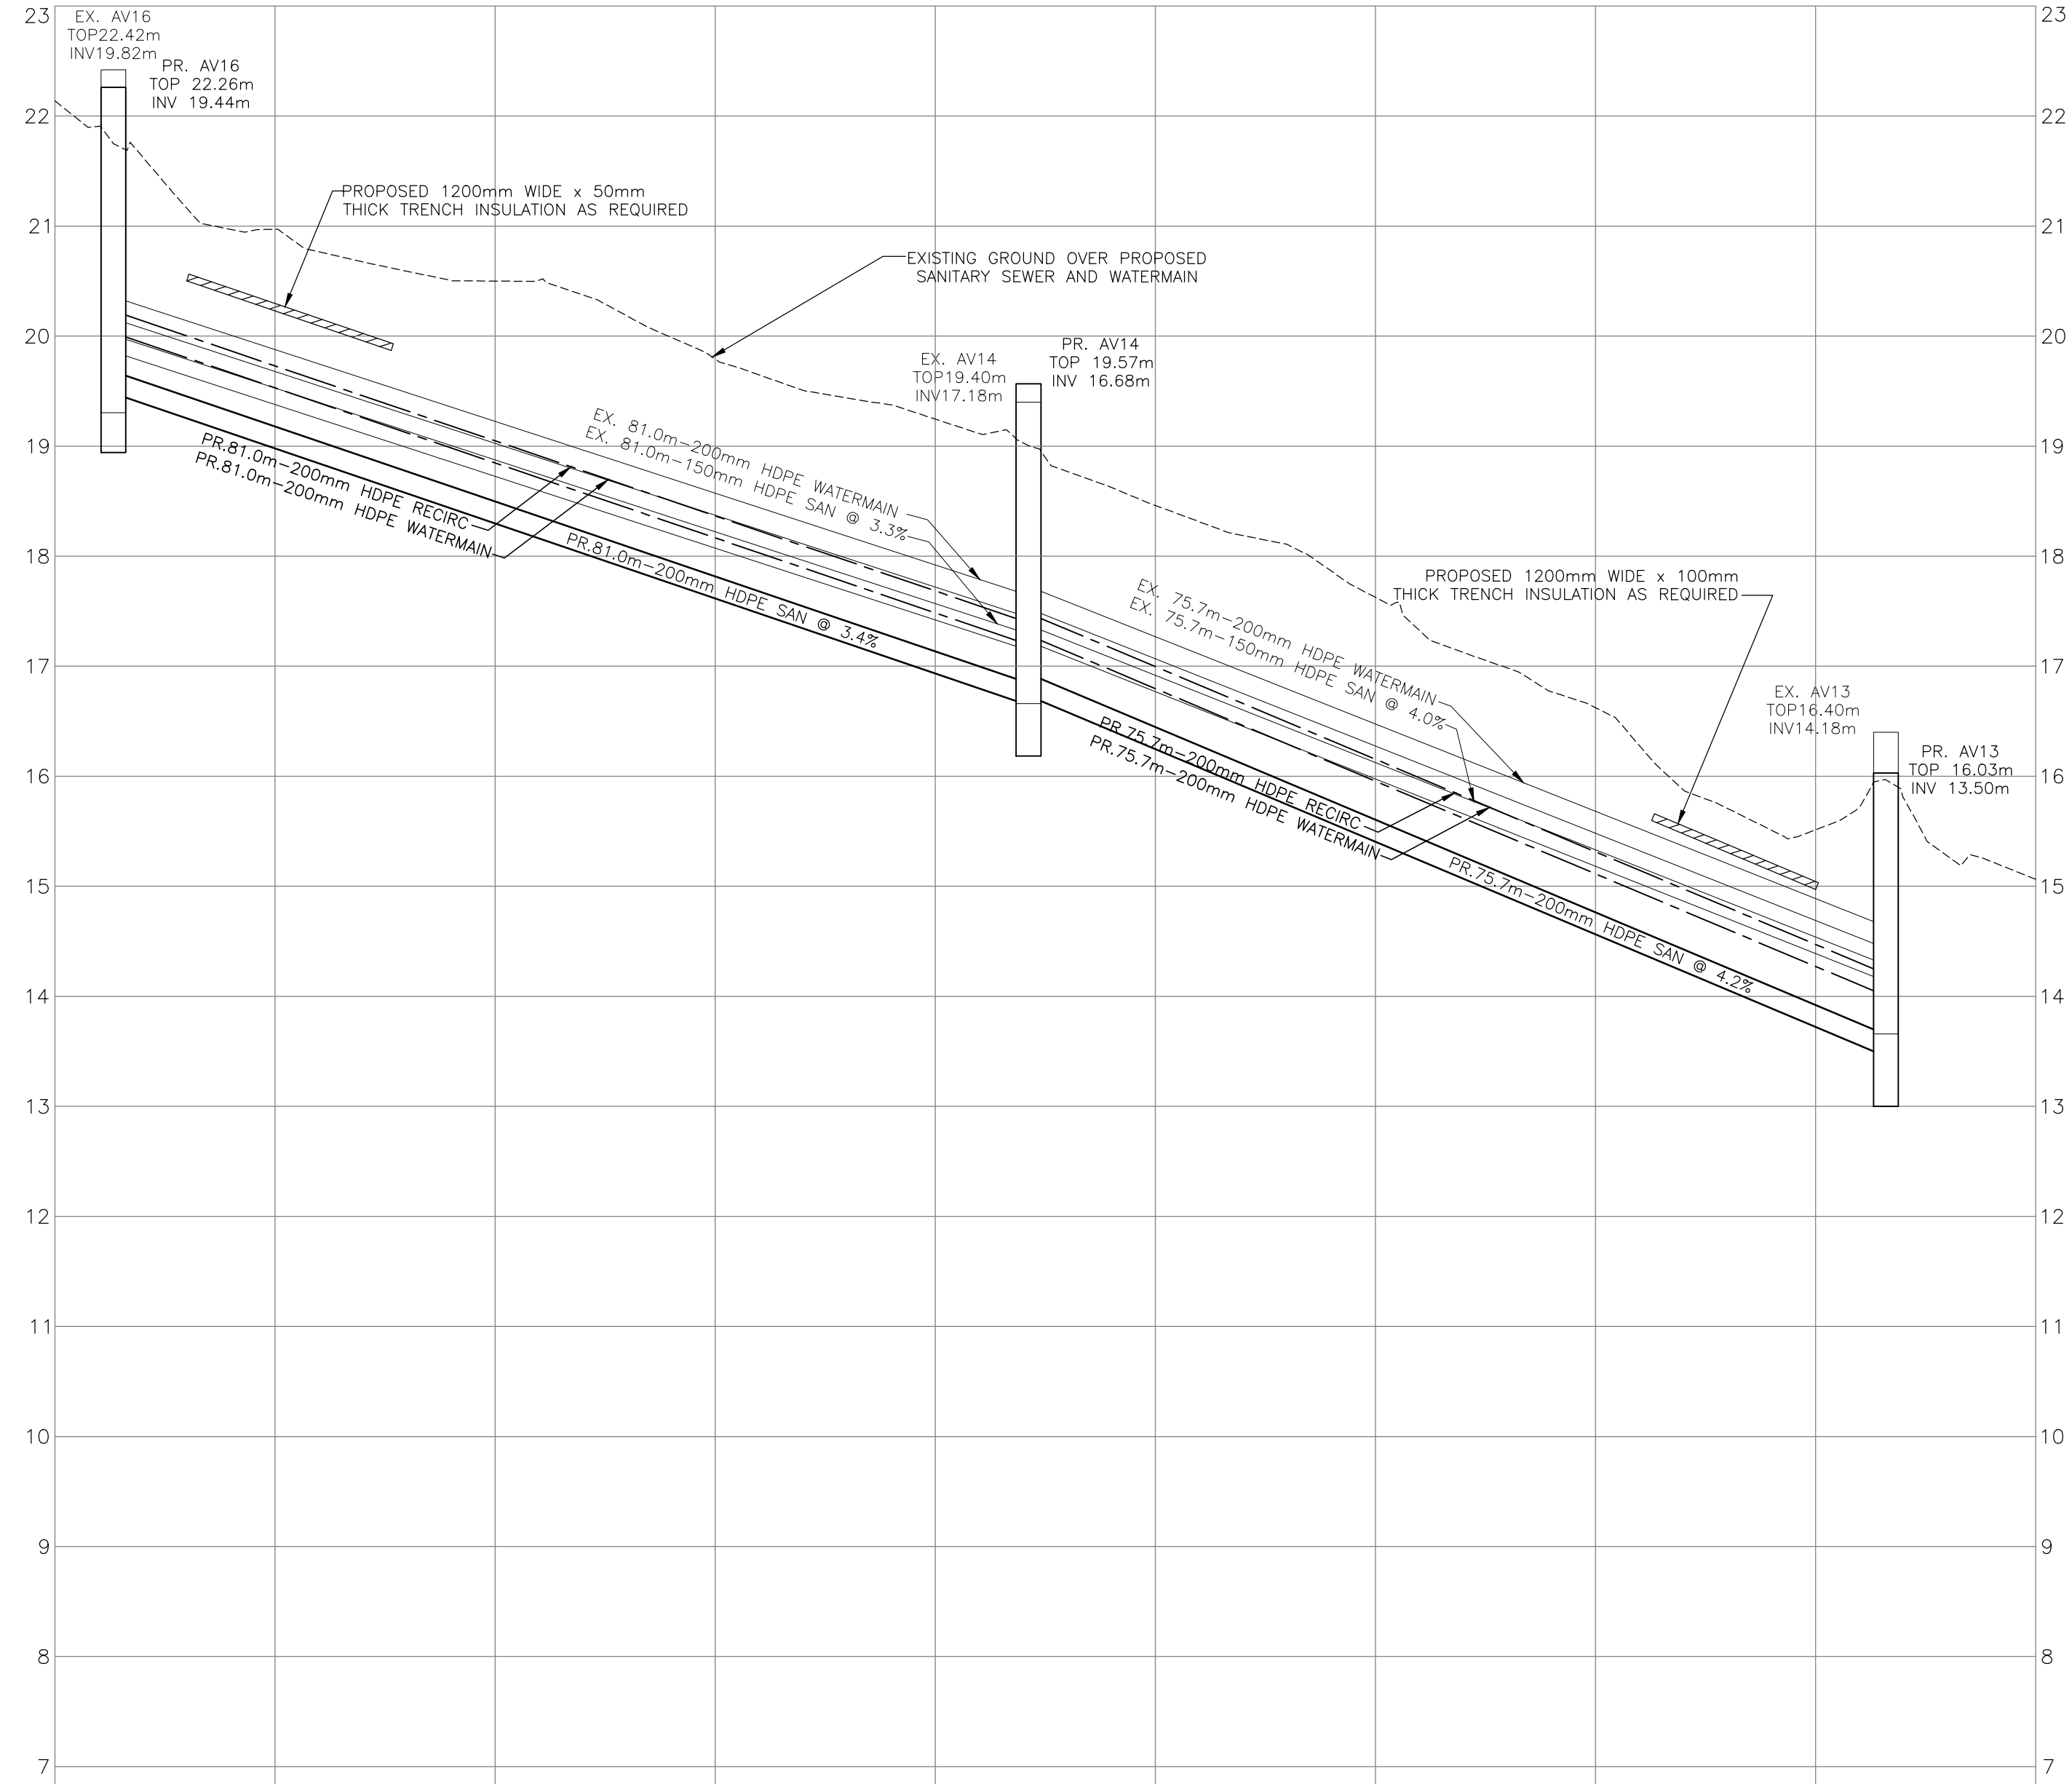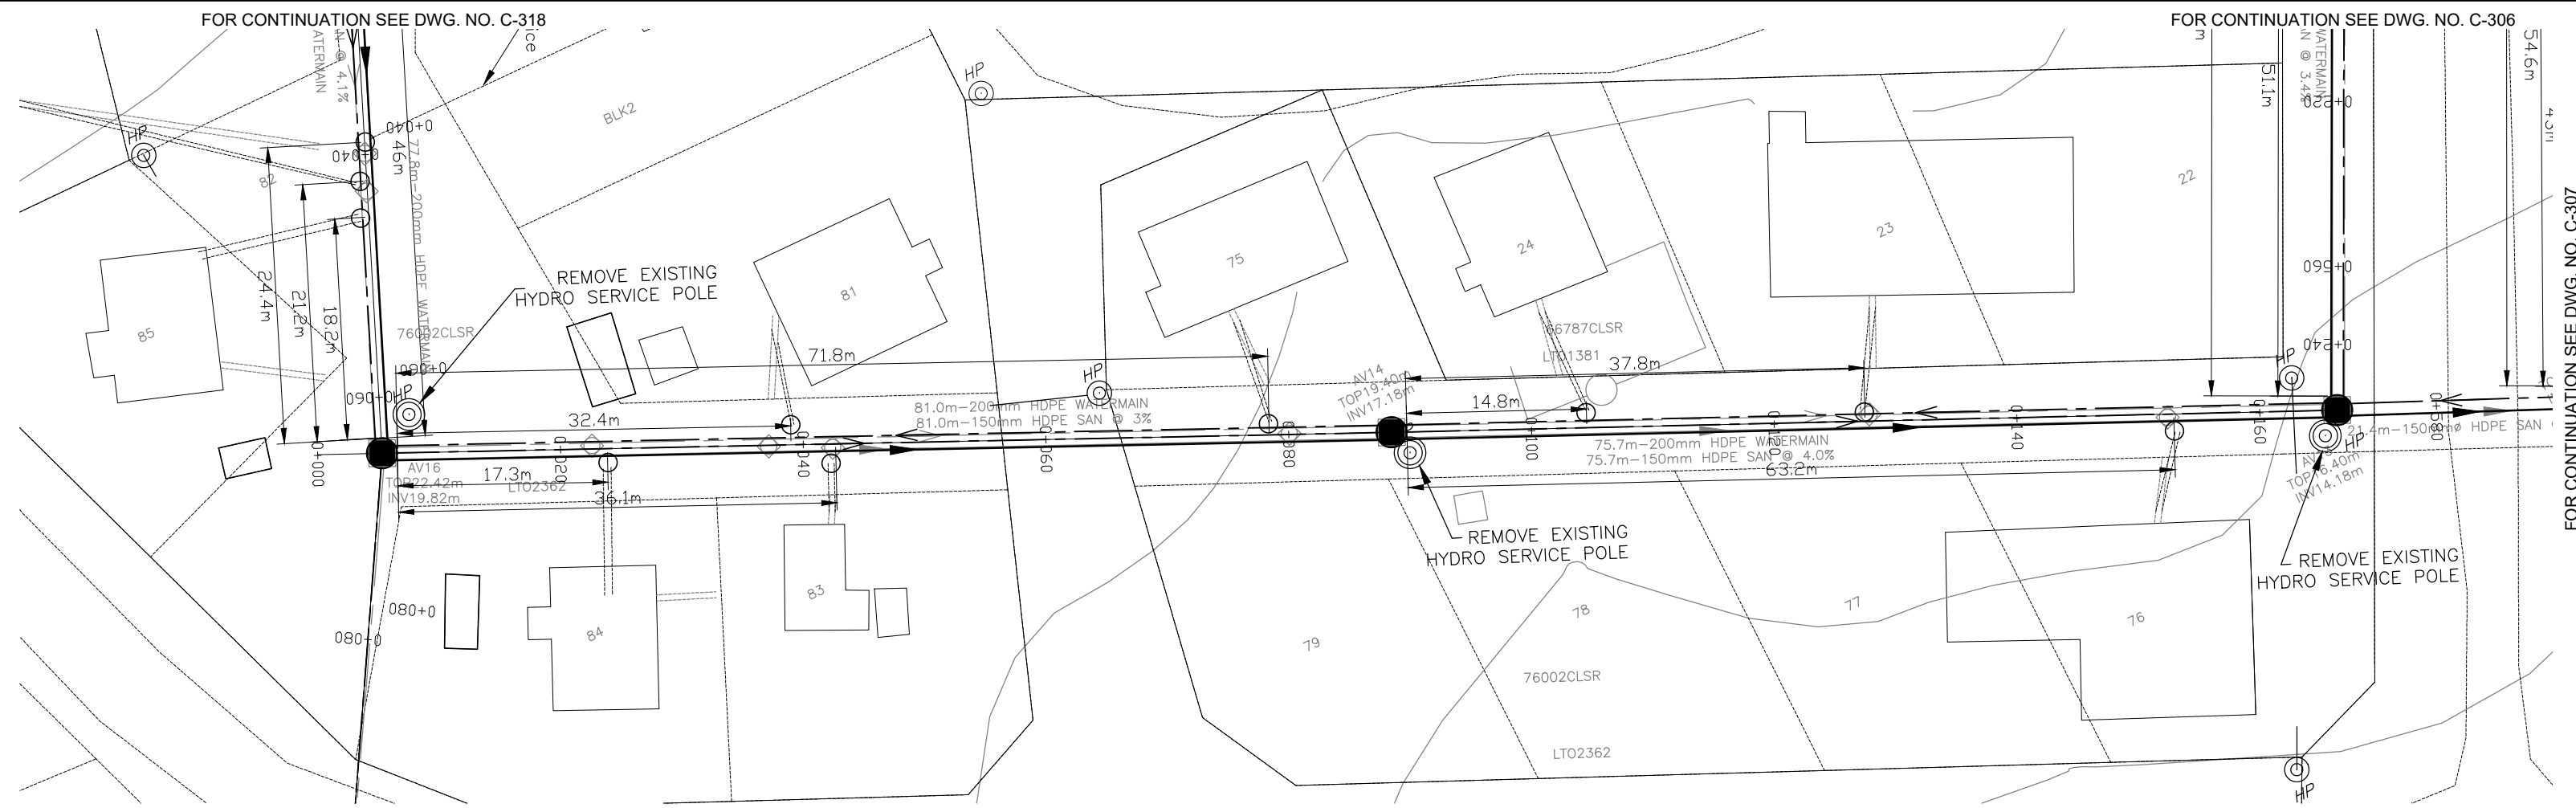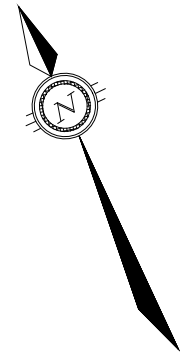

PROPOSED ELEVATION	22.14		20.97		20.50		19.79		19.25		18.46		17.63		16.62		15.51	
TOP OF WATERMAIN ELEVATION	NE20.19 NW20.19	SE20.19	81.0m-200mmØ SERIES 128 HDPE WATERMAIN		17.43 17.43		75.7m-200mmØ SERIES 128 HDPE WATERMAIN						NW14.25 SE14.25		NE14.25			
TOP OF WATER RECIRC ELEVATION		20.19	81.0m-200mmØ SERIES 128 HDPE RECIRCULATION		17.43 17.43		75.7m-200mmØ SERIES 128 HDPE RECIRCULATION						14.25					
SANITARY SEWER INVERT	19.44	19.44	81.0m-200mmØ SERIES 128 HDPE SAN @ 3.4%		16.68 16.68		75.7m-200mmØ SERIES 128 HDPE SAN @ 4.2%						NW13.50 SE13.50		NE13.50			
EXISTING ELEVATION	22.14		20.97		20.50		19.79		19.25		18.46		17.63		16.62		15.51	
CHAINAGE	0+000	0+005.31	0+020		0+040		0+060		0+080		0+100		0+120		0+140		0+160	
									0+085.45								0+165.39	

No.	Issue	Date
01	ISSUED FOR TENDER	2013-MAR-25
02	REISSUED FOR TENDER	2013-OCT-25
03	ISSUED FOR CONSTRUCTION	2014-APR-21
04	ISSUED FOR AS-BUILT	2016-APR-26



AS-BUILT

DATE: APRIL 26, 2016

00	100% SUBMISSION	SLB	2013-MAR-04
No.	Revision	Ckd. By	Date

	Const. North
	Drawn By: I.CRAWFORD
	Dwg. Standards
	Ckd. By:
	Designed By: A. ZARAD
Date Printed	Dwg. Design Ckd. By: S. BURDEN

exp Services Inc.
t: +1.613.688.1899 | f: +1.613.225.7330
2650 Queensview Drive, Unit 100
Ottawa, ON K2B 8H6
CANADA
www.exp.com





- BUILDINGS • EARTH & ENVIRONMENT • ENERGY •
- INDUSTRIAL • INFRASTRUCTURE • SUSTAINABILITY •

Project Title	
NEW UTILIDOR DESIGN RESOLUTE BAY, NU	
Dwg. Title	
PLAN AND PROFILE AV16 TO AV13	
Project No. OTT-00206333-A0	
Dwg. No. C-317	Rev. No. 03
Scale 1:500 This drawing is not to be scaled	

NO DATA BEYOND 0+100

NO DATA BEYOND 0+100

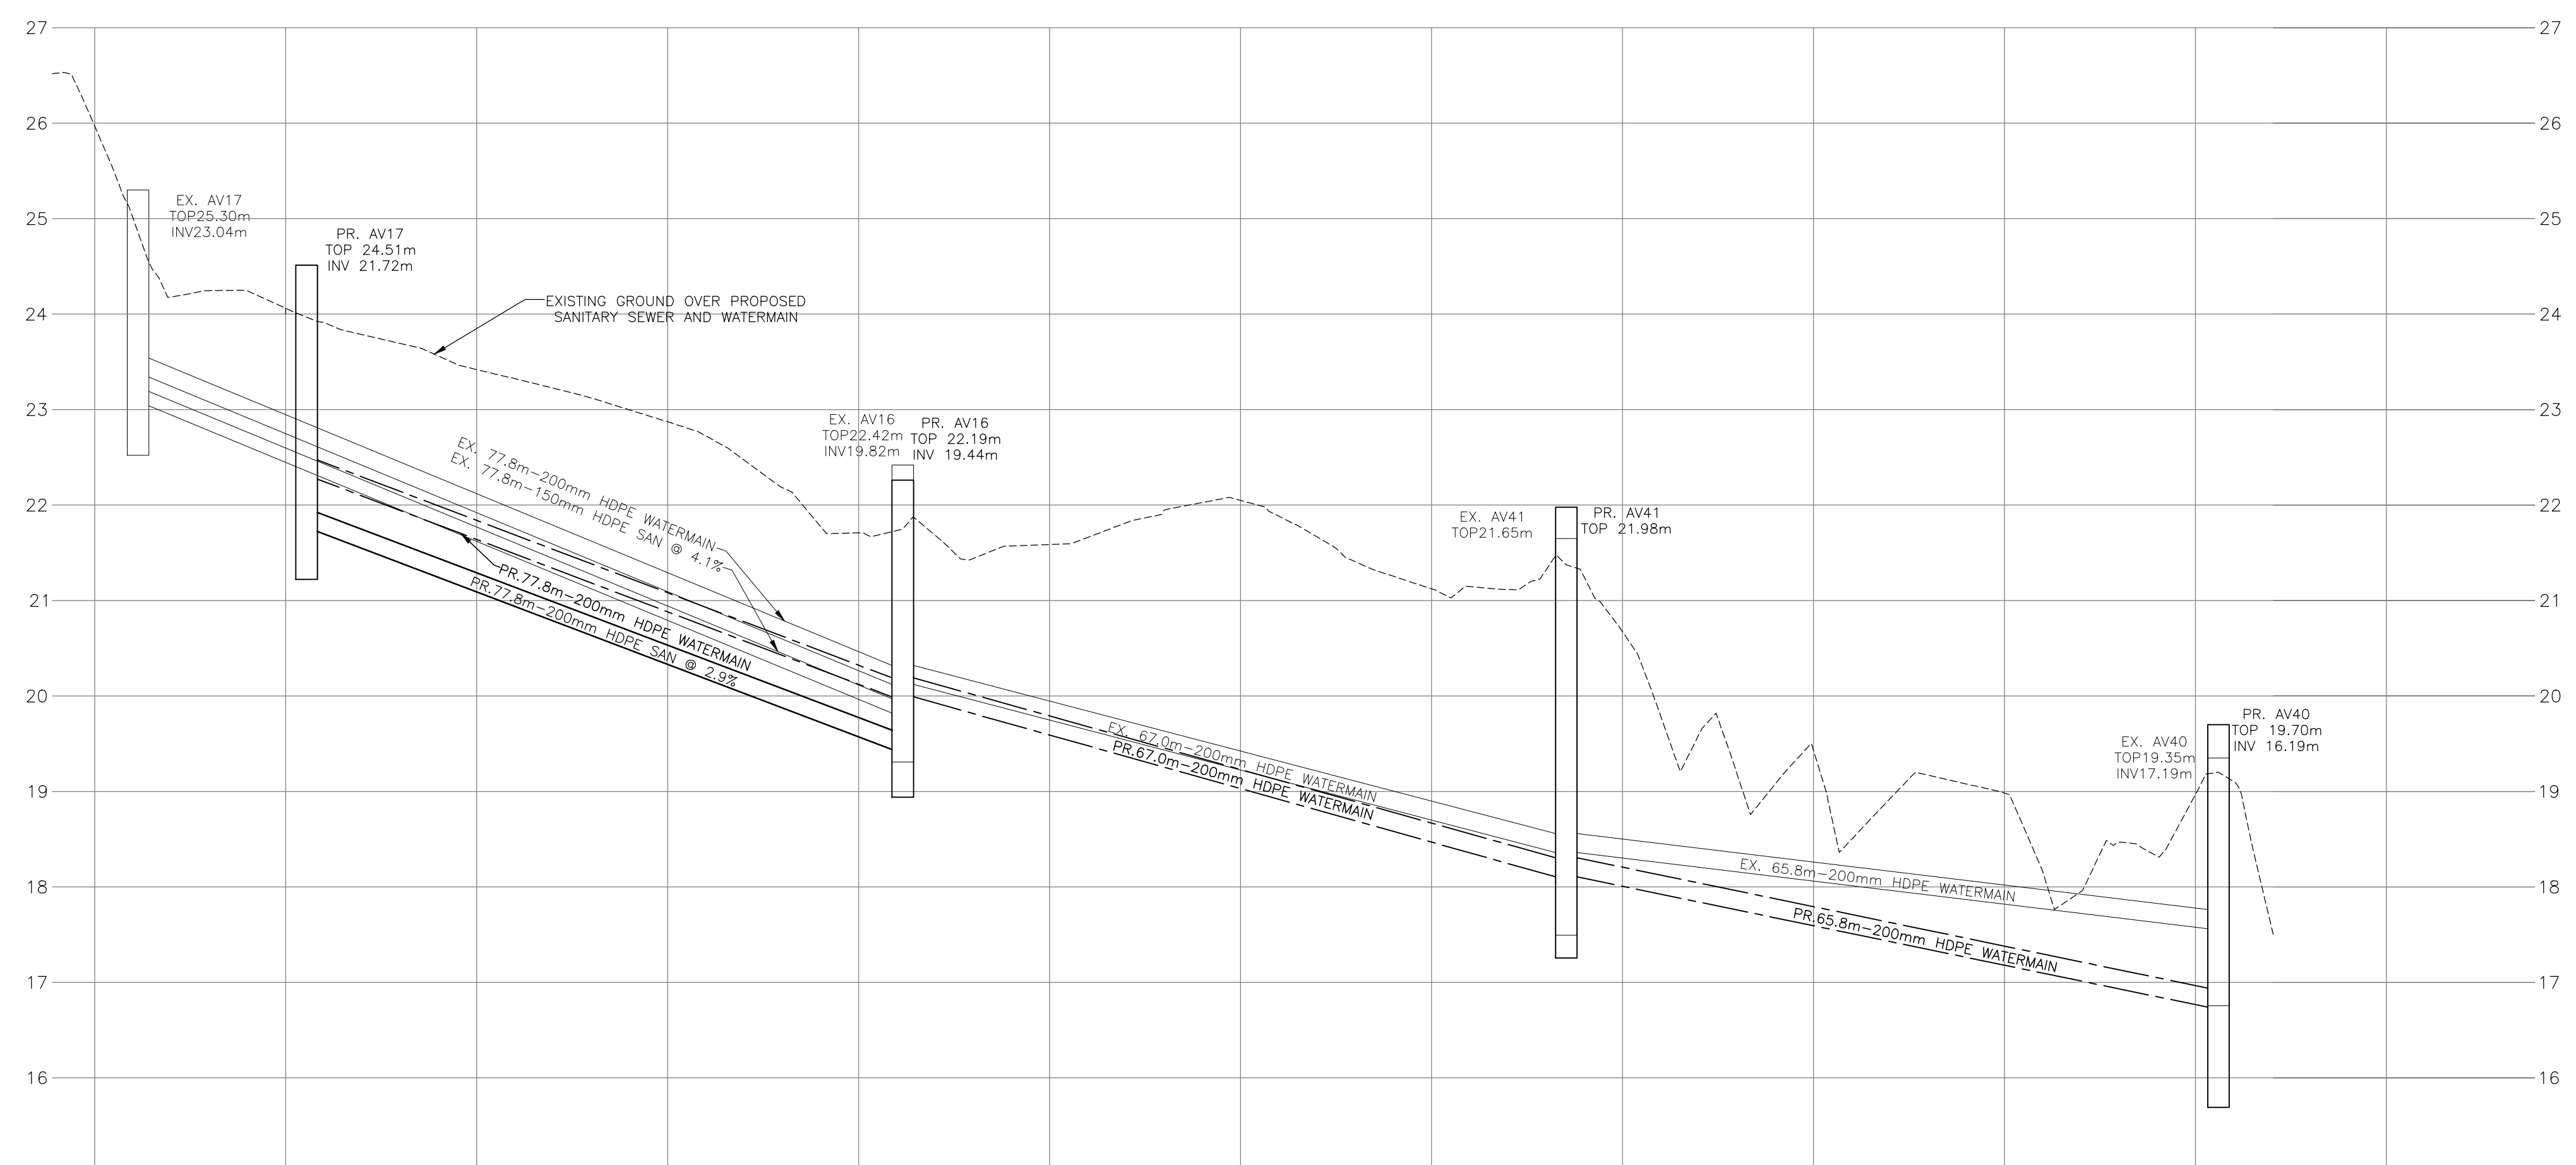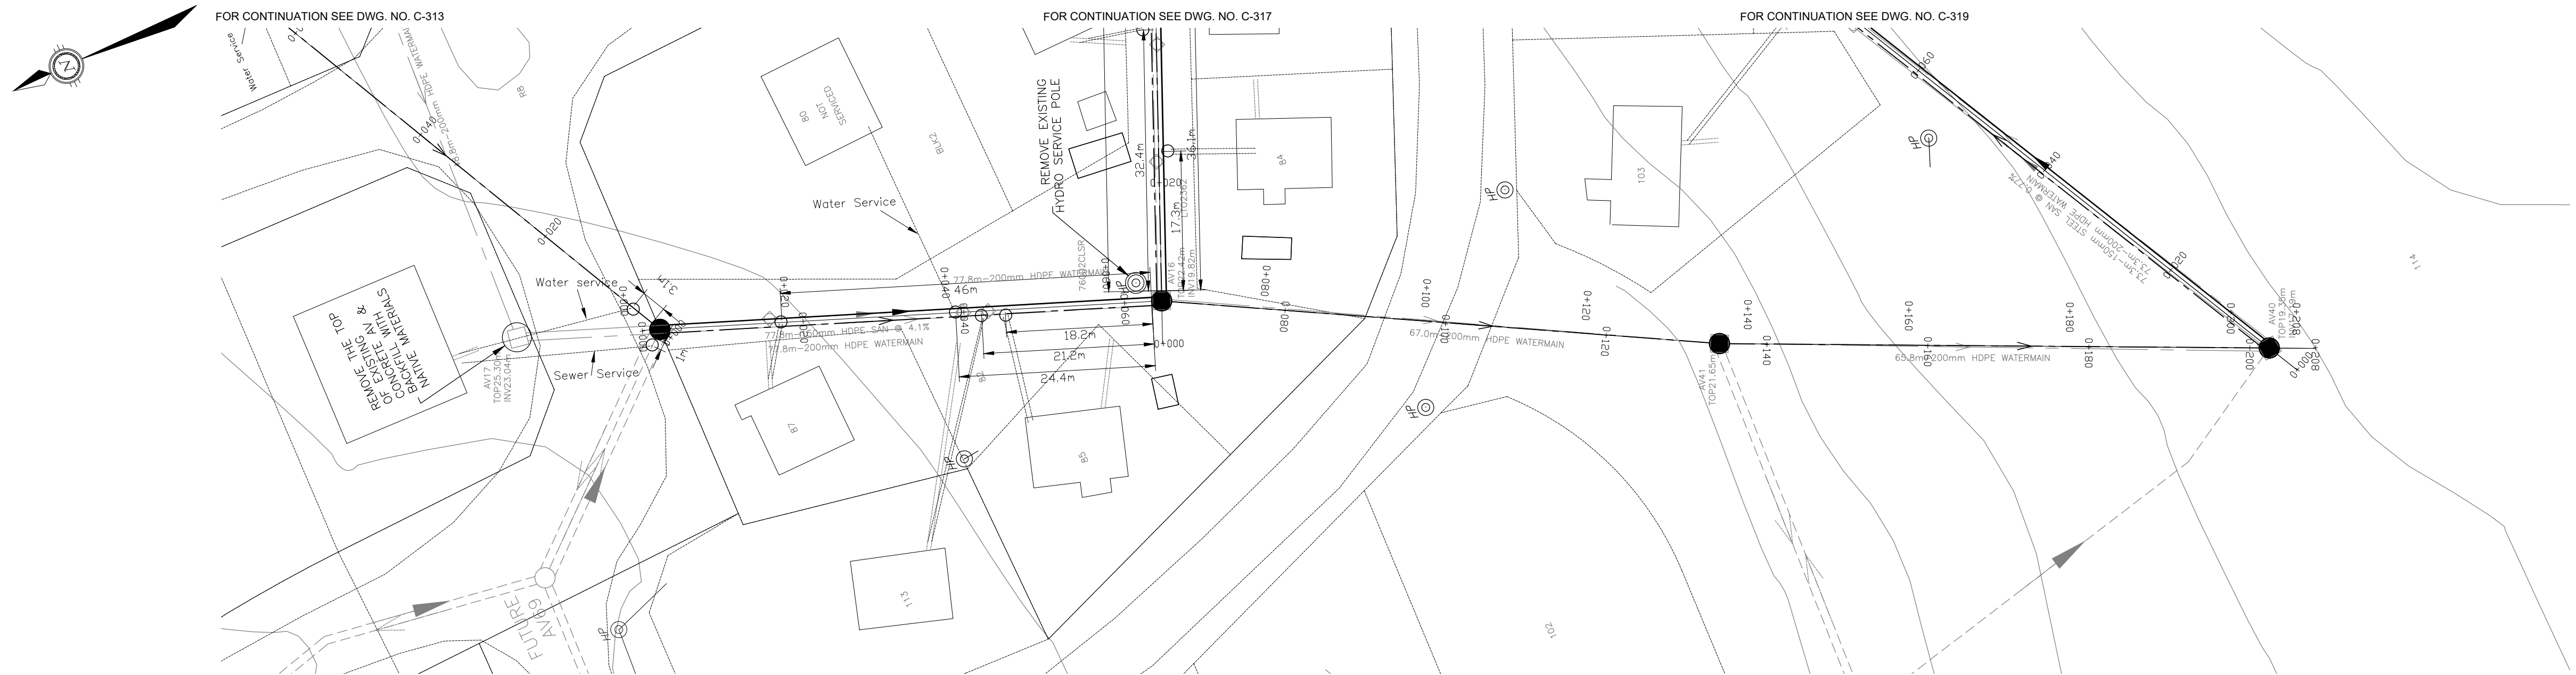

PROPOSED ELEVATION		24.06		23.42		22.87		21.71		21.59		22.05		21.12		20.67		19.43		18.99		18.97		18.35		
TOP OF WATERMAIN ELEVATION		22.47	22.47	77.8m-200mmØ SERIES 128 HDPE WATERMAIN				NE20.19 SE20.19	67.0m-200mmØ SERIES 128 HDPE WATERMAIN				18.30	18.30	65.8m-200mmØ SERIES 128 HDPE WATERMAIN				16.94	16.94						
TOP OF WATER RECIRC ELEVATION																										
SANITARY SEWER INVERT		21.72	77.8m-200mmØ SERIES 128 HDPE SAN @ 2.9%				NE19.44 SE19.44											16.19								
EXISTING ELEVATION	25.96	24.06		23.42		22.87		21.71		21.59		22.05		21.12		20.67		19.43		18.99		18.97		18.35		
CHAINAGE		0+000	0+002.18		0+020		0+040		0+060	0+064.62		0+080		0+100		0+120	0+134.11	0+140		0+160		0+180		0+200	0+202.41	0+220

No.	Issue	Date
01	ISSUED FOR TENDER	2013-MAR-25
02	REISSUED FOR TENDER	2013-OCT-25
03	ISSUED FOR CONSTRUCTION	2014-APR-21
04	ISSUED FOR AS-BUILT	2016-APR-26



AS-BUILT

DATE: APRIL 26, 2016

No.	Revision	Ckd. By	Date
00	100% SUBMISSION	SLB	2013-MAR-04

Const. North

Drawn By: I.CRAWFORD

Dwg. Standards Ckd. By:

Designed By: A. ZARAD

Date Printed

Dwg. Design Ckd. By: S. BURDEN

exp Services Inc.

t: +1.613.688.1899 | f: +1.613.225.7330

2650 Queensview Drive, Unit 100

Ottawa, ON K2B 8H6

CANADA

www.exp.com



• BUILDINGS • EARTH & ENVIRONMENT • ENERGY •

• INDUSTRIAL • INFRASTRUCTURE • SUSTAINABILITY •

Project Title

NEW UTILIDOR DESIGN

RESOLUTE BAY, NU

Dwg. Title

PLAN AND PROFILE

AV17 TO AV40

Project No. OTT-00206333-A0


Dwg. No. C-318	Rev. No. 03
----------------	-------------

Scale 1:500

This drawing is not to be scaled

exp Services Inc. © 2012

NO COPY OF THIS DRAWING IS TO BE MADE OR REPRODUCED IN ANY MANNER WITHOUT THE WRITTEN PERMISSION OF EXP SERVICES INC. THIS DRAWING IS THE PROPERTY OF EXP SERVICES INC. AND IS NOT TO BE LOANED, REPRODUCED, COPIED, REPRODUCED, OR IN ANY MANNER USED FOR ANY OTHER PROJECT WITHOUT THE WRITTEN PERMISSION OF EXP SERVICES INC. THIS DRAWING IS THE PROPERTY OF EXP SERVICES INC. AND IS NOT TO BE LOANED, REPRODUCED, COPIED, REPRODUCED, OR IN ANY MANNER USED FOR ANY OTHER PROJECT WITHOUT THE WRITTEN PERMISSION OF EXP SERVICES INC.

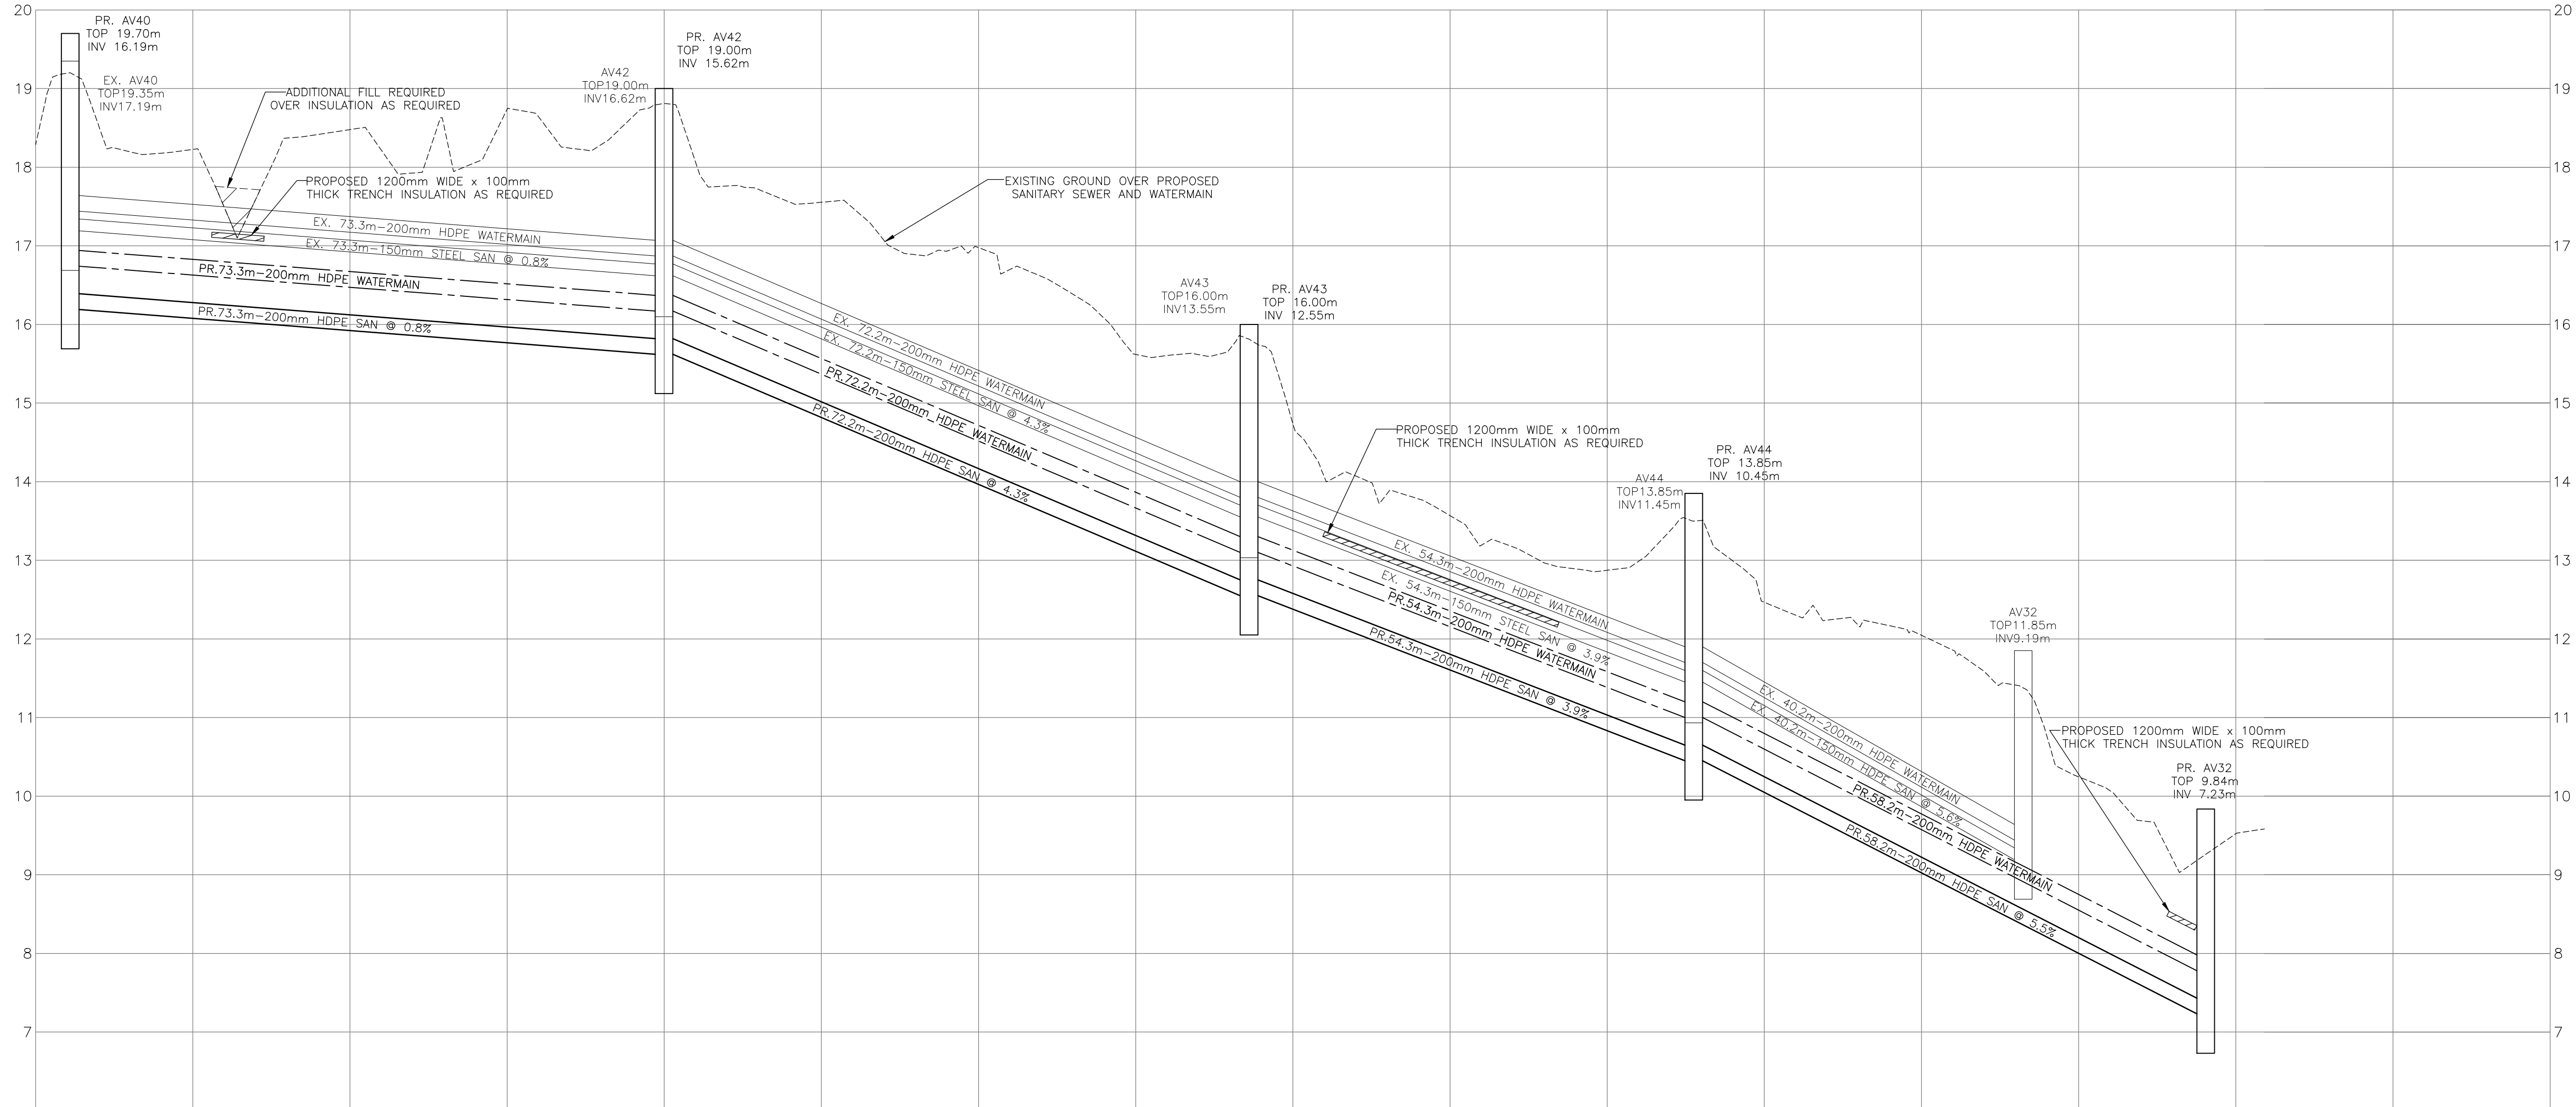

PROPOSED ELEVATION	18.29	18.23	18.48	18.74	18.81	17.55	16.98	15.62	14.74	13.57	12.87	12.46	12.05	10.24	8.12							
TOP OF WATERMAIN ELEVATION	16.94	16.94	73.3m-200mmØ SERIES 128 HDPE WATERMAIN			16.37	72.2m-200mmØ SERIES 128 HDPE WATERMAIN			13.30	54.3m-200mmØ SERIES 128 HDPE WATERMAIN			11.20	58.2m-200mmØ SERIES 128 HDPE WATERMAIN			7.98				
TOP OF WATER RECIRC ELEVATION																	7.98					
SANITARY SEWER INVERT	16.19		73.3m-200mmØ SERIES 128 HDPE SAN @ 0.8%			15.62	72.2m-200mmØ SERIES 128 HDPE SAN @ 4.3%			12.55	54.3m-200mmØ SERIES 128 HDPE SAN @ 3.9%			10.45	58.2m-200mmØ SERIES 128 HDPE SAN @ 5.5%			NW 7.23				
EXISTING ELEVATION	18.29	18.23	18.48	18.74	18.81	17.55	16.99	15.62	14.74	13.57	12.87	12.46	12.05	10.24	8.12							
CHAINAGE	0+000	0+004.41	0+020	0+040	0+060	0+079.97	0+080	0+100	0+120	0+140	0+154.42	0+160	0+180	0+200	0+211.01	0+220	0+240	0+260	0+276.16	0+280	0+300	0+320

No.	Issue	Date
01	ISSUED FOR TENDER	2013-MAR-25
02	REISSUED FOR TENDER	2013-OCT-25
03	ISSUED FOR CONSTRUCTION	2014-APR-21
04	ISSUED FOR AS-BUILT	2016-APR-26



AS-BUILT

DATE: APRIL 26, 2016

00	100% SUBMISSION	SLB	2013-MAR-04
No.	Revision	Ckd. By	Date

Const. North

Drawn By: I.CRAWFORD

Dwg. Standards Ckd. By:

Designed By: A. ZARAD

Date Printed

Dwg. Design Ckd. By: S. BURDEN

exp Services Inc.

t: +1.613.688.1899 | f: +1.613.225.7330

2650 Queensview Drive, Unit 100

Ottawa, ON K2B 8H6

CANADA

www.exp.com



• BUILDINGS • EARTH & ENVIRONMENT • ENERGY •

• INDUSTRIAL • INFRASTRUCTURE • SUSTAINABILITY •

Project Title

NEW UTILIDOR DESIGN

RESOLUTE BAY, NU

Dwg. Title

PLAN AND PROFILE

AV40 TO AV32

Project No. OTT-00206333-A0



Dwg. No. C-319	Rev. No. 03
----------------	-------------

Scale 1:500

This drawing is not to be scaled

exp Services Inc. © 2012

NO DATA ARE BELIEVED
INSTRUMENTS: SURVEYOR: JAMES J. O'NEILL
DATE: 11/10/2010
PROJECT: NEW UTILIDOR DESIGN
SHEET: C-311

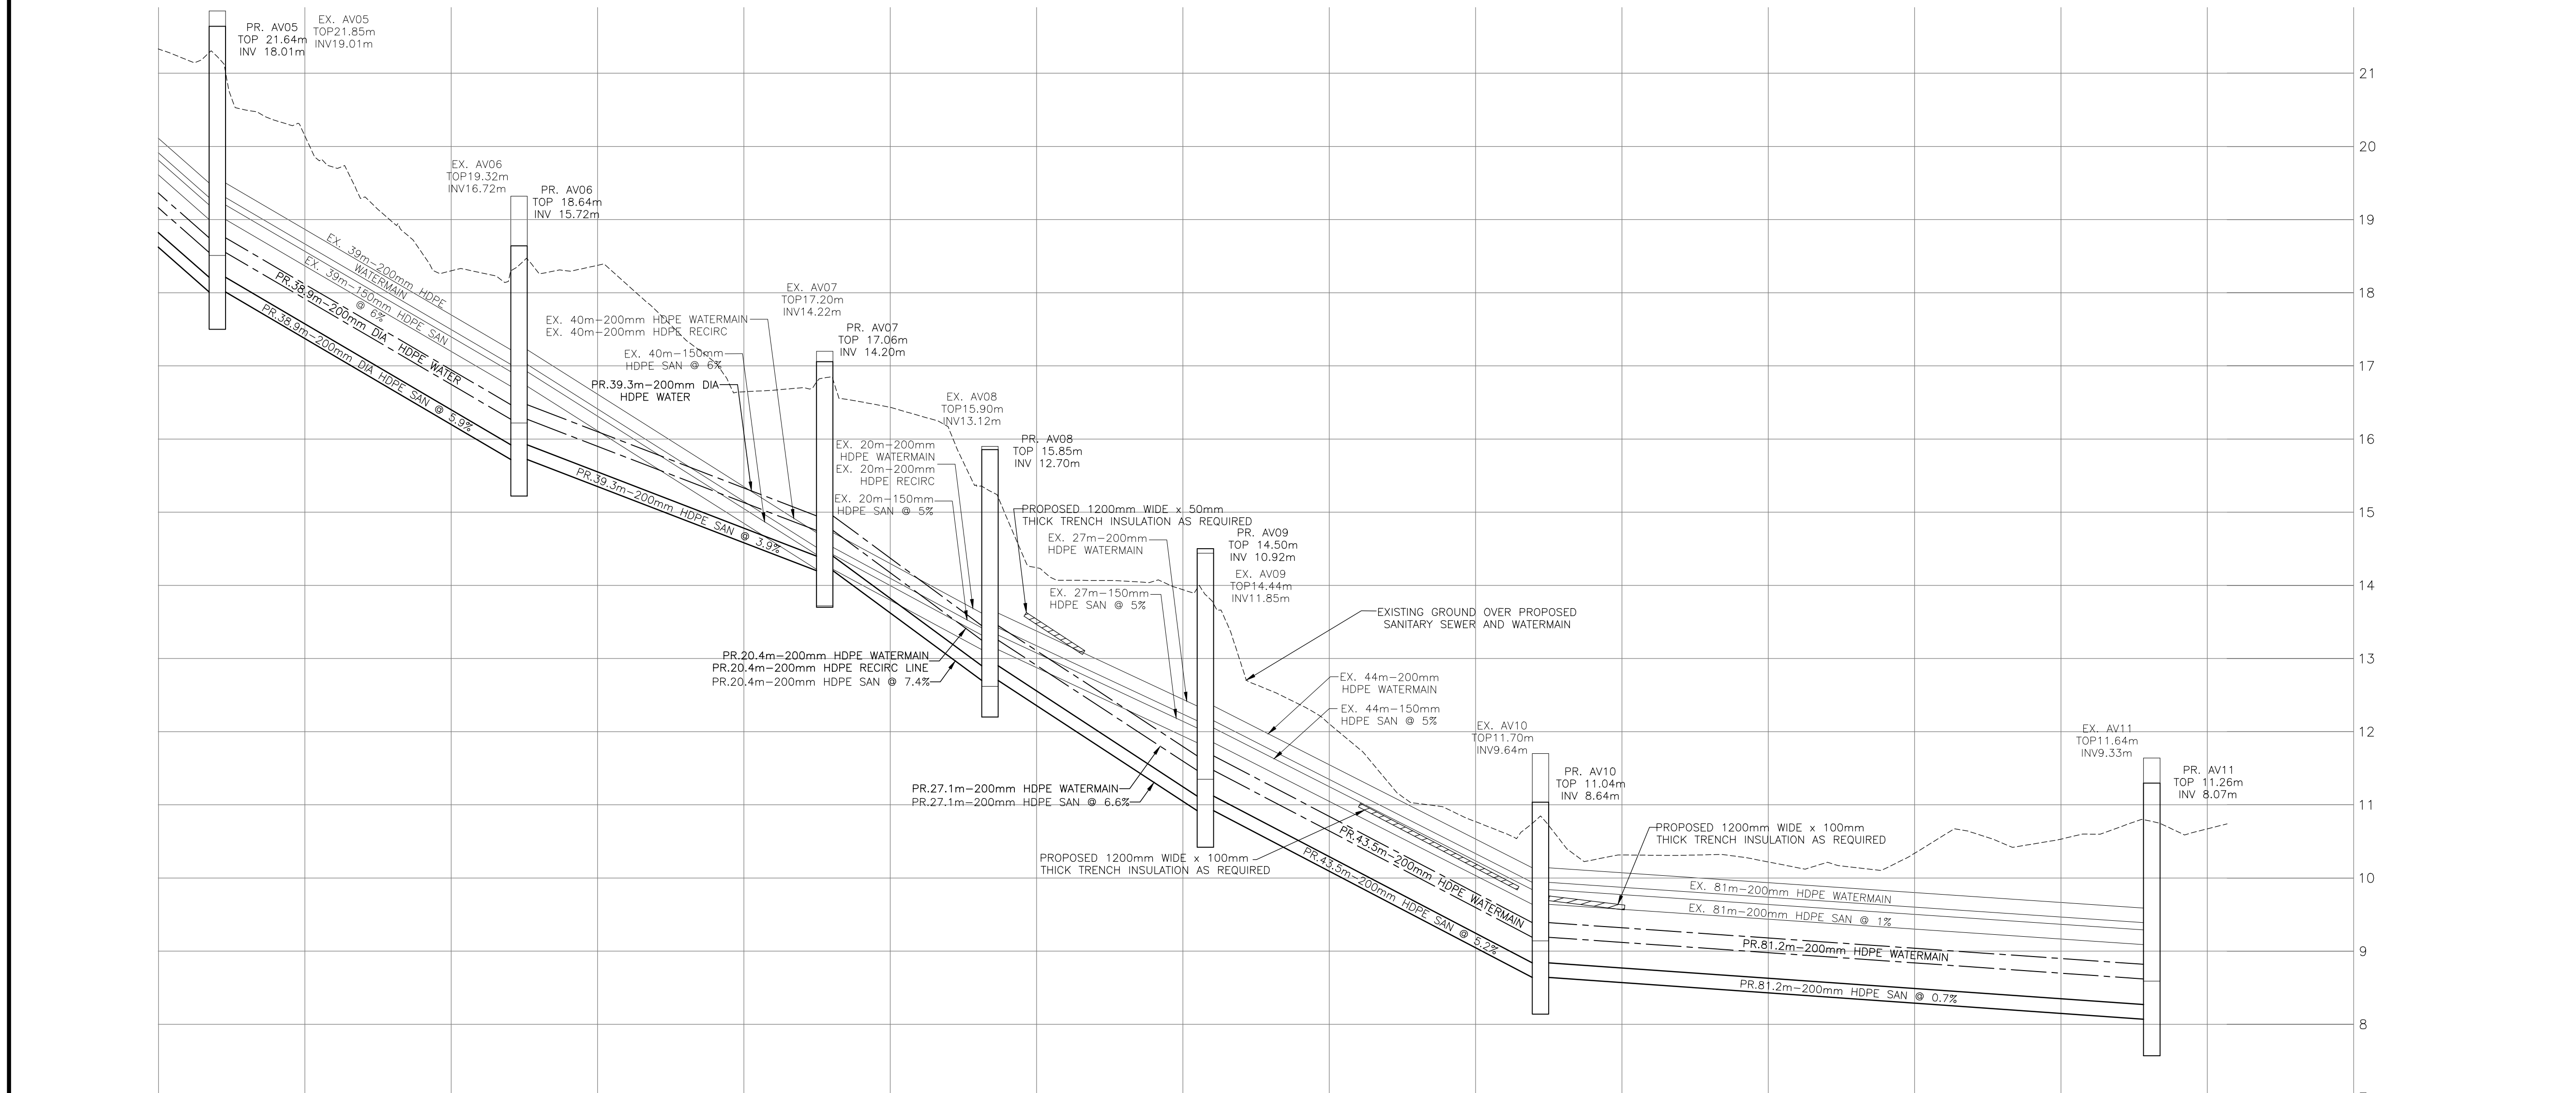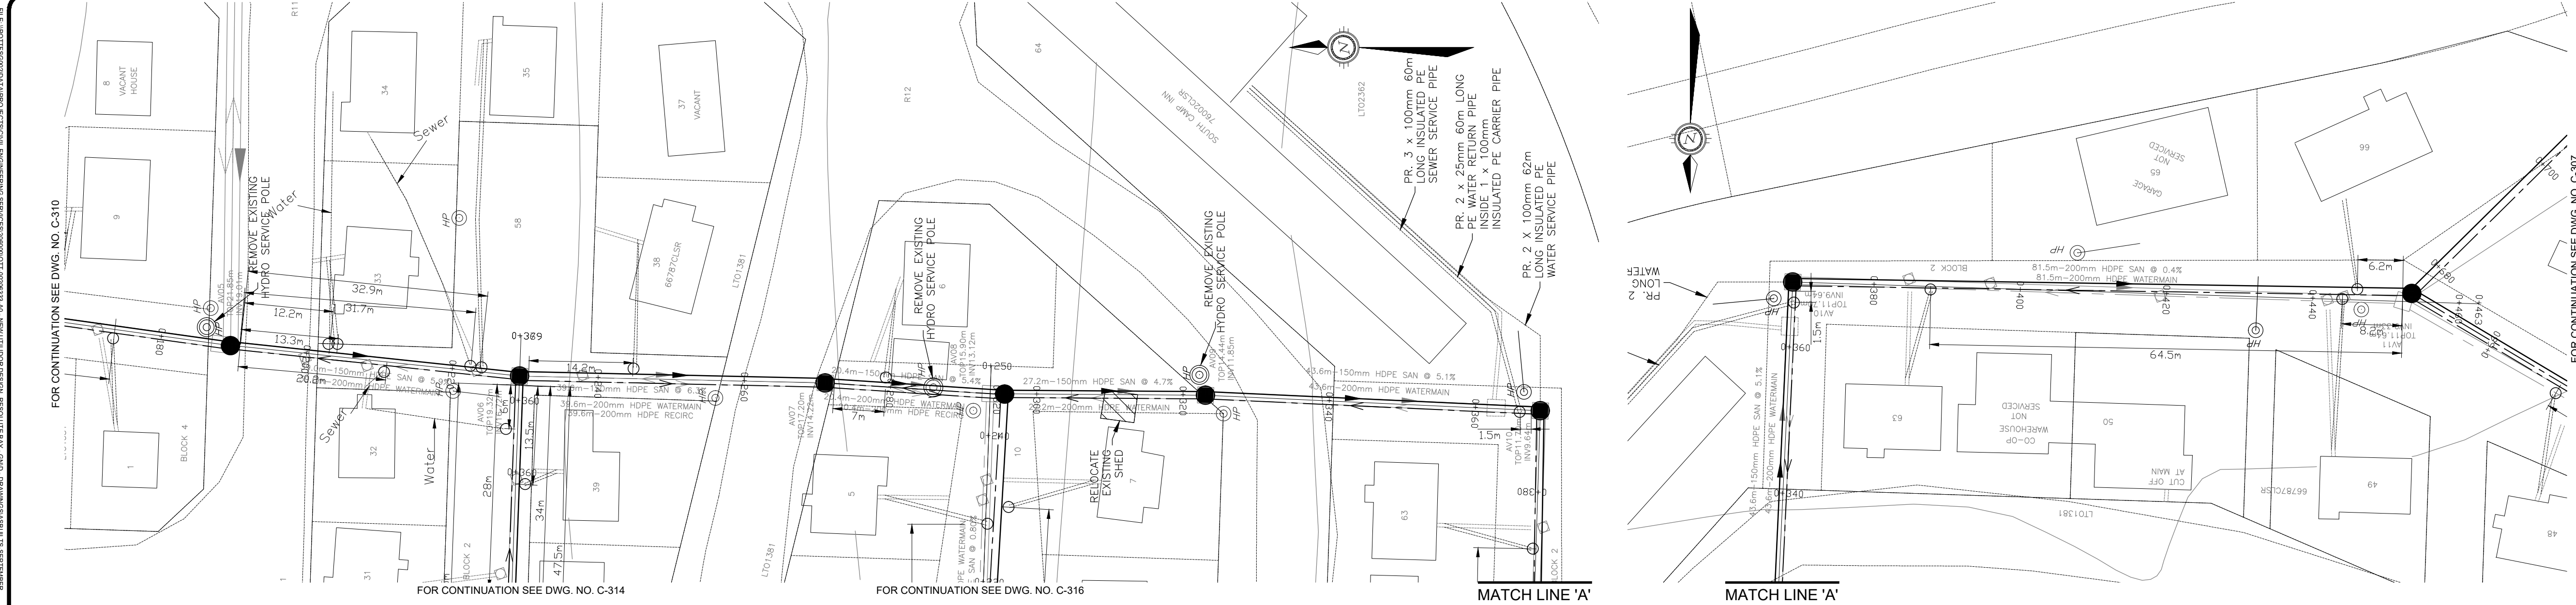

PROPOSED ELEVATION	21.33		20.14	18.30		18.37		16.65		16.43		14.24		13.94		12.11		10.77		10.31		10.22		10.34		10.53		10.67								
TOP OF WATERMAIN ELEVATION		18.76		38.9m-200mm $\varnothing$ SERIES 128 HDPE WATERMAIN		16.47		16.47		14.95		14.95		20.4m-200mm $\varnothing$ SERIES 128 HDPE WATERMAIN		13.45		13.45		27.1m-200mm $\varnothing$ SERIES 128 HDPE WATERMAIN		11.67		11.67		43.5m-200mm $\varnothing$ SERIES 128 HDPE WATERMAIN		9.39		9.39		81.2m-200mm $\varnothing$ SERIES 128 HDPE WATERMAIN		E 8.82		
TOP OF WATER RECIRC ELEVATION										14.95		14.95		20.4m-200mm $\varnothing$ SERIES 128 HDPE RECIRCULATION		13.45		13.45													E 8.82					
SANITARY SEWER INVERT		18.01		38.9m-200mm $\varnothing$ SERIES 128 HDPE SAN @ 5.9%		N 15.72		S 15.72		39.3m-200mm $\varnothing$ SERIES 128 HDPE SAN @ 3.9%		14.20		14.20		20.4m-200mm $\varnothing$ SERIES 128 HDPE SAN @ 7.4%		N 12.70		S 12.70		27.1m-200mm $\varnothing$ SERIES 128 HDPE SAN @ 6.6%		10.92		10.92		43.5m-200mm $\varnothing$ SERIES 128 HDPE SAN @ 5.2%		8.64		8.64		81.2m-200mm $\varnothing$ SERIES 128 HDPE SAN @ 0.7%		E 8.07
EXISTING ELEVATION	21.33		20.14	18.30		18.37		16.65		16.43		14.24		13.94		12.11		10.77		10.31		10.22		10.34		10.53		10.67								
CHAINAGE	0+180	0+188.03	0+200	0+220	0+229.26	0+240	0+260	0+271.04	0+280	0+293.64	0+300	0+323.07	0+340	0+360	0+368.88	0+380	0+400	0+420	0+440	0+452.42	0+460	0+480														

No.

Issue

Date

01

ISSUED FOR TENDER

2013-MAR-25

02

REISSUED FOR TENDER

2013-OCT-25

03

ISSUED FOR CONSTRUCTION

2014-APR-21

04

ISSUED FOR AS-BUILT

2016-APR-26



AS-BUILT

DATE: APRIL 26, 2016

00	100% SUBMISSION	SLB	2013-MAR-04
No.	Revision	Ckd. By	Date

Const. North

Drawn By: I. CRAWFORD

Dwg. Standards Ckd. By:

Designed By: A. ZARAD

Date Printed

Dwg. Design Ckd. By: S. BURDEN

exp Services Inc.

t: +1.613.688.1899 | f: +1.613.225.7330

2650 Queensview Drive, Unit 100

Ottawa, ON K2B 8H6

CANADA

www.exp.com



BUILDINGS • EARTH & ENVIRONMENT • ENERGY •

INDUSTRIAL • INFRASTRUCTURE • SUSTAINABILITY •

Project Title

NEW UTILIDOR DESIGN
RESOLUTE BAY, NU

Dwg. Title

PLAN AND PROFILE
AV05 TO AV11

Project No.

OTT-00206333-A0

Dwg. No.

C-311

Rev. No.

03

Scale

1:500

This drawing is not to be scaled

exp Services Inc. © 2012

