
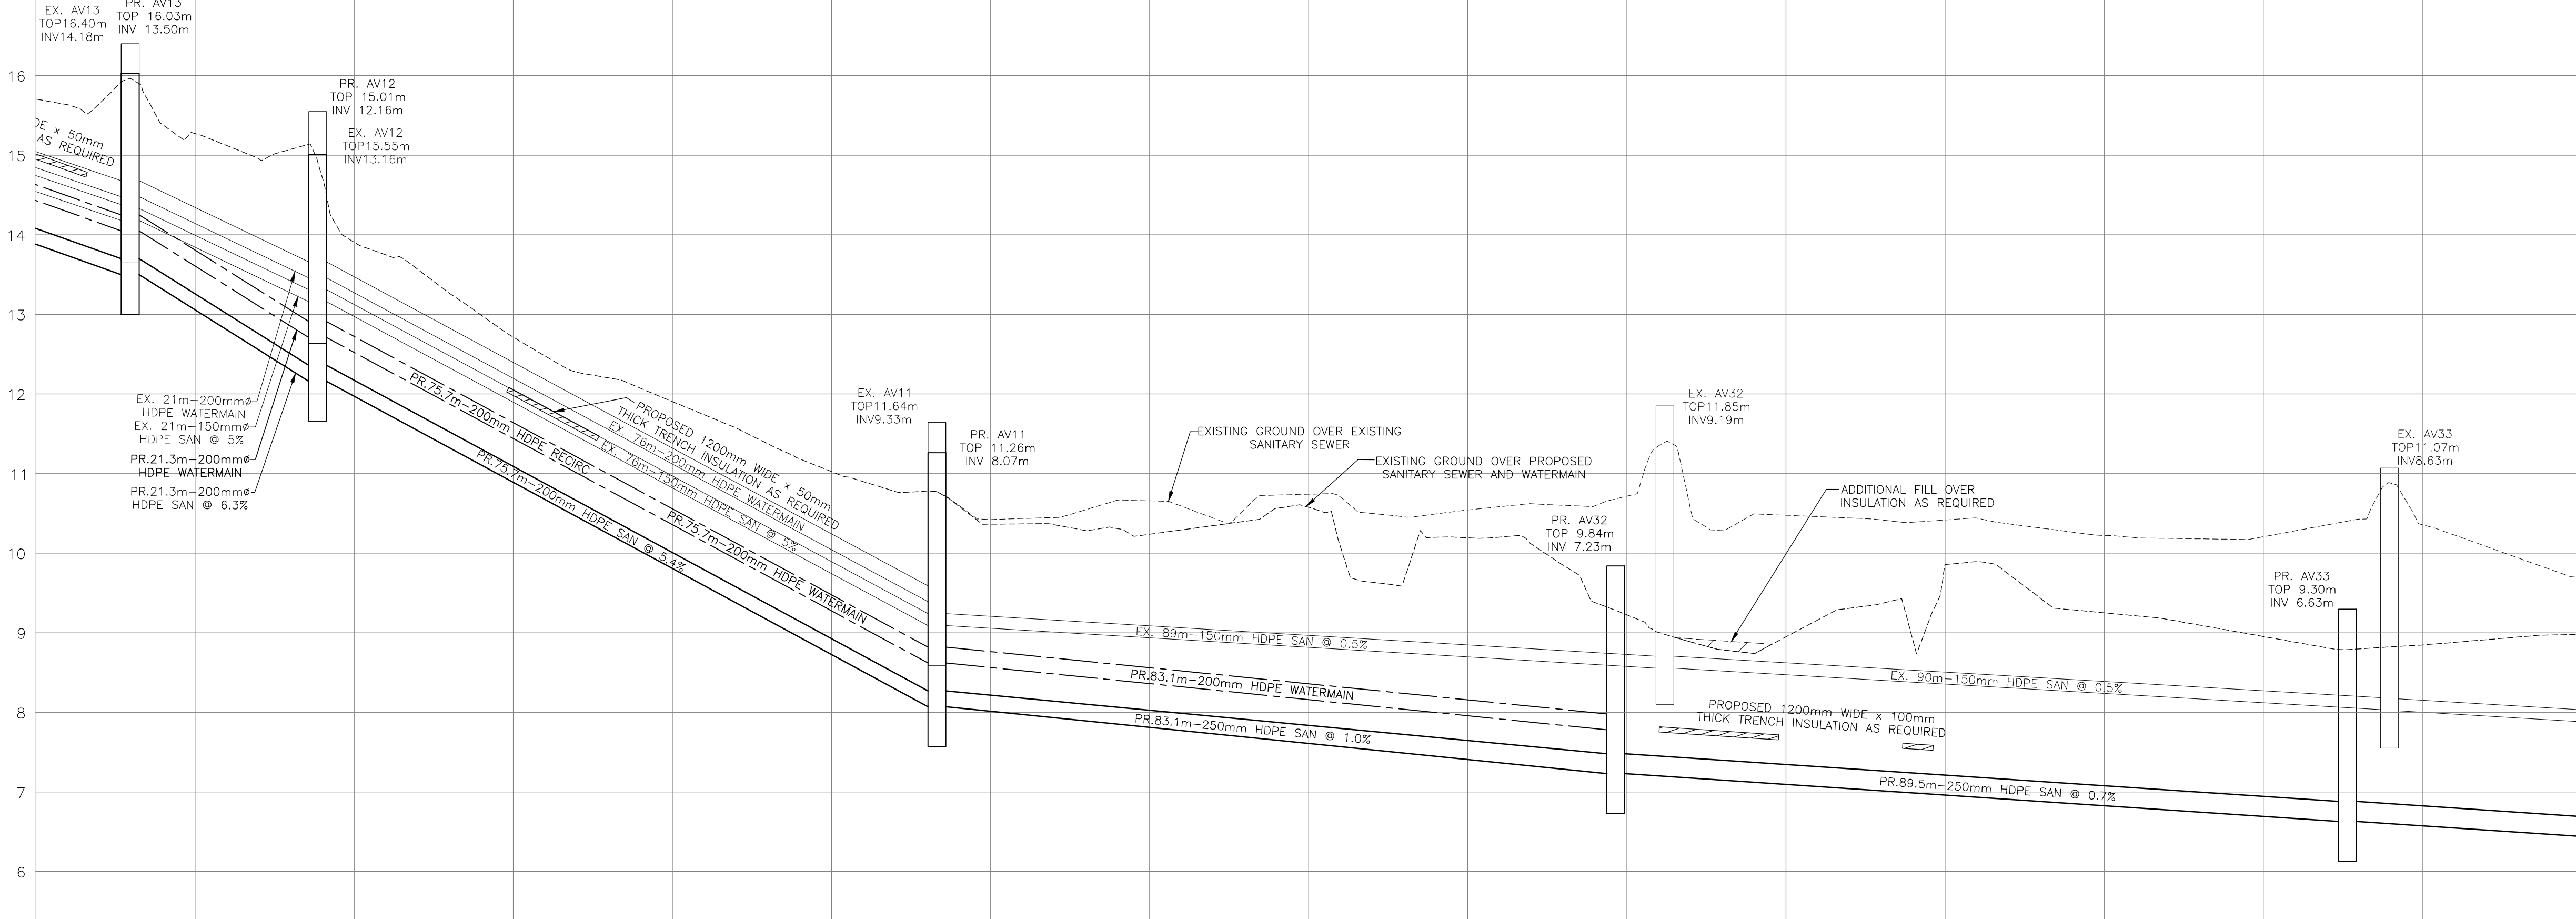


DATE: 13-10-2016 10:00:00 AM PROJECT: NEW UTILIDOR DESIGN RESOLUTE BAY, NU DRAWN BY: I. CRAWFORD CHECKED BY: S. BURDEN

NO. 004-18-000000

PROJECT: NEW UTILIDOR DESIGN RESOLUTE BAY, NU

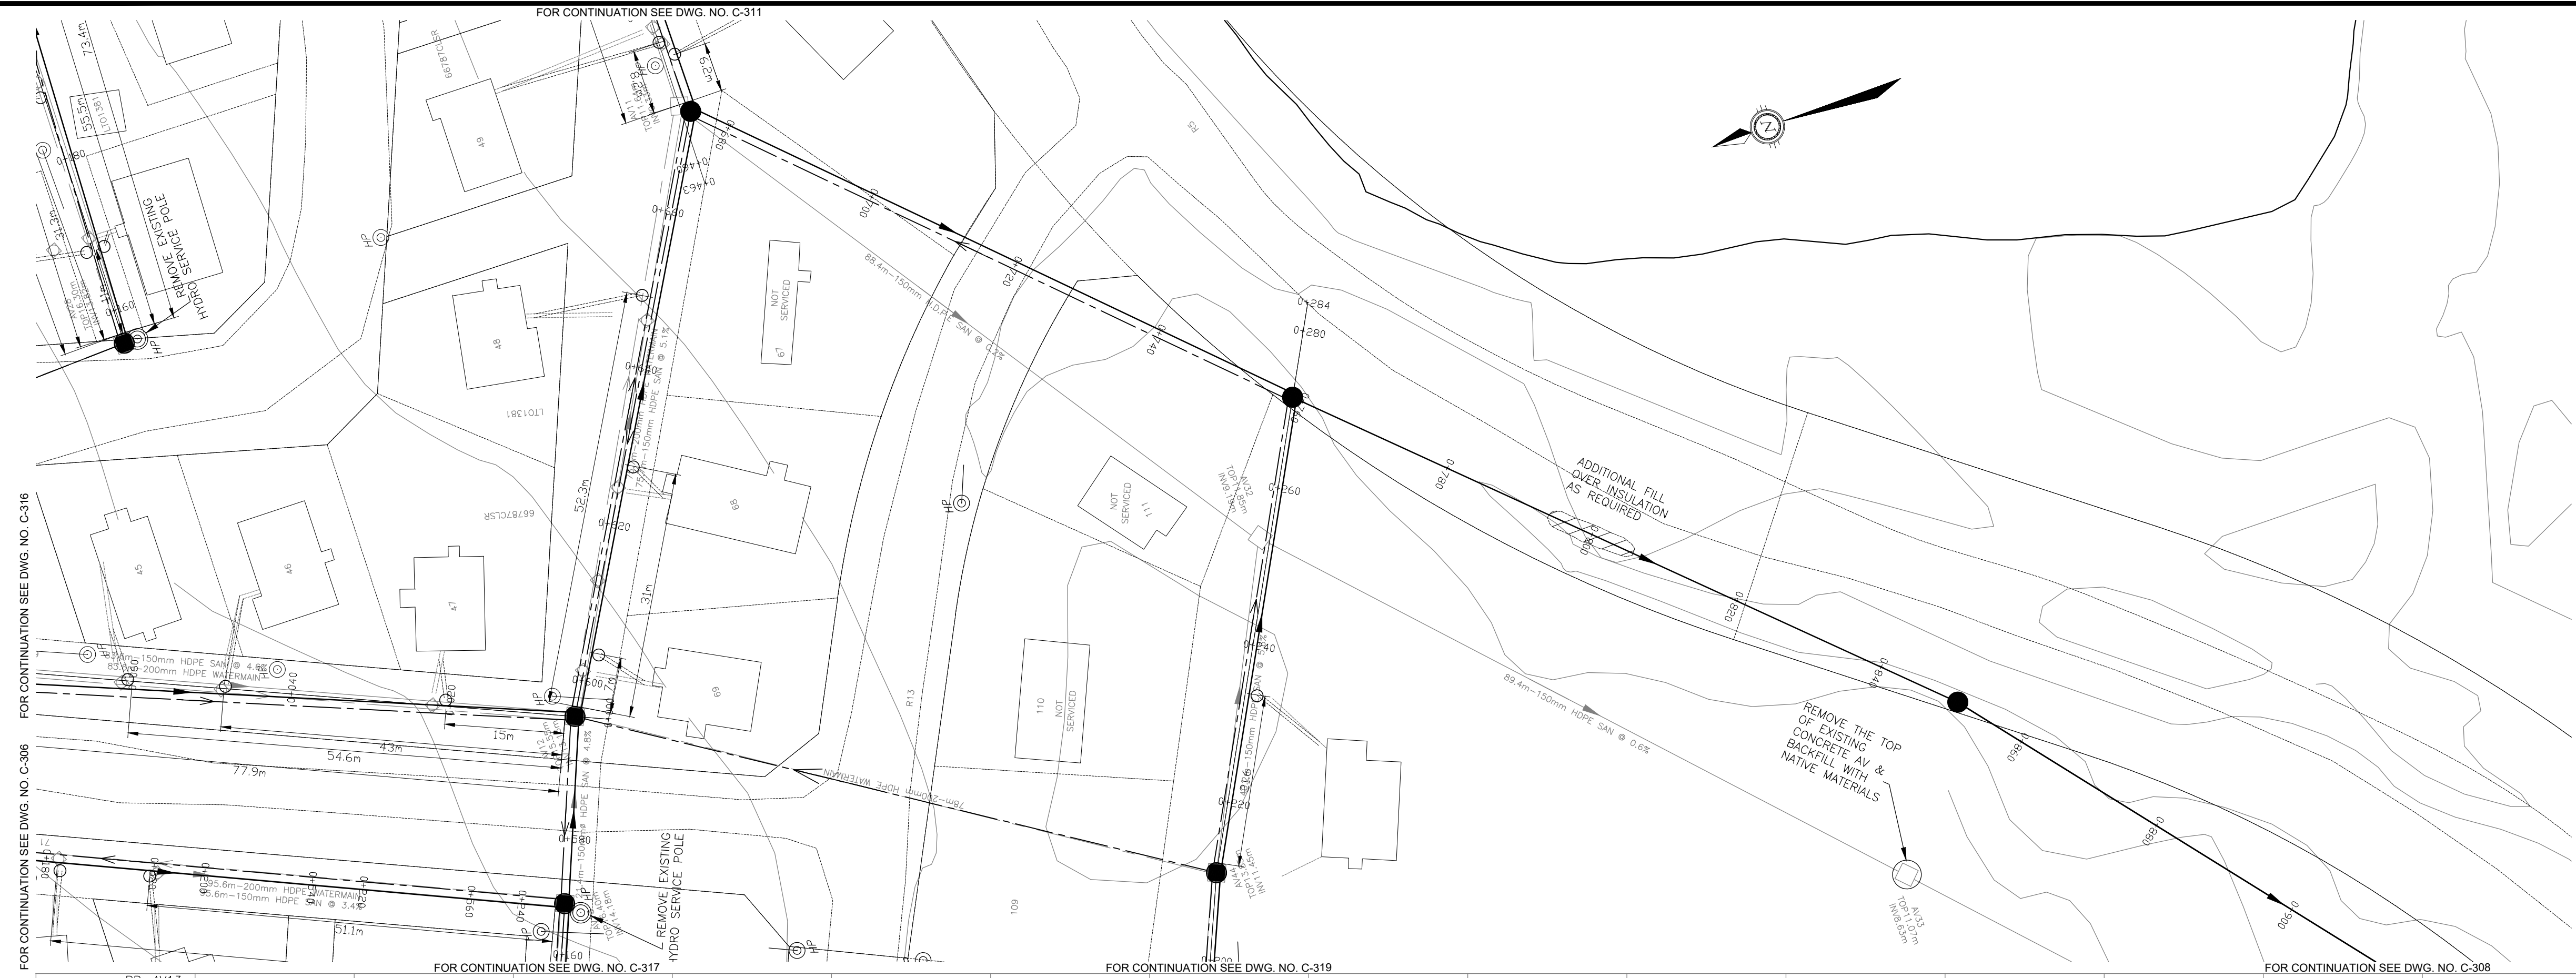

PROPOSED ELEVATION	15.27		13.91		12.71		11.90		11.02		10.36		10.24		10.58		10.19		9.22		8.95		9.86		9.25		8.95		8.85	
TOP OF WATERMAIN ELEVATION	NE 14.25 NW 14.25 SW 14.25	21.3m~200mm $\varnothing$ SERIES 128 HDPE WATERMAIN	12.91 12.91	75.7m~200mm $\varnothing$ SERIES 128 HDPE WATERMAIN				83.1m~200mm $\varnothing$ SERIES 128 HDPE WATERMAIN				8.03 NW 7.98																		
TOP OF WATER RECIRC ELEVATION	14.25 NW 14.25 SW 14.25		12.91 12.91	75.7m~200mm $\varnothing$ SERIES 128 HDPE RECIRCULATION				E 8.82 SW 8.87 NW 8.87																						
SANITARY SEWER INVERT	NE 13.50 NW 13.50 SW 13.50	21.3m~200mm $\varnothing$ SERIES 128 HDPE SAN $\odot$ 6.3% 12.16	12.16 12.16	75.7m~200mm $\varnothing$ SERIES 128 HDPE SAN $\odot$ 5.4%				83.1m~250mm $\varnothing$ SERIES 128 HDPE SAN $\odot$ 1.0%				NE 7.23 SW 7.23 NW 7.23		89.5m~250mm $\varnothing$ SERIES 128 HDPE SAN $\odot$ 0.7%										6.63 6.63						
EXISTING ELEVATION	17.17		16.53		15.24		14.04		12.44		10.99		10.25		10.37		10.11		10.44		10.64		10.23		10.45		9.90		8.04	
CHAINAGE	0+571.84	0+580	0+595.41	0+600	0+620	0+640	0+660	0+673.26	0+680	0+700	0+720	0+740	0+758.60	0+760	0+780	0+800	0+820	0+840	0+850.60	0+860										

No.

Issue

Date

01

ISSUED FOR TENDER

2013-MAR-25

02

REISSUED FOR TENDER

2013-OCT-25

03

ISSUED FOR CONSTRUCTION

2014-APR-21

04

ISSUED FOR AS-BUILT

2016-APR-26



AS-BUILT

DATE: APRIL 26, 2016

No.

100% SUBMISSION

SLB

2013-MAR-04

No.

Revision

Ckd. By

Date

Const. North

Drawn By: I. CRAWFORD

Dwg. Standards Ckd. By:

Designed By: A. ZARAD

Date Printed

Dwg. Design Ckd. By: S. BURDEN

exp Services Inc.

t: +1.613.688.1899 | f: +1.613.225.7330

2650 Queensview Drive, Unit 100

Ottawa, ON K2B 8H6

CANADA

www.exp.com



BUILDINGS • EARTH & ENVIRONMENT • ENERGY • INDUSTRIAL • INFRASTRUCTURE • SUSTAINABILITY

Project Title

NEW UTILIDOR DESIGN
RESOLUTE BAY, NU

Dwg. Title

PLAN AND PROFILE
AV13 TO AV33

Project No.

OTT-00206333-A0

Dwg. No.

C-307

Rev. No.

03

Scale

1:500

This drawing is not to be scaled