


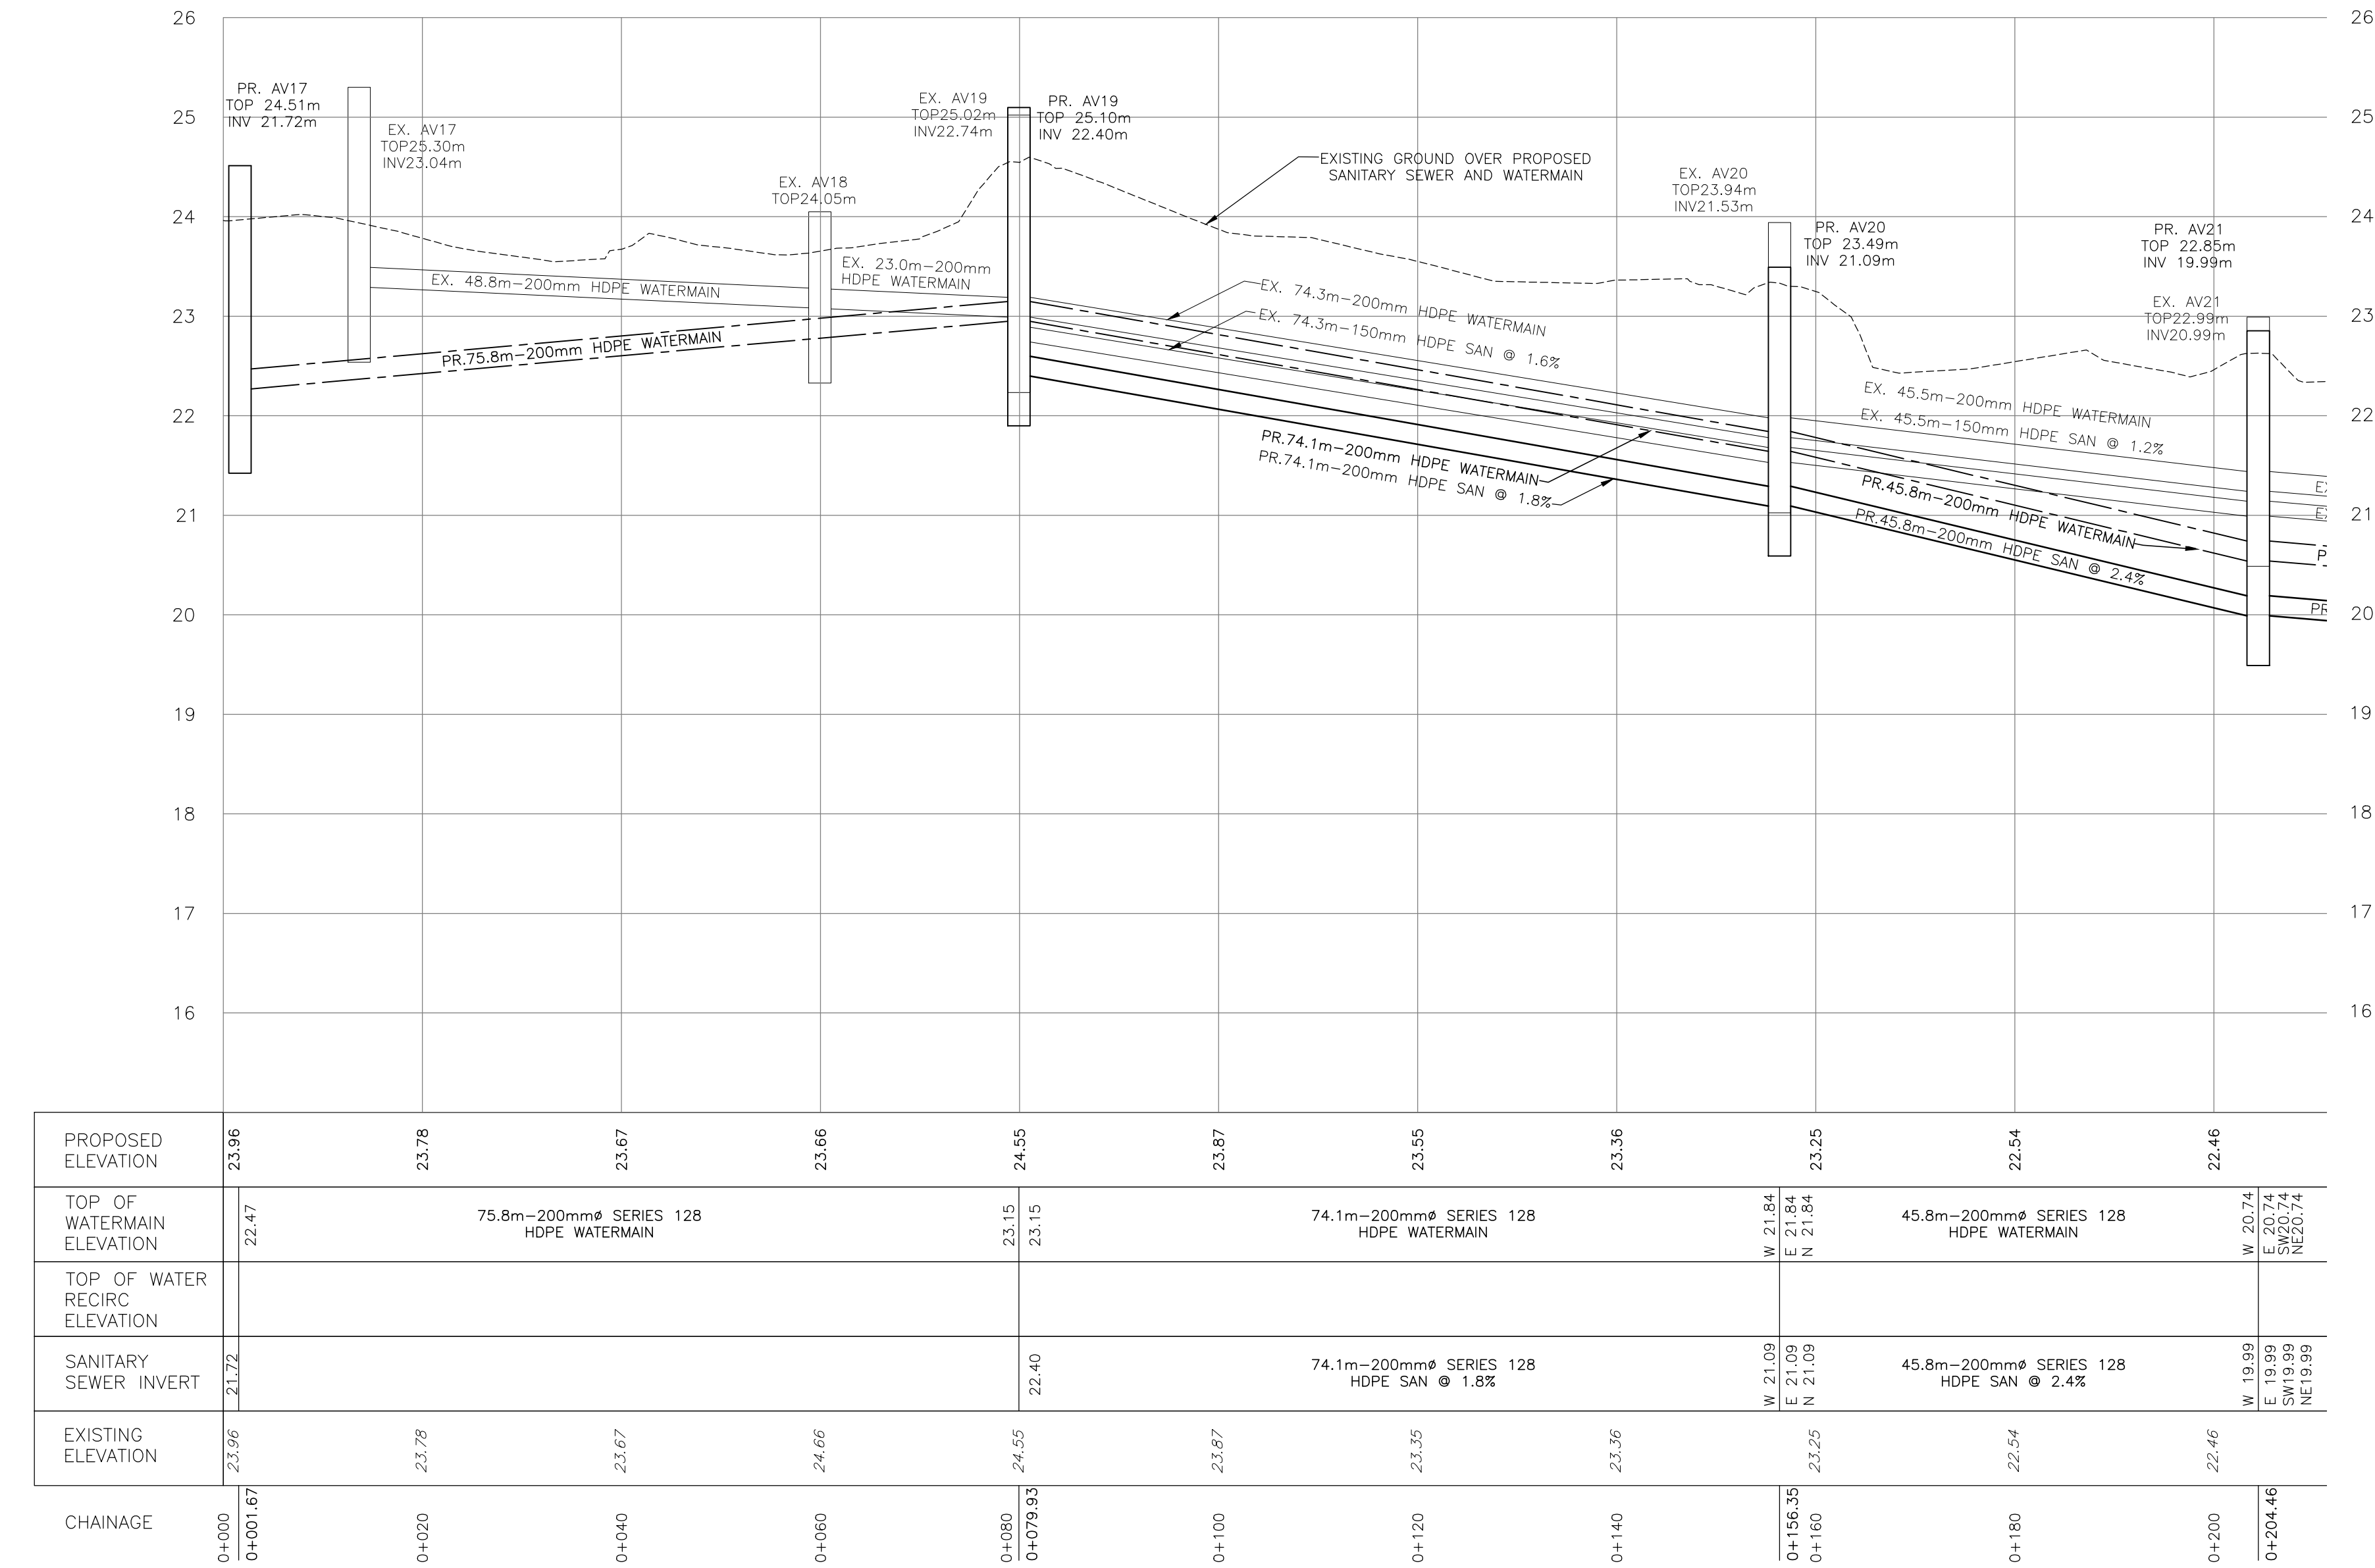

1:500
This drawing is not to be scaled