
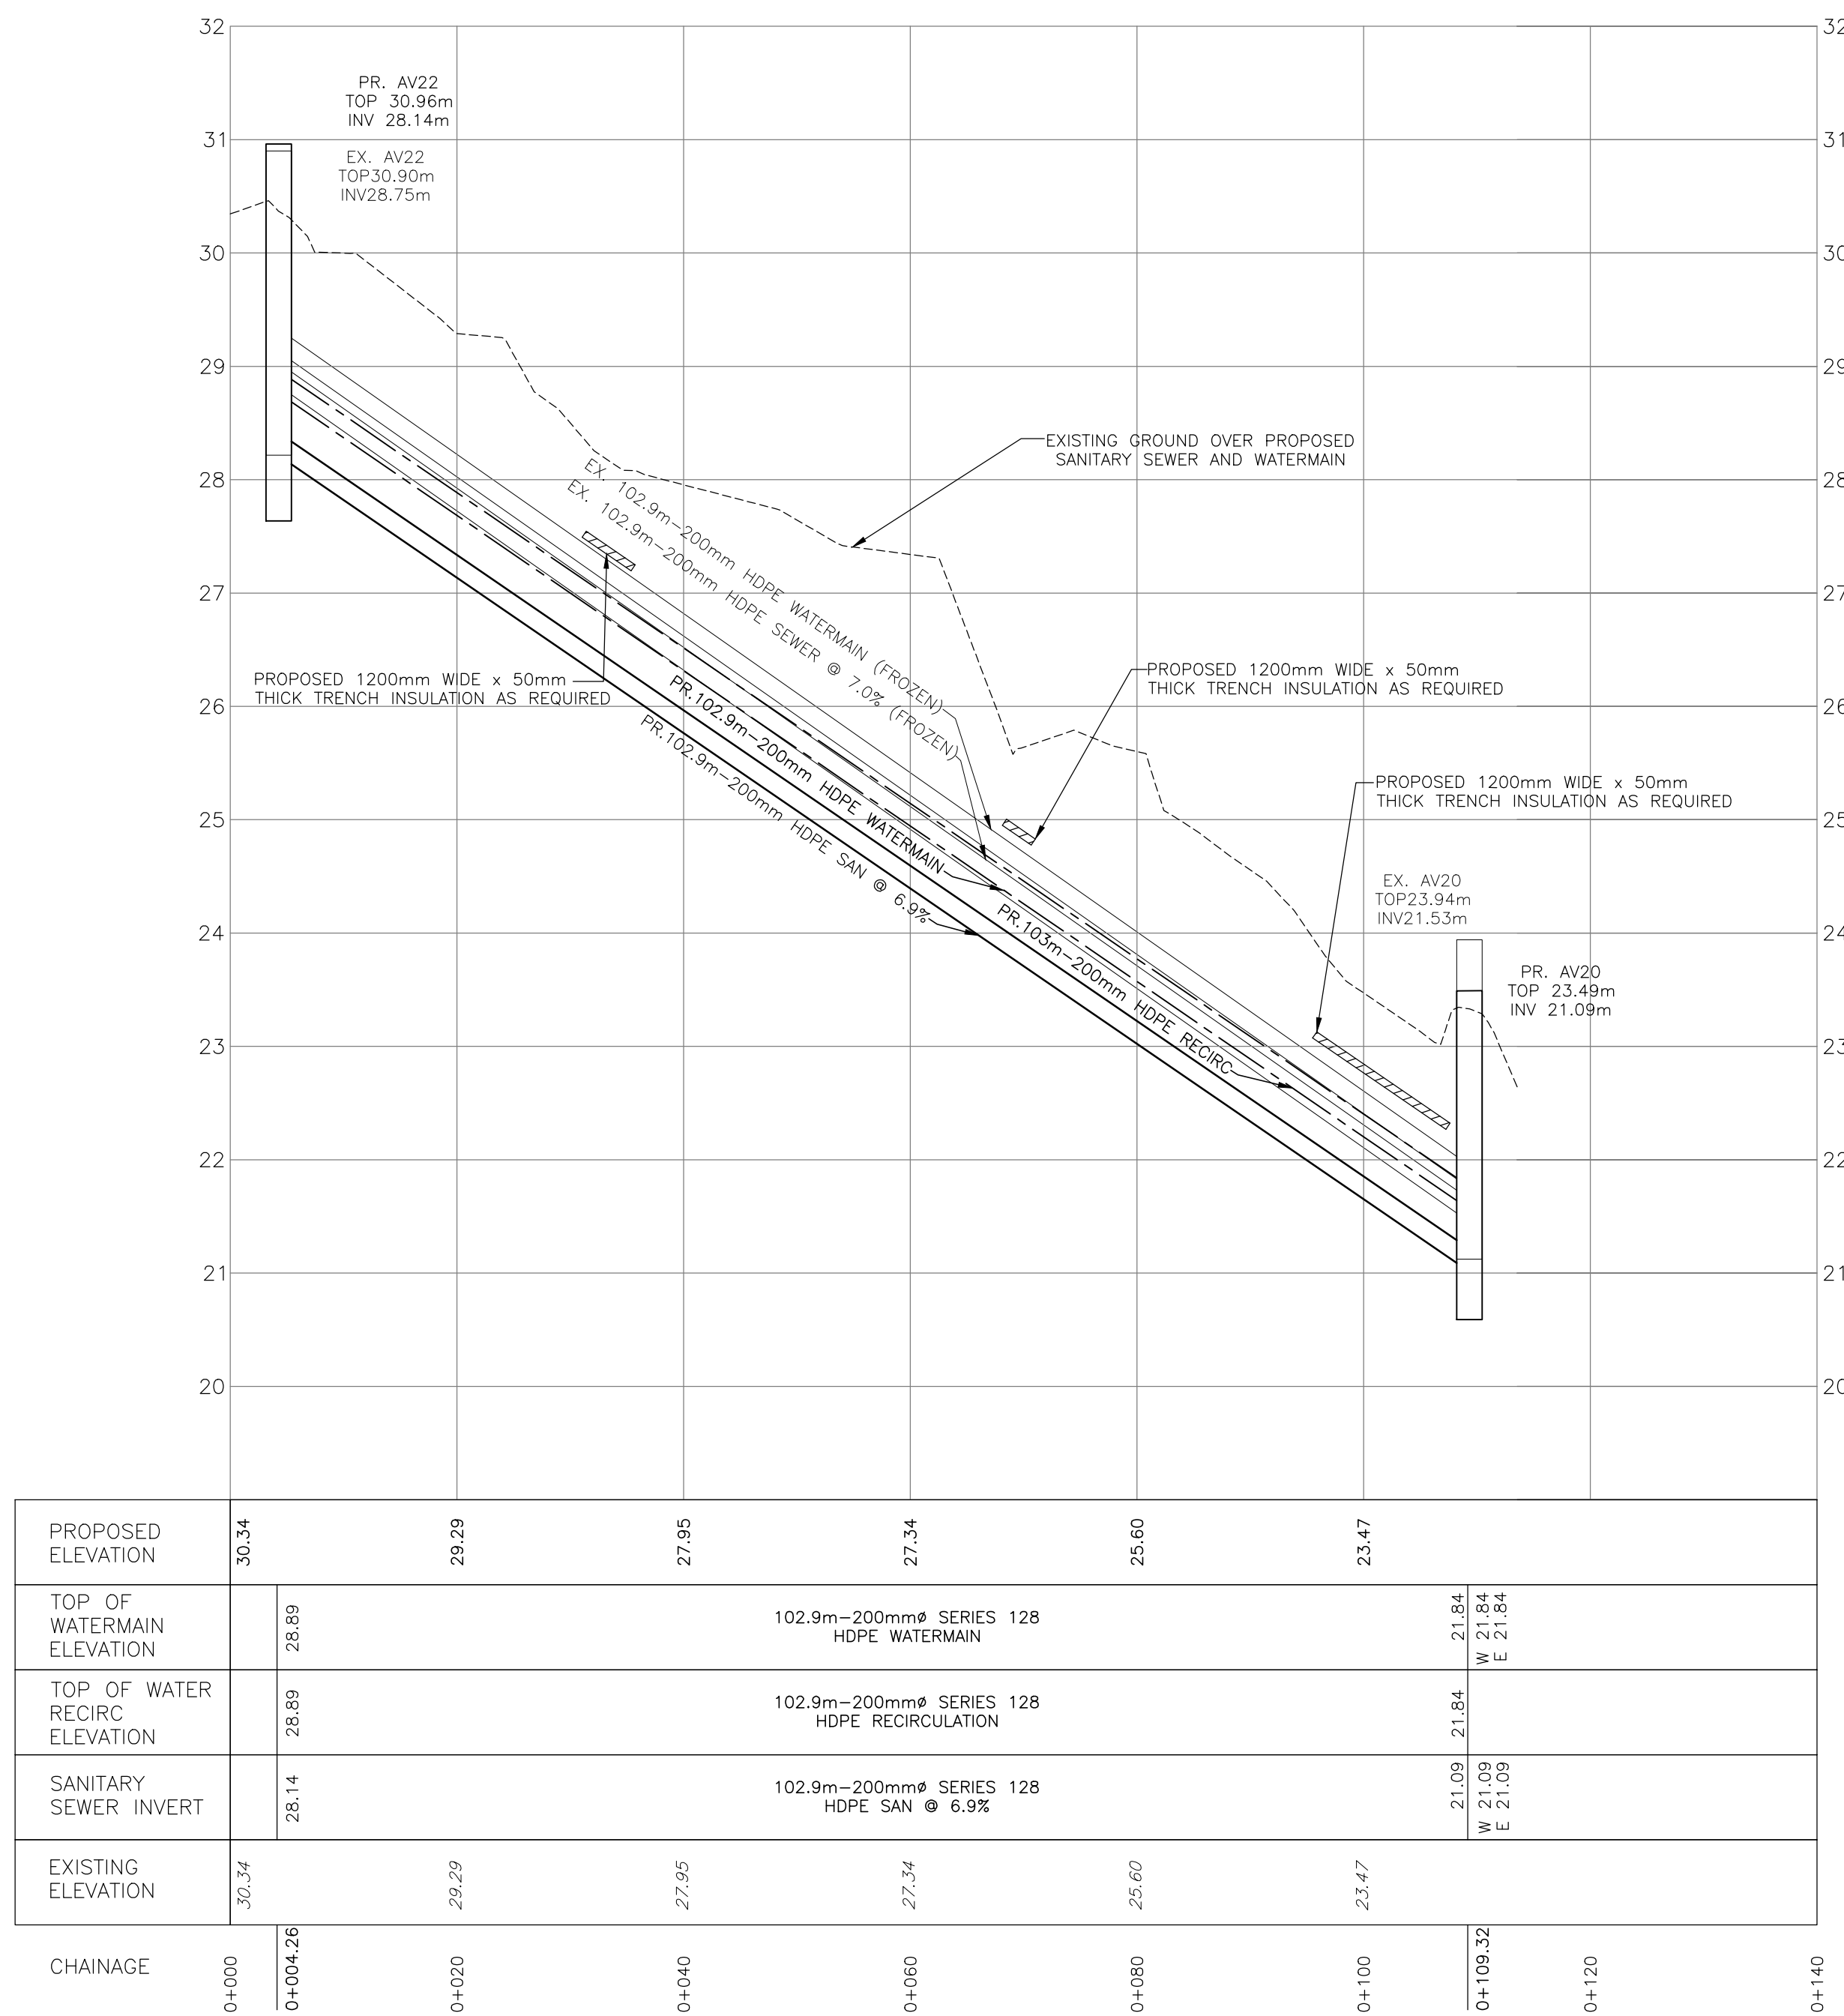


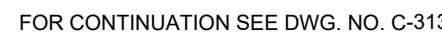

Project Title		
NEW UTILIDOR DESIGN RESOLUTE BAY, NU		
Dwg. Title		
PLAN AND PROFILE AV22 TO AV20		
Project No.		
OTT-00206333-A0		
Dwg. No.	C-315	Rev. No.
Scale		03
1:500		
This drawing is not to be scaled		