
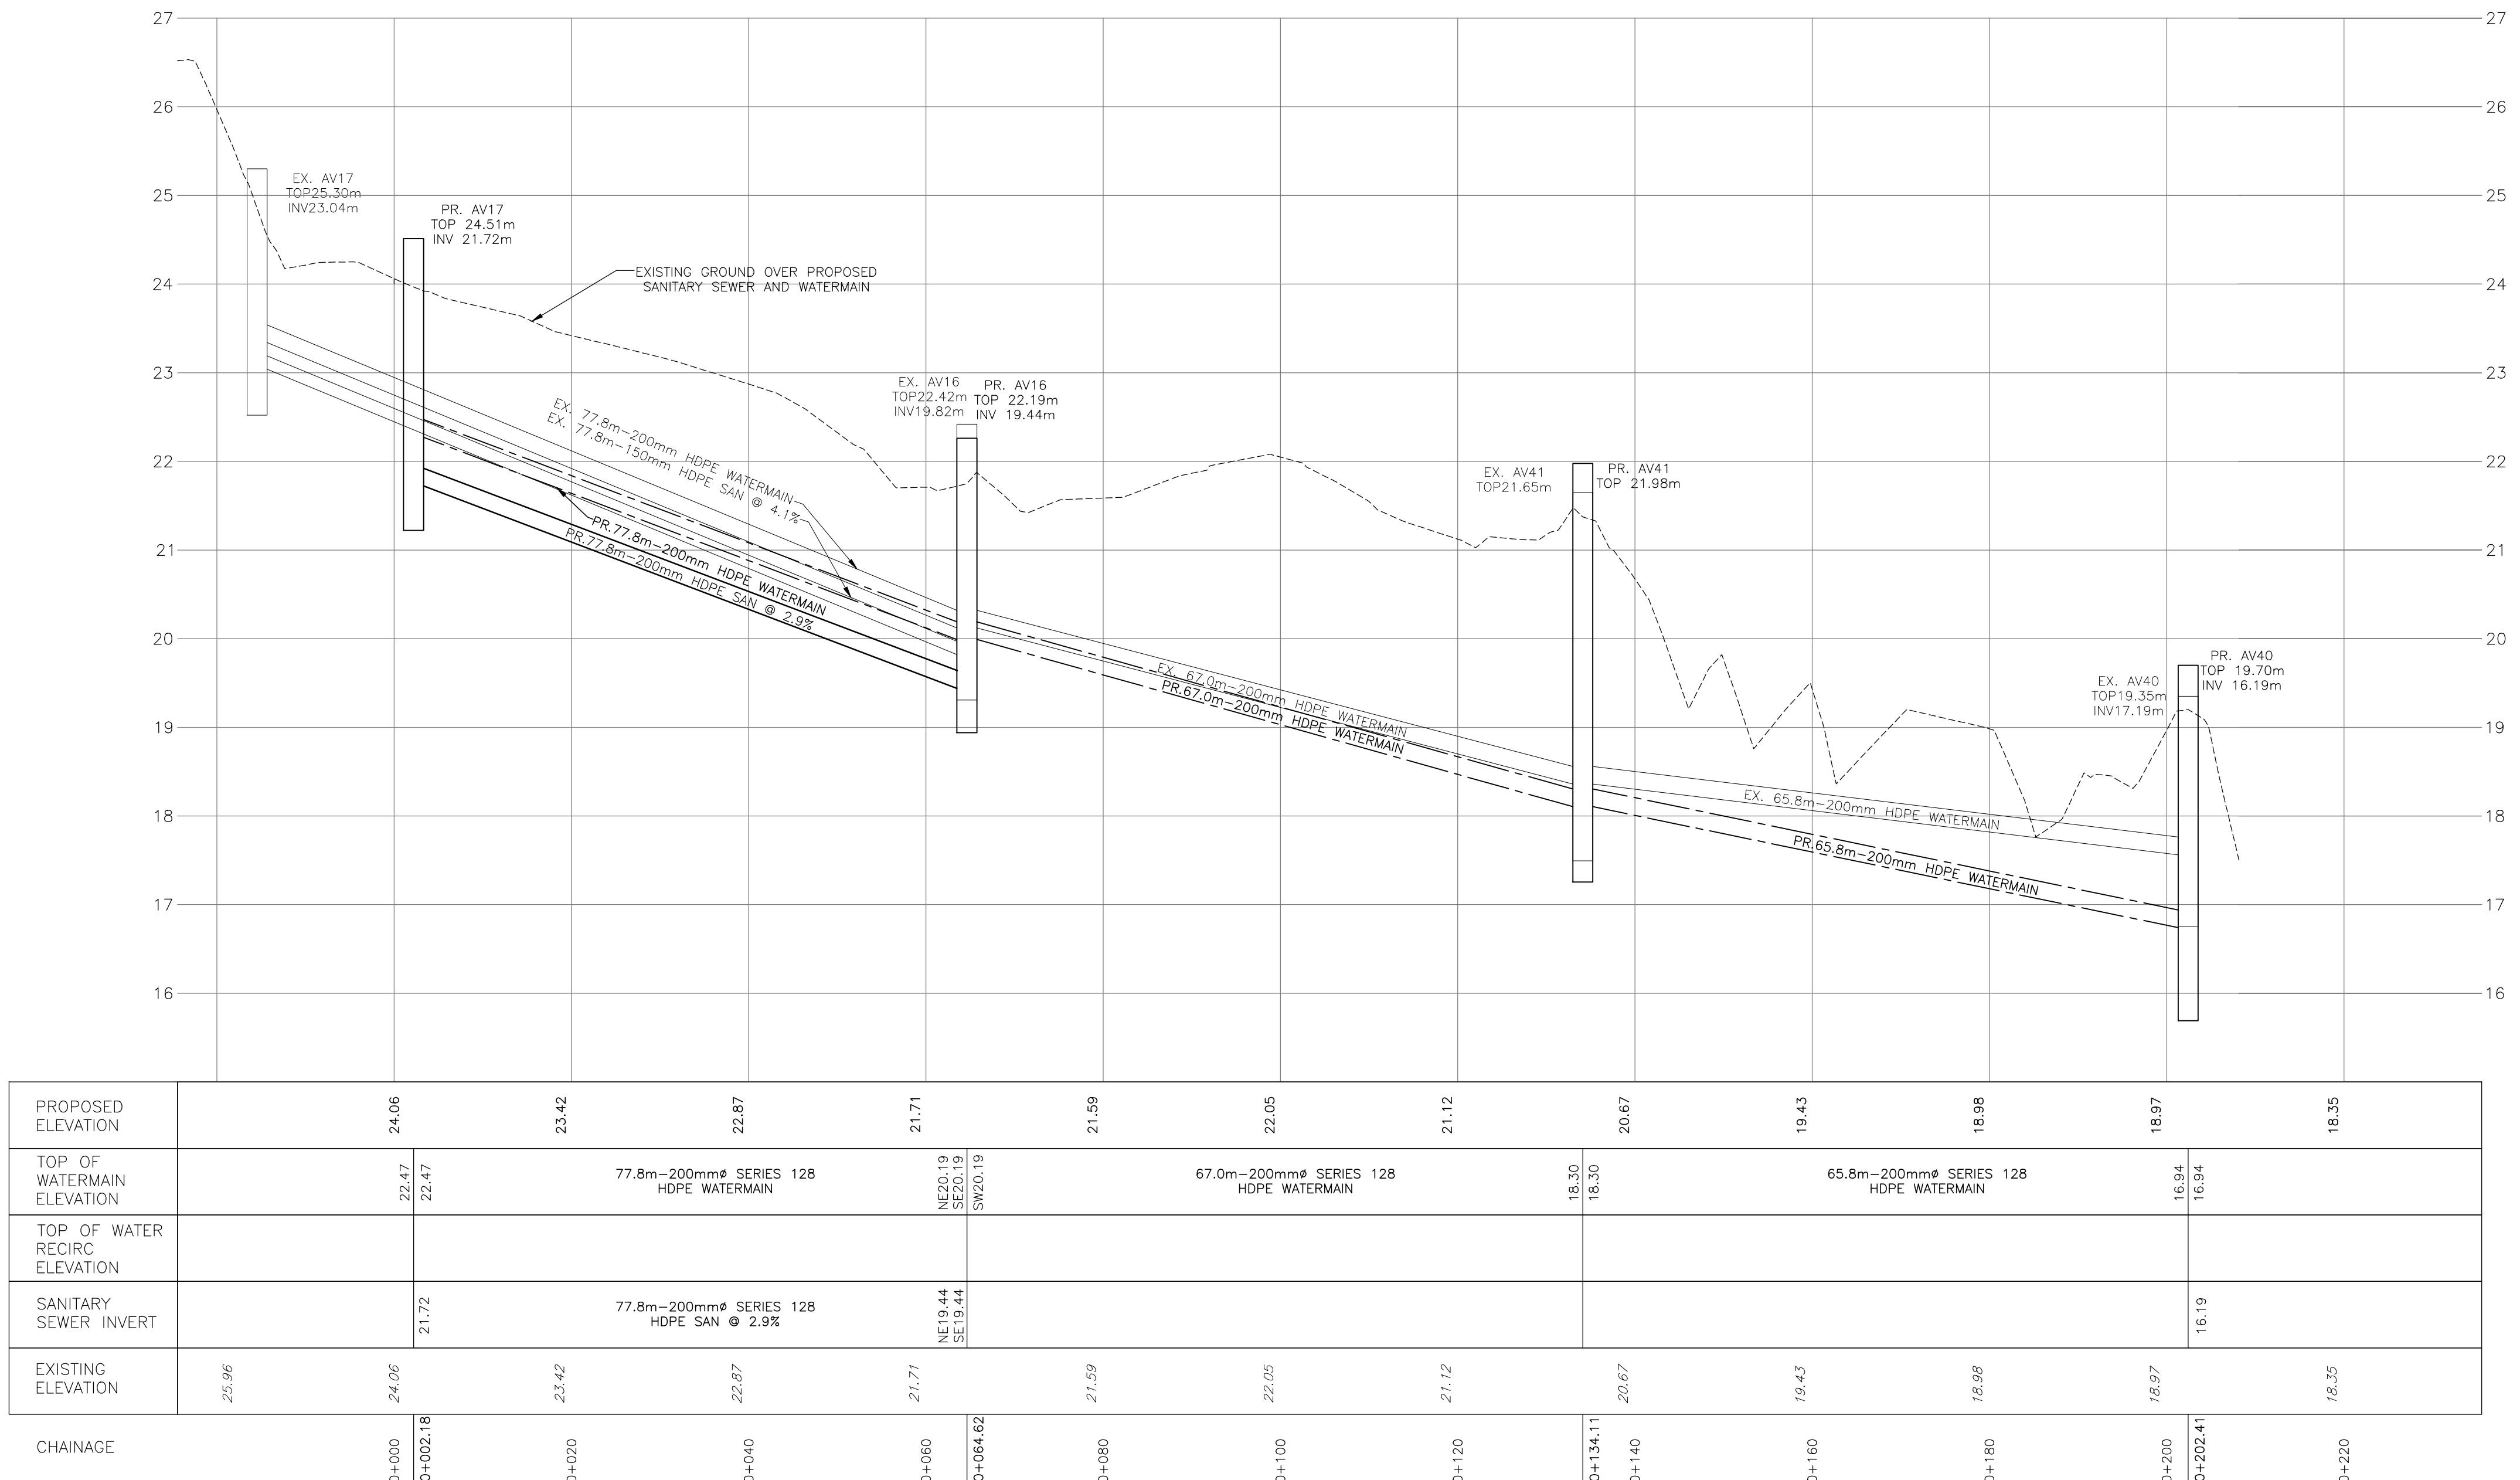


NO DATA BEYOND 0+100

NO DATA BEYOND 0+100

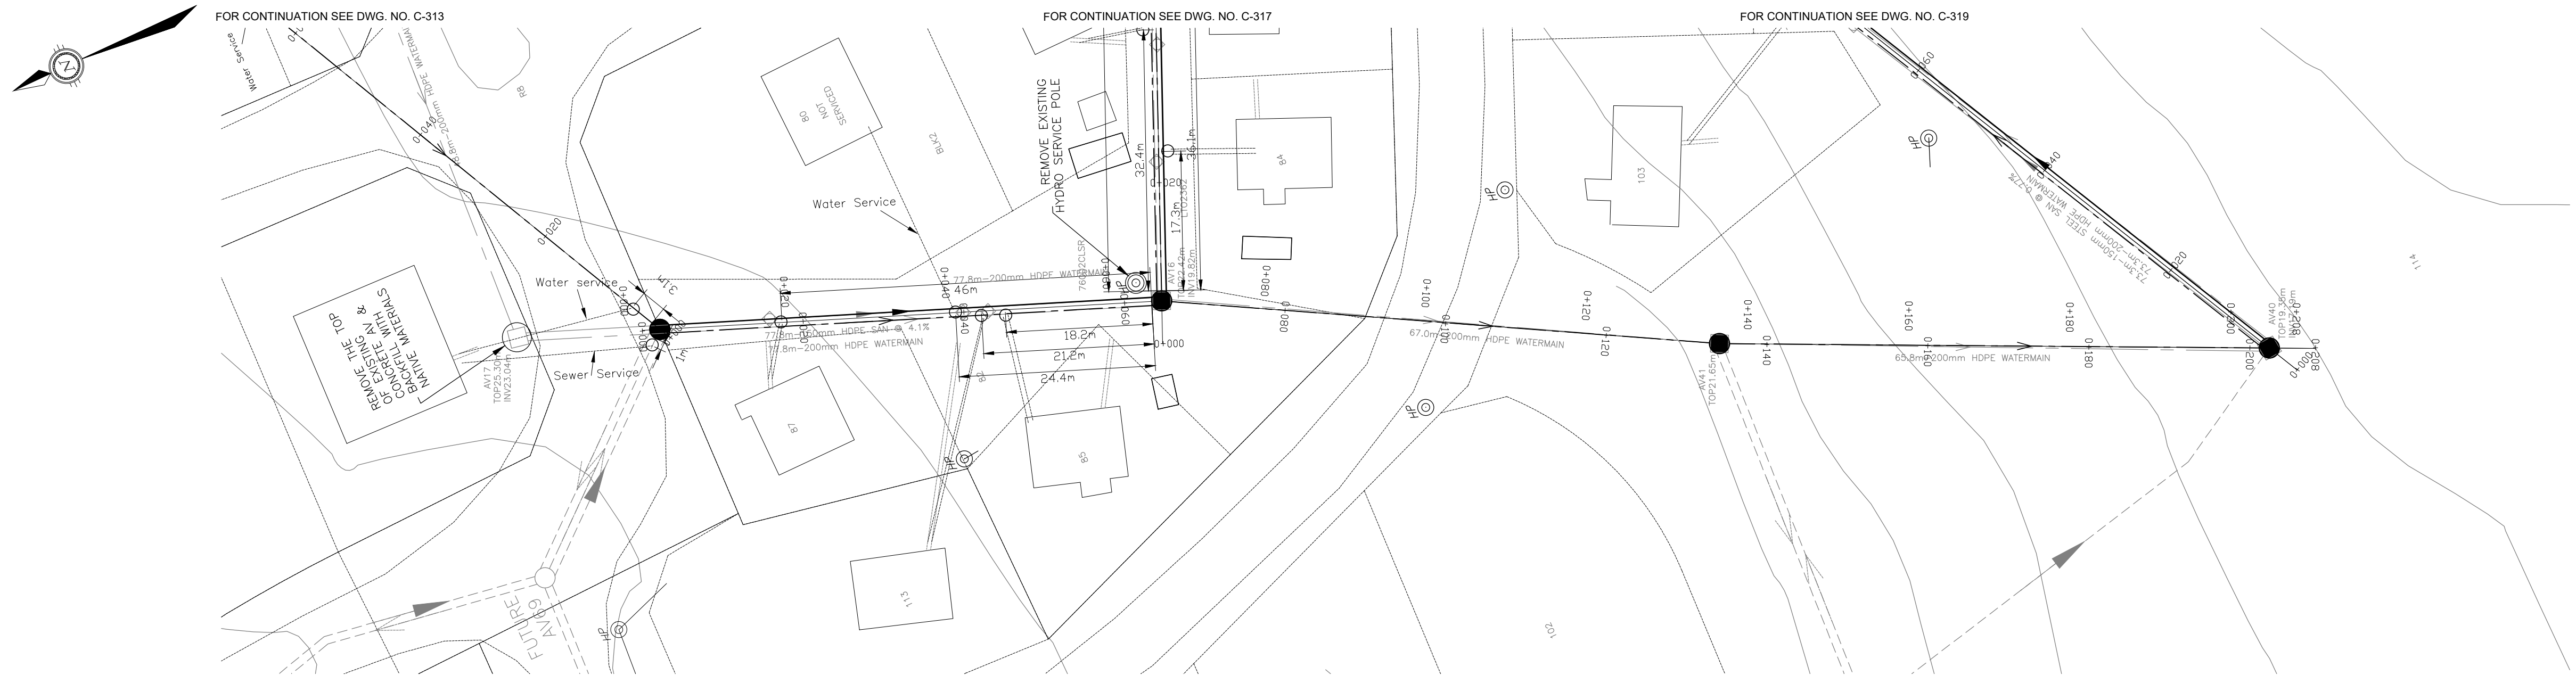

PROPOSED ELEVATION		24.06		23.42		22.87		21.71		21.59		22.05		21.12		20.67		19.43		18.98		18.97		18.35
TOP OF WATERMAIN ELEVATION		22.47	22.47		77.8m-200mmØ SERIES 128 HDPE WATERMAIN			NE20.19 SE20.19	SW20.19			67.0m-200mmØ SERIES 128 HDPE WATERMAIN				18.30 18.30			65.8m-200mmØ SERIES 128 HDPE WATERMAIN				16.94 16.94	
TOP OF WATER RECIRC ELEVATION																								
SANITARY SEWER INVERT		21.72			77.8m-200mmØ SERIES 128 HDPE SAN @ 2.9%			NE19.44 SE19.44															16.19	
EXISTING ELEVATION	23.96	24.06		23.42		22.87		21.71		21.59		22.05		21.12		20.67		19.43		18.98		18.97		18.35

No.

Issue

Date

01

ISSUED FOR TENDER

2013-MAR-25

02

REISSUED FOR TENDER

2013-OCT-25

03

ISSUED FOR CONSTRUCTION

2014-APR-21

04

ISSUED FOR AS-BUILT

2016-APR-26



AS-BUILT

DATE: APRIL 26, 2016

00	100% SUBMISSION	SLB	2013-MAR-04
No.	Revision	Ckd. By	Date

Const. North

Drawn By: I.CRAWFORD

Dwg. Standards Ckd. By:

Designed By: A. ZARAD

Date Printed

Dwg. Design Ckd. By: S. BURDEN

exp Services Inc.

t: +1.613.688.1899 | f: +1.613.225.7330

2650 Queensview Drive, Unit 100

Ottawa, ON K2B 8H6

CANADA

www.exp.com



BUILDINGS • EARTH & ENVIRONMENT • ENERGY • INDUSTRIAL • INFRASTRUCTURE • SUSTAINABILITY

Project Title

NEW UTILIDOR DESIGN

RESOLUTE BAY, NU

Dwg. Title

PLAN AND PROFILE

AV17 TO AV40

Project No.

OTT-00206333-A0

Dwg. No.

C-318

Rev. No.

03

Scale

1:500

This drawing is not to be scaled