


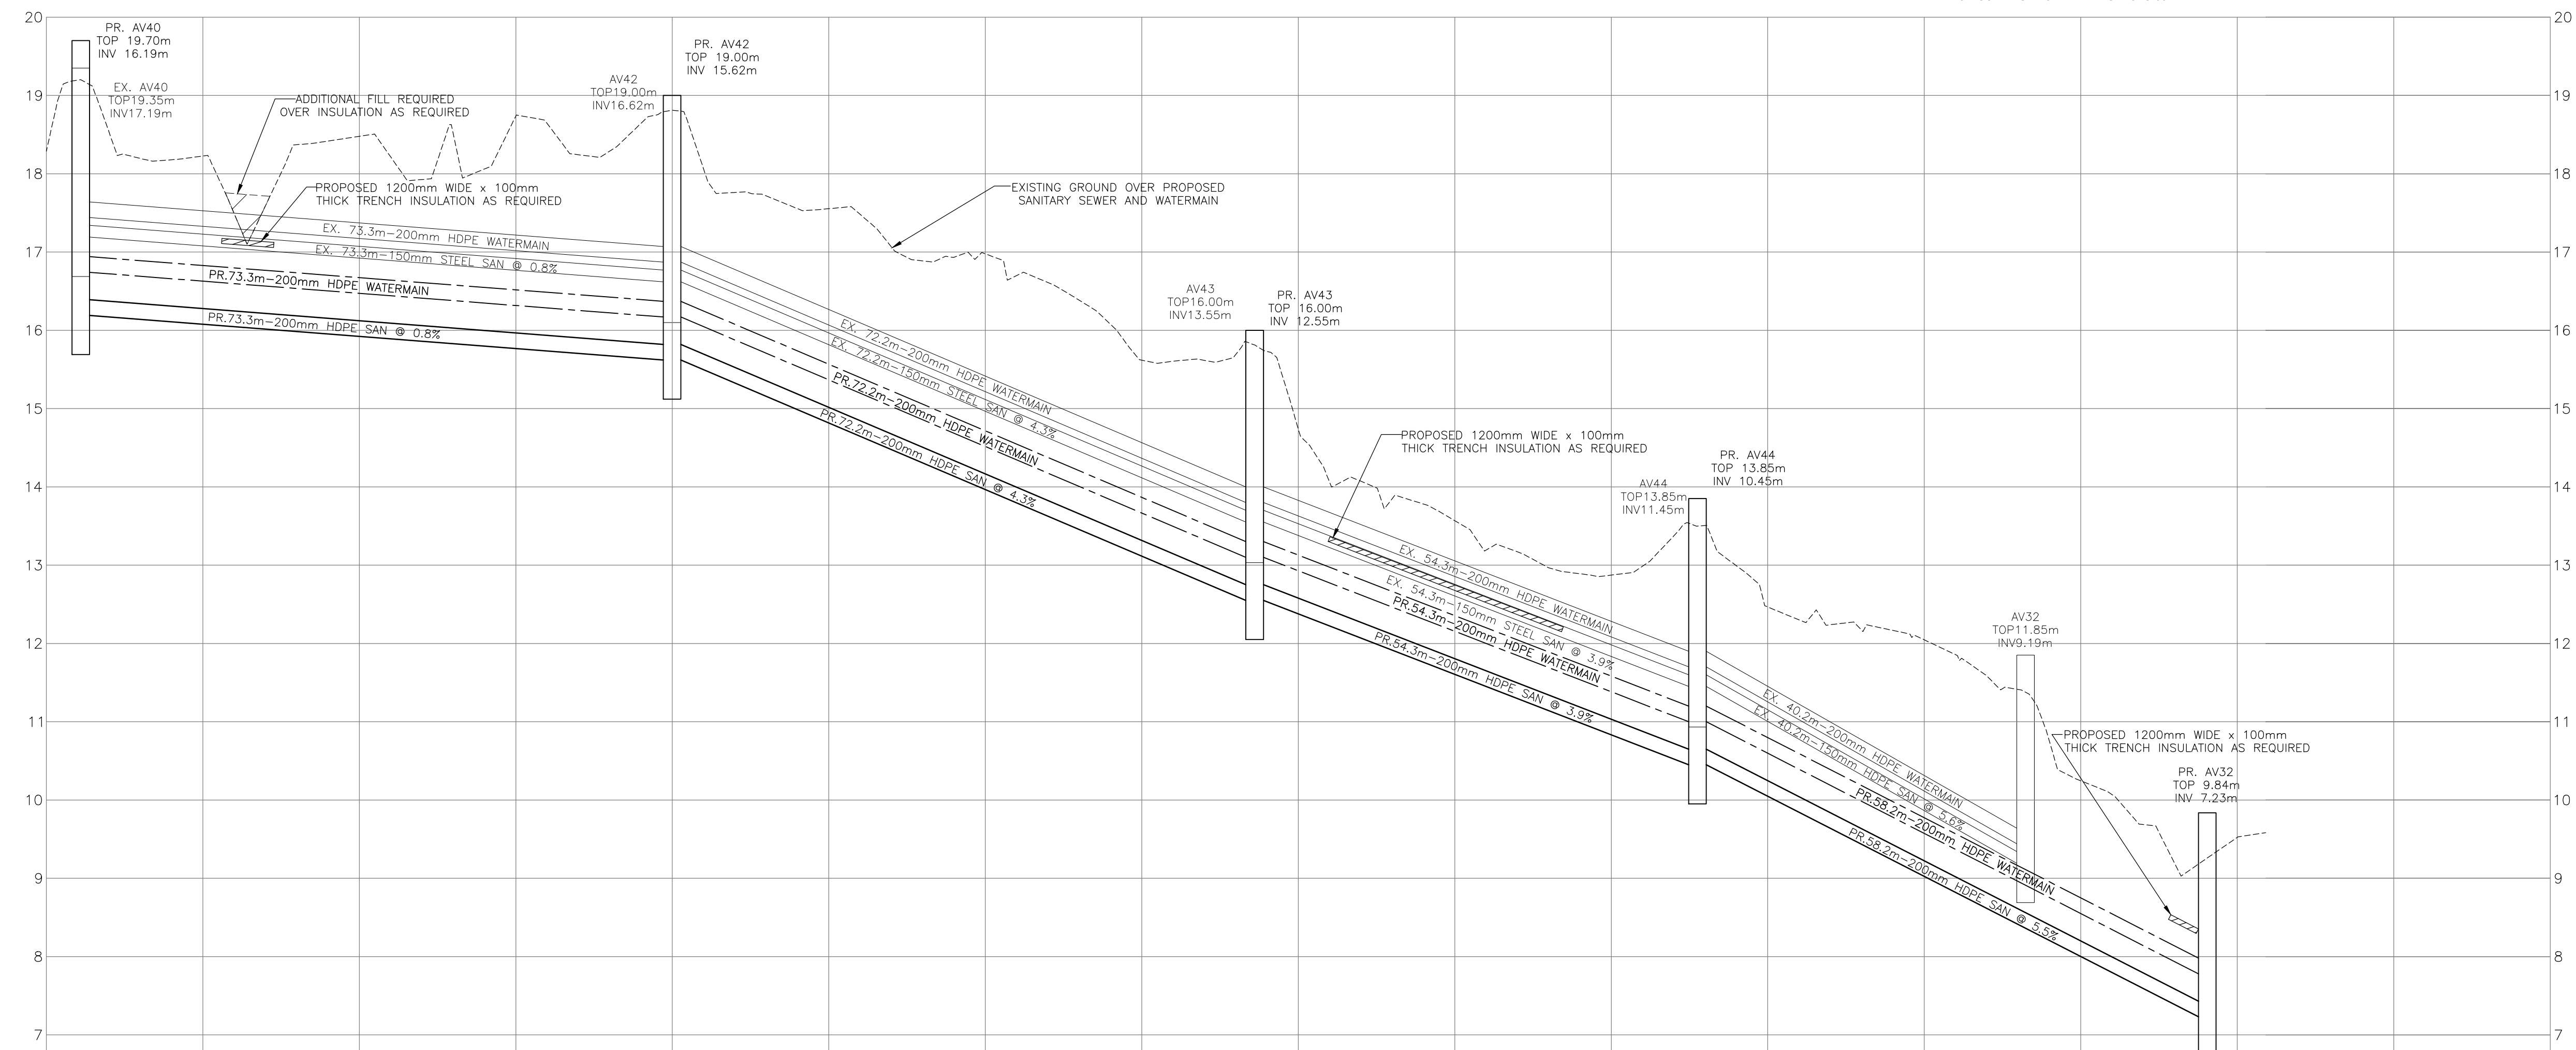

		PROPOSED ELEVATION	18.29	18.23	18.48	18.74	18.81	17.55	16.98	15.82	14.74	13.57	12.87	12.46	12.05	10.24	8.12				
		TOP OF WATERMAIN ELEVATION	16.94 16.94	73.3m~200mm ϕ SERIES 128 HDPE WATERMAIN				16.37 16.37	72.2m~200mm ϕ SERIES 128 HDPE WATERMAIN				13.30 13.30	54.3m~200mm ϕ SERIES 128 HDPE WATERMAIN				11.20 11.20	58.2m~200mm ϕ SERIES 128 HDPE WATERMAIN		7.98 7.98
		TOP OF WATER RECIRC ELEVATION																			
		SANITARY SEWER INVERT	16.19	73.3m~200mm ϕ SERIES 128 HDPE SAN @ 0.8%				15.62 15.62	72.2m~200mm ϕ SERIES 128 HDPE SAN @ 4.3%				12.55 12.55	54.3m~200mm ϕ SERIES 128 HDPE SAN @ 3.9%				10.45 10.45	58.2m~200mm ϕ SERIES 128 HDPE SAN @ 5.5%		NW 7.23 NE 7.23 SW 7.23
		EXISTING ELEVATION	18.29	18.23	18.48	18.74	18.81	17.55	16.98	15.82	14.74	13.57	12.87	12.46	12.05	10.24	8.12				
CHAINAGE	0+000 0+004.41			0+020	0+040	0+060	0+075.97 0+080	0+100	0+120	0+140	0+160	0+180	0+200	0+211.01 0+220	0+240	0+260	0+276.16 0+280	0+300			

No.	Issue	Date
01	ISSUED FOR TENDER	2013-MAR-25
02	REISSUED FOR TENDER	2013-OCT-25
03	ISSUED FOR CONSTRUCTION	2014-APR-21
04	ISSUED FOR AS-BUILT	2016-APR-26



AS-BUILT

DATE: APRIL 26, 2016

00	100% SUBMISSION	SLB	2013-MAR-04
No.	Revision	Ckd. By	Date

	Const. North
	Drawn By: I. CRAWFORD
	Dwg. Standards Ckd. By:
	Designed By: A. ZARAD
Date Printed	Dwg. Design Ckd. By: S. BURDEN

exp Services Inc.
t: +1.613.688.1899 | f: +1.613.225.7330
2650 Queensview Drive, Unit 100
Ottawa, ON K2B 8H6
CANADA
www.exp.com



• BUILDINGS • EARTH & ENVIRONMENT • ENERGY •
• INDUSTRIAL • INFRASTRUCTURE • SUSTAINABILITY •

Project Title

NEW UTILIDOR DESIGN
RESOLUTE BAY, NU

Dwg. Title

PLAN AND PROFILE AV40 TO AV32

Project No. OTT-00206333-A0

Dwg. No.	C-319	Rev. No.	03
----------	--------------	----------	----

Scale	1:500
-------	-------