




DATE: APRIL 26, 2016

exp Services Inc.
t: +1.613.688.1899 | f: +1.613.225.7330
2650 Queensview Drive, Unit 100
Ottawa, ON K2B 8H6
CANADA
www.exp.com

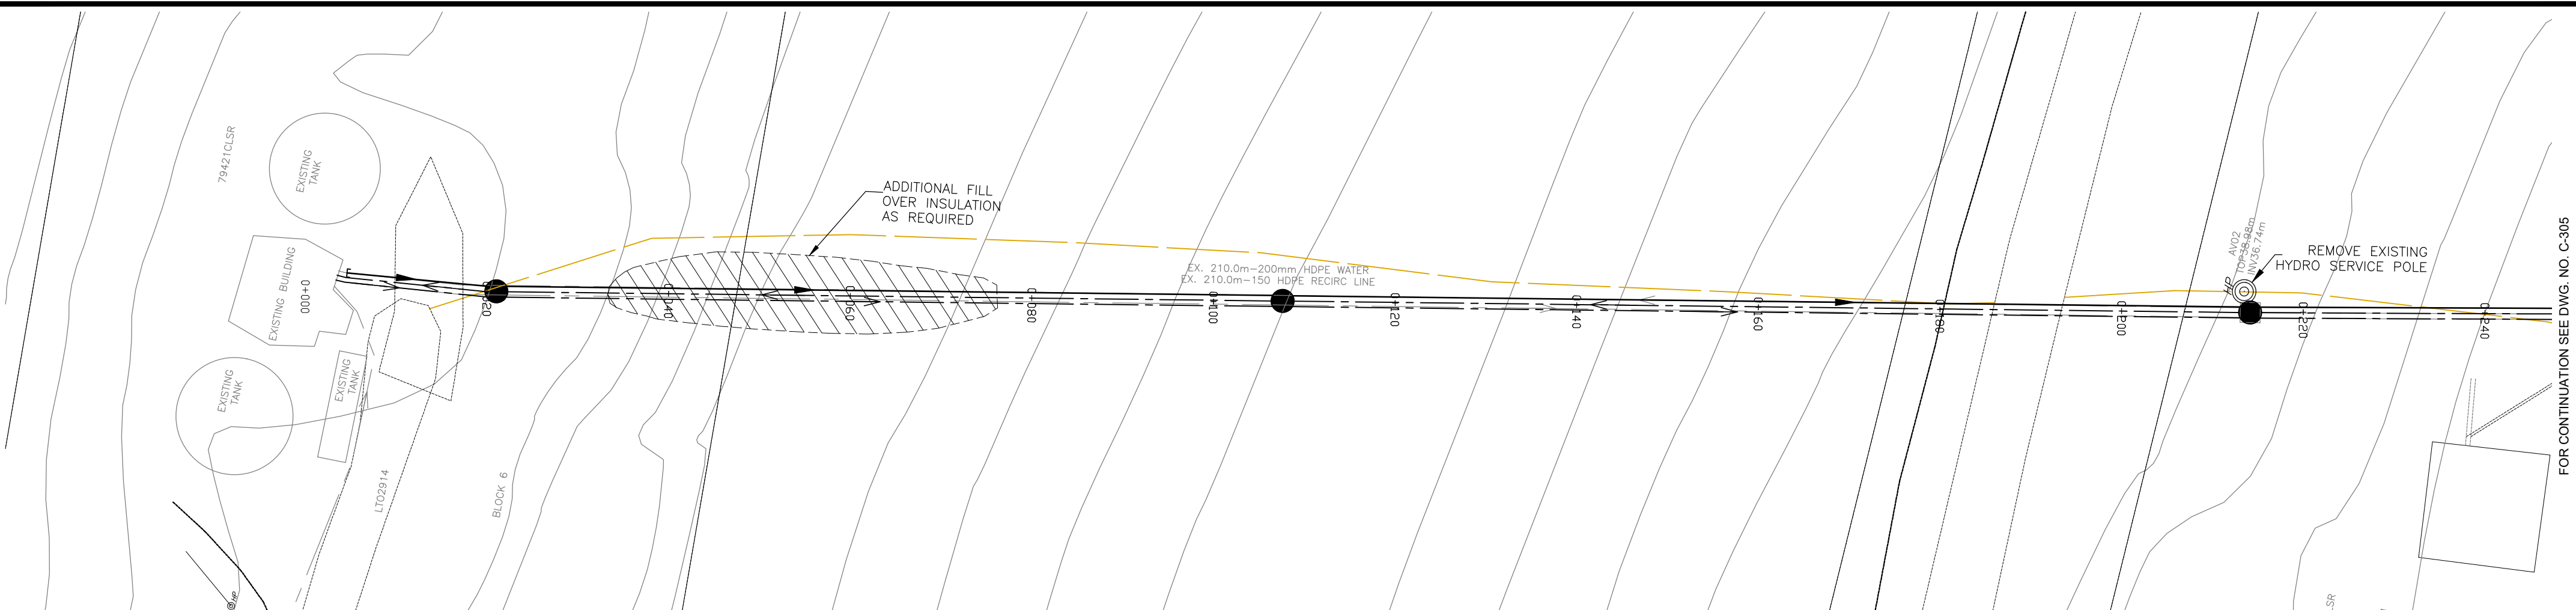

Project Title

NEW UTILIDOR DESIGN
RESOLUTE BAY, NU

PLAN AND PROFILE SIGNAL HILL TO AV02

Scale

1:500