


DATE: 13-03-2016 10:00:00 AM PROJECT: NEW UTILIDOR DESIGN RESOLUTE BAY, NU PROJECT NO: C-306

NO. 001-18-0000

EXP SERVICES INC.

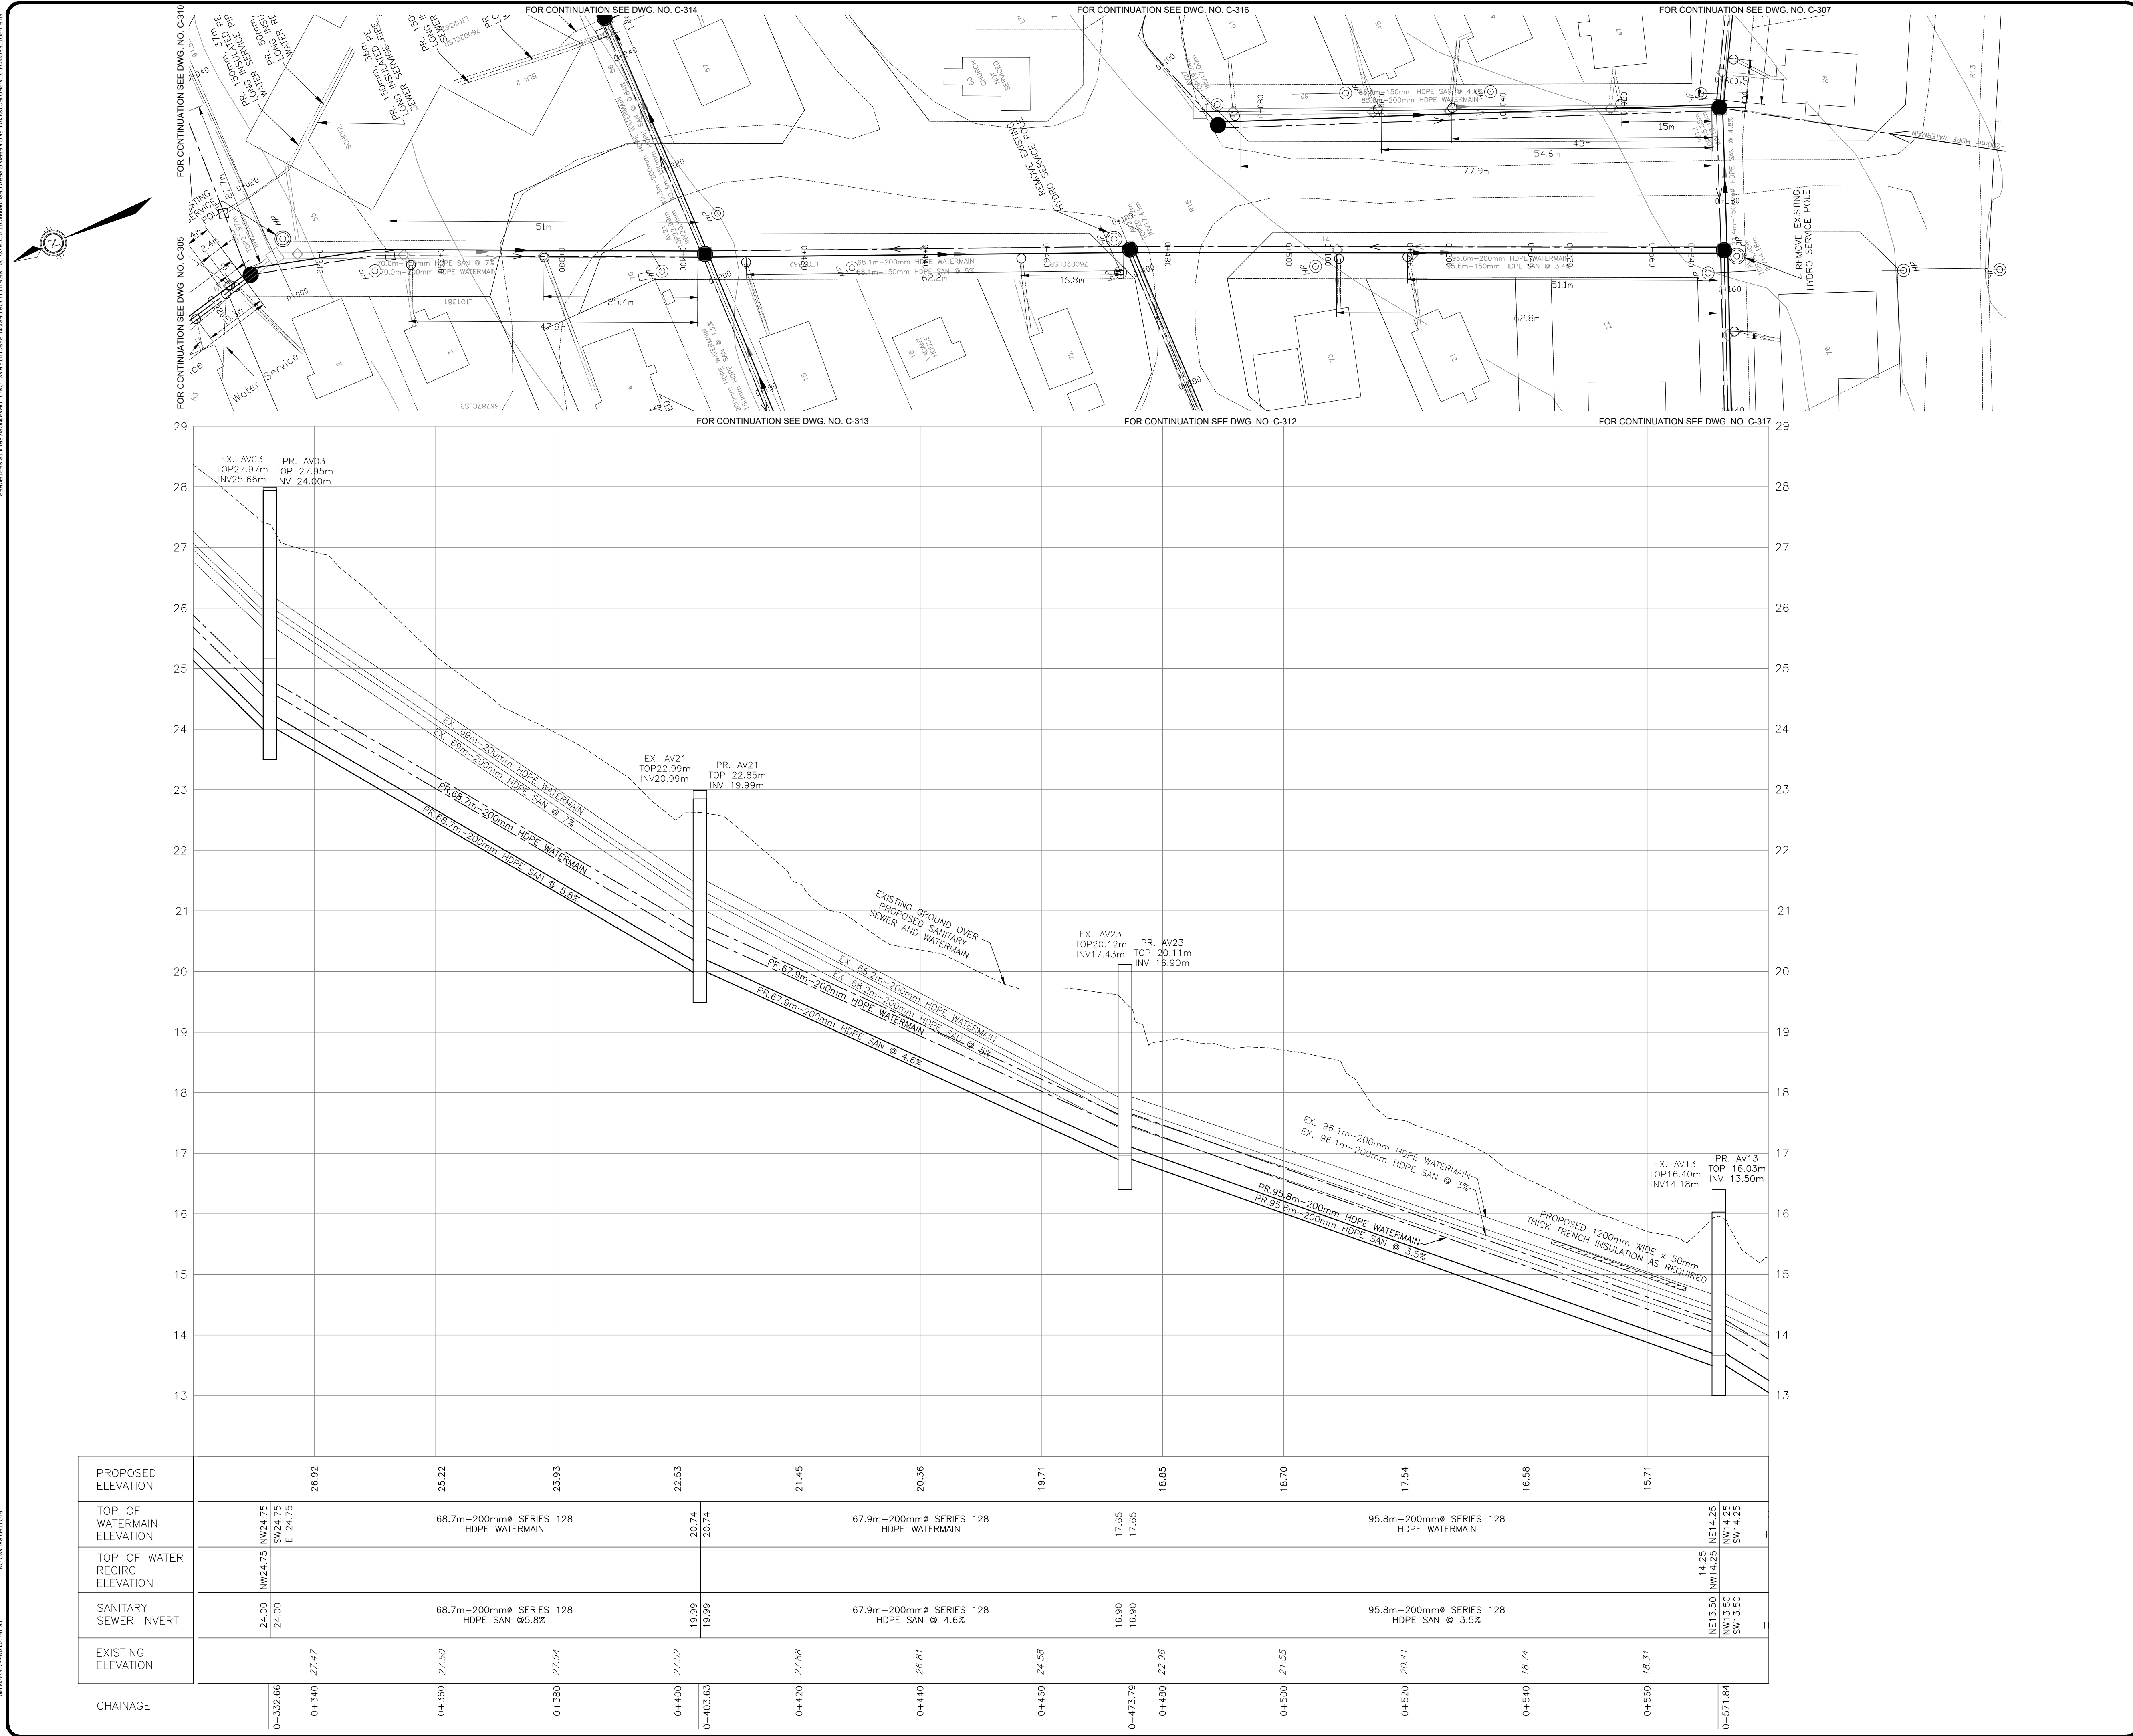

No.

Issue

Date

01

ISSUED FOR TENDER

2013-MAR-25

02

REISSUED FOR TENDER

2013-OCT-25

03

ISSUED FOR CONSTRUCTION

2014-APR-21

04

ISSUED FOR AS-BUILT

2016-APR-26



AS-BUILT

DATE: APRIL 26, 2016

00

100% SUBMISSION

SLB

2013-MAR-04

No.

Revision

Ckd. By

Date

Const. North

Drawn By: I.CRAWFORD

Dwg. Standards Ckd. By:

Designed By: A. ZARAD

Date Printed

Dwg. Design Ckd. By: S. BURDEN

exp Services Inc.

t: +1.613.688.1899 | f: +1.613.225.7330

2650 Queensview Drive, Unit 100

Ottawa, ON K2B 8H6

CANADA

www.exp.com



• BUILDINGS • EARTH & ENVIRONMENT • ENERGY •

• INDUSTRIAL • INFRASTRUCTURE • SUSTAINABILITY •

Project Title

NEW UTILIDOR DESIGN
RESOLUTE BAY, NU

Dwg. Title

PLAN AND PROFILE
AV03 TO AV13

Project No.

OTT-00206333-A0

Dwg. No.

C-306

Rev. No.

03

Scale

1:500

This drawing is not to be scaled

exp Services Inc. © 2012