
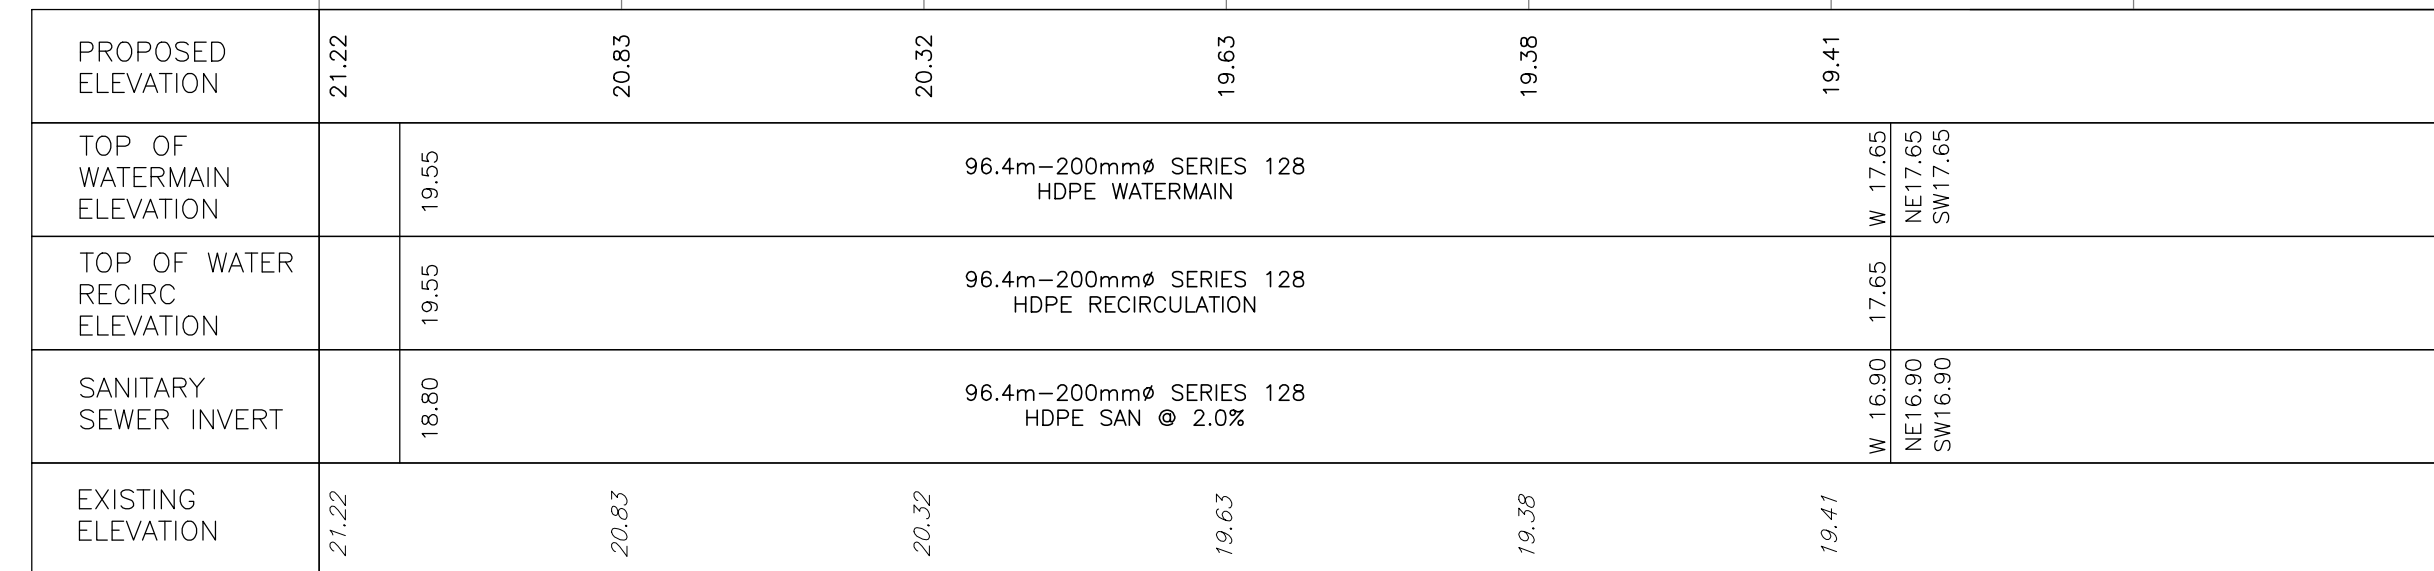


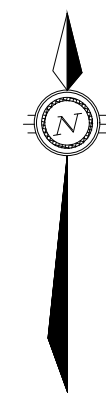

DATE: APRIL 26, 2016

No.	Revision	Ckd. By	Date
-----	----------	---------	------

Date Printed

www.exp.com



Project Title

Dwg. Title

Scale	
-------	--

1:500
This drawing is not to be scaled