



NO DATE 48 BELLONG
NUNAVUT'S INFRASTRUCTURE BOARD AND LUTHERAN NORTH DIVISION OF THE LUTHERAN CHURCH IN CANADA
NUNAVUT'S INFRASTRUCTURE BOARD AND LUTHERAN NORTH DIVISION OF THE LUTHERAN CHURCH IN CANADA

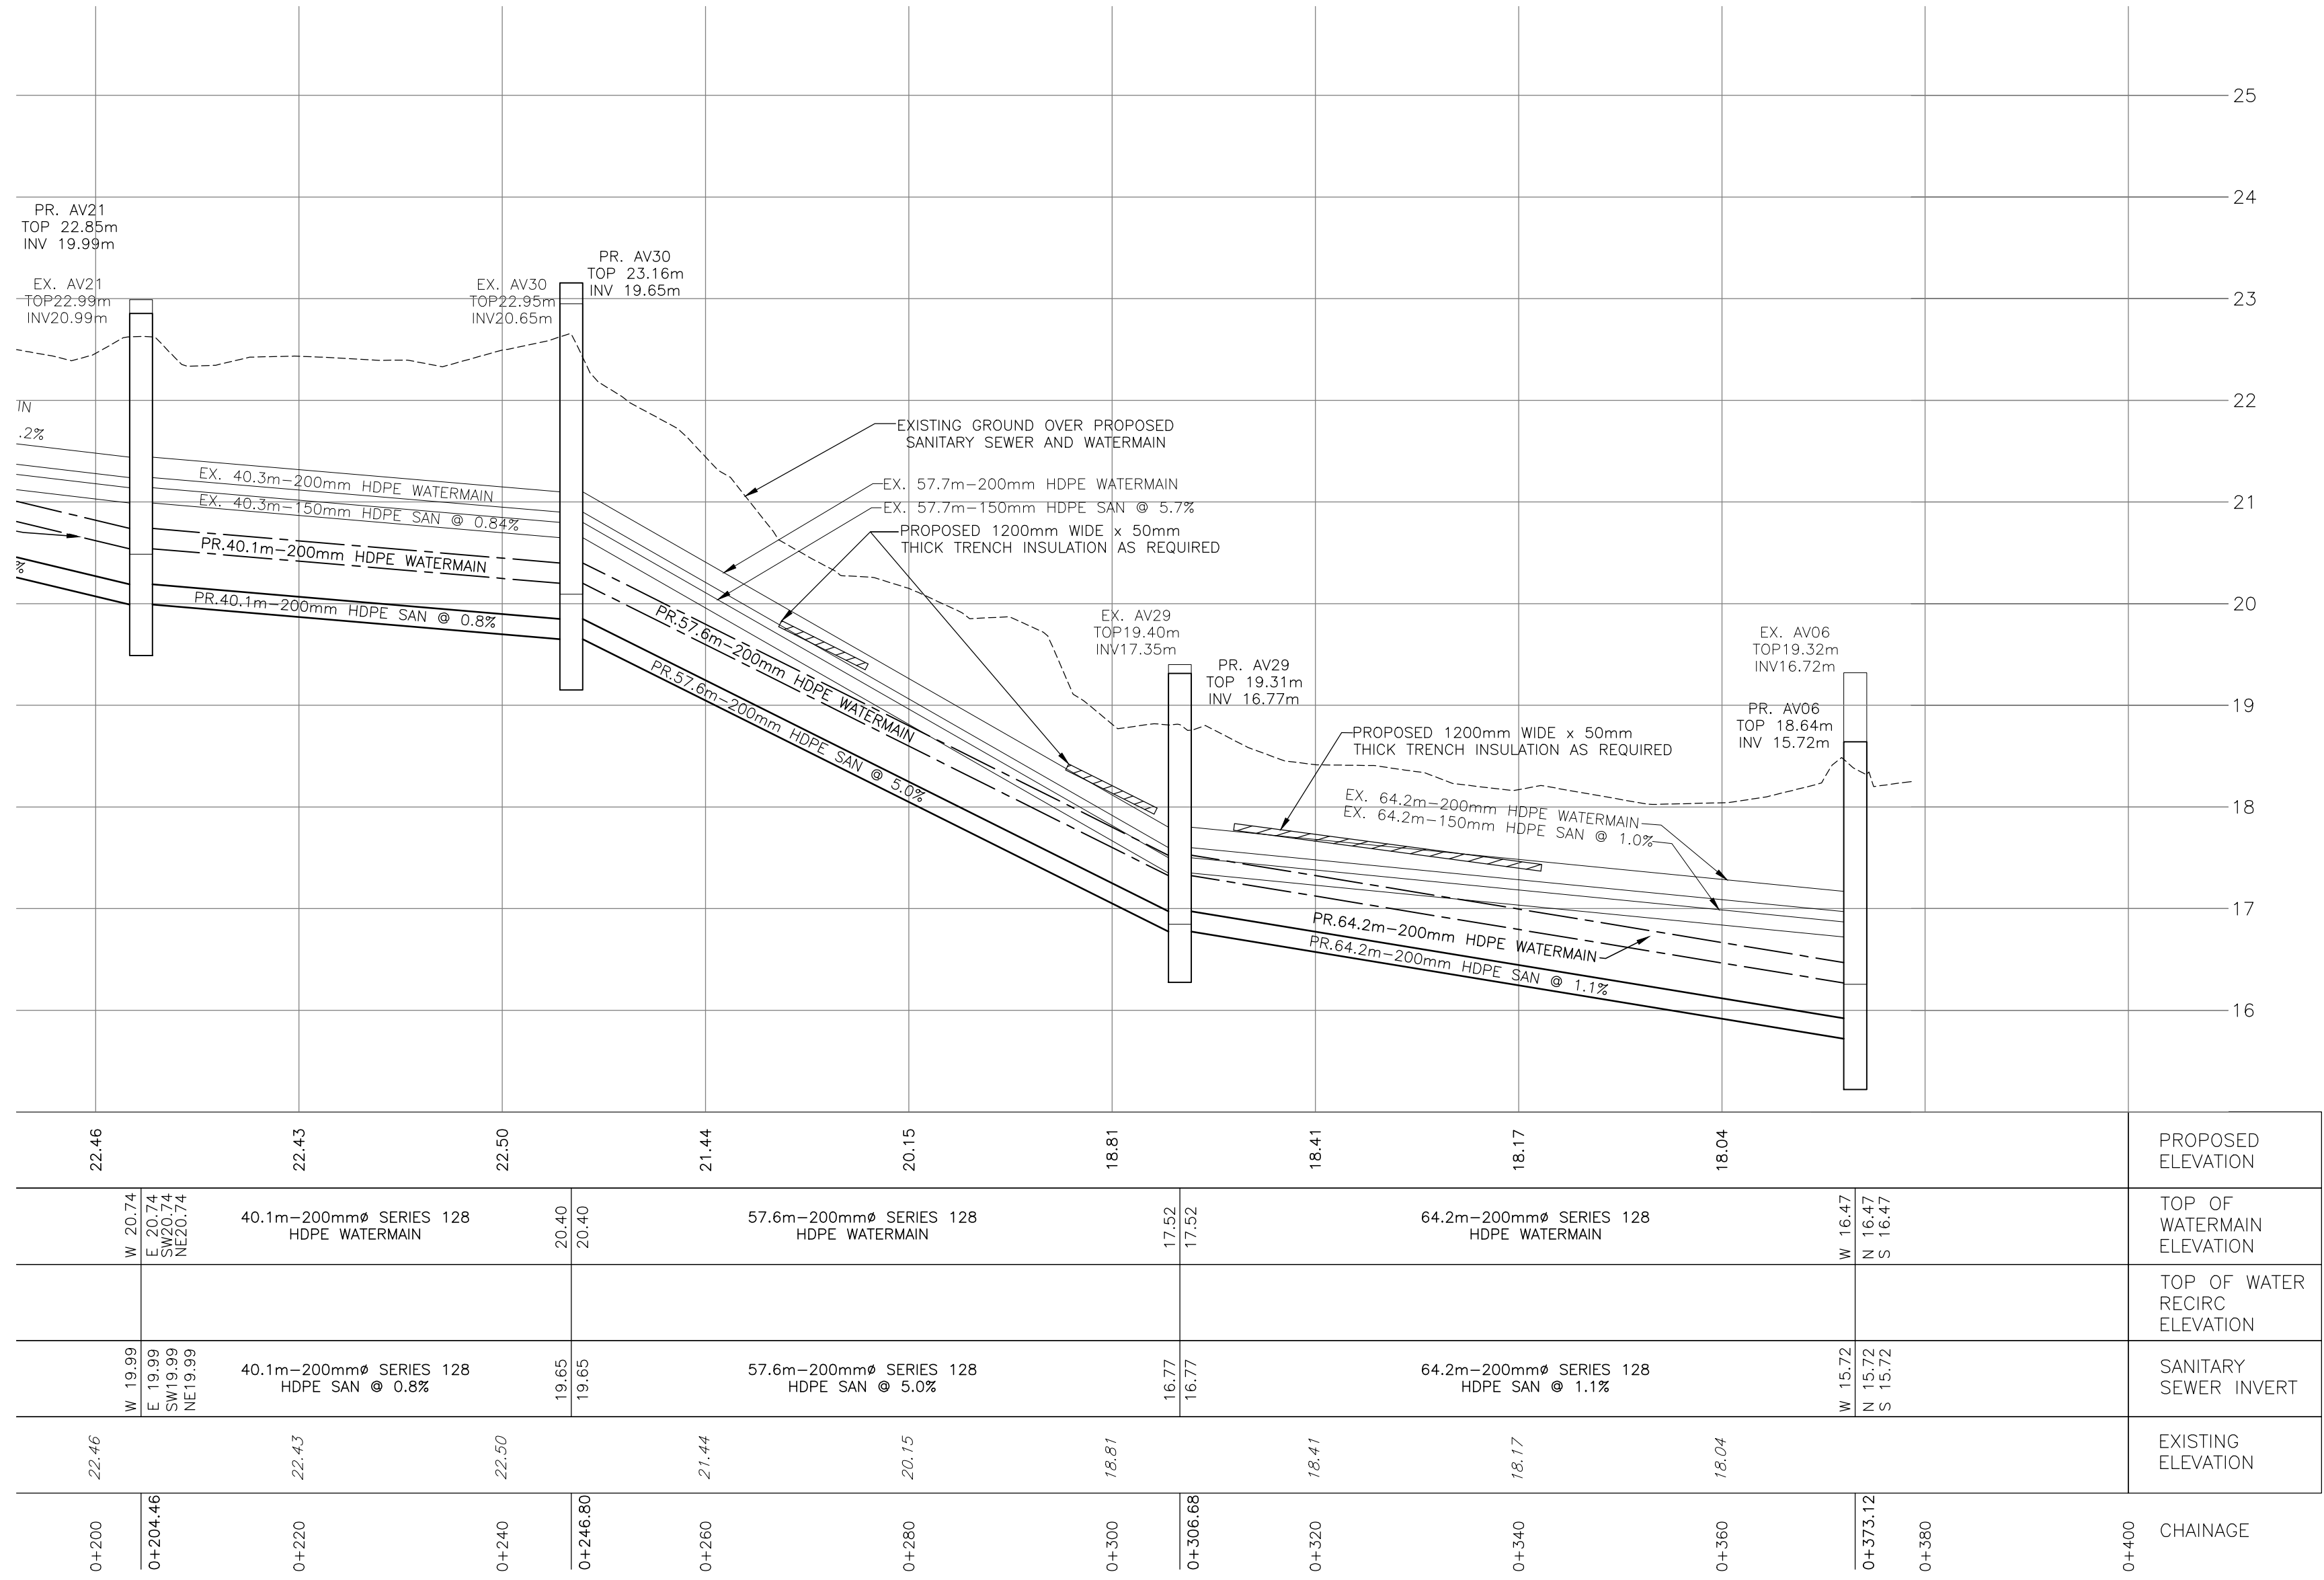

No.	Issue	Date
01	ISSUED FOR TENDER	2013-MAR-25
02	REISSUED FOR TENDER	2013-OCT-25
03	ISSUED FOR CONSTRUCTION	2014-APR-21
04	ISSUED FOR AS-BUILT	2016-APR-26

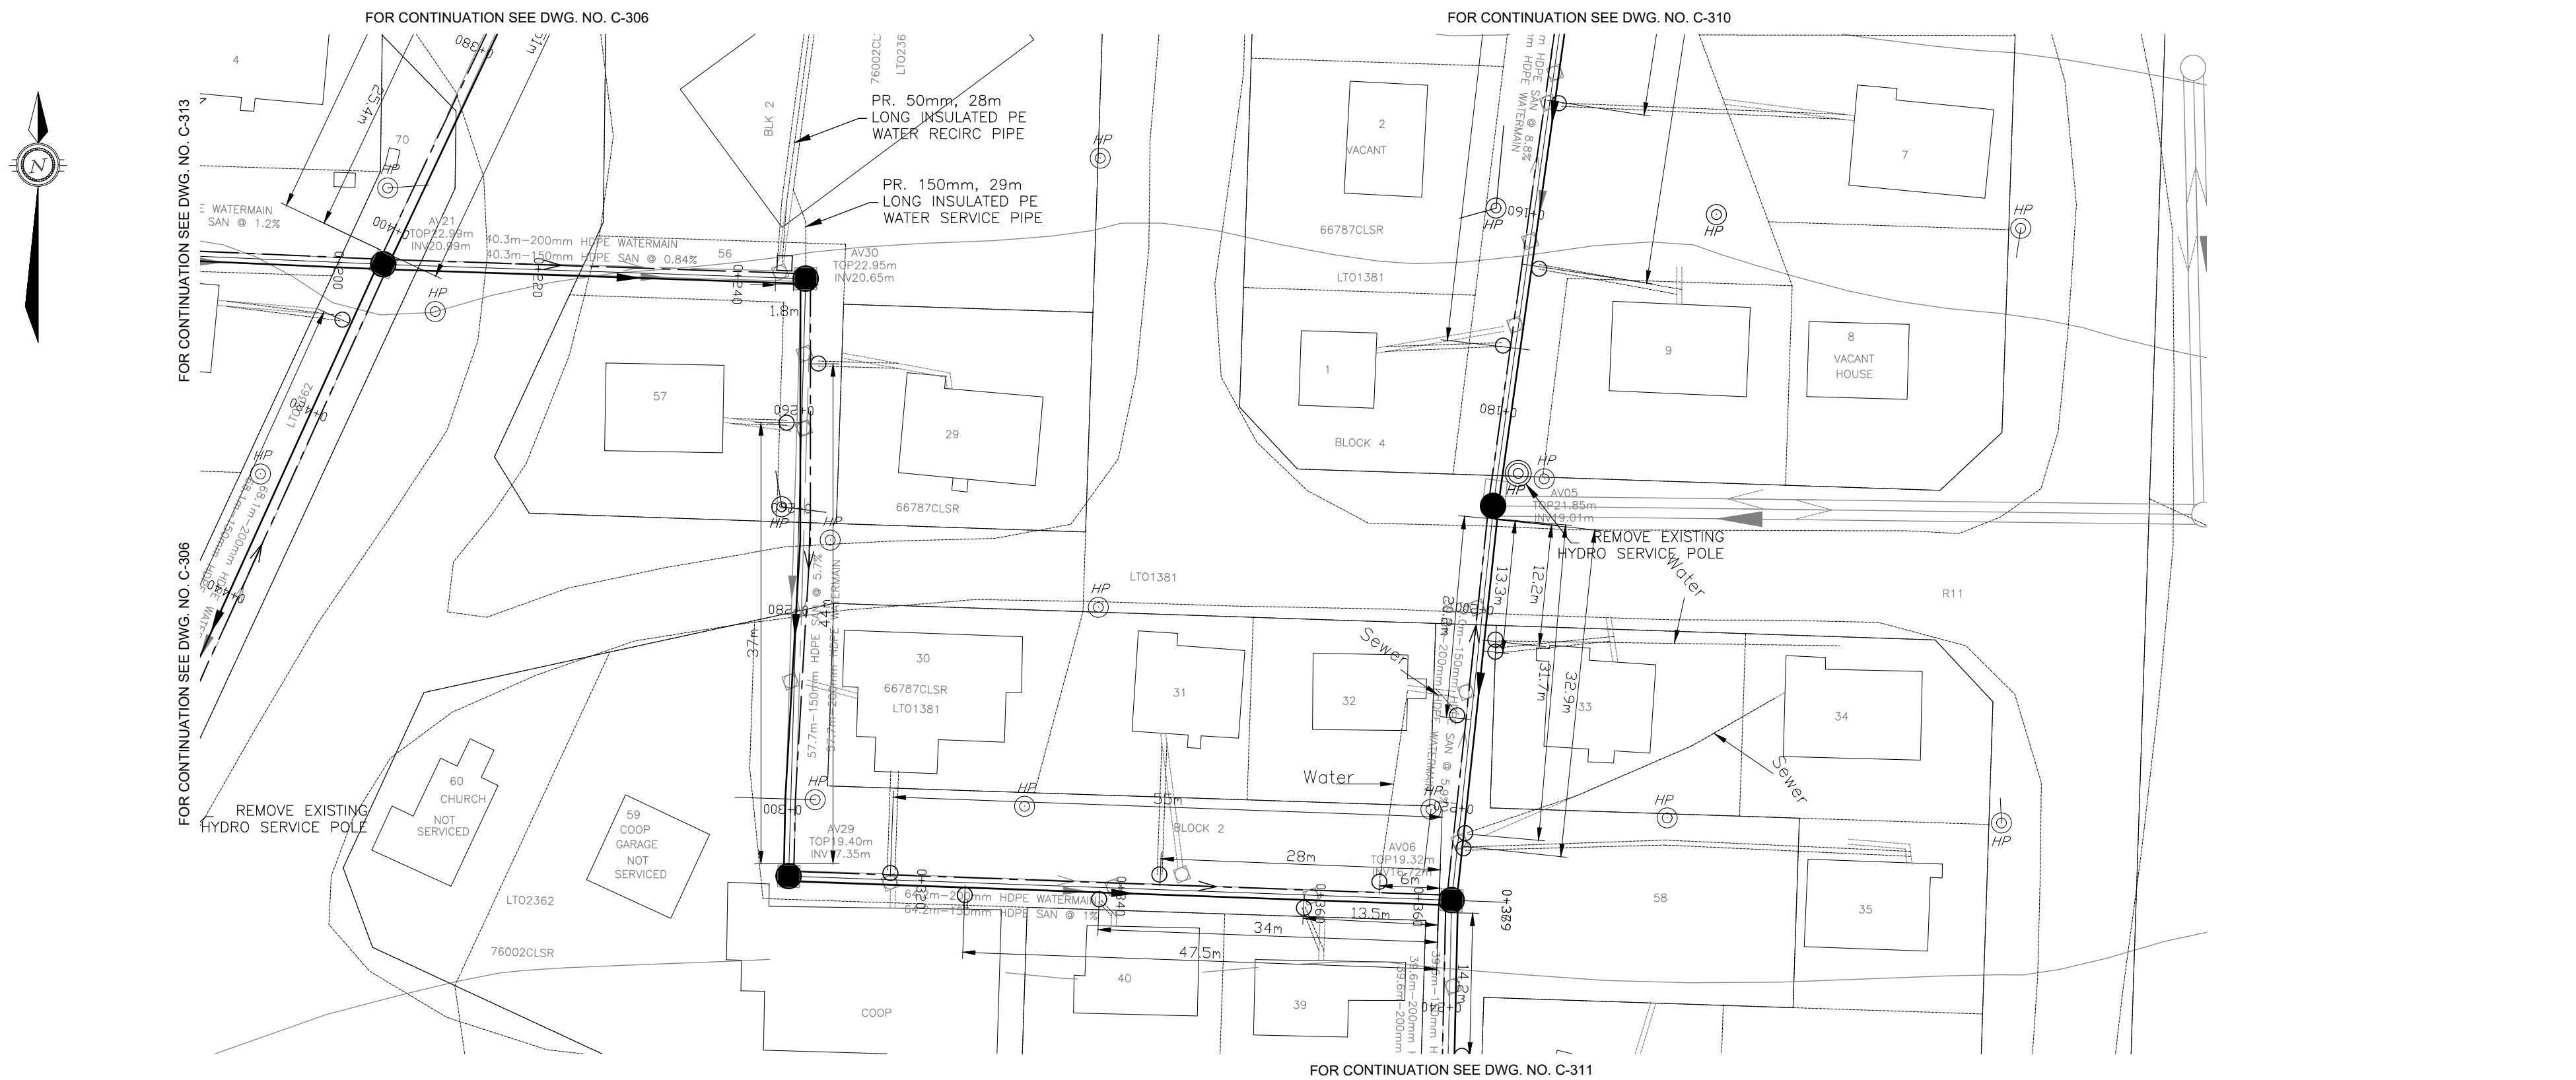

AS-BUILT

DATE: APRIL 26, 2016

No.	Revision	Ckd. By	Date
00	100% SUBMISSION	SLB	2013-MAR-04

Const. North

Drawn By:
I. CRAWFORD

Dwg. Standards
Ckd. By:

Designed By:
A. ZARAD

Date Printed

Dwg. Design
Ckd. By: S. BURDEN

exp Services Inc.

t: +1.613.688.1899 | f: +1.613.225.7330
2650 Queensview Drive, Unit 100
Ottawa, ON K2B 8H6
CANADA

www.exp.com

• BUILDINGS • EARTH & ENVIRONMENT • ENERGY •
• INDUSTRIAL • INFRASTRUCTURE • SUSTAINABILITY •

Project Title

NEW UTILIDOR DESIGN RESOLUTE BAY, NU

Dwg. Title

PLAN AND PROFILE AV21 TO AV06

Project No. OTT-00206333-A0

Dwg. No. **C-314** Rev. No. 03

Scale 1:500
This drawing is not to be scaled