

**LEGEND**

**PERMIT OF PRACTICE**  
TROW ASSOCIATES INC.


Signature \_\_\_\_\_  
Date \_\_\_\_\_

PERMIT NUMBER: P184  
The Association of Professional Engineers  
Geologists and Geophysicists of the NWT/NU

**BENCH MARK**

BM 1 ELEV. = 59.12  
CONTOUR ELEVATIONS WERE DREIVED FROM NAD 83 CONTROL MONUMENT 7038914 LOCATED NORTH OF THE ARCTIC BAY AIRPORT UNDER CONSTRUCTION.

3	AS-CONSTRUCTED	17/11/11	MEB	SLB
2	TENDER SET	27/04/09	MMR	SLB
1	ISSUED FOR APPROVAL	24/04/08	MMR	SLB
No.	DESCRIPTION	DATE	BY	APP'D
R E V I S I O N S				

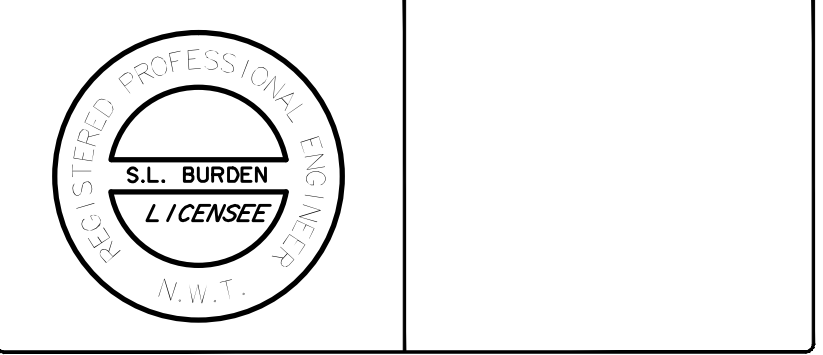

**Trow Associates Inc.**  
154 Colonnade Road South  
Ottawa, Ont. K2E 7J5  
Tel: (613) 225-9940  
Fax: (613) 225-7337

CLIENT  
**GOVERNMENT OF NUNAVUT**

PROJECT  
**ARCTIC BAY WASTEWATER LAGOON**

TITLE  
**EXISTING SITE**

design by	SAD	project no.	OTCD000190544
drawn by	MEB	drawing no.	
checked by	SLB		
date	15/01/2008		
scale	HORIZ 1:1000		

**ES-1**