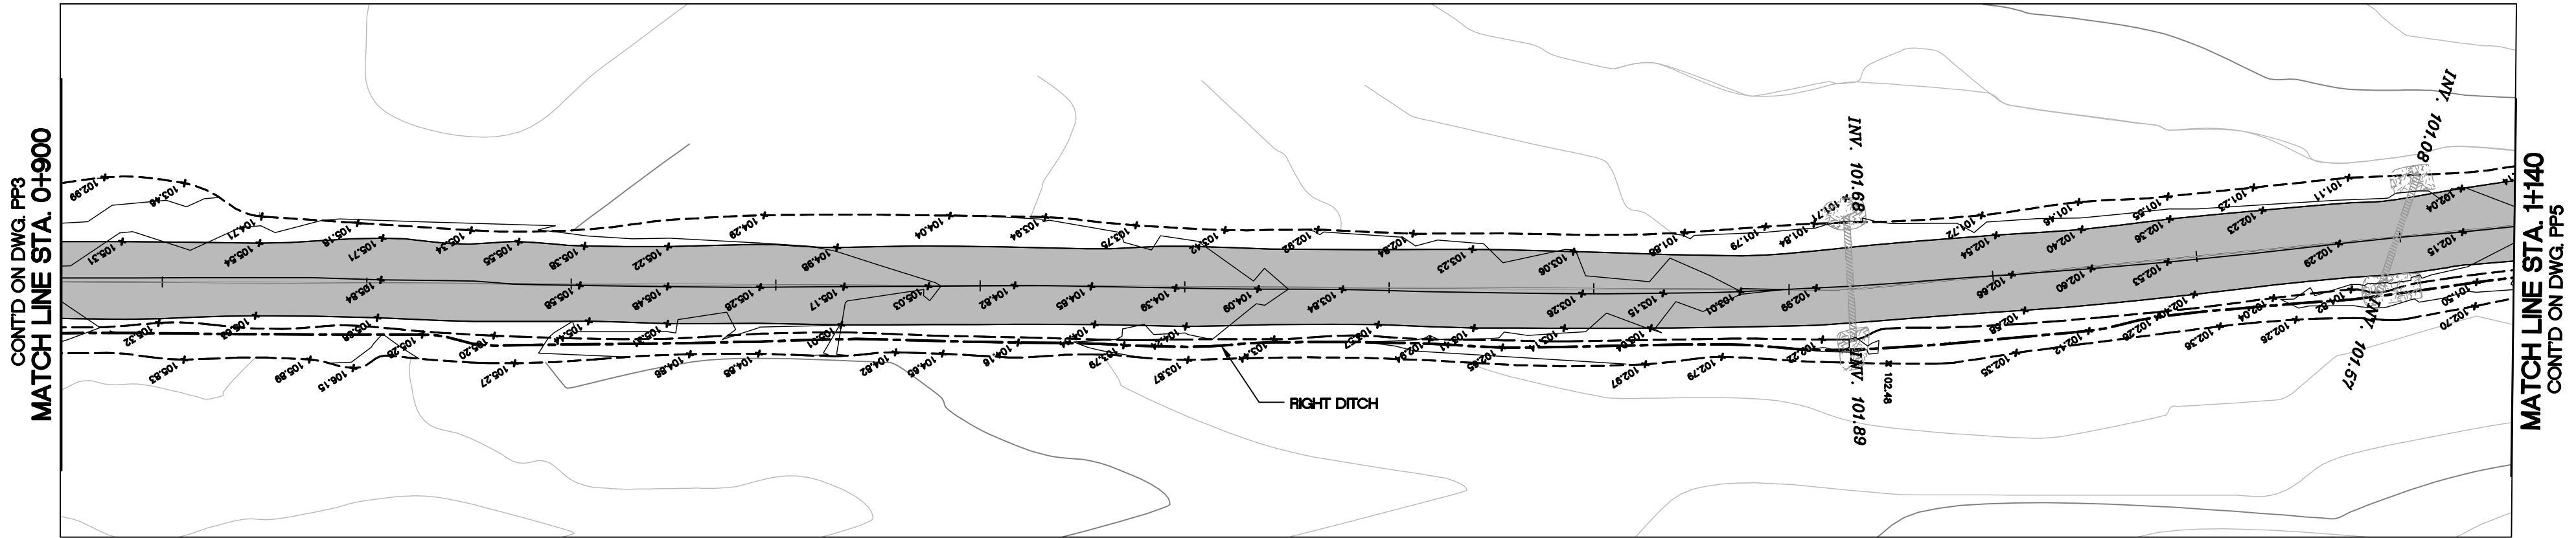


KEY PLAN


LEGEND

PERMIT OF PRACTICE
TROW ASSOCIATES INC.
Signature _____
Date _____
PERMIT NUMBER: P184
The Association of Professional Engineers
Geologists and Geophysicists of the NWT/NU

BENCH MARK
BM 1
DESCRIPTION HERE
ELEV. = 000.00

No.	DESCRIPTION	DATE	BY	APP'D
4	AS-CONSTRUCTED	17/11/11	MEB	SLB
3	ISSUED FOR CONSTRUCTION	14/09/09	MMR	SLB
2	TENDER SET	27/04/09	MMR	SLB
1	ISSUED FOR APPROVAL	24/04/08	MMR	SLB

REVISIONS

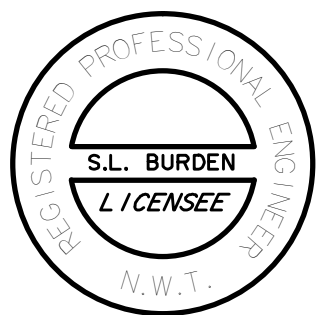

Trow Associates Inc.
154 Colonnade Road, South
Ottawa, Ont. K2E 7J5
Tel: (613) 225-9940
Fax: (613) 225-7337

CLIENT
GOVERNMENT OF NUNAVUT

PROJECT
ARCTIC BAY
WASTE WATER
LAGOON ROAD

TITLE
ACCESS ROAD
PLAN & PROFILE
STA. 0+900 TO STA. 1+200
design by S.A.D. project no. OTCD19054A
drawn by M.M.R. drawing no. PP4
checked by S.L.B.
date 21/04/08
scale HORIZ 1:500 VERT 1:50

