

KEY PLAN

LEGEND

PERMIT OF PRACTICE
TROW ASSOCIATES INC.

Signature _____

Date _____


PERMIT NUMBER: P184
The Association of Professional Engineers
Geologists and Geophysicists of the NWT/NNU

BENCH MARK

BM 1 ELEV. = 000.00

DESCRIPTION HERE

4	AS-CONSTRUCTED	17/11/11	MEB	SLB
3	ISSUED FOR CONSTRUCTION	14/09/09	MMR	SLB
2	TENDER SET	27/04/09	MMR	SLB
1	ISSUED FOR APPROVAL	24/04/08	MMR	SLB
No.	DESCRIPTION	DATE	BY	APP'D
R E V I S I O N S				

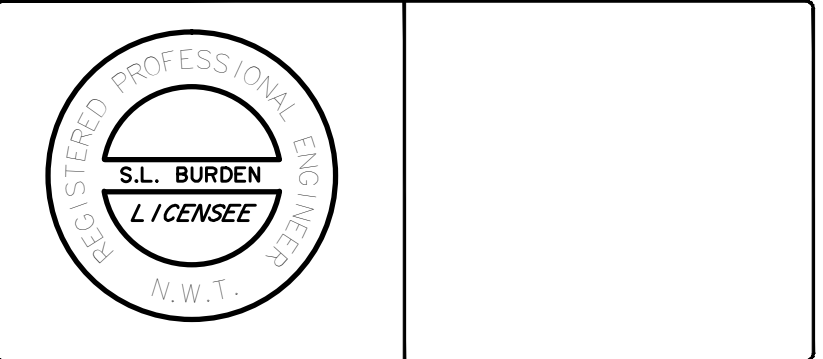

Trow Associates Inc.

154 Colonnade Road South
Ottawa, Ont. K2E 7J5

Tel: (613) 225-9940
Fax: (613) 225-7337

CLIENT

GOVERNMENT OF NUNAVUT

PROJECT

ARCTIC BAY
WASTE WATER LAGOON

TITLE

ACCESS ROAD
SECOND BERM
PLAN & PROFILE

design by	S.A.D.	project no.	OTCD19054A
drawn by	M.M.R.	drawing no.	
checked by	S.L.B.		
date	07/12/07		
scale	HORIZ 1:500 VERT 1:50		

PP7

