



GOVERNMENT OF NUNAVUT

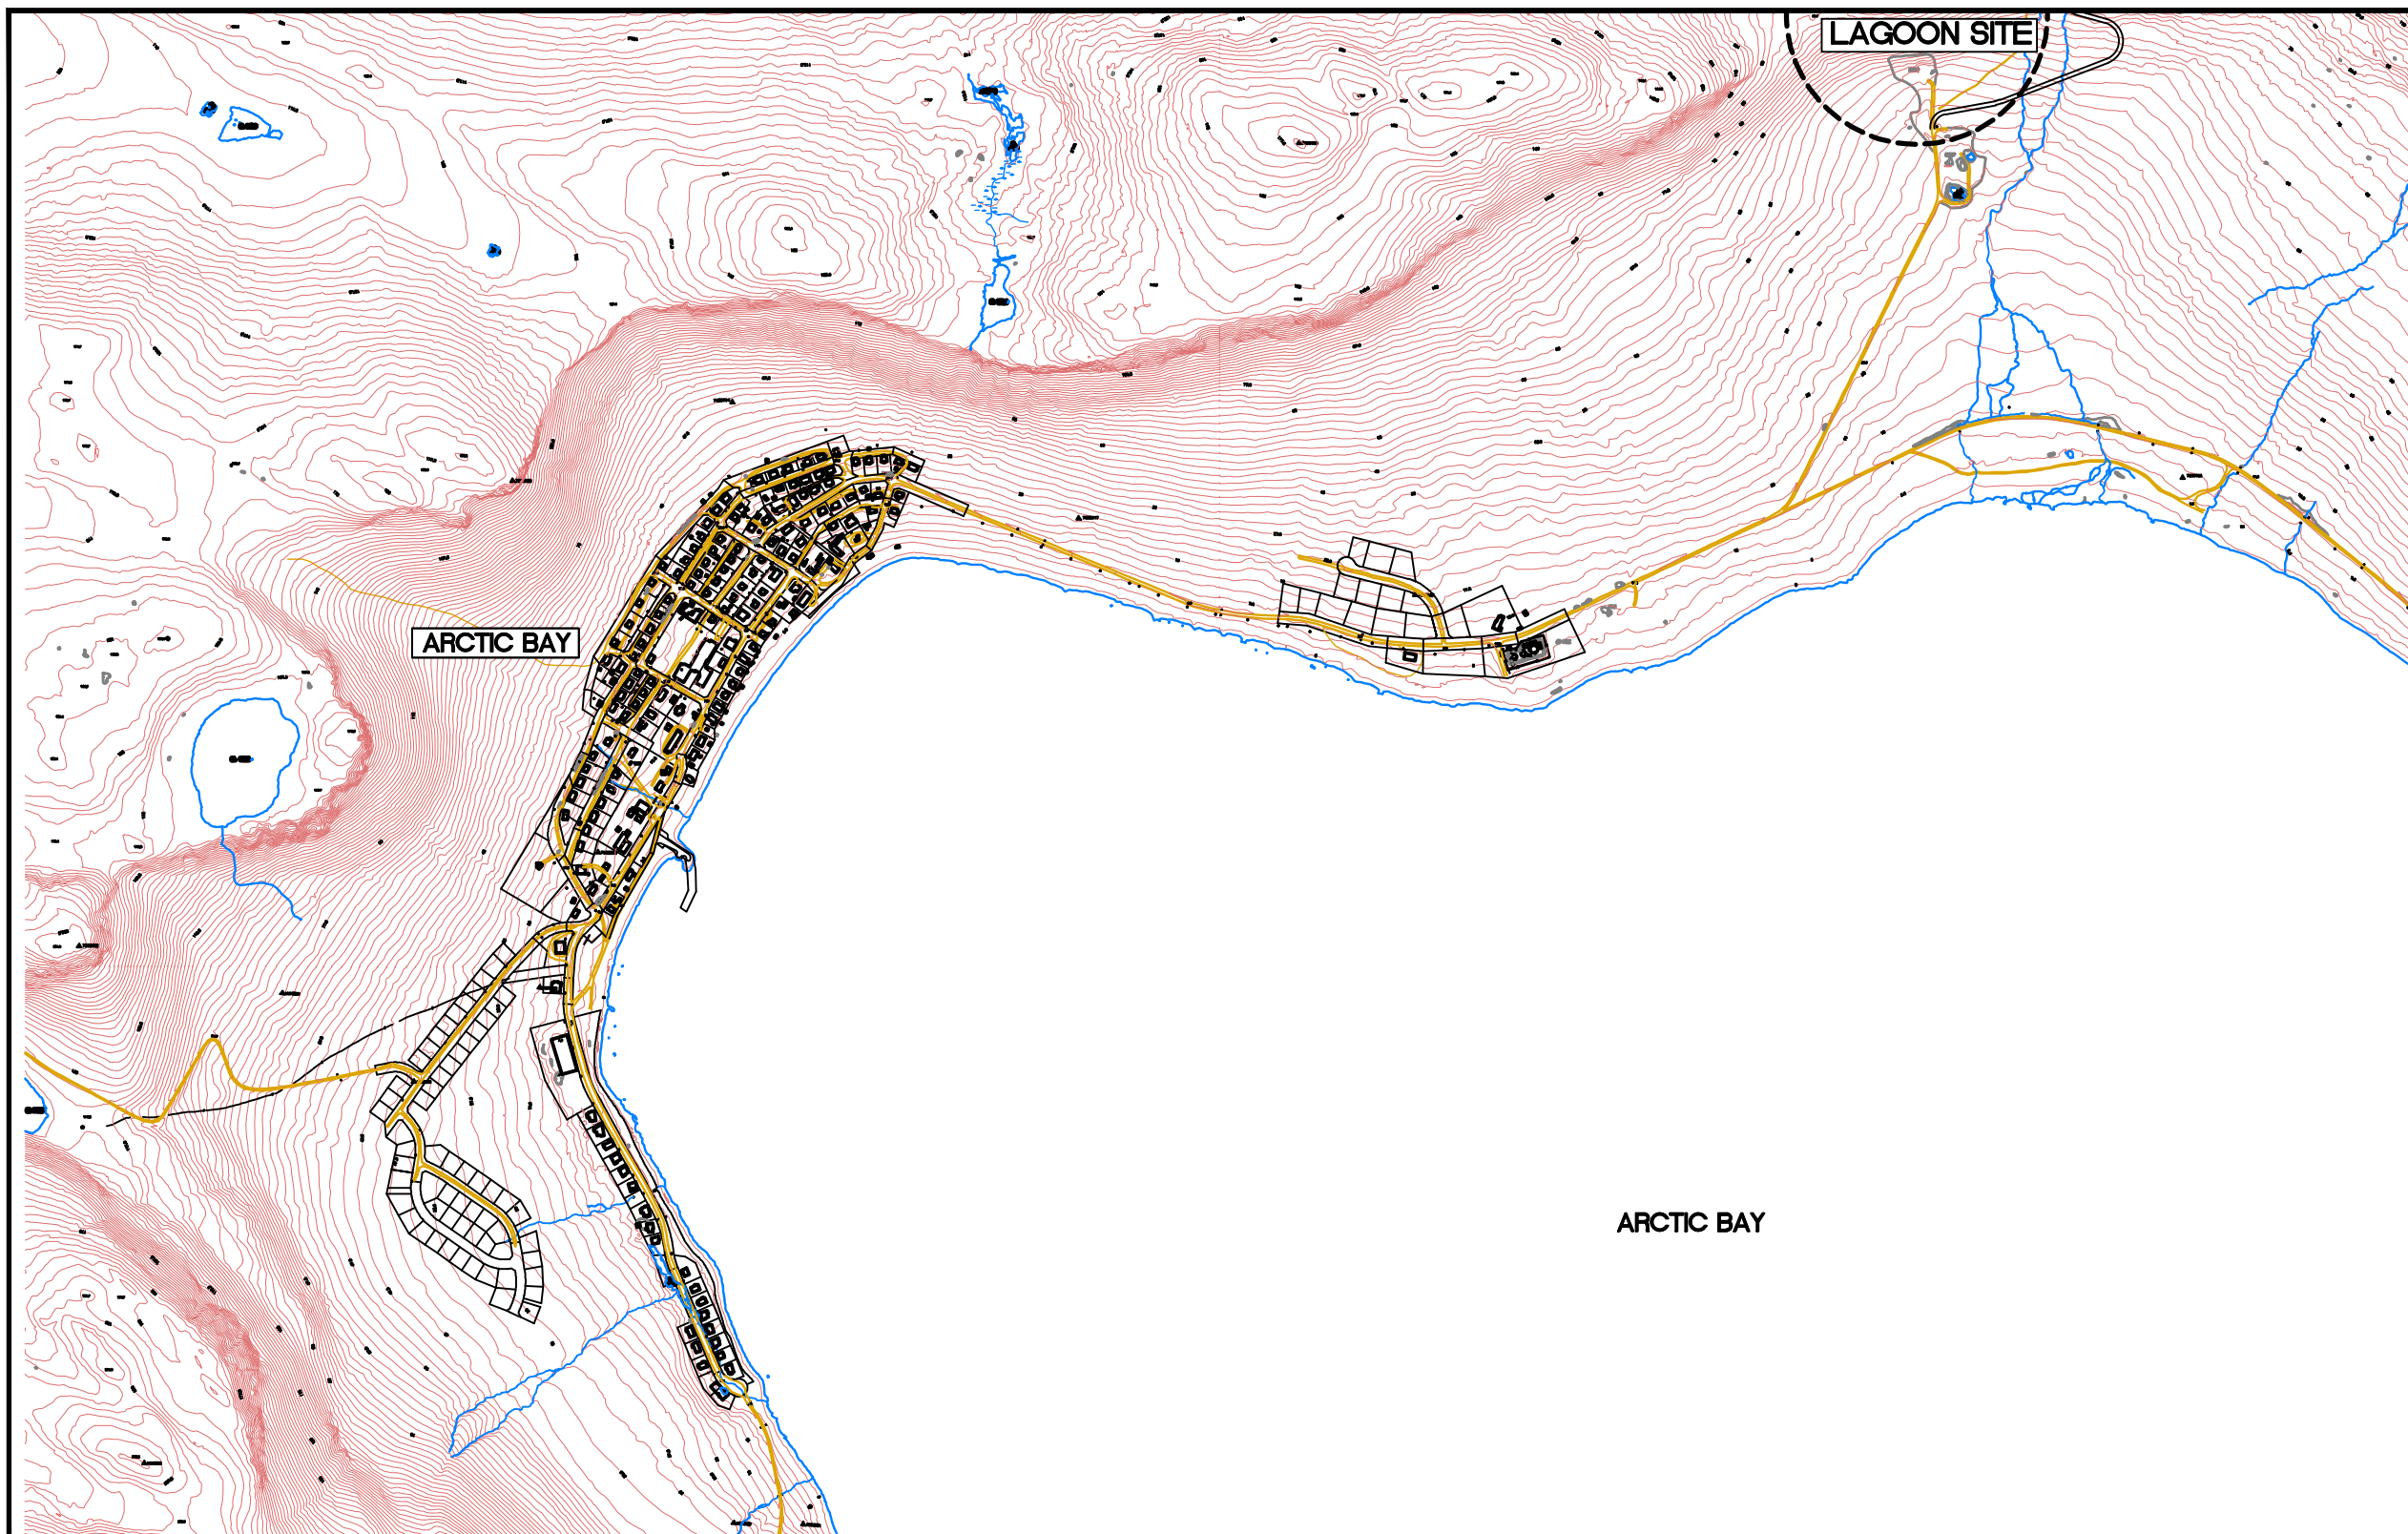

INDEX OF INCLUDED DRAWINGS

DRAWING NO.	REVISION	DESCRIPTION
OTCD00019054A-OSP1	REV 4	OVERALL SITE PLAN
OTCD00019054A-ES1	REV 4	EXISTING SITE
OTCD00019054A-L1	REV 4	PROPOSED LAGOON
OTCD00019054A-TD1	REV 4	TRUCK DISCHARGE PLAN
OTCD00019054A-DE1	REV 4	DETAILS
OTCD00019054A-DE2	REV 4	DETAILS
OTCD00019054A-SLP1	REV 4	SIGNAGE LOCATION PLAN
OTCD00019054A-CS1	REV 4	CROSS SECTIONS

ARCTIC BAY WASTEWATER LAGOON

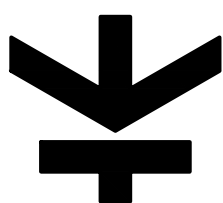 **Trow** Associates Inc.
154 COLONNADE ROAD SOUTH PHONE (613) 225-9940
OTTAWA, ONTARIO K2E 7J5 FAX (613) 225-7337

AS-BUILT INFORMATION PROVIDED BY KUDLIK CONSTRUCTION LTD. NOVEMBER 2011

AS-BUILT
DATE: NOVEMBER 30, 2011