


CUT: 777 m³
FILL: 10765 m³
NET: 9988 m³



as built

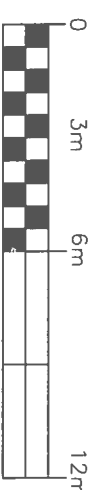

HORIZONTAL 1:300

General Notes	
No.	Revision/Issue
Date	
Form Name and Address	
Project Name and Address	
Decommissioning of existing lagoon NU	
Project	Sheet
lagoon	1
Date	
31.01.2013	
Scale	
1:300	