


SEE DRAWING SHEET CS-1 FOR ALL
CROSS-SECTIONAL INFORMATION AND DETAILS.

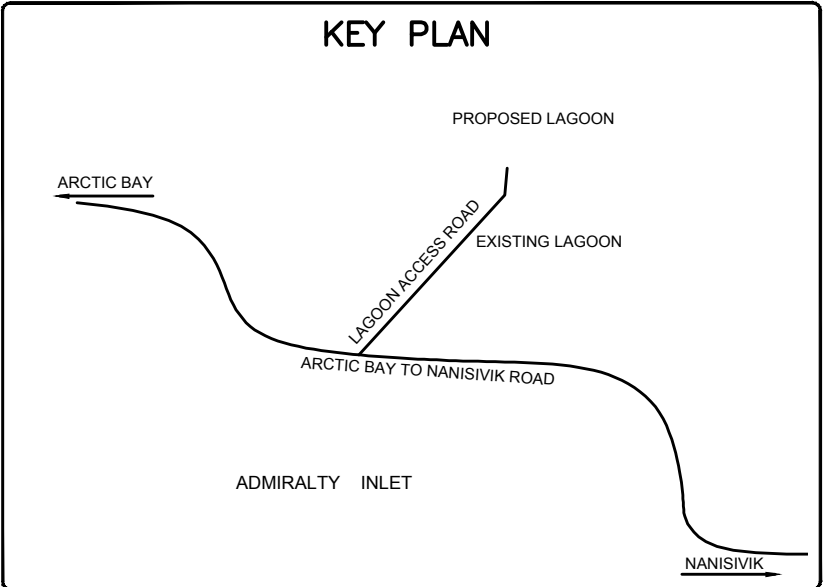

LEGEND

- BERM CORE DETECTION - THERMISTOR CASING w/ THERMISTOR STRING AND DATA LOGGER CONNECTION
- SAMPLING POINT

AS-BUILT


DATE: NOVEMBER 30, 2011

BENCH MARK

BM 1 ELEV. = 59.12
CONTOUR ELEVATIONS WERE DREINED FROM NAD 83 CONTROL MONUMENT 7038914 LOCATED NORTH OF THE ARCTIC BAY AIRPORT UNDER CONSTRUCTION.

R E V I S I O N S				
4	AS-BUILT	30/11/11	SAB	SLB
3	AS-CONSTRUCTED	17/11/11	MEB	SLB
2	TENDER SET	27/04/09	MMR	SLB
1	ISSUED FOR APPROVAL	24/04/08	MMR	SLB
No.	DESCRIPTION	DATE	BY	APP'D

DRAWINGS ORIGINALLY
SEALED BY
S.L.BURDEN, P.eng. OF
exp. SERVICES Inc.
APRIL 27TH, 2009

 **Trow Associates Inc.**
154 Colonnade Road South
Ottawa, Ont. K2E 7J5
Tel: (613) 225-9940
Fax: (613) 225-7337

CLIENT
GOVERNMENT OF NUNAVUT

PROJECT
ARCTIC BAY WASTEWATER LAGOON

TITLE
PROPOSED LAGOON

design by SAD	project no. OTCD000190544
drawn by MEB	drawing no.
checked by SLB	
date 15/01/2008	
scale HORIZ 1:750	

L-1