

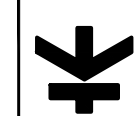
LEGEND

**AS-BUILT**  
DATE: NOVEMBER 30, 2011

**BENCH MARK**  
BM 1 ELEV. = 59.12  
CONTOUR ELEVATIONS WERE DREIVED FROM NAD 83 CONTROL MONUMENT 7038914 LOCATED NORTH OF THE ARCTIC BAY AIRPORT UNDER CONSTRUCTION.

R E V I S I O N S				
4	AS-BUILT	30/11/11	SAB	SLB
3	AS-CONSTRUCTED	17/11/11	MEB	SLB
2	TENDER SET	27/04/09	MMR	SLB
1	ISSUED FOR APPROVAL	24/04/08	MMR	SLB
No.	DESCRIPTION	DATE	BY	APP'D

DRAWINGS ORIGINALLY SEALED BY  
S.L.BURDEN, P.eng. OF  
exp. SERVICES Inc.  
APRIL 27TH, 2009

 **Trow Associates Inc.**  
154 Colonnade Road South  
Ottawa, Ont. K2E 7J5  
Tel:(613)225-9940  
Fax:(613)225-7337

CLIENT  
GOVERNMENT OF NUNAVUT

PROJECT  
ARCTIC BAY WASTEWATER LAGOON

TITLE  
OVERALL  
SITE PLAN

design by	SAD	project no.	OTCD000190544
drawn by	MEB	drawing no.	OSP-1
checked by	SLB	date	
date	15/01/2008	scale	
scale	HORIZ 1:2500		