




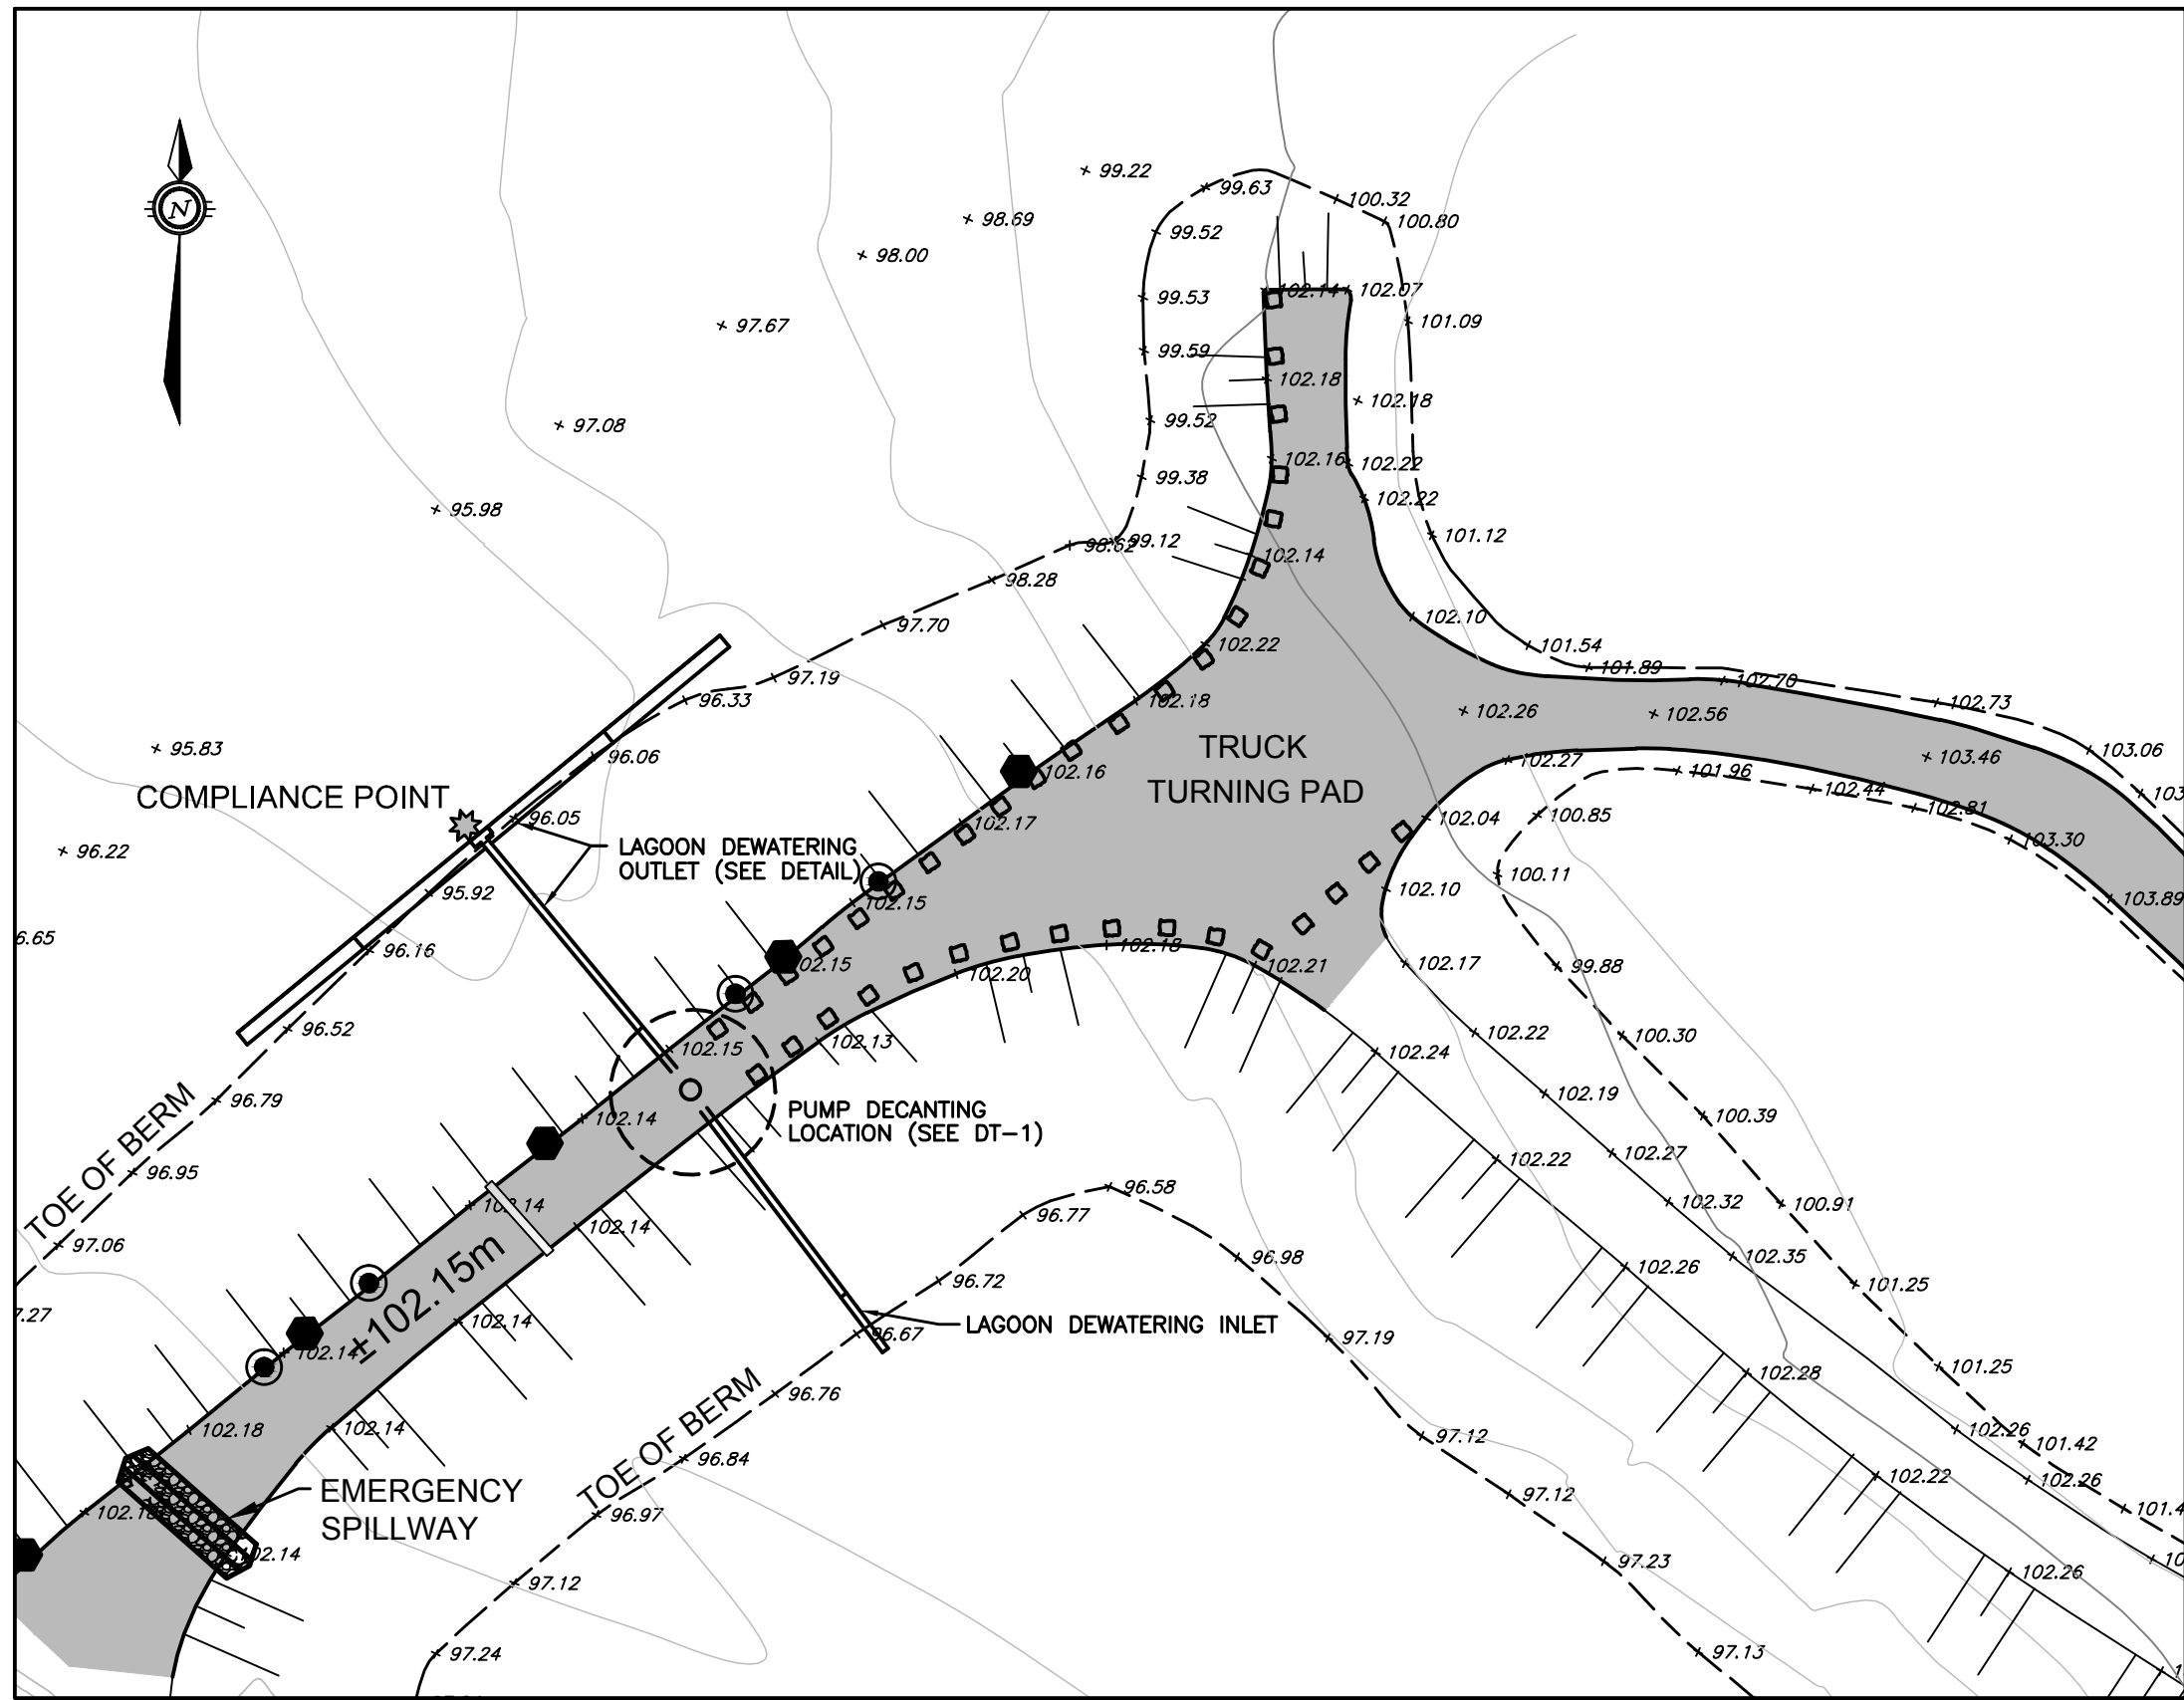


NORTH BERM DECANTING
SCALE 1:500

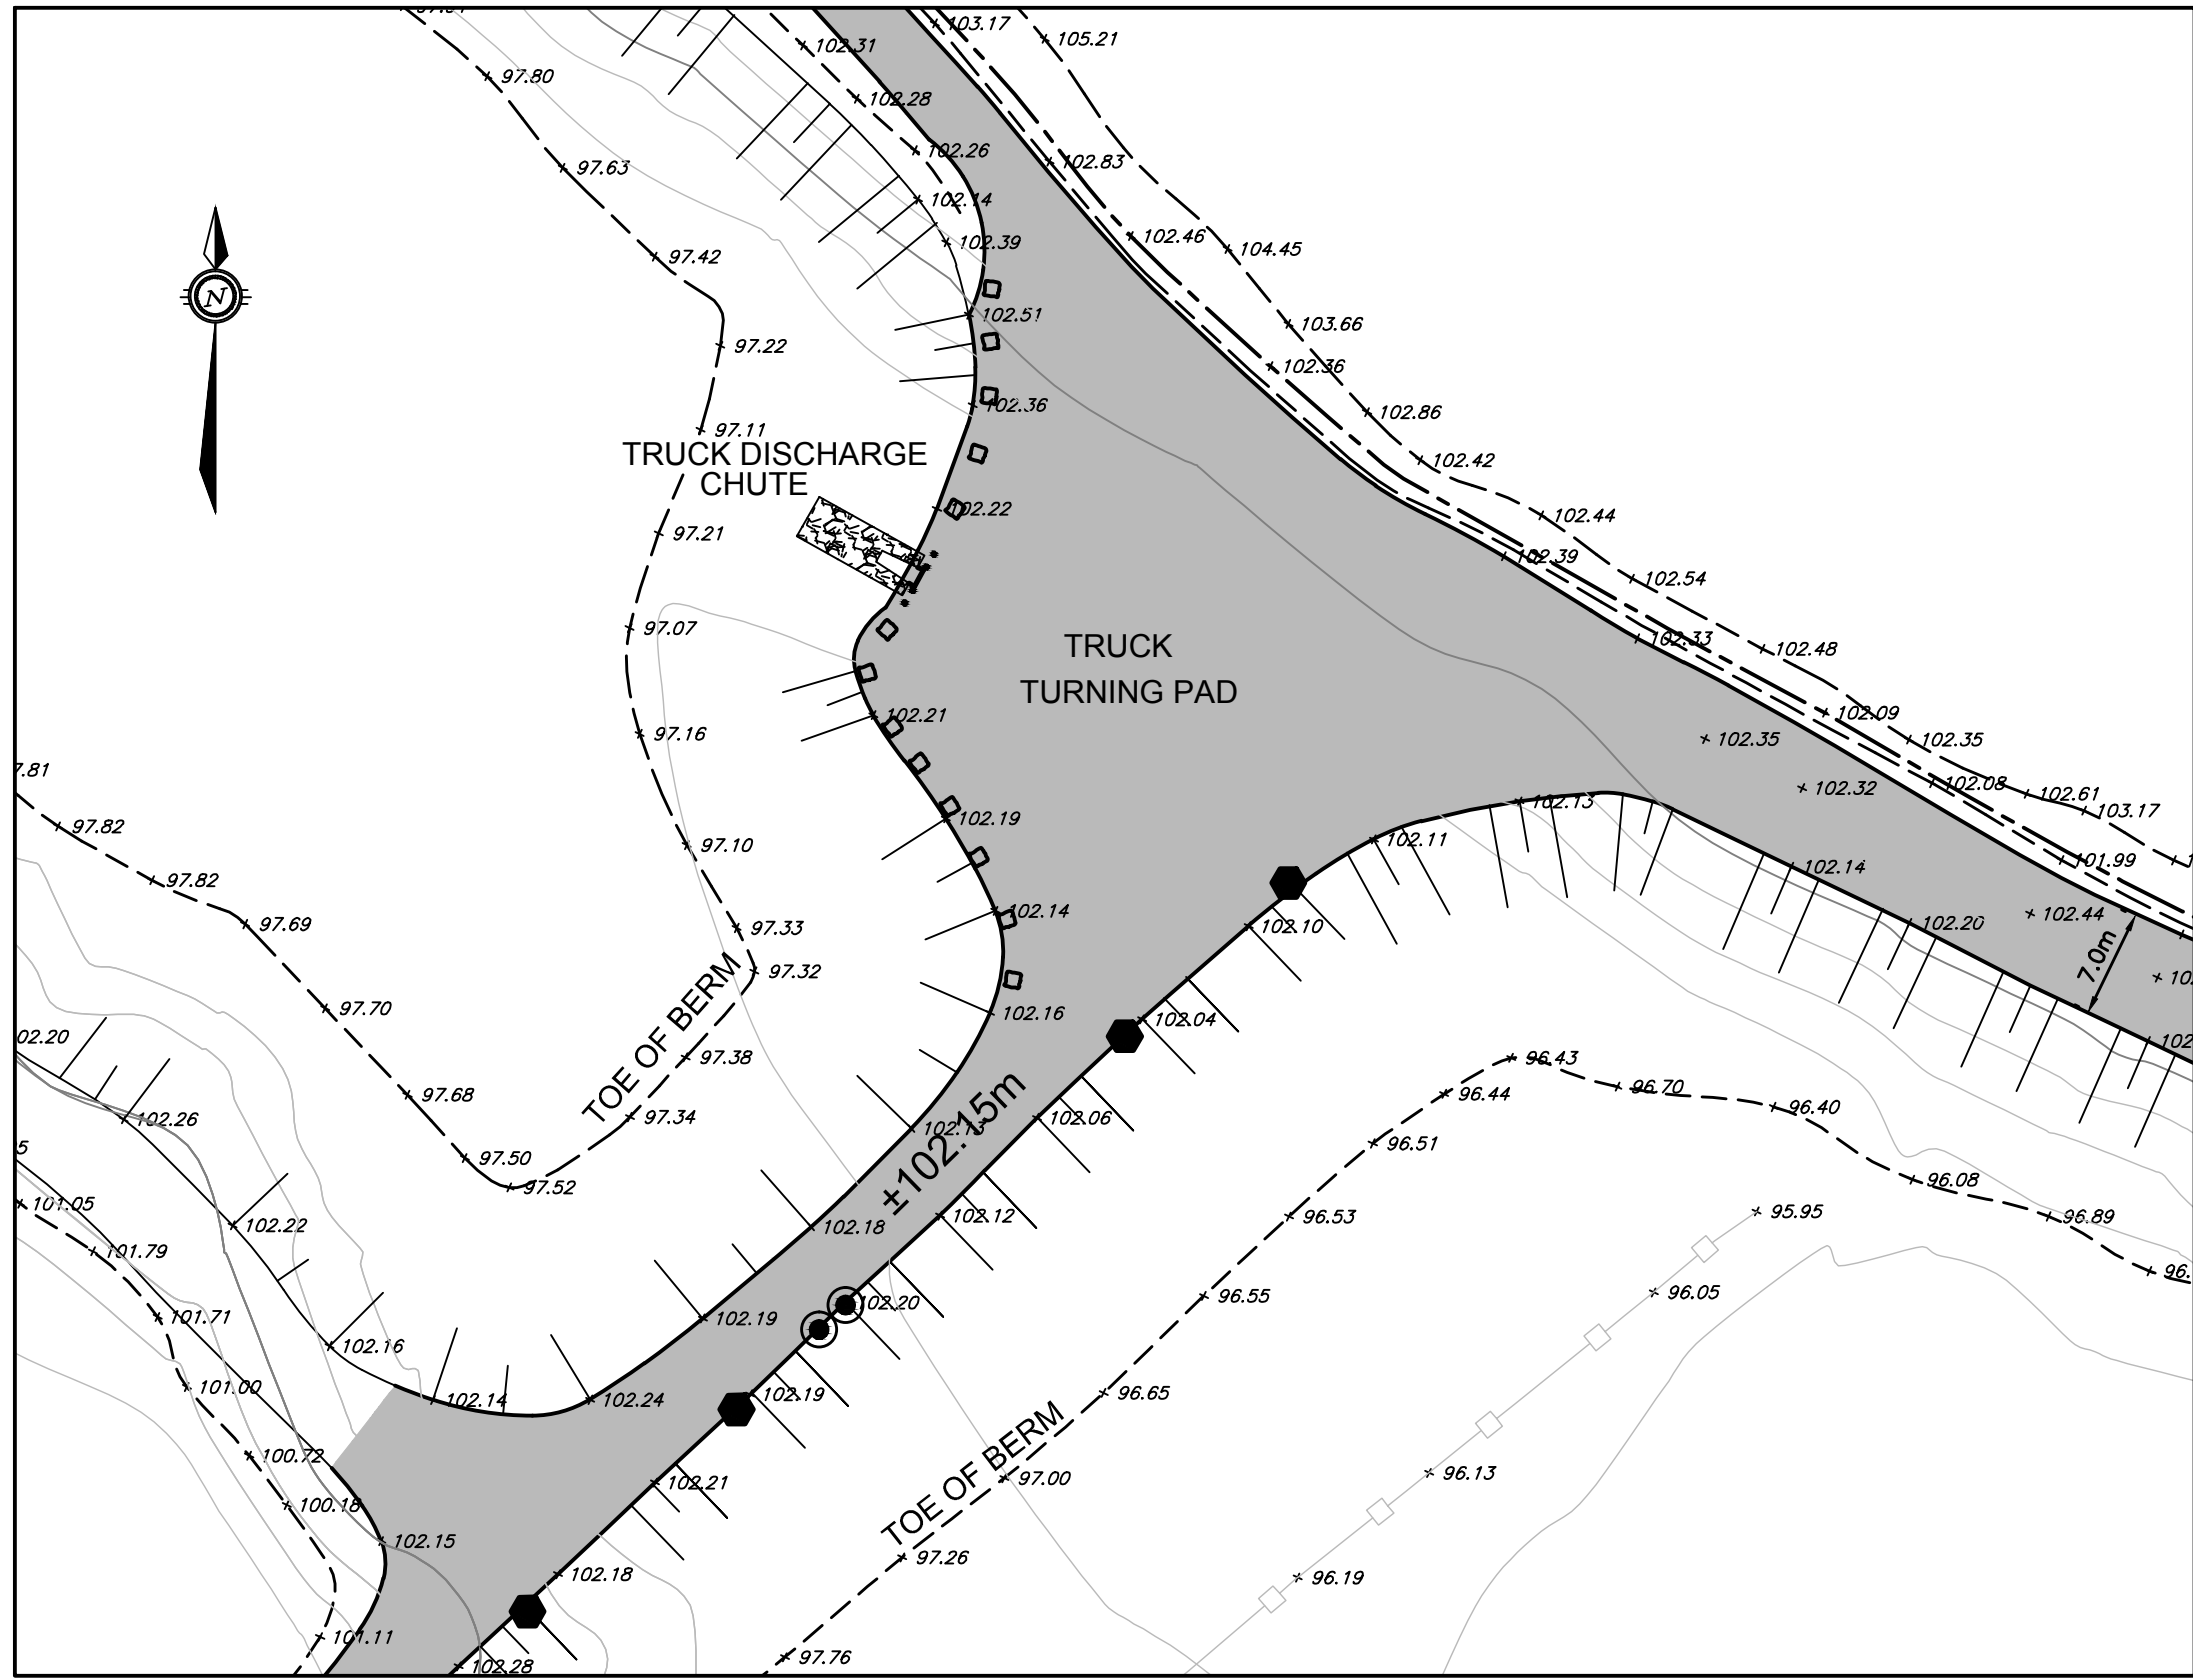


SOUTH BERM TRUCK DISCHARGE
SCALE 1:500

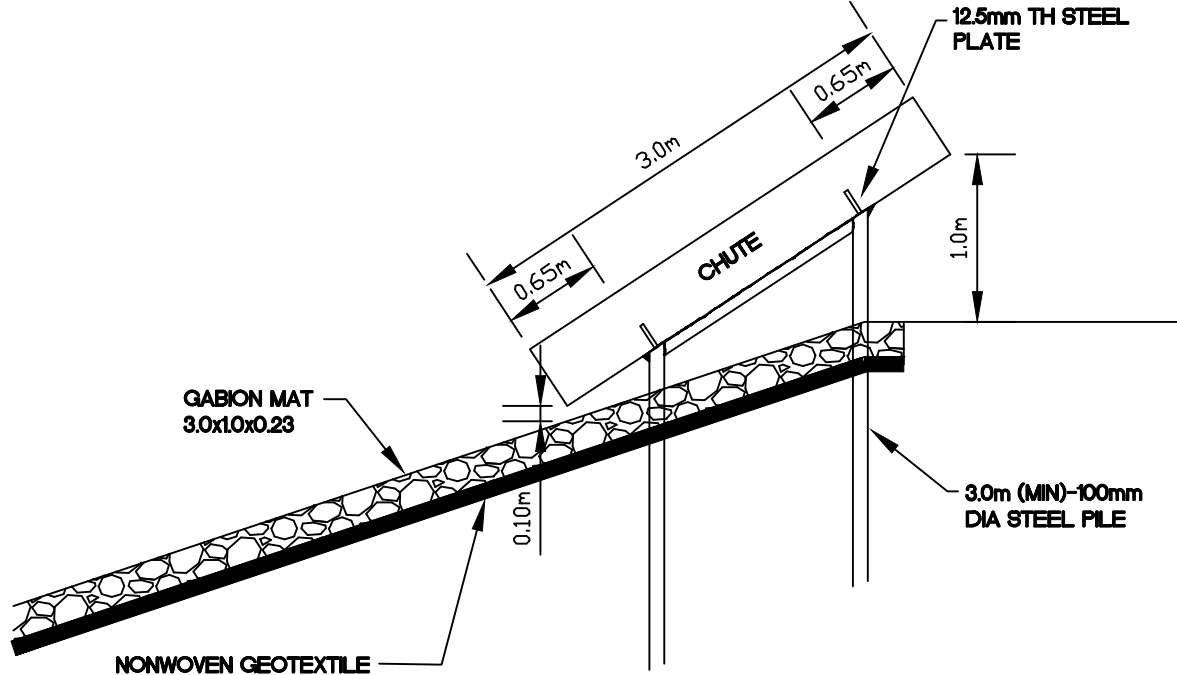


TRUCK DISCHARGE CHUTE
SECTION VIEW
SCALE 1:50

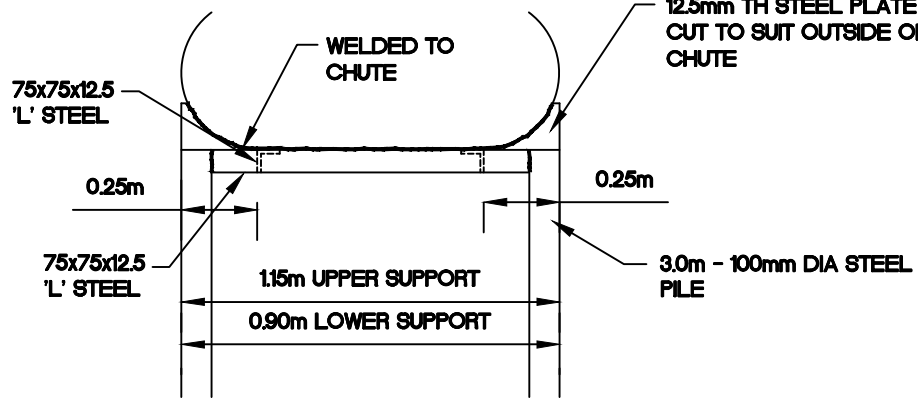


TRUCK DISCHARGE CHUTE
END VIEW
SCALE 1:25

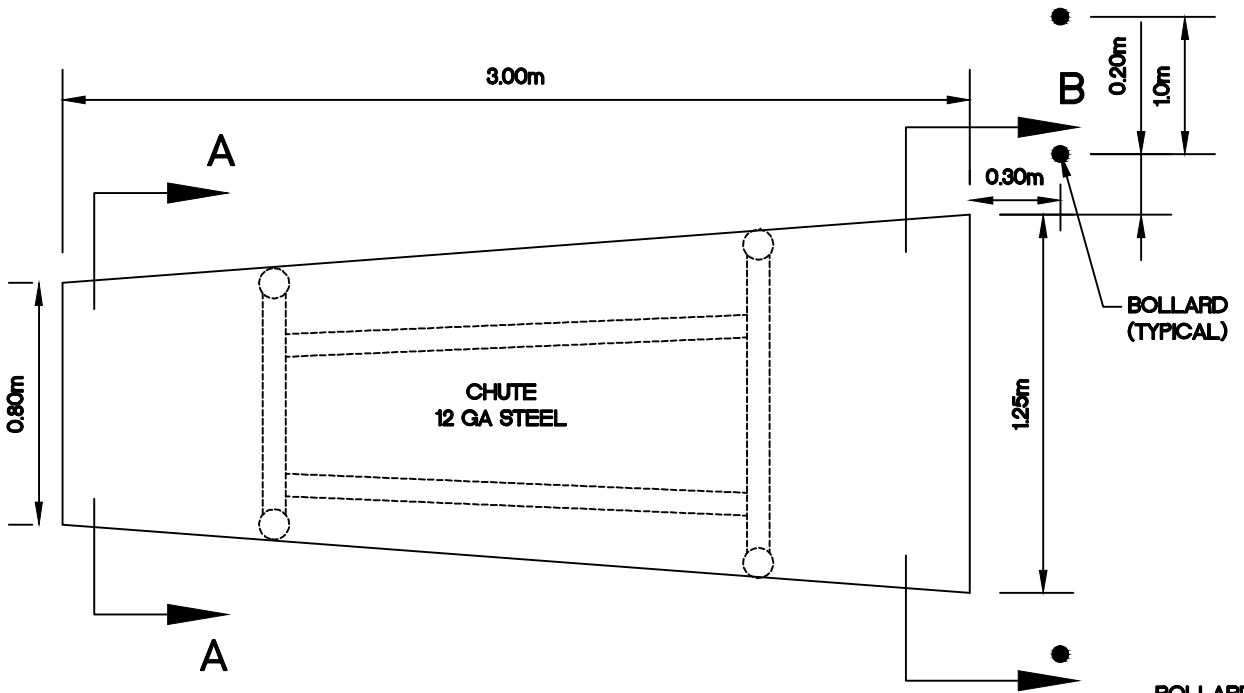


DISCHARGE CHUTE
PLAN VIEW
SCALE 1:25

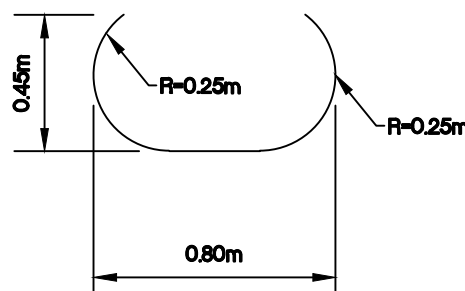

SECTION A-A
SCALE 1:25

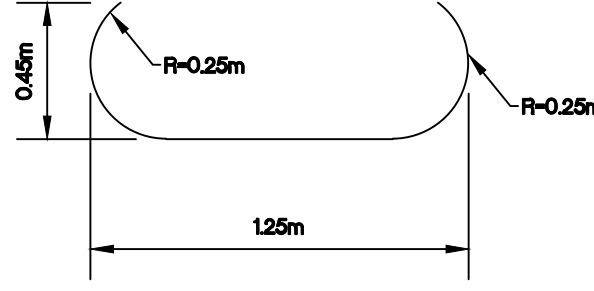


SECTION B-B
SCALE 1:25

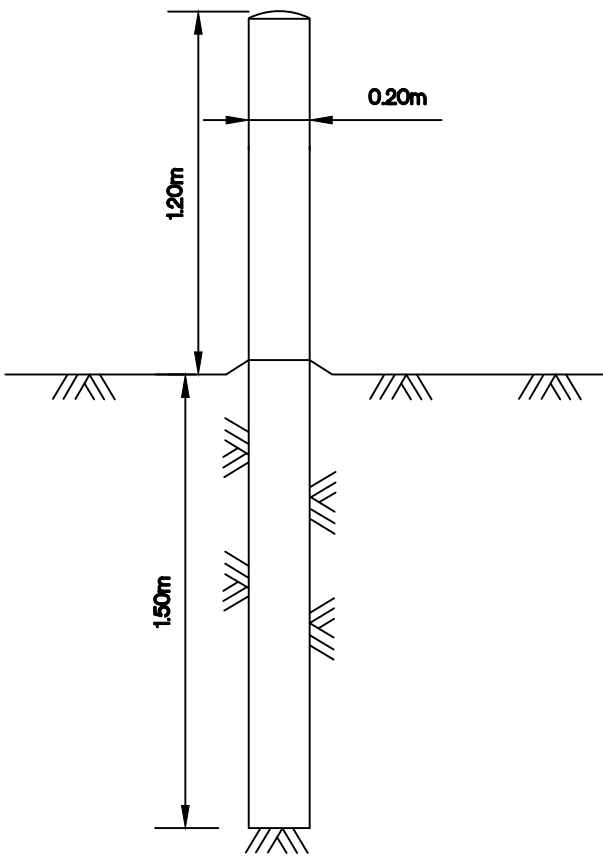

BOLLARD DETAIL
SCALE 1:25

TRUCK DISCHARGE CHUTE DETAIL

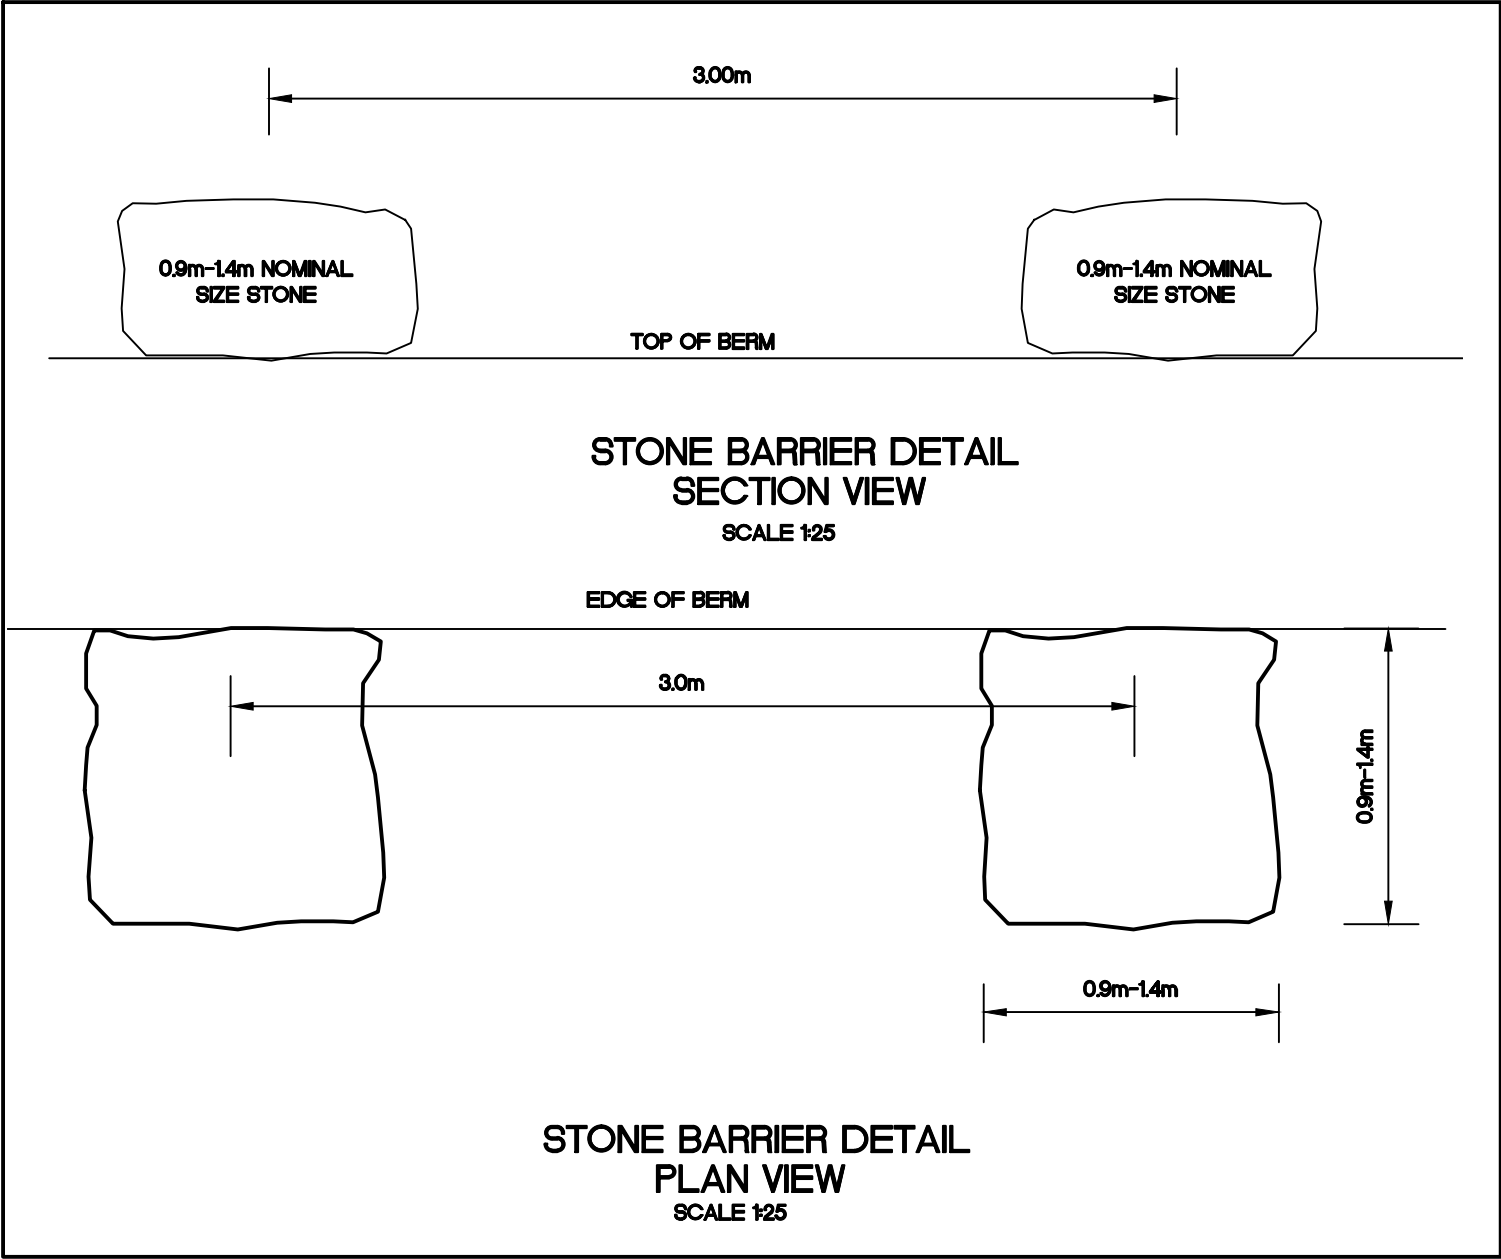

STONE BARRIER DETAIL
PLAN VIEW
SCALE 1:25

KEY PLAN

LEGEND

AS-BUILT

DATE: NOVEMBER 30, 2011

BENCH MARK

BM 1 ELEV. = 59.12
CONTOUR ELEVATIONS WERE DRENED FROM NAD 83 CONTROL
MONUMENT 7038914 LOCATED NORTH OF THE ARCTIC BAY
AIRPORT UNDER CONSTRUCTION.

No.	DESCRIPTION	DATE	BY	APP'D
4	AS-BUILT	30/11/11	SAB	SLB
3	AS-CONSTRUCTED	17/11/11	MEB	SLB
2	TENDER SET	27/04/09	MMR	SLB
1	ISSUED FOR APPROVAL	24/04/08	MMR	SLB
REVISIONS				

DRAWINGS ORIGINALLY
SEALED BY
S.L.BURDEN, P.eng. OF
exp. SERVICES Inc.
APRIL 27TH, 2009

Trow Associates Inc.
154 Colonnade Road South
Ottawa, Ont. K2E 7J5
Tel:(613)225-9940
Fax:(613)225-7337

GOVERNMENT OF NUNAVUT

ARCTIC BAY WASTEWATER LAGOON

LOCATION PLAN FOR
TRUCK DISCHARGE AND
DECANTING

design by	SAD	project no.	OTCD000190544
drawn by	MEB	drawing no.	
checked by	SLB		
date	15/01/2008		
scale	HORIZ 1:500		

TD-1