



GOVERNMENT OF NUNAVUT

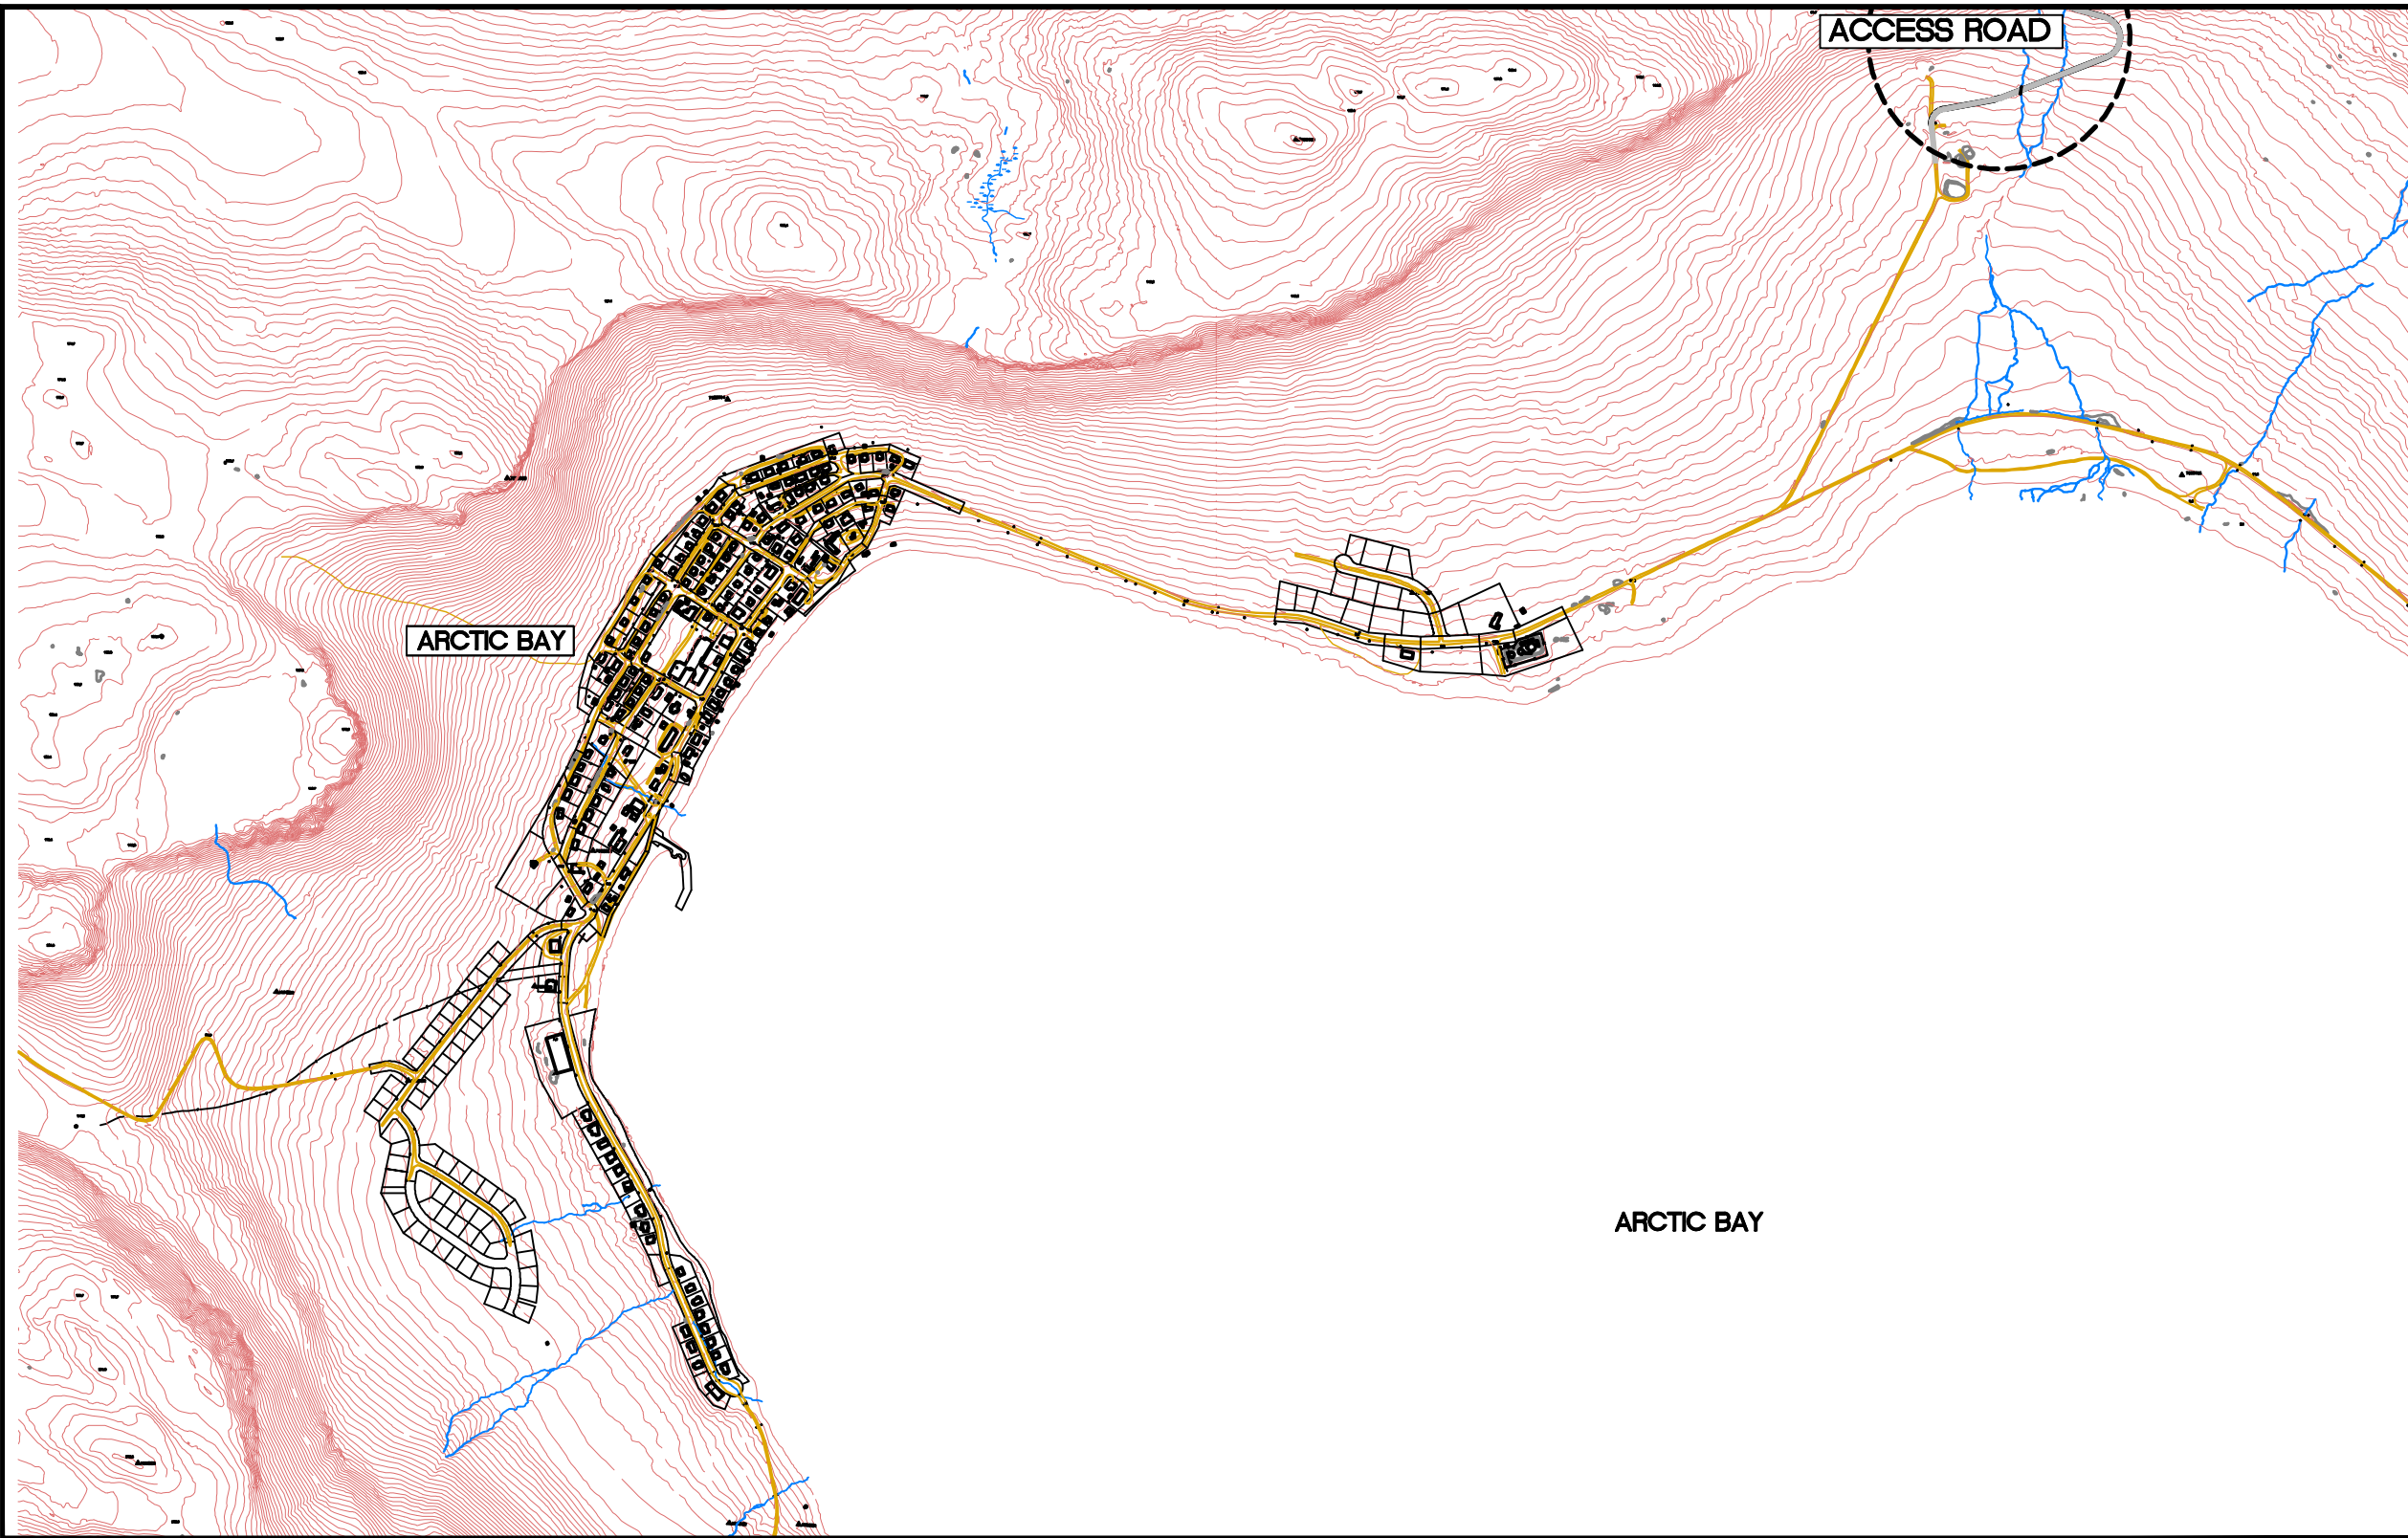

INDEX OF INCLUDED DRAWINGS

DRAWING NO.	REVISION	DESCRIPTION
OTCD00019054A-SP1	REV 5	SITE PLAN
OTCD00019054A-PP1	REV 5	ACCESS ROAD PLAN & PROFILE
OTCD00019054A-PP2	REV 5	ACCESS ROAD PLAN & PROFILE
OTCD00019054A-PP3	REV 5	ACCESS ROAD PLAN & PROFILE
OTCD00019054A-PP4	REV 5	ACCESS ROAD PLAN & PROFILE
OTCD00019054A-PP5	REV 5	ACCESS ROAD PLAN & PROFILE
OTCD00019054A-PP6	REV 5	ACCESS ROAD SECOND BERM PLAN & PROFILE
OTCD00019054A-PP7	REV 5	ACCESS ROAD SECOND BERM PLAN & PROFILE
OTCD00019054A-DE1	REV 6	ROAD DETAILS

ARCTIC BAY WASTEWATER LAGOON ROAD

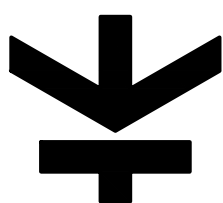

Trow

Associates Inc.

154 COLONNADE ROAD SOUTH
OTTAWA, ONTARIO K2E 7J5

PHONE (613) 225-9940
FAX (613) 225-7337

AS-BUILT INFORMATION PROVIDED BY KUDLIK CONSTRUCTION LTD. NOVEMBER 2011

AS-BUILT

DATE: NOVEMBER 30, 2011