

KEY PLAN

LEGEND

AS-BUILT

DATE: NOVEMBER 30, 2011

BENCH MARK

BM 1
DESCRIPTION HERE
ELEV. = 000.00

5	AS-BUILT	30/11/11	SAB	SLB
4	AS-CONSTRUCTED	17/11/11	MEB	SLB
3	ISSUED FOR CONSTRUCTION	14/09/09	MMR	SLB
2	TENDER SET	27/04/09	MMR	SLB
1	ISSUED FOR APPROVAL	24/04/08	MMR	SLB
No.	DESCRIPTION	DATE	BY	APP'D
R E V I S I O N S				

DRAWINGS ORIGINALLY
SEALED BY
S.L.BURDEN, P.eng. OF
exp. SERVICES Inc.
APRIL 27TH, 2009




Trow Associates Inc.
154 Colonnade Road South
Ottawa, Ont. K2E 7J5
Tel: (613) 225-9940
Fax: (613) 225-7337

CLIENT
GOVERNMENT OF NUNAVUT

PROJECT
ARCTIC BAY
WASTE WATER
LAGOON ROAD

TITLE
ACCESS ROAD
PLAN & PROFILE
STA. 0+600 TO STA. 0+900

design by	S.A.D.	project no.	OTCD19054A
drawn by	M.M.R.	drawing no.	PP3
checked by	S.L.B.		
date	21/04/08		
scale	HORIZ 1:500 VERT 1:50		

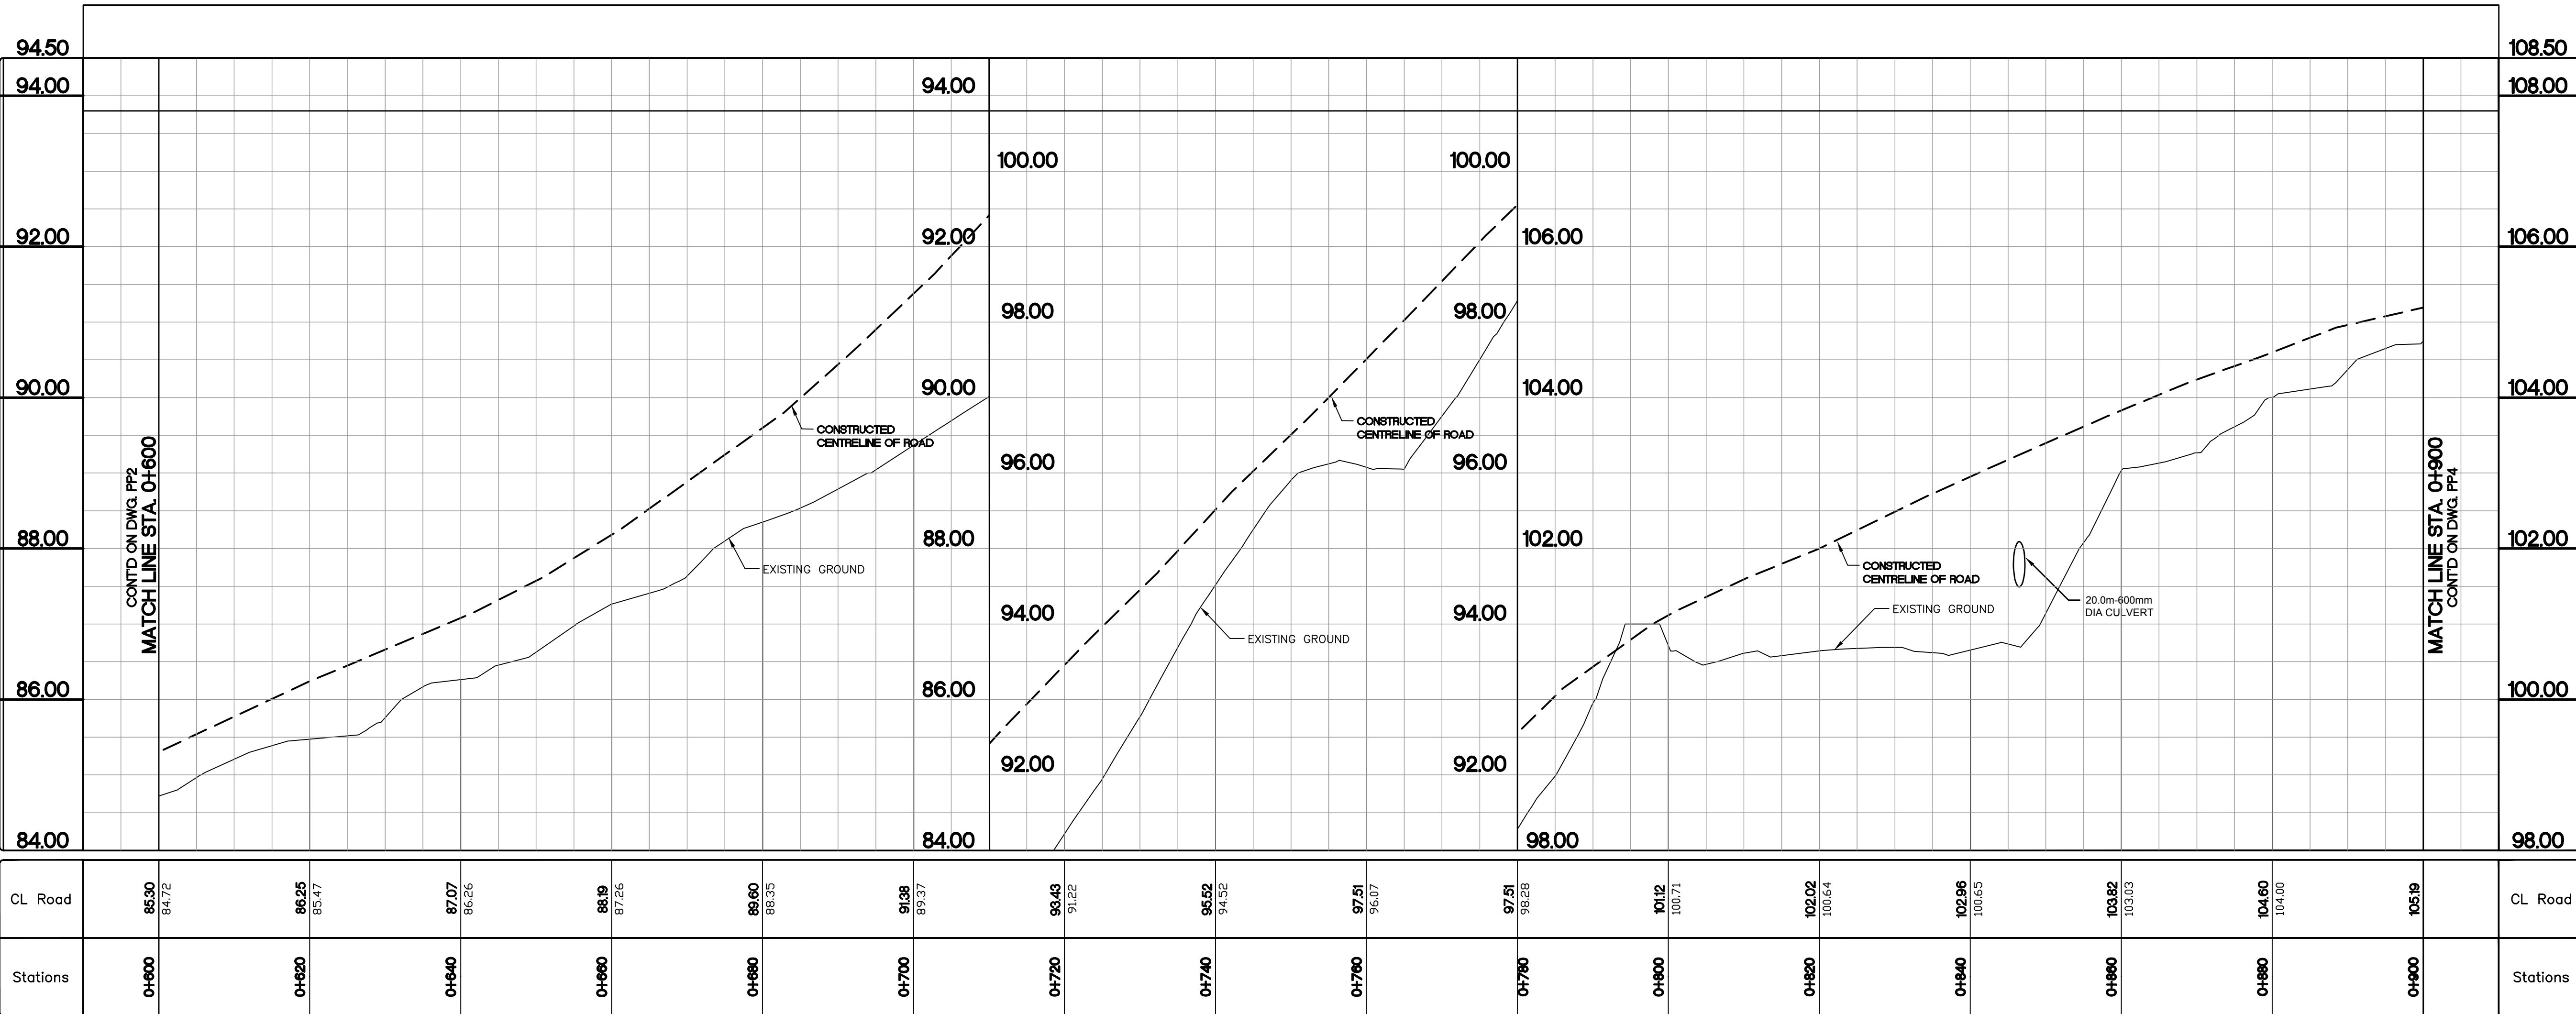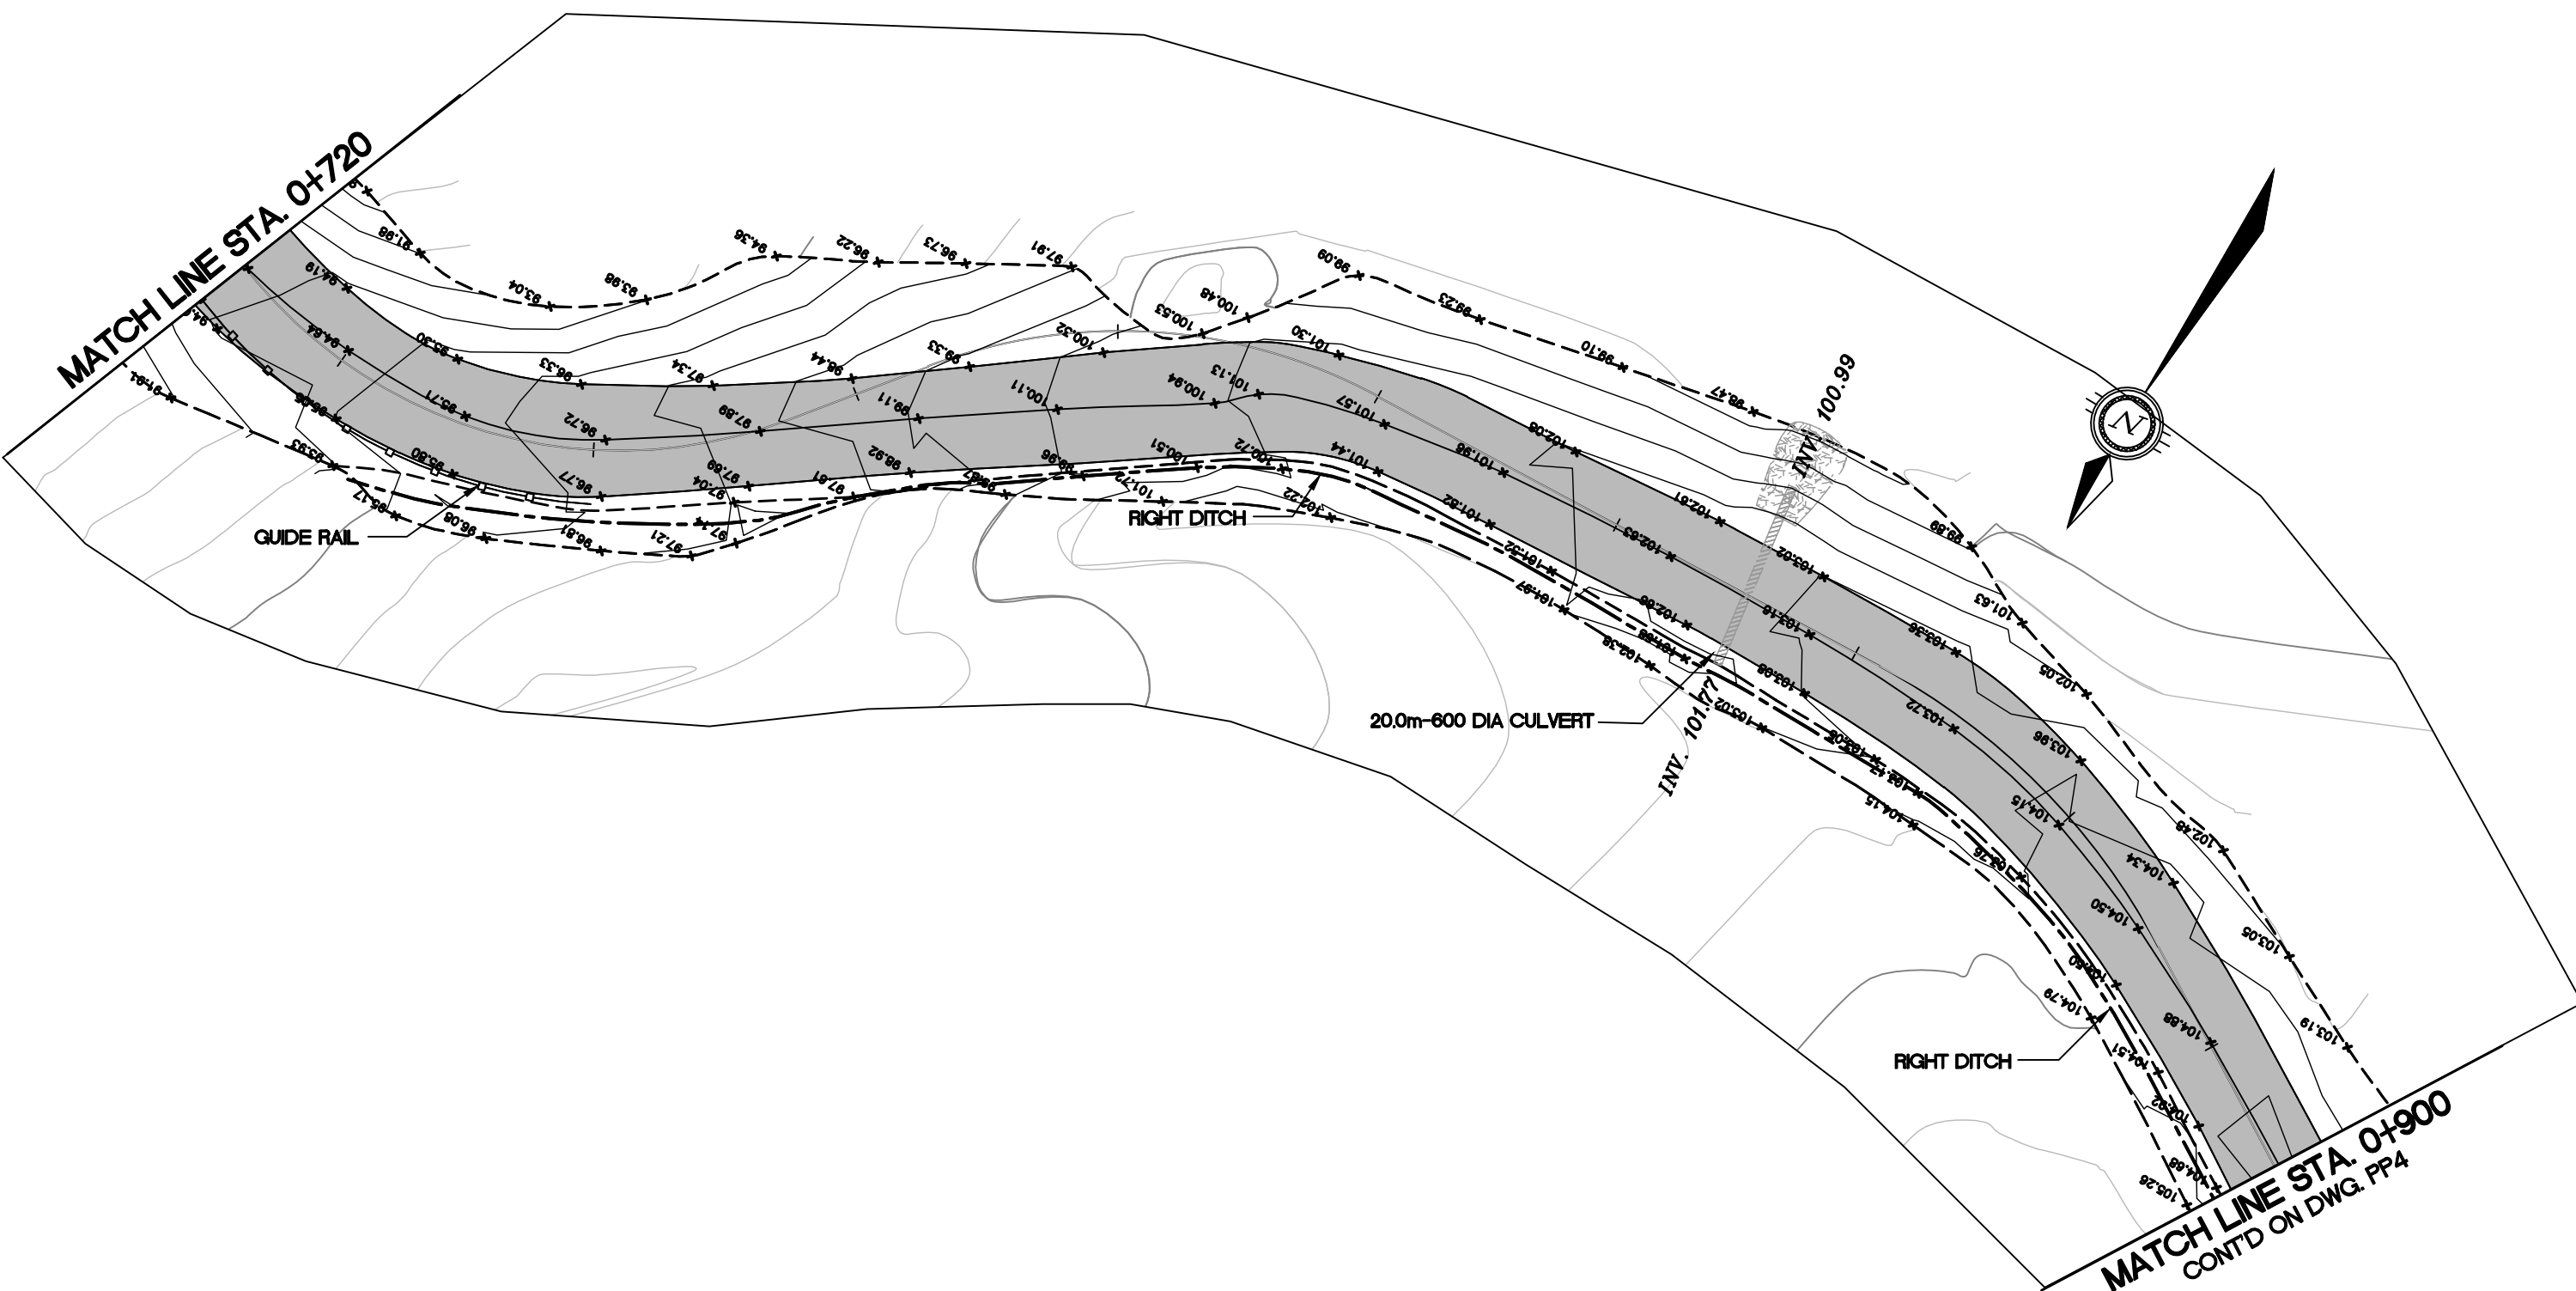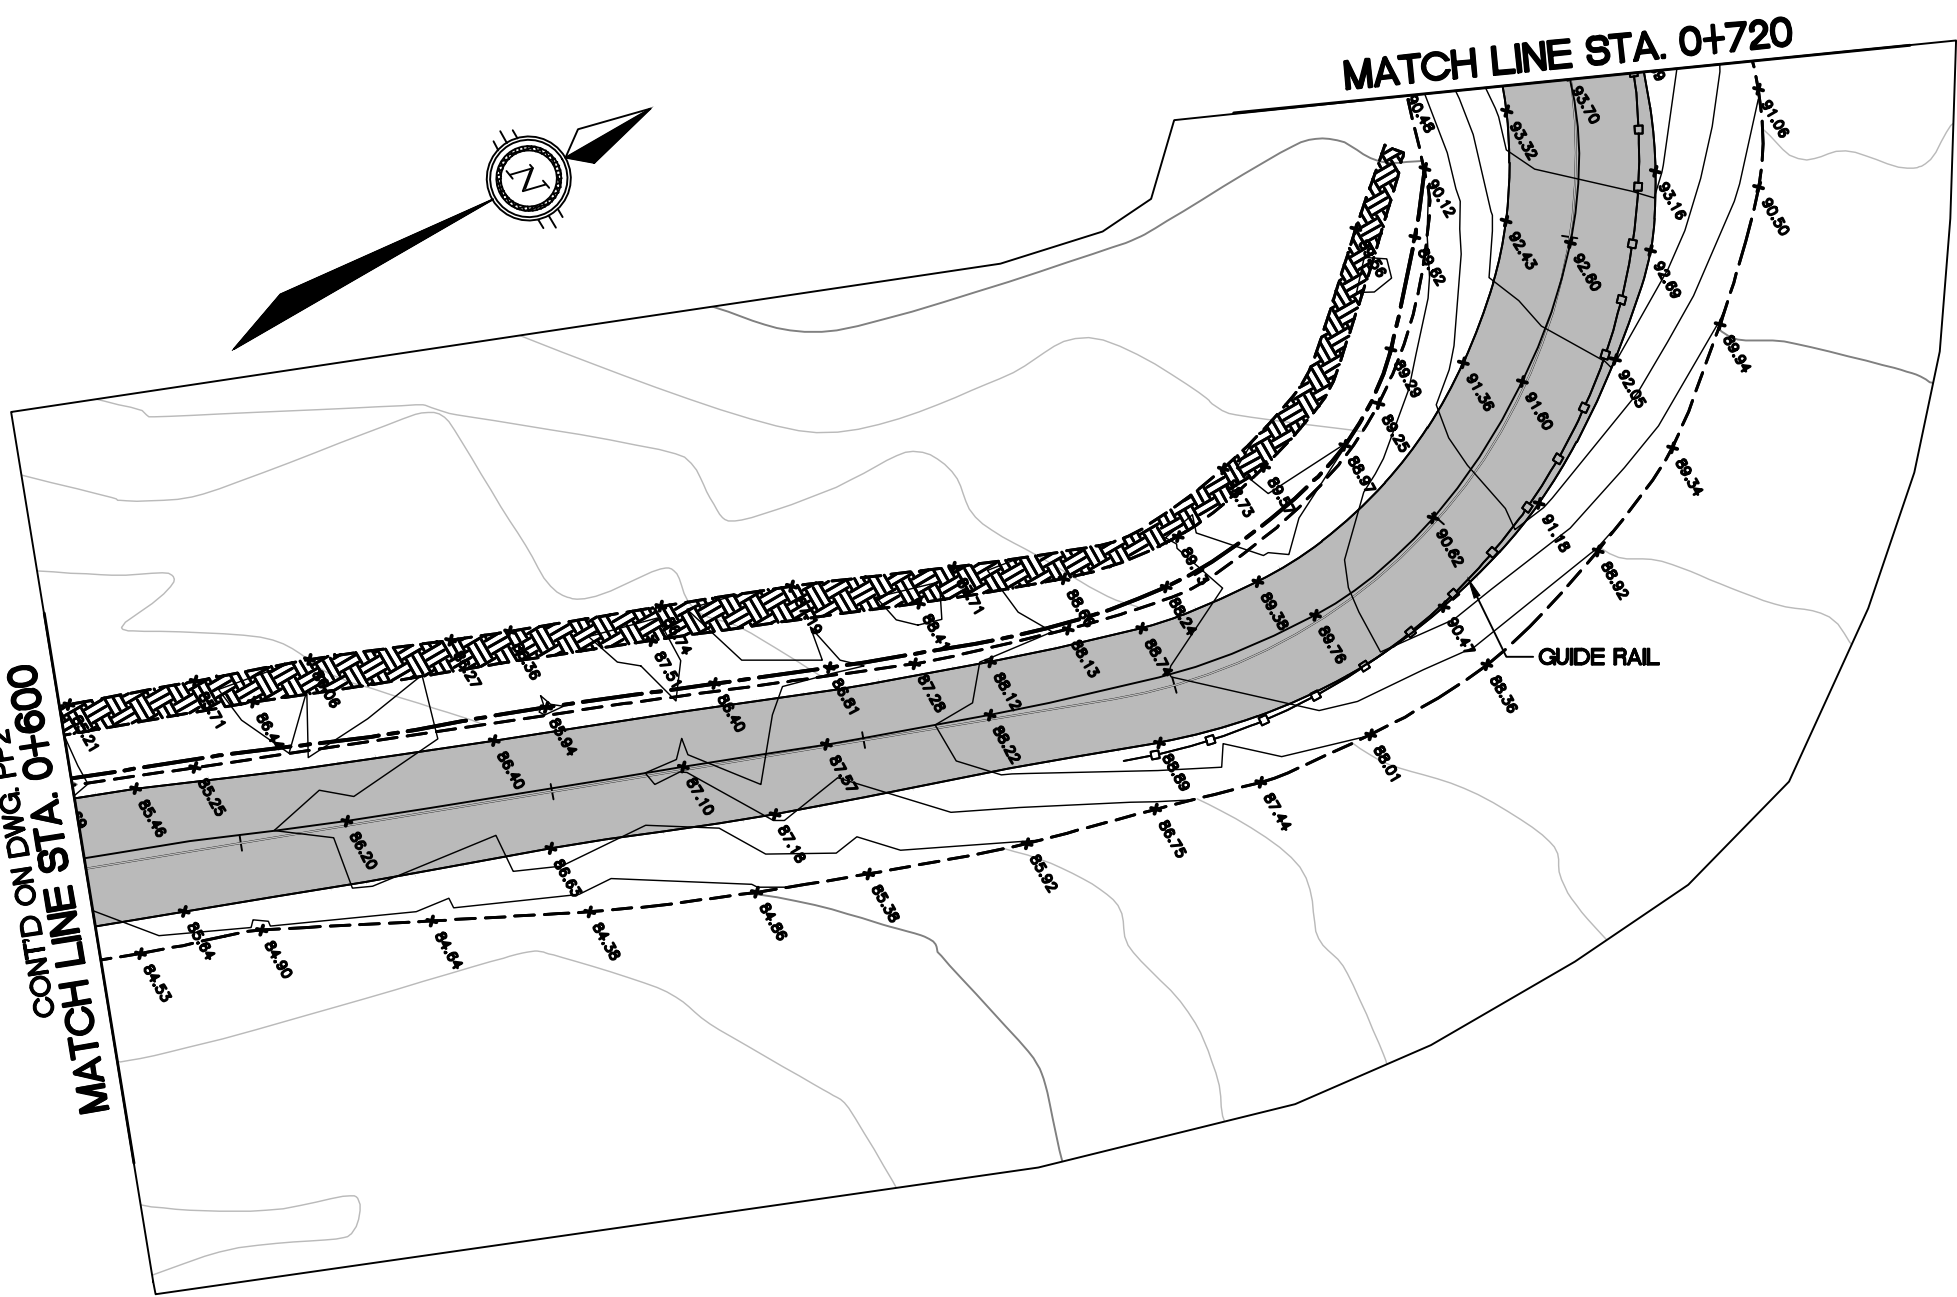

CL Road	85.30 84.72	86.25 85.47	87.07 86.26	88.19 87.26	88.60 88.35	89.38 89.37	93.43 91.22	95.52 94.52	97.51 96.07	97.51 98.28	101.12 100.71	102.02 100.54	102.96 100.65	103.82 103.03	104.60 104.00	105.19	CL Road
Stations	0+600	0+620	0+640	0+660	0+680	0+700	0+720	0+740	0+760	0+780	0+800	0+820	0+840	0+860	0+880	0+900	Stations