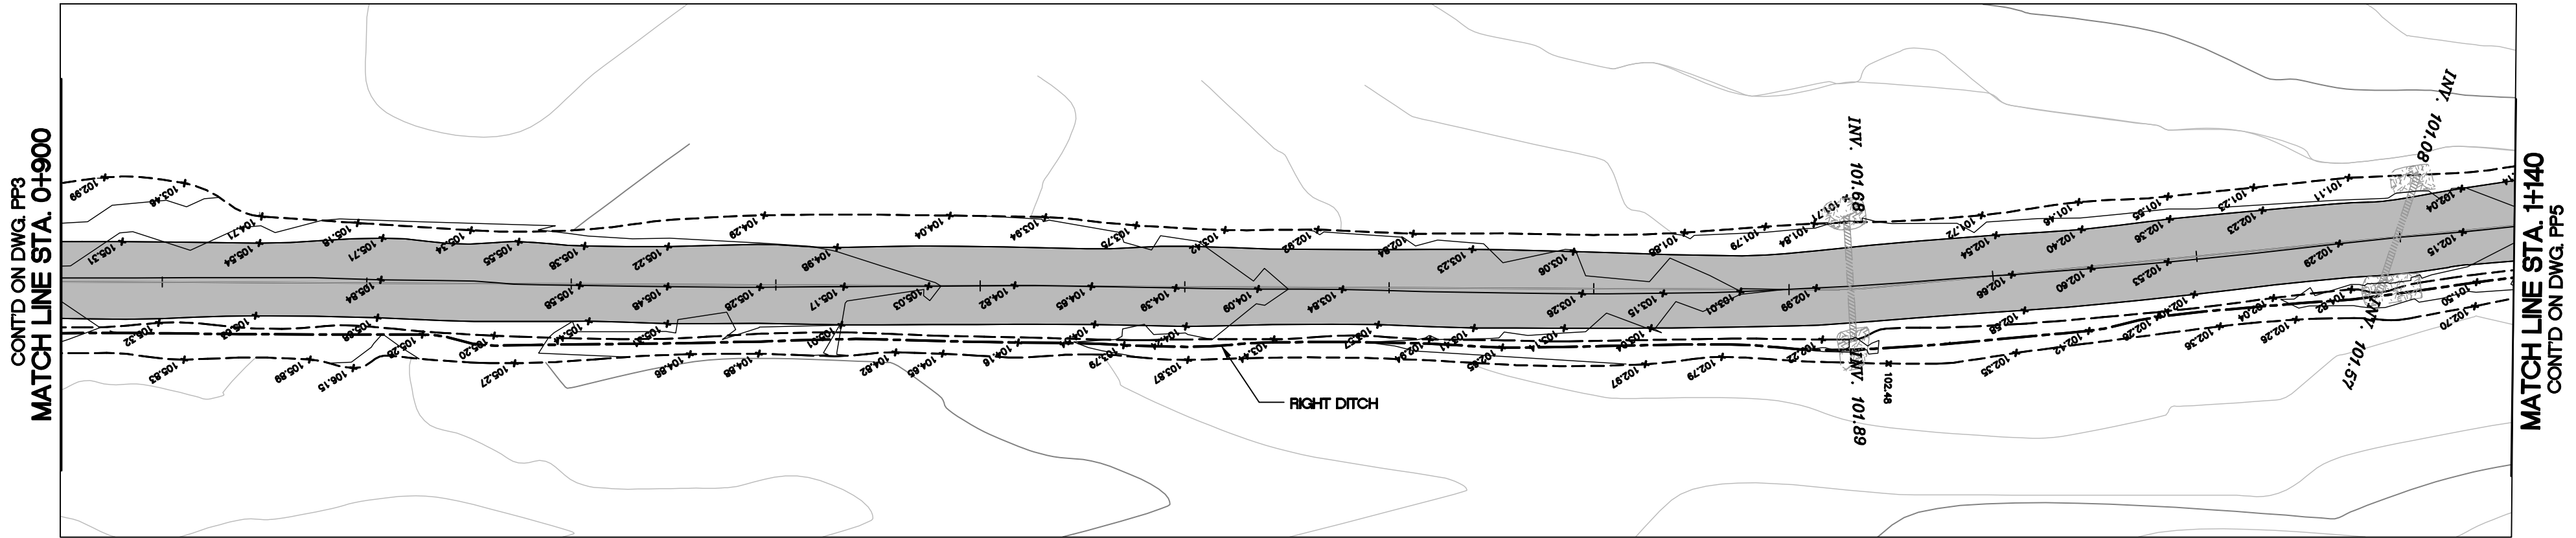


KEY PLAN

LEGEND

AS-BUILT

DATE: NOVEMBER 30, 2011

BENCH MARK

BM 1
DESCRIPTION HERE
ELEV. = 000.00

5	AS-BUILT	30/11/11	SAB	SLB
4	AS-CONSTRUCTED	17/11/11	MEB	SLB
3	ISSUED FOR CONSTRUCTION	14/09/09	MMR	SLB
2	TENDER SET	27/04/09	MMR	SLB
1	ISSUED FOR APPROVAL	24/04/08	MMR	SLB
No.	DESCRIPTION	DATE	BY	APP'D
R E V I S I O N S				

DRAWINGS ORIGINALLY
SEALED BY
S.L.BURDEN, P.eng. OF
exp. SERVICES Inc.
APRIL 27TH, 2009

Trow Associates Inc.
154 Colonnade Road, South
Ottawa, Ont. K2E 7J5
Tel: (613) 225-9940
Fax: (613) 225-7337

CLIENT
GOVERNMENT OF NUNAVUT

PROJECT
ARCTIC BAY
WASTE WATER
LAGOON ROAD

TITLE
ACCESS ROAD
PLAN & PROFILE
STA. 0+900 TO STA. 1+200

design by	S.A.D.	project no.	OTCD19054A
drawn by	M.M.R.	drawing no.	PP4
checked by	S.L.B.		
date	21/04/08		
scale	HORIZ 1:500 VERT 1:50		

