


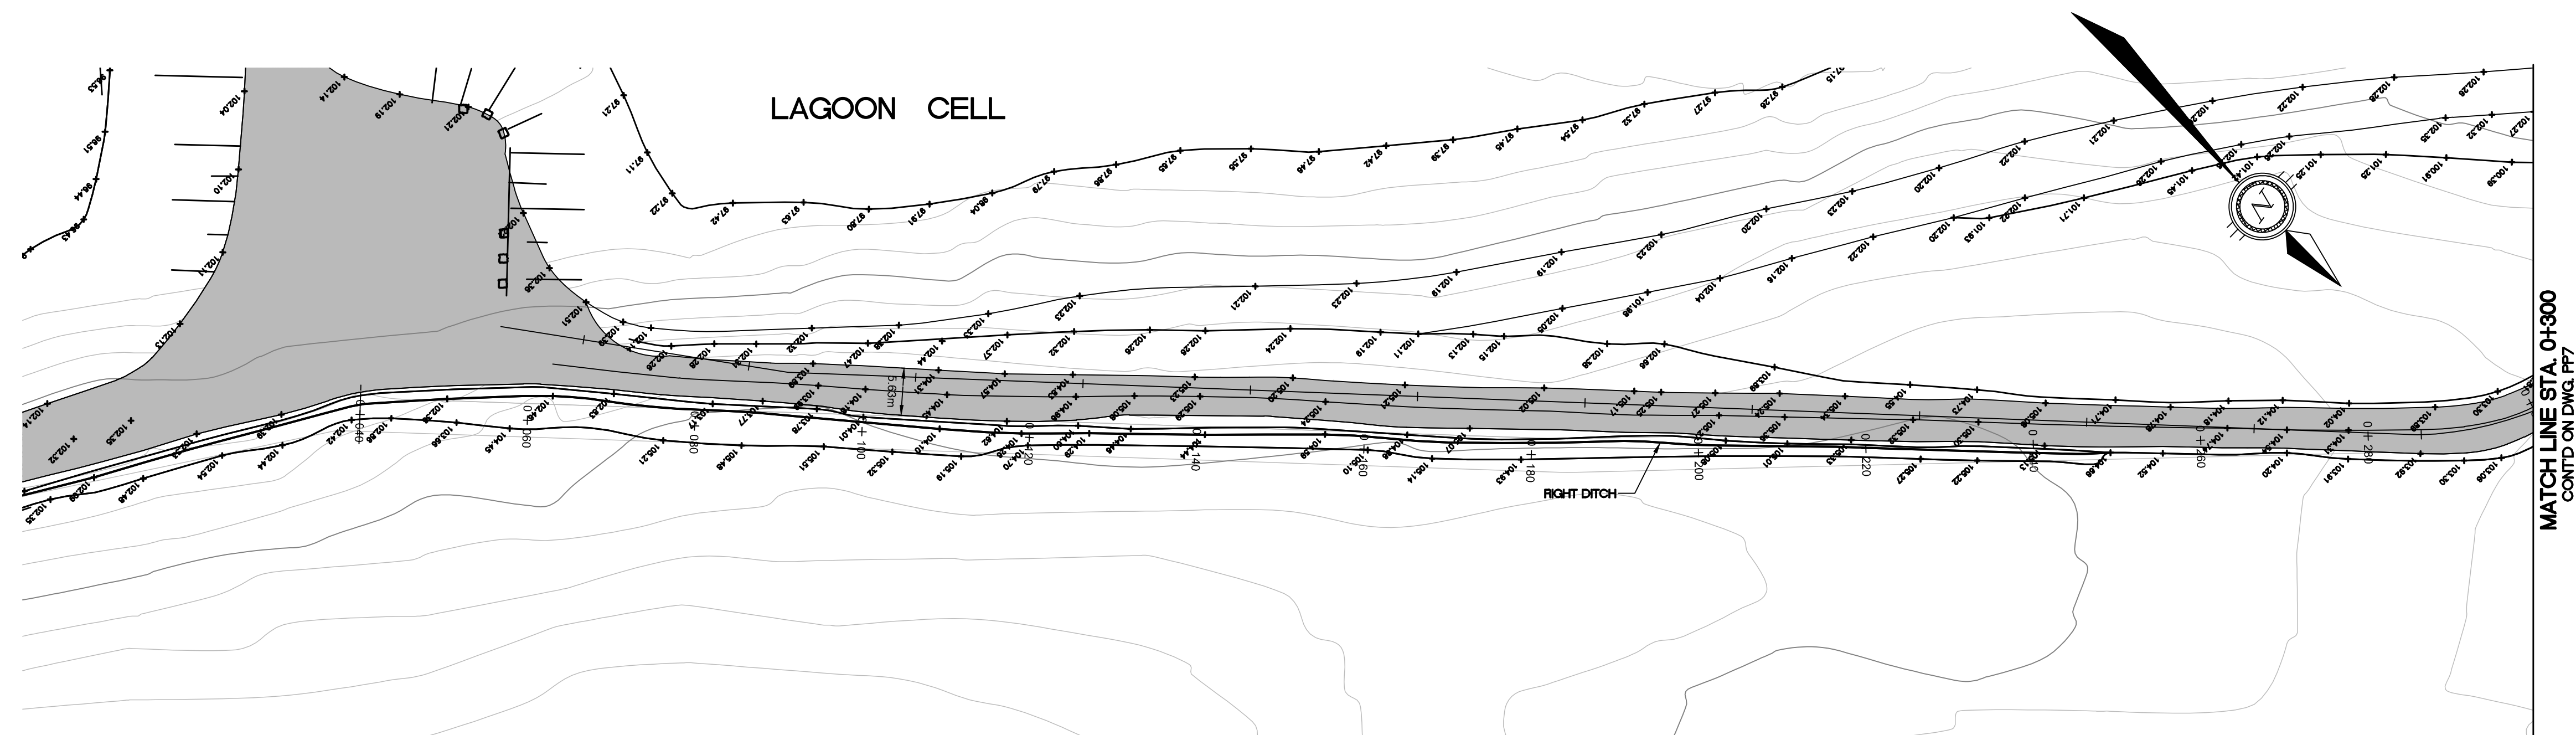

KEY PLAN

LEGEND

AS-BUILT

DATE: NOVEMBER 30, 2011

BENCH MARK

BM 1	DESCRIPTION HERE
------	------------------

ELEV. = 000.00

5	AS-BUILT	30/11/11	SAB	SLB
4	AS-CONSTRUCTED	17/11/11	MEB	SLB
3	ISSUED FOR CONSTRUCTION	14/09/09	MMR	SLB
2	TENDER SET	27/04/09	MMR	SLB
1	ISSUED FOR APPROVAL	24/04/08	MMR	SLB
No.	DESCRIPTION	DATE	BY	APP'D
R E V I S I O N S				

DRAWINGS ORIGINALLY
SEALED BY
S.L.BURDEN, P.eng. OF
exp. SERVICES Inc.
APRIL 27TH, 2009



CLIENT

GOVERNMENT OF NUNAVUT

PROJECT

ARCTIC BAY
WASTE WATER LAGOON

TITLE

ACCESS ROAD
SECOND BERM
PLAN & PROFILE

design by

S.A.D.

project no.	OTCD19054A
-------------	------------

drawn by

M.M.R.

drawing no.

checked by

S.L.B.

date

07/12/07

scale

HORIZ 1:500 VERT 1:50

PP6