




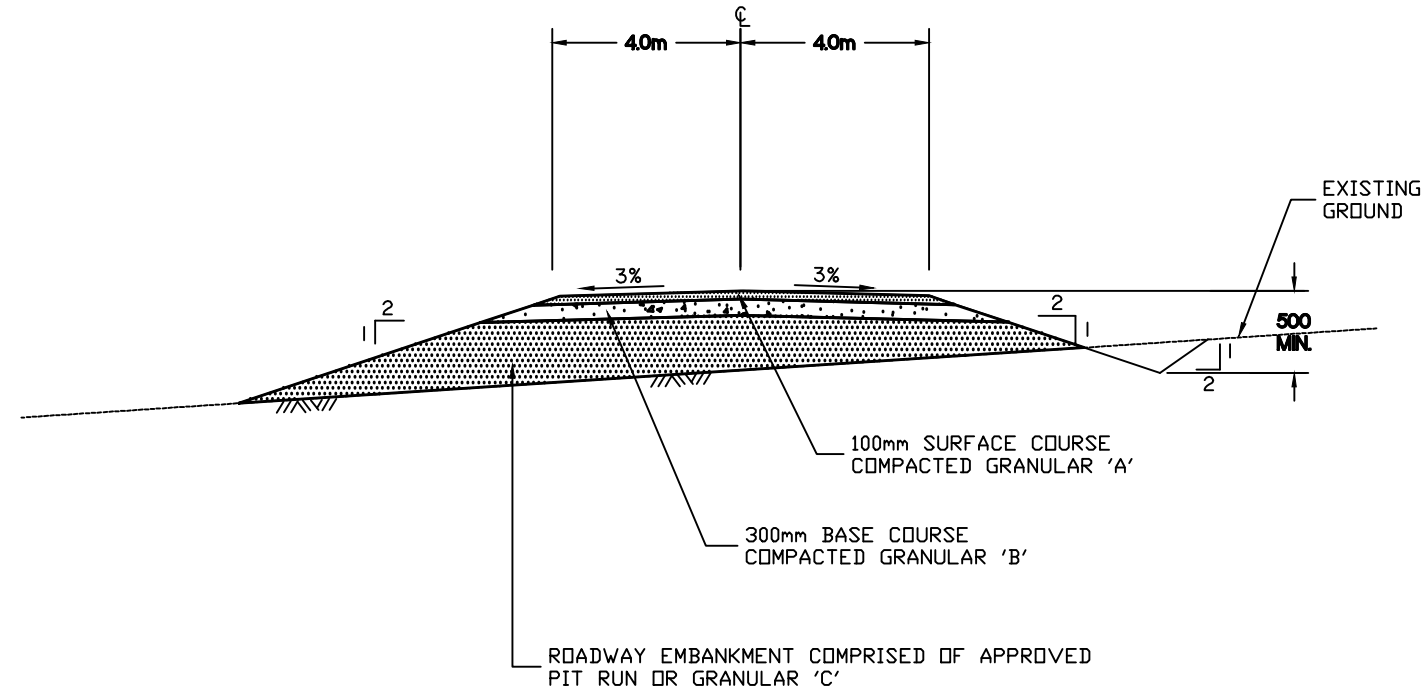


LOCAL ROAD SECTION FOR EMBANKMENT CONSTRUCTION
N.T.S.

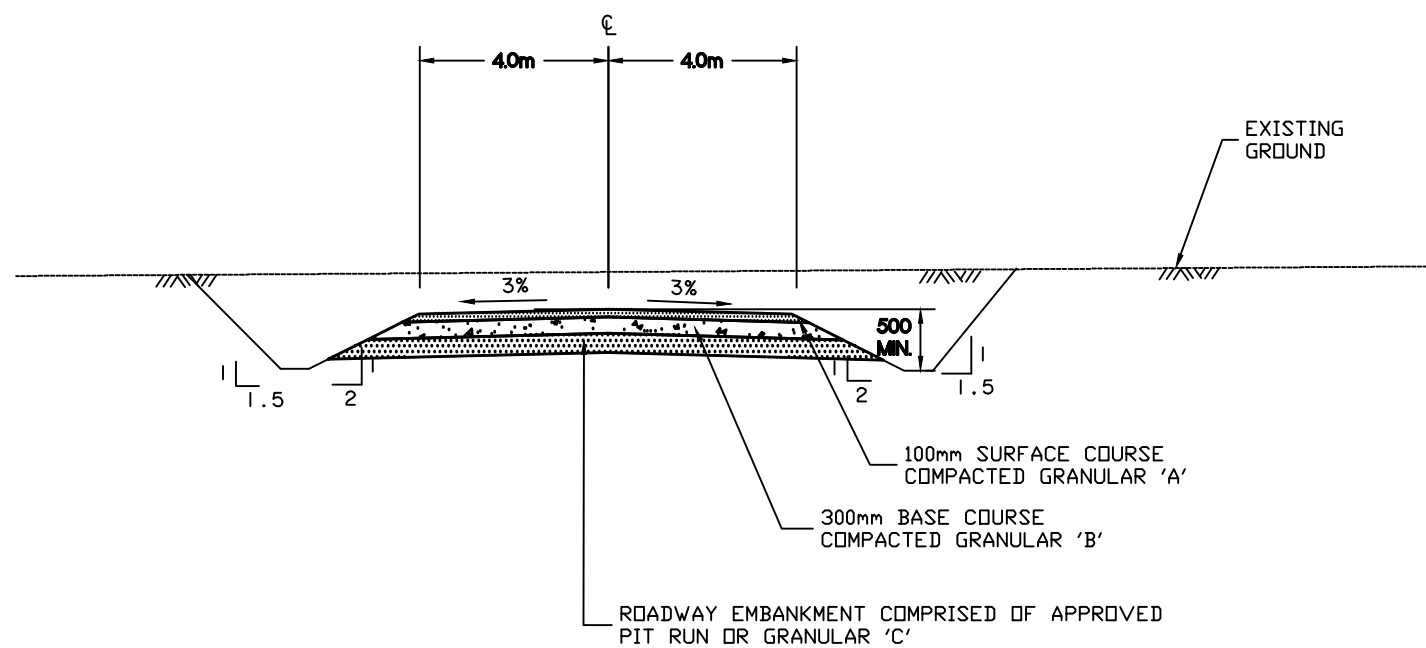


LOCAL ROAD SECTION IN CUT AREA WITH ROADSIDE DITCHES
ON BOTH SIDES
N.T.S.

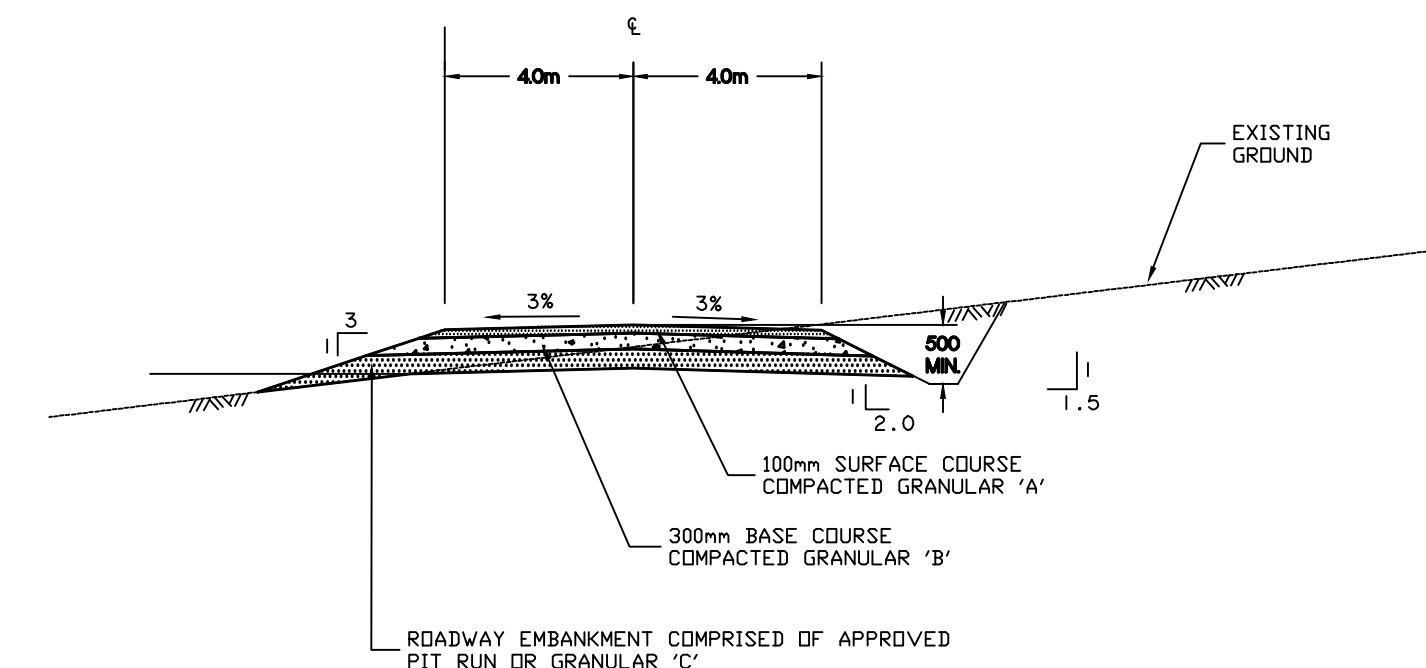


LOCAL ROAD SECTION IN CUT AREA
N.T.S.

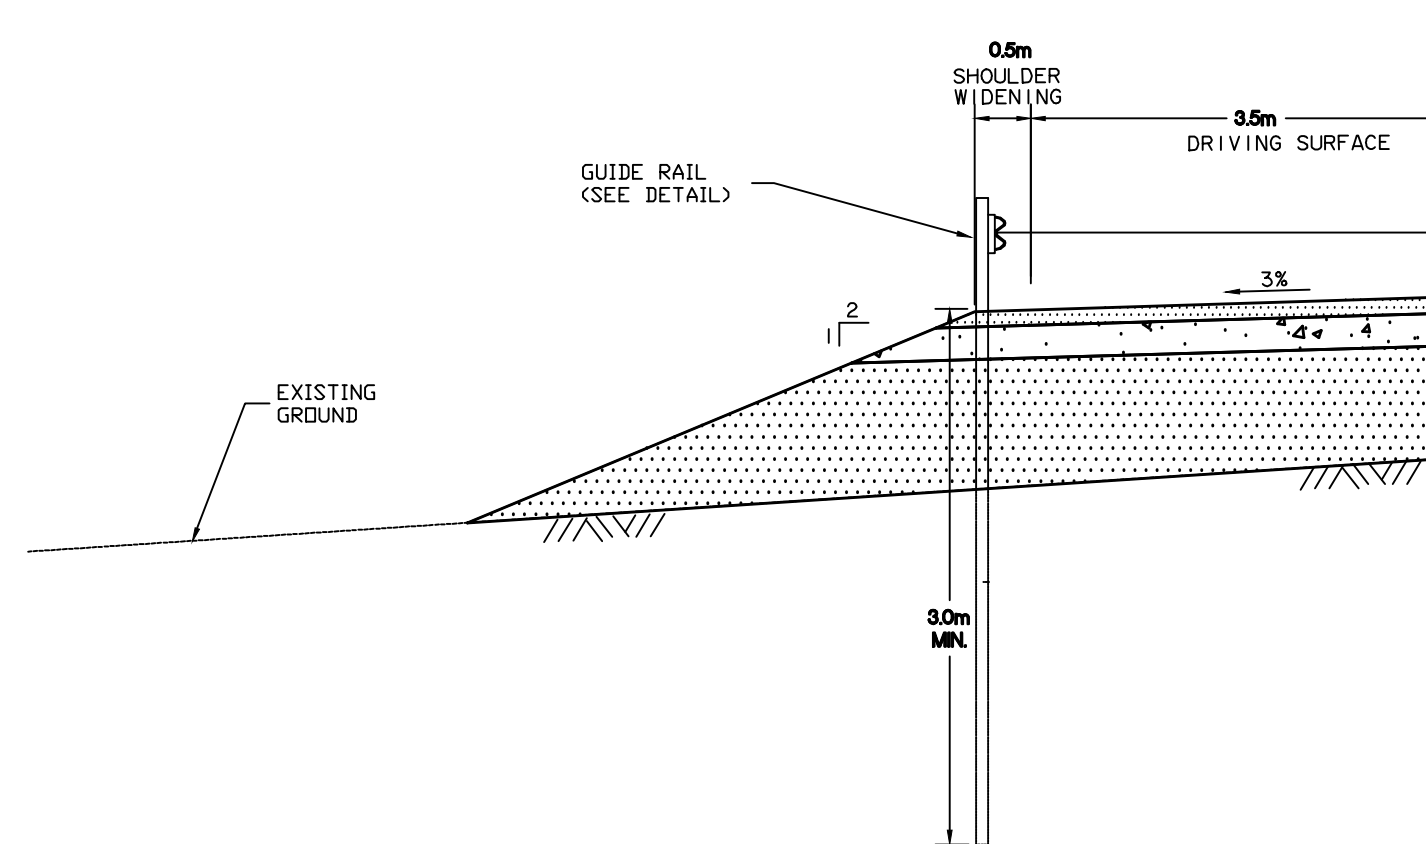

LOCAL ROAD WIDENING AT GUIDE RAIL LOCATIONS
N.T.S.

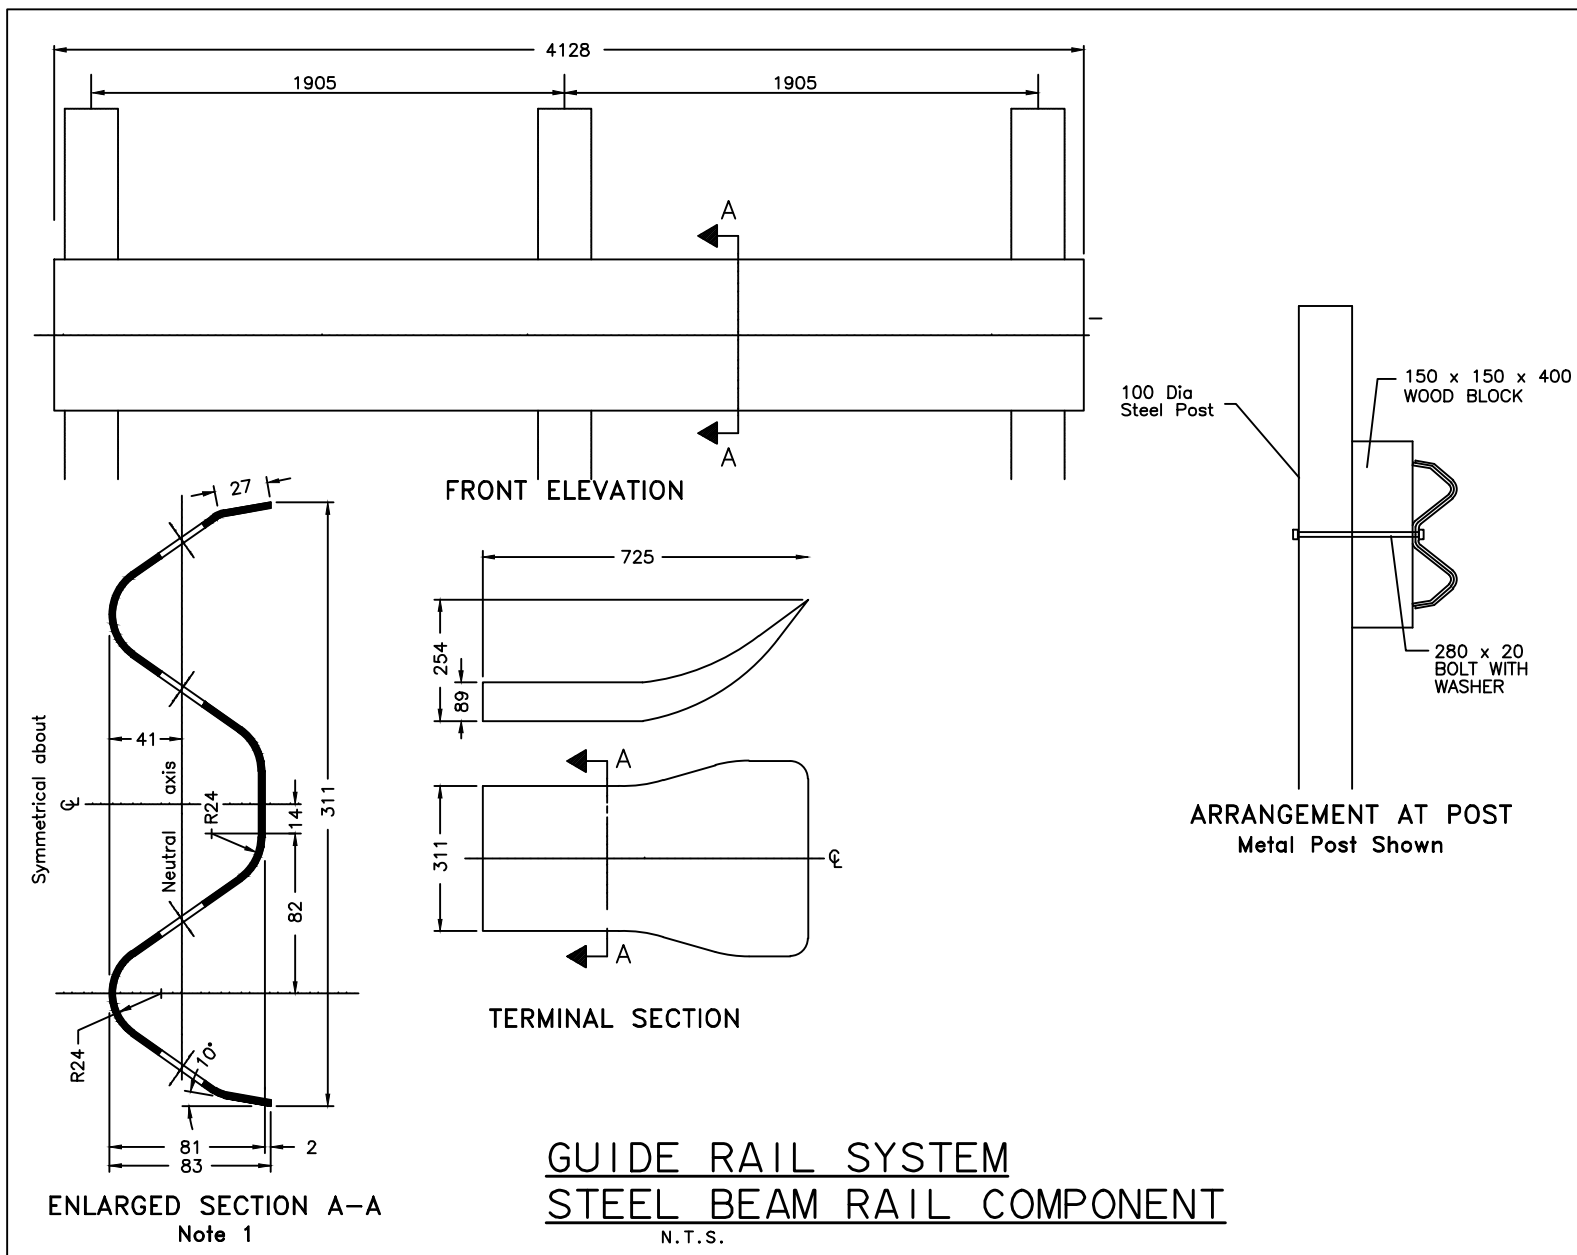


GUIDE RAIL SYSTEM
STEEL BEAM RAIL COMPONENT
N.T.S.

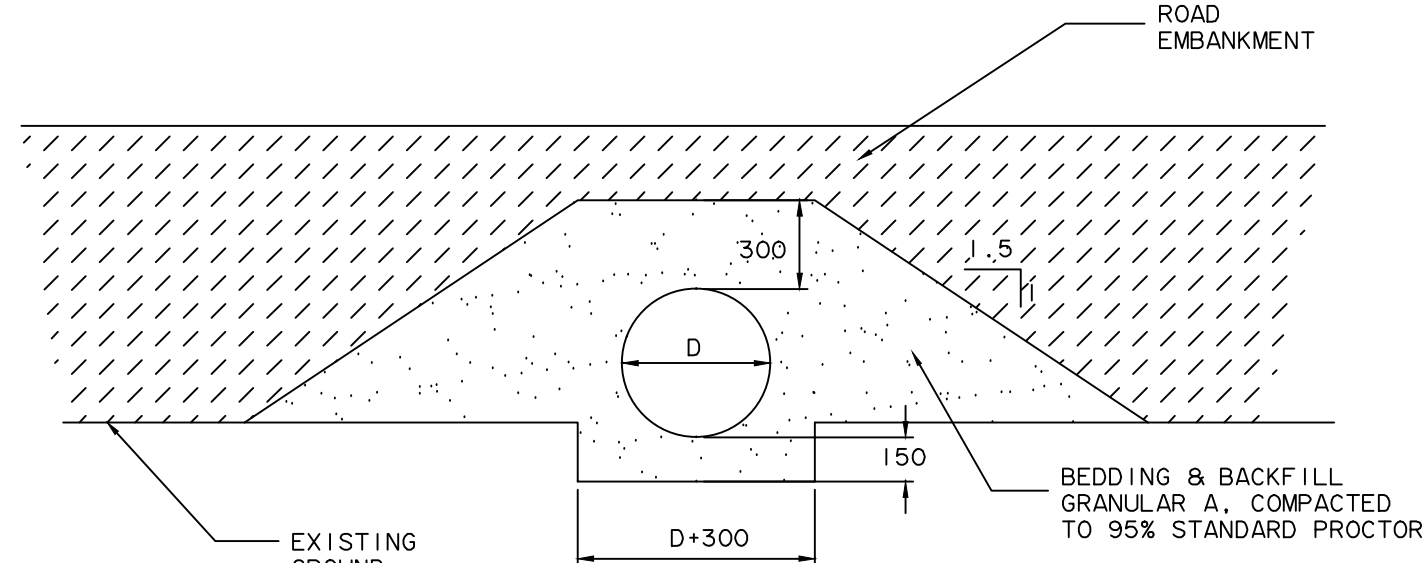


- NOTES:
1. MINIMUM COVER 450mm IN ROADS
 2. INVERT OF CULVERT 0.1D BELOW EXISTING GROUND.
 3. SEE DRAWING T-6 FOR CULVERT APRON DETAIL.

PIPE CULVERT IN
AN EMBANKMENT
N.T.S.

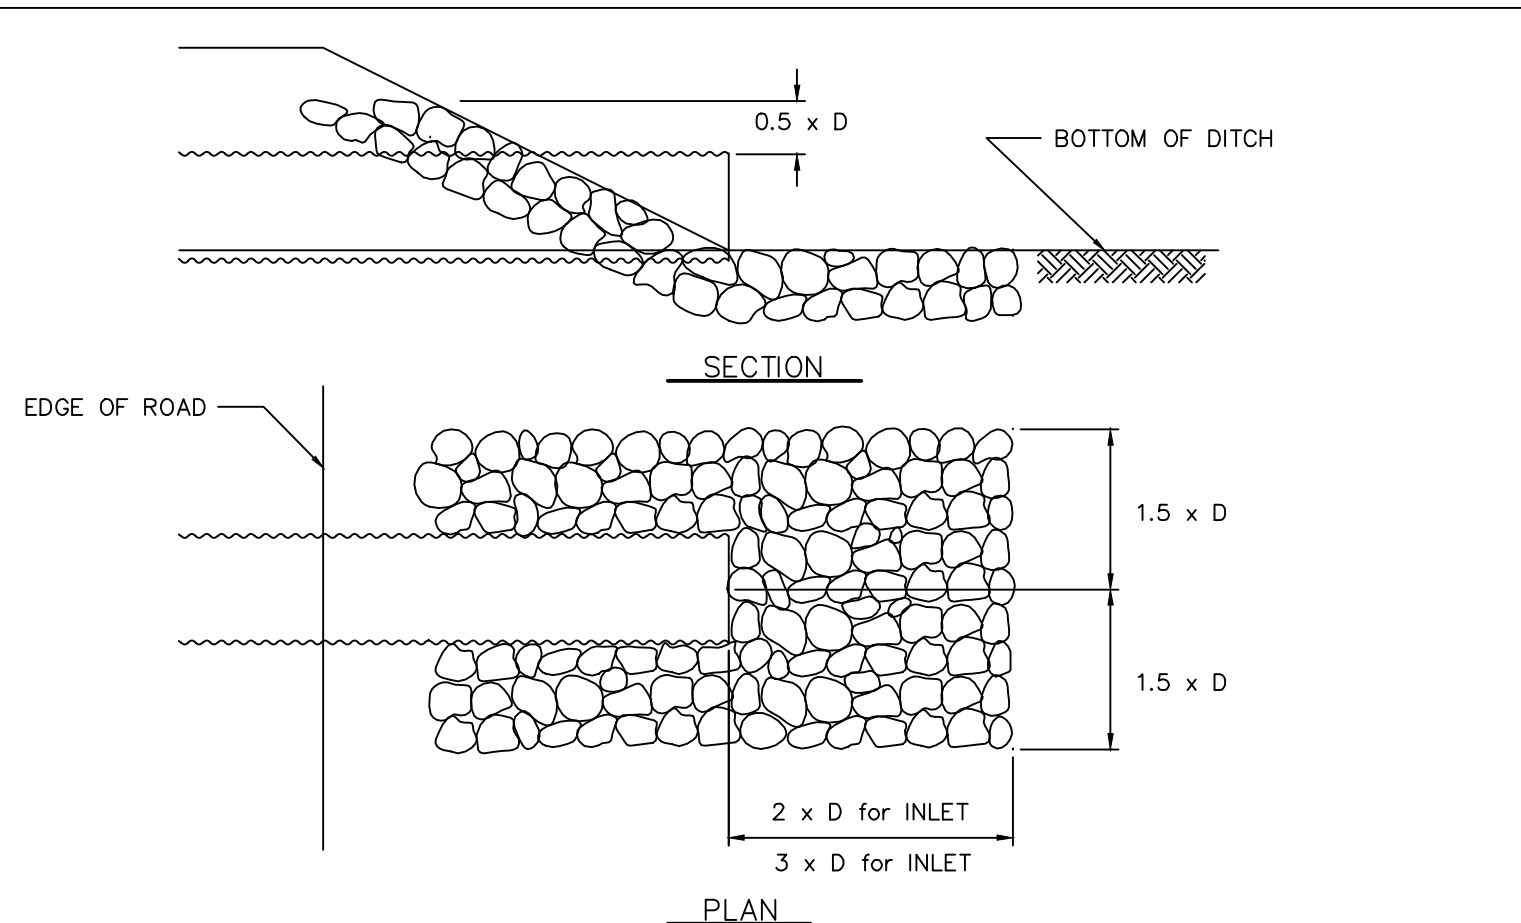

CULVERT APRON
DETAIL
N.T.S.

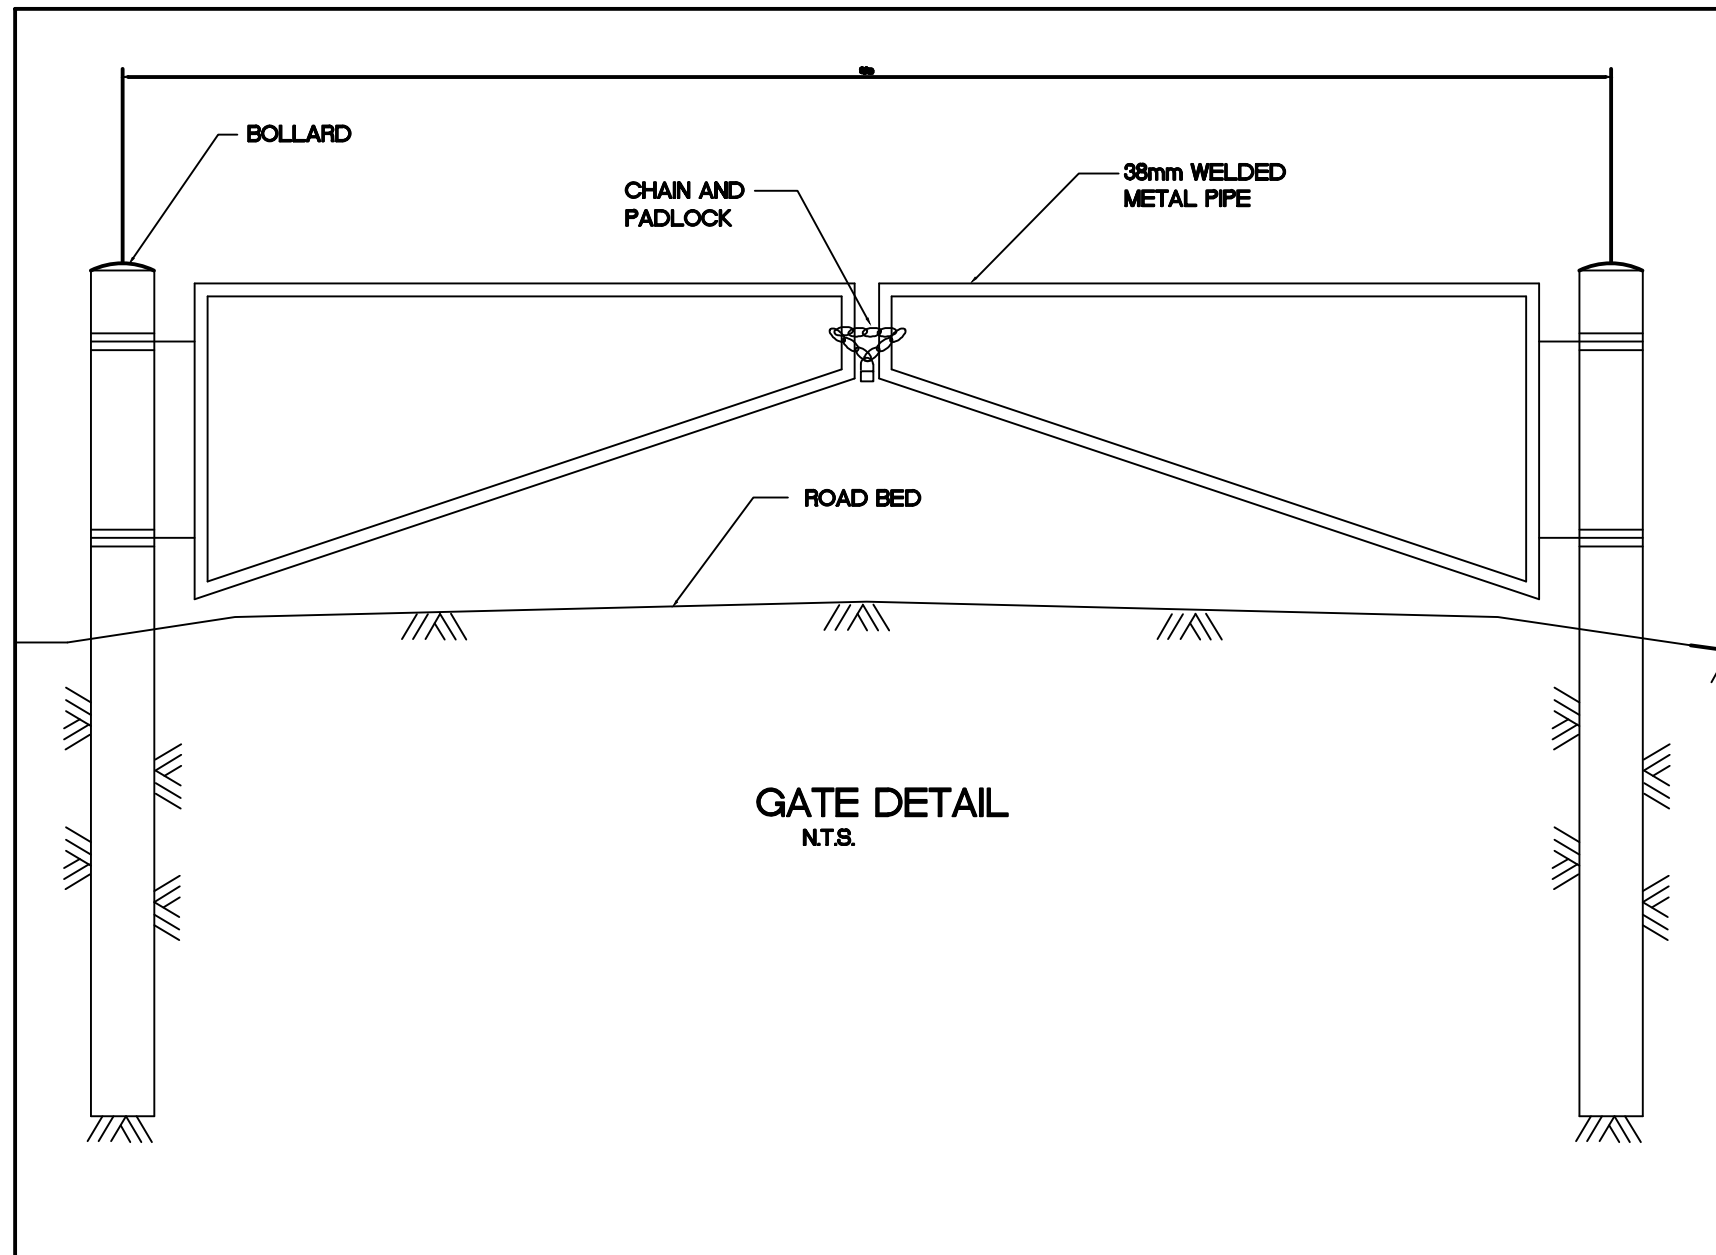

GATE DETAIL
N.T.S.

KEY PLAN

LEGEND

AS-BUILT

DATE: NOVEMBER 30, 2011

BENCH MARK

BM 1
DESCRIPTION HERE
ELEV. = 000.00

No.	DESCRIPTION	DATE	BY	APP'D
6	AS-BUILT	30/11/11	SAB	SLB
5	AS-CONSTRUCTED	17/11/11	MEB	SLB
4	ISSUED FOR CONSTRUCTION	14/09/09	MMR	SLB
3	TENDER SET	27/04/09	MMR	SLB
2	REVISED GUARD RAIL SYSTEM DETAIL	26/01/09	MMR	SLB
1	ISSUED FOR APPROVAL	24/04/08	MMR	SLB

DRAWINGS ORIGINALLY
SEALED BY
S.L.BURDEN, P.eng. OF
exp. SERVICES Inc.
APRIL 27TH, 2009

Trow Associates Inc.
154 Colonnade Road South
Ottawa, Ont. K2E 7J5
Tel: (613) 225-9940
Fax: (613) 225-7337

CLIENT
GOVERNMENT OF NUNAVUT

PROJECT
ARCTIC BAY
WASTE WATER LAGOON

TITLE
ROAD DETAILS

design by	S.A.D.	project no.	OTCD19054A
drawn by	M.M.R.	drawing no.	DE-1
checked by	S.L.B.		
date	14/12/07		
scale	AS SHOWN		