
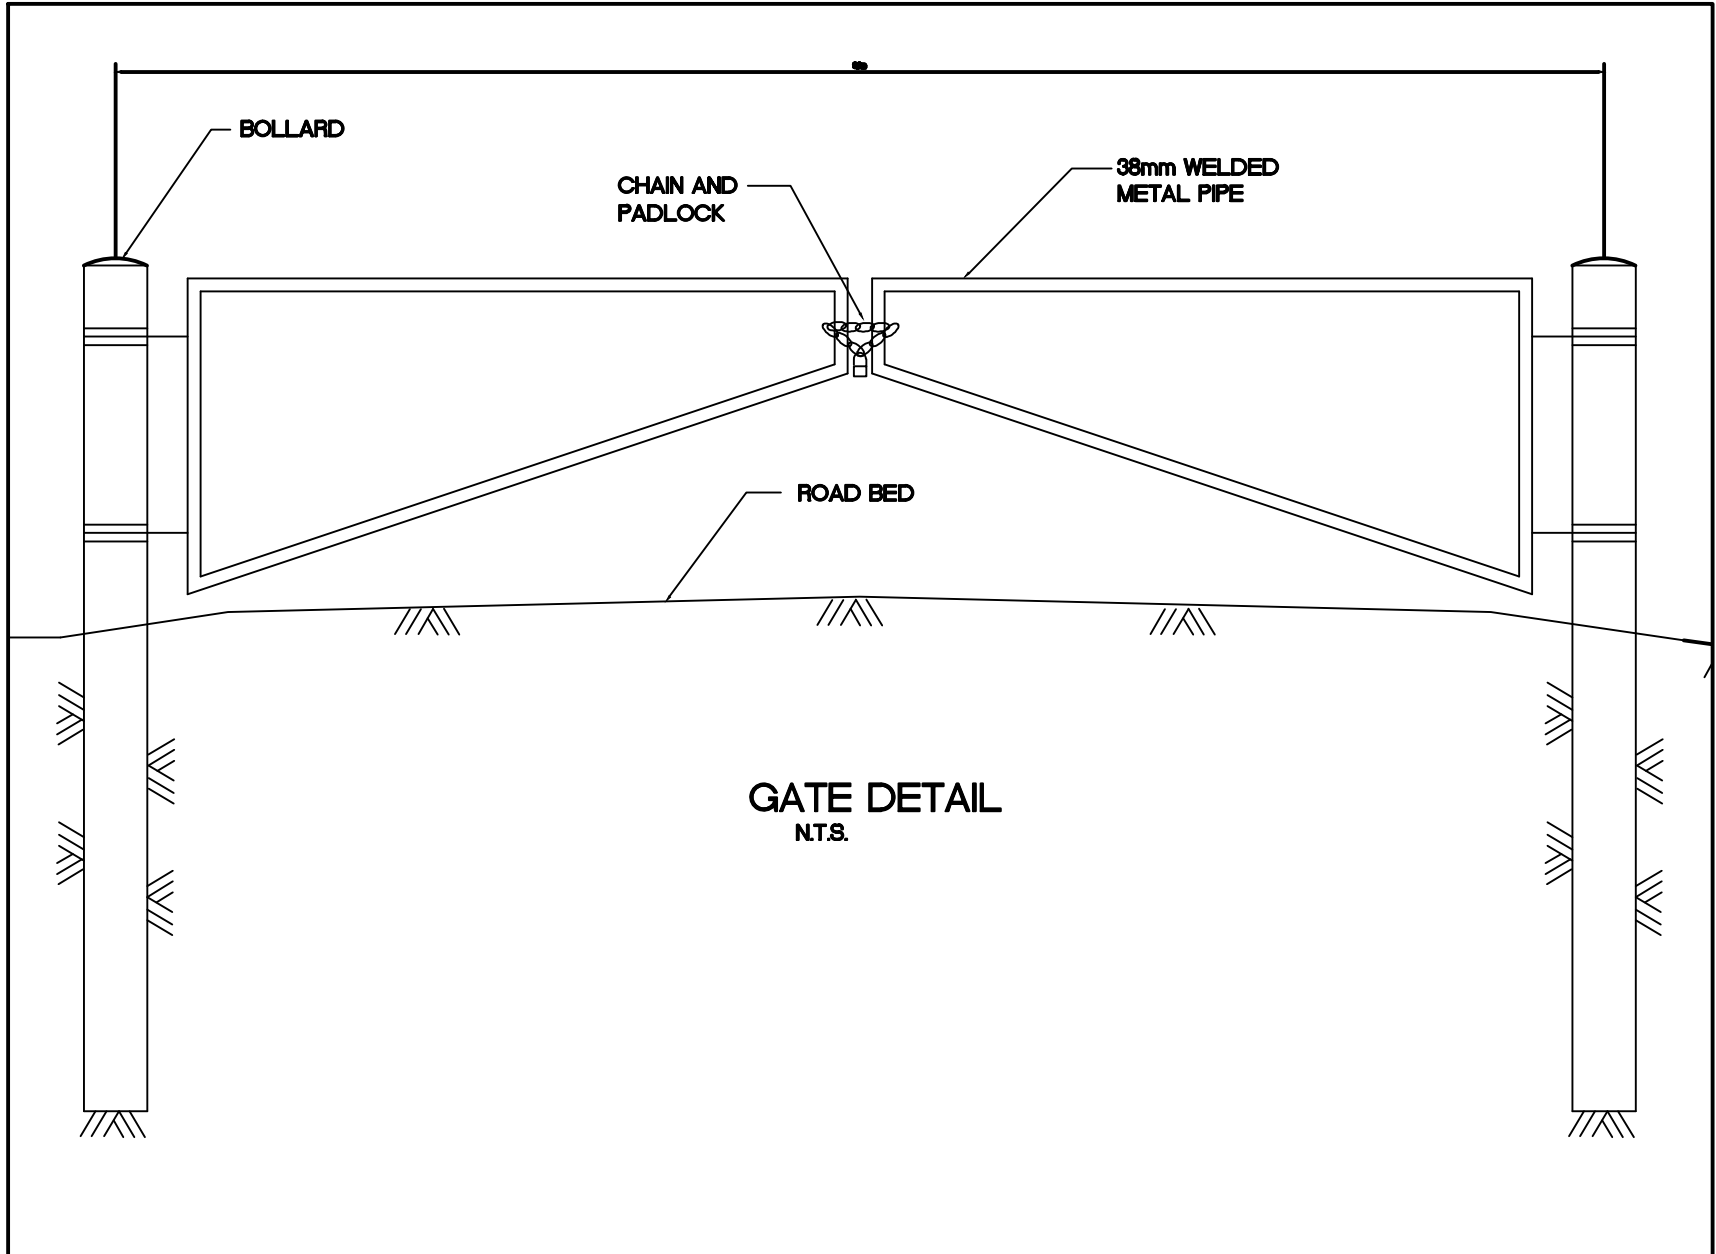
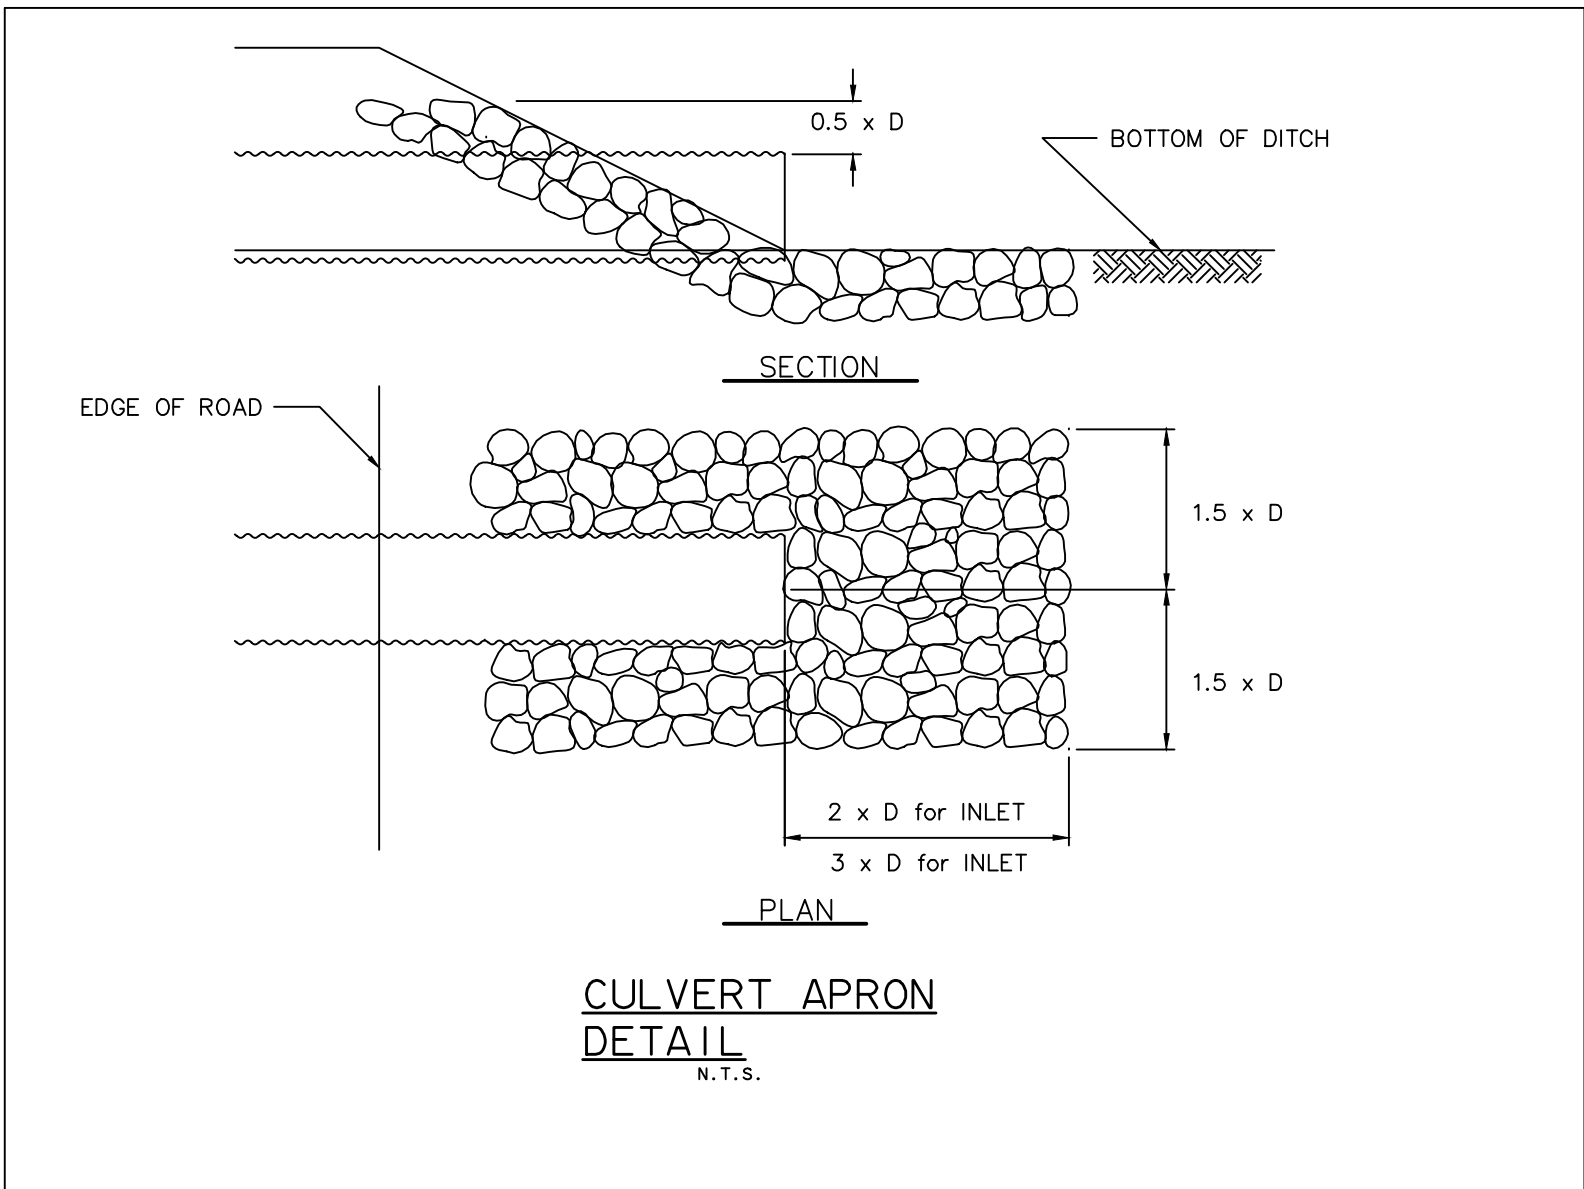
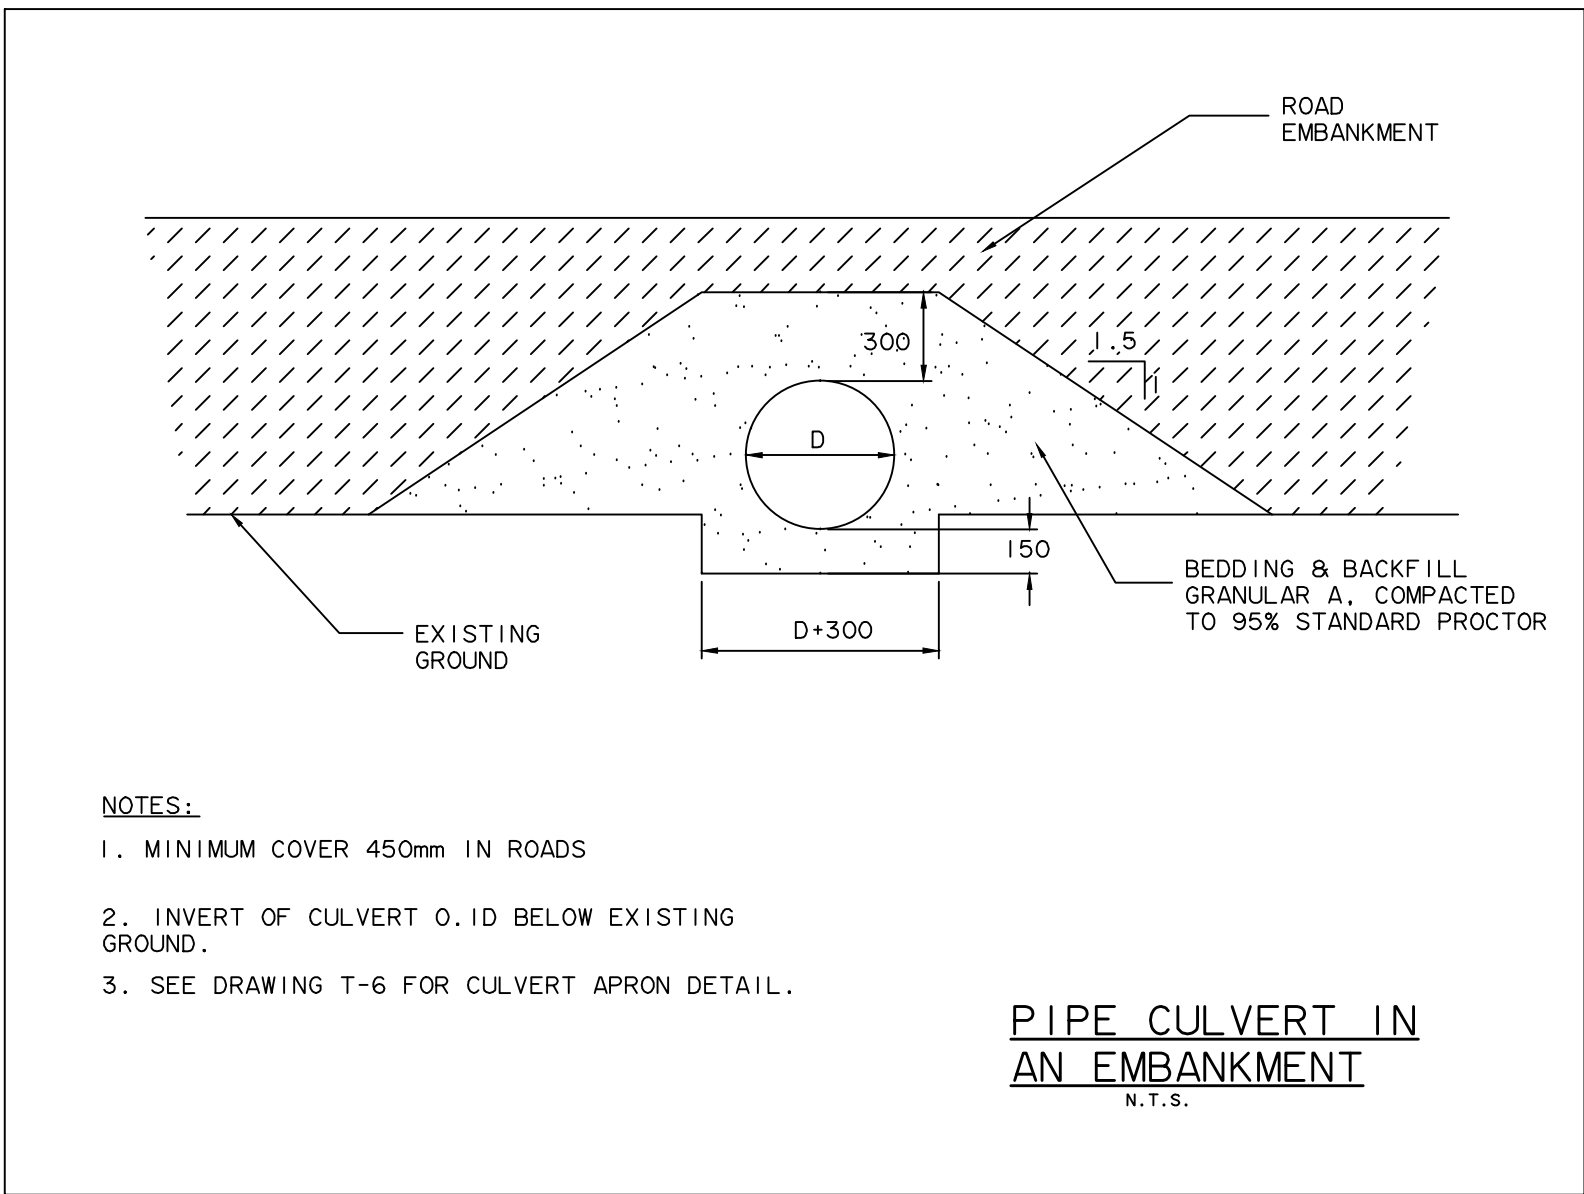
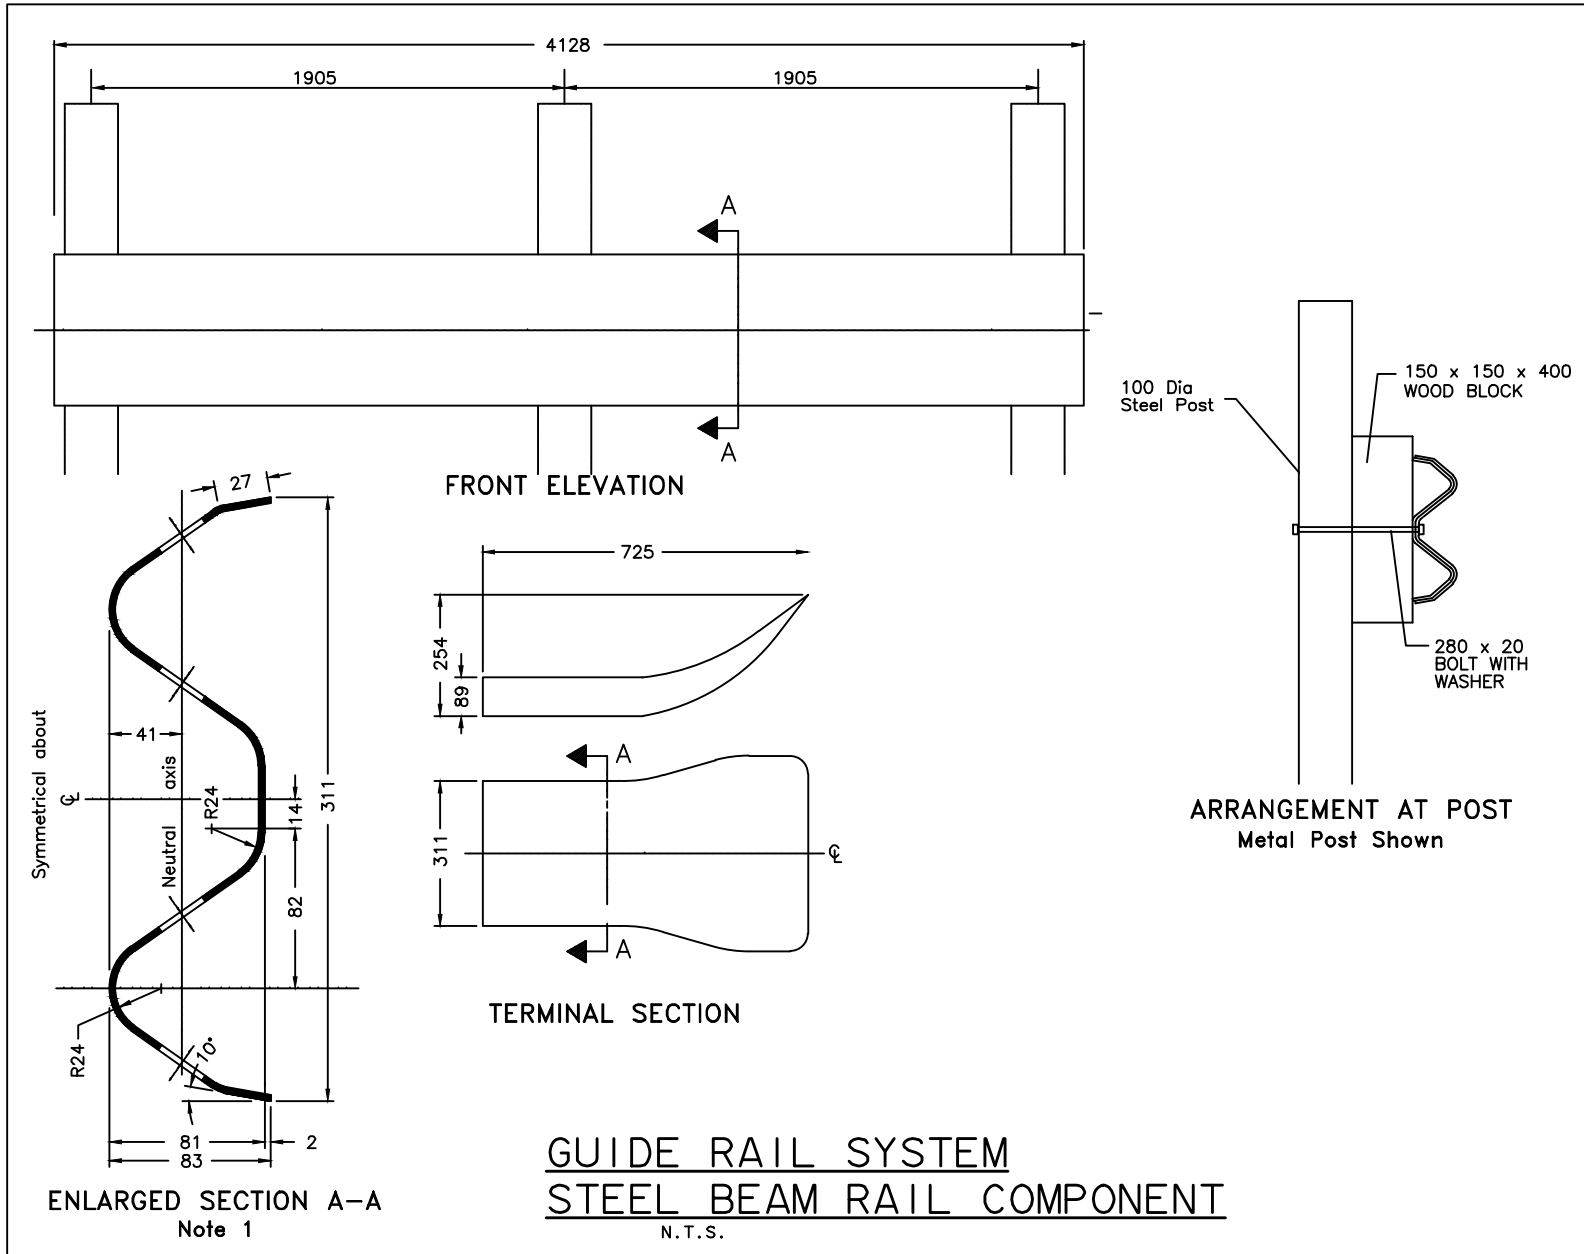
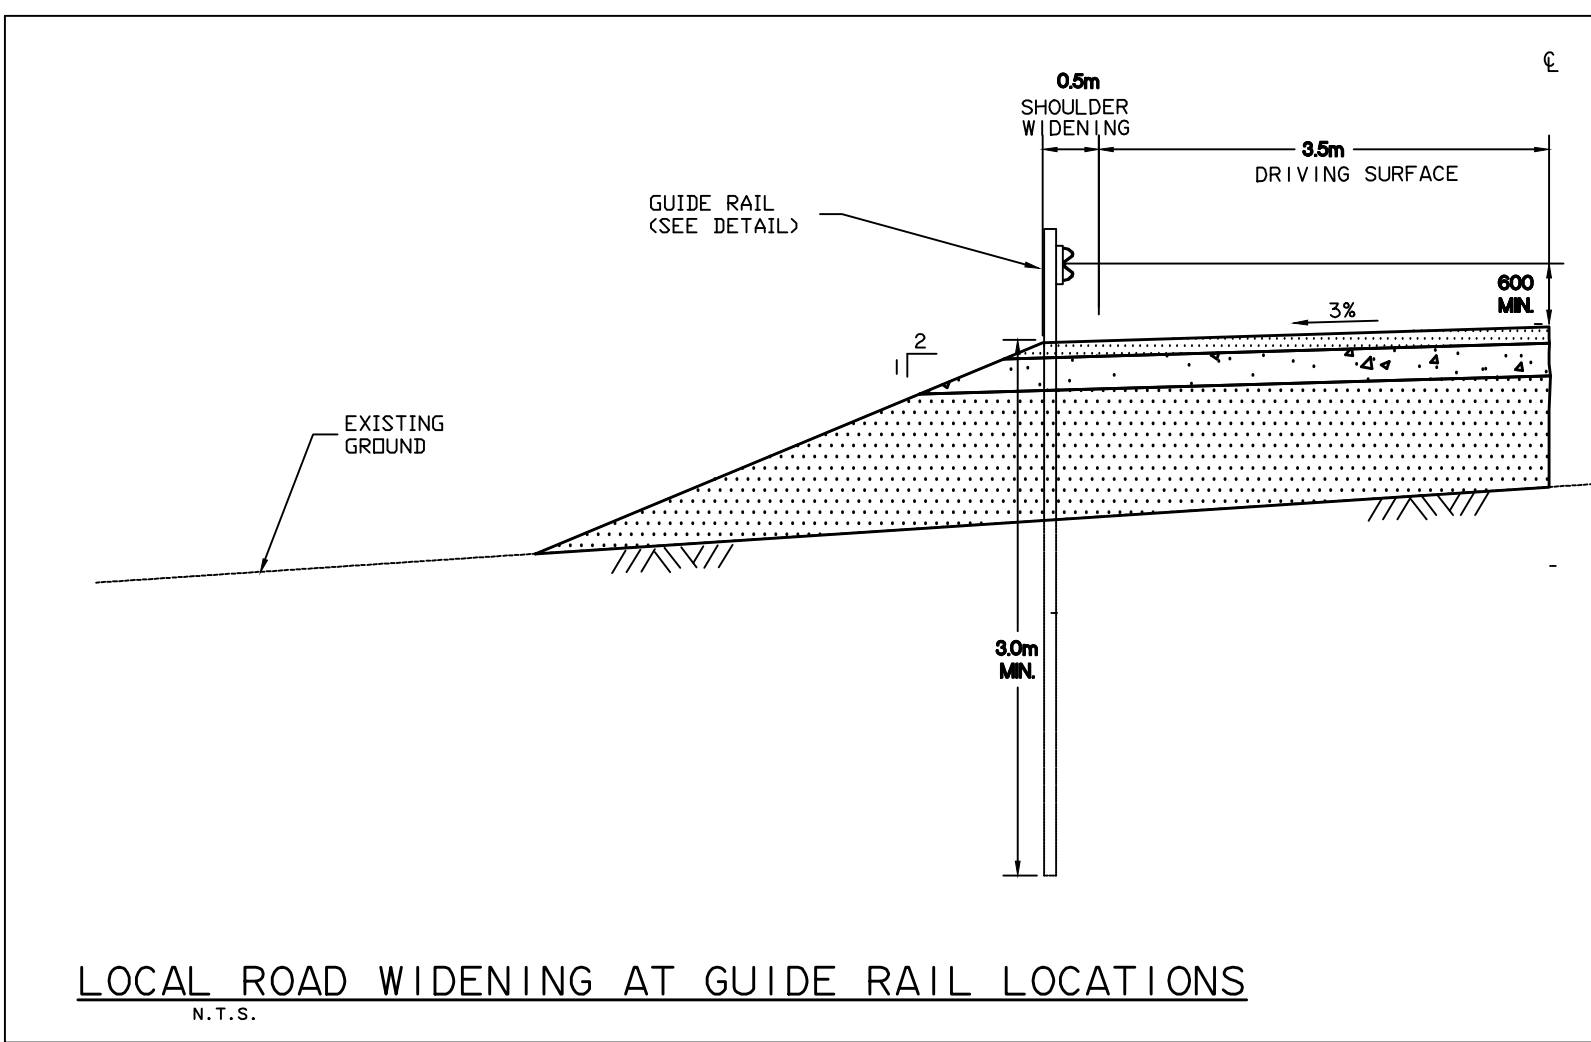
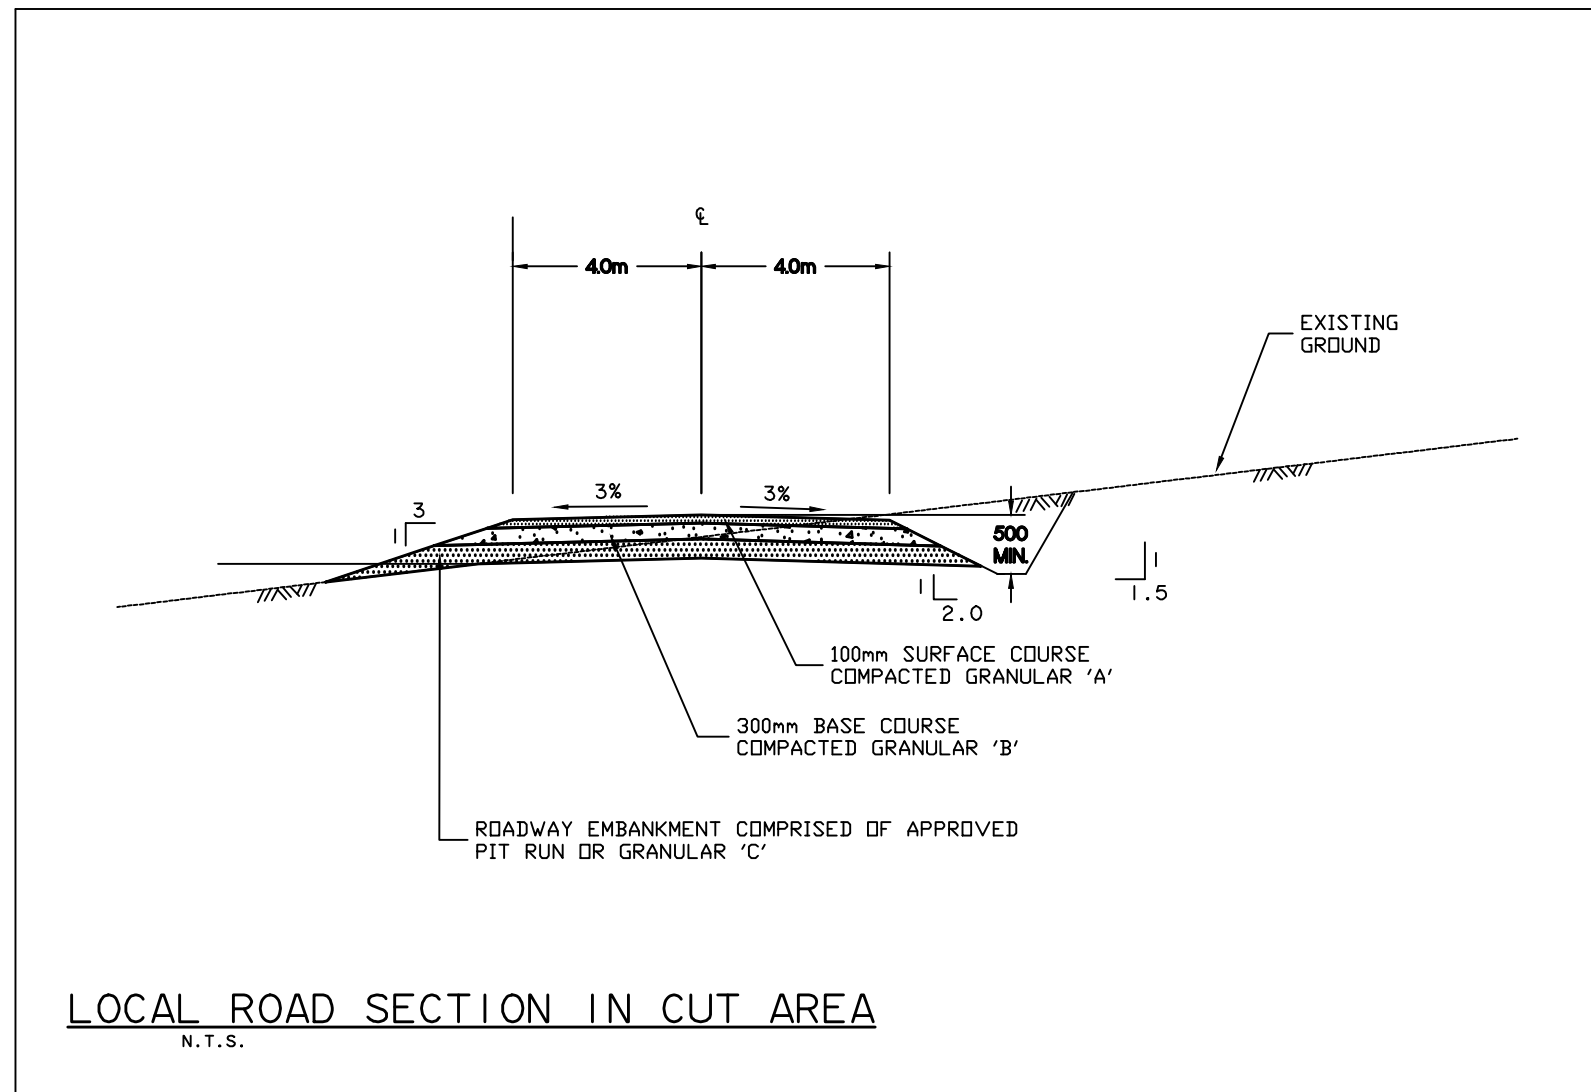
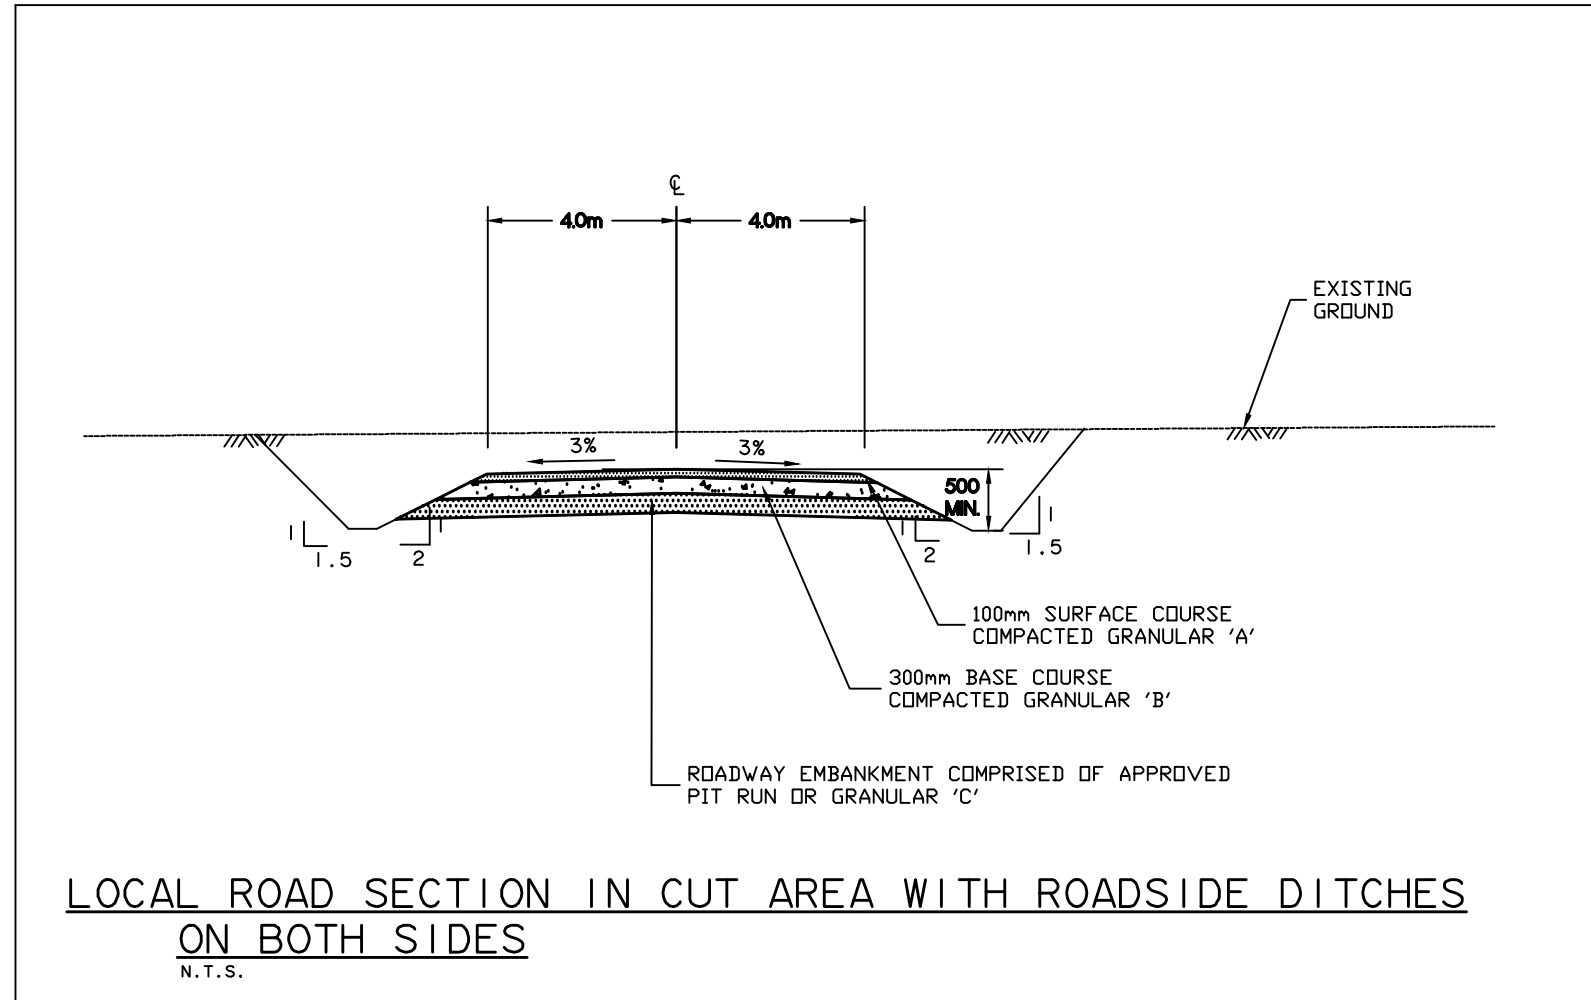


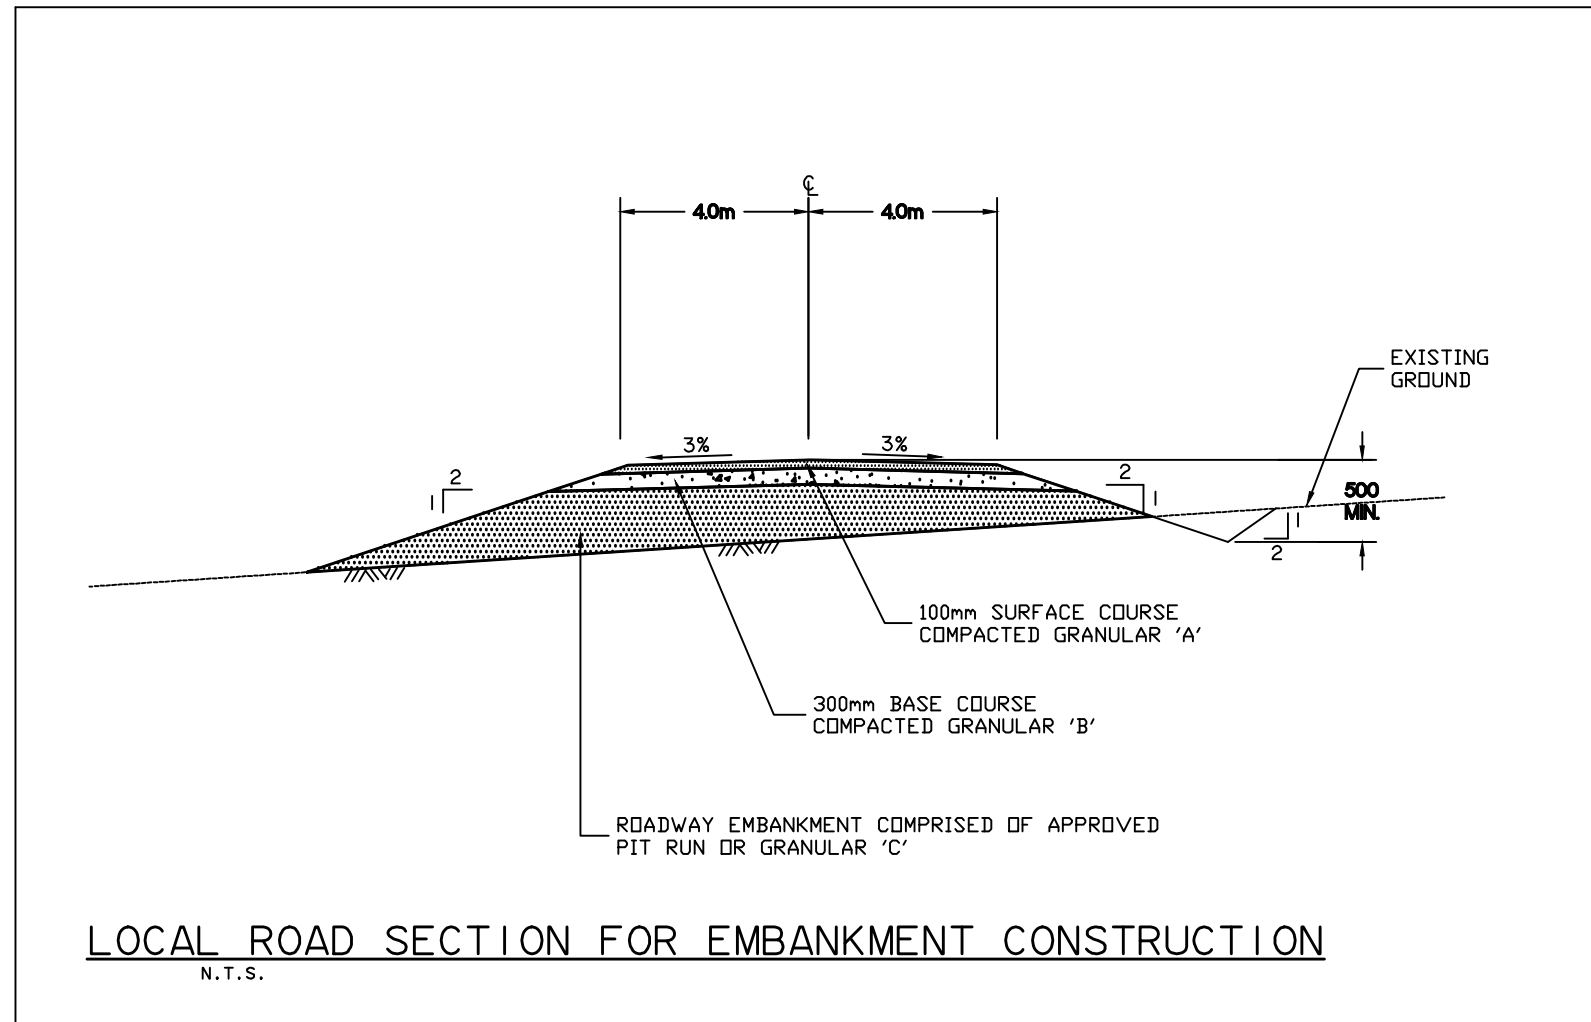

KEY PLAN				

LEGEND				

PERMIT OF PRACTICE
TROW ASSOCIATES INC.
Signature _____
Date _____
PERMIT NUMBER: P184
The Association of Professional Engineers
Geologists and Geophysicists of the NWT/NU

BENCH MARK	
BM 1	ELEV. = 000.00
DESCRIPTION HERE	

No.	DESCRIPTION	DATE	BY	APP'D
5	AS-CONSTRUCTED	17/11/11	MEB	SLB
4	ISSUED FOR CONSTRUCTION	14/09/09	MMR	SLB
3	TENDER SET	27/04/09	MMR	SLB
2	REVISED GUARD RAIL SYSTEM DETAIL	26/01/09	MMR	SLB
1	ISSUED FOR APPROVAL	24/04/08	MMR	SLB

REGISTERED PROFESSIONAL ENGINEER
S.L. BURDEN
LICENSEE
N.W.T.

Trow Associates Inc.
154 Colonnade Road, South
Ottawa, Ont. K2E 7J5
Tel: (613) 225-9940
Fax: (613) 225-7337

CLIENT
GOVERNMENT OF NUNAVUT

PROJECT
**ARCTIC BAY
WASTE WATER LAGOON**

TITLE
ROAD DETAILS

design by	S.A.D.	project no.	OTCD19054A
drawn by	M.M.R.	drawing no.	DE-1
checked by	S.L.B.		
date	14/12/07		
scale	AS SHOWN		