


NOTES  
CONTOUR INFORMATION WAS DERIVED BY TROW ASSOCIATES INC.  
SURVEY DATED AUGUST 23, 2007.  
CONTOUR INTERVALS ARE SET AT 1.00m

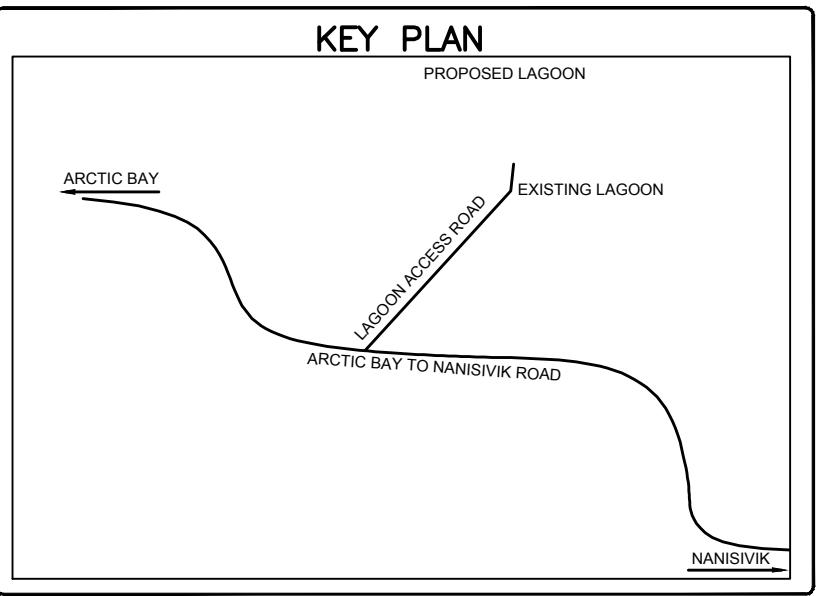

LEGEND

PERMIT OF PRACTICE  
TROW ASSOCIATES INC.

Signature \_\_\_\_\_

Date \_\_\_\_\_


PERMIT NUMBER: P184  
The Association of Professional Engineers  
Geologists and Geophysicists of the NWT/NU

BENCH MARK

BM 1 ELEV. = 000.00

DESCRIPTION HERE

4	AS-CONSTRUCTED	17/11/11	MEB	SLB
3	ISSUED FOR CONSTRUCTION	14/09/09	MMR	SLB
2	TENDER SET	27/04/09	MMR	SLB
1	ISSUED FOR APPROVAL	24/04/08	MMR	SLB
No.	DESCRIPTION	DATE	BY	APP'D
R E V I S I O N S				

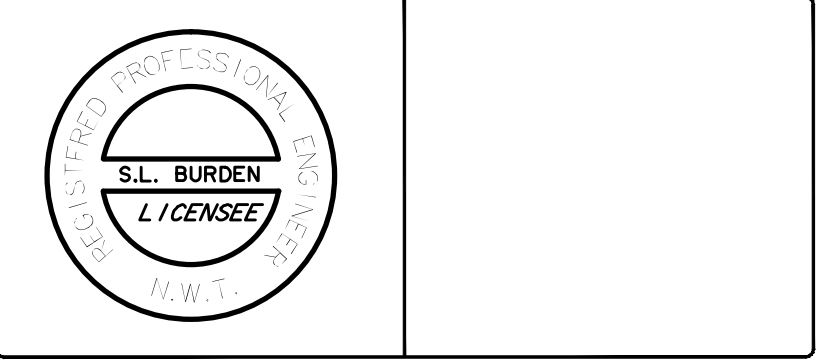

**Trow Associates Inc.**

154 Colonnade Road South  
Ottawa, Ont. K2E 7J5

Tel: (613) 225-9940  
Fax: (613) 225-7337

CLIENT

GOVERNMENT OF NUNAVUT

PROJECT

ARCTIC BAY  
WASTE WATER LAGOON  
ROAD

TITLE

SITE PLAN

design by	S.A.D.	project no.	OTCD000190544
drawn by	M.M.R.	drawing no.	
checked by	S.L.B.		
date	10/09/2007		
scale	HORIZ 1:2000		

SP1