




NORTH BERM DECANTING  
SCALE 1:500

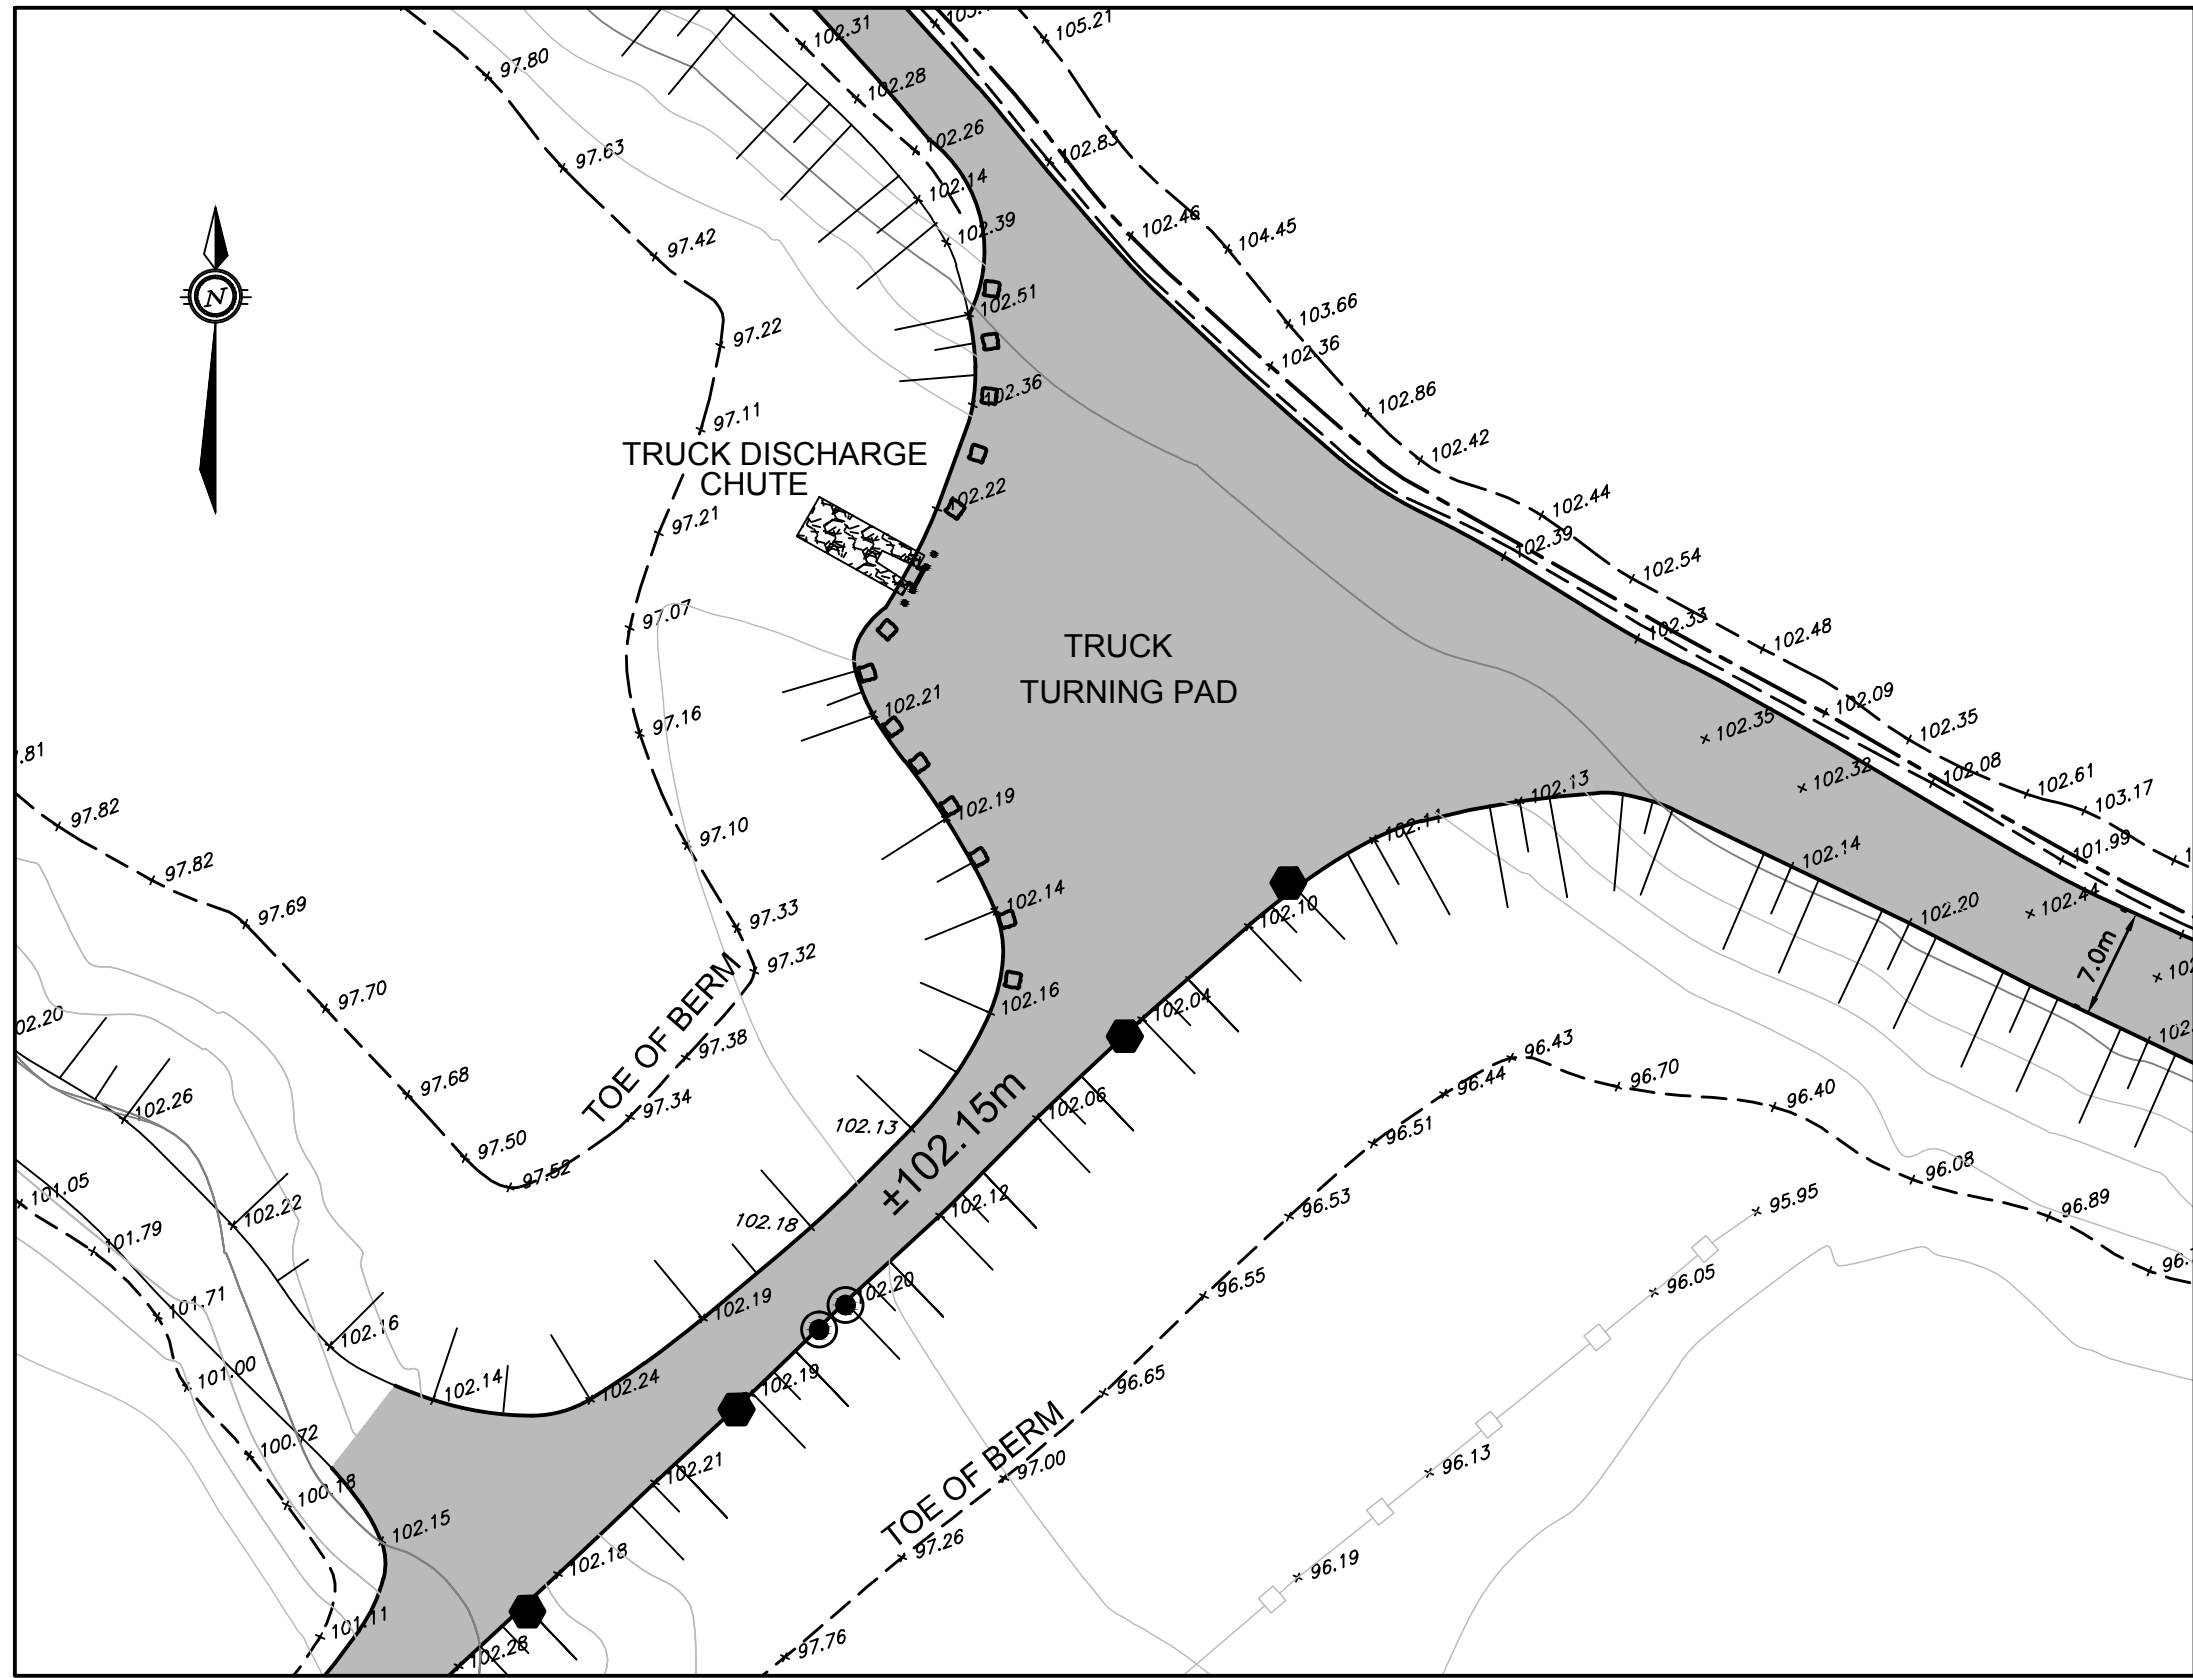


SOUTH BERM TRUCK DISCHARGE  
SCALE 1:500

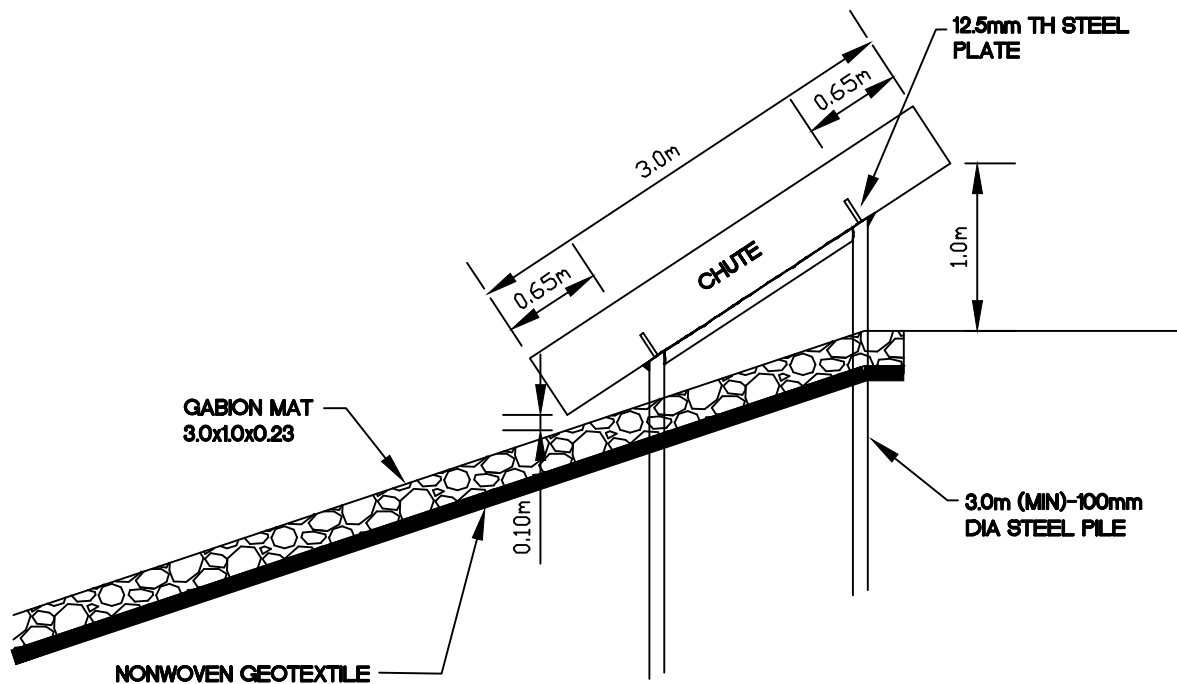


TRUCK DISCHARGE CHUTE  
SECTION VIEW  
SCALE 1:50

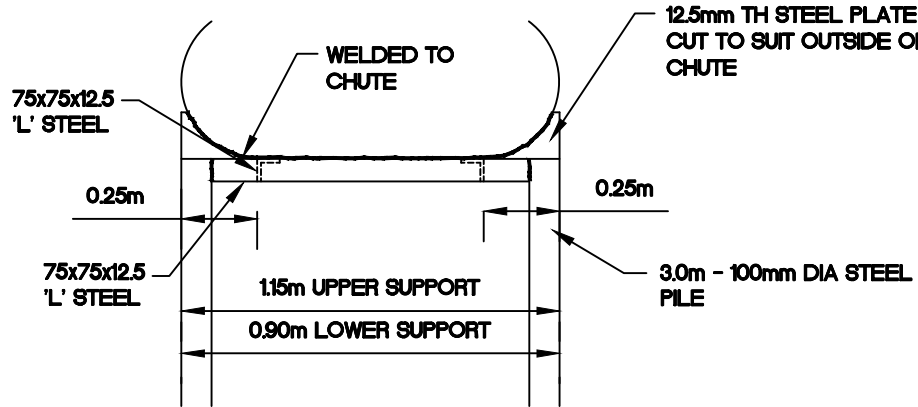


TRUCK DISCHARGE CHUTE  
END VIEW  
SCALE 1:25

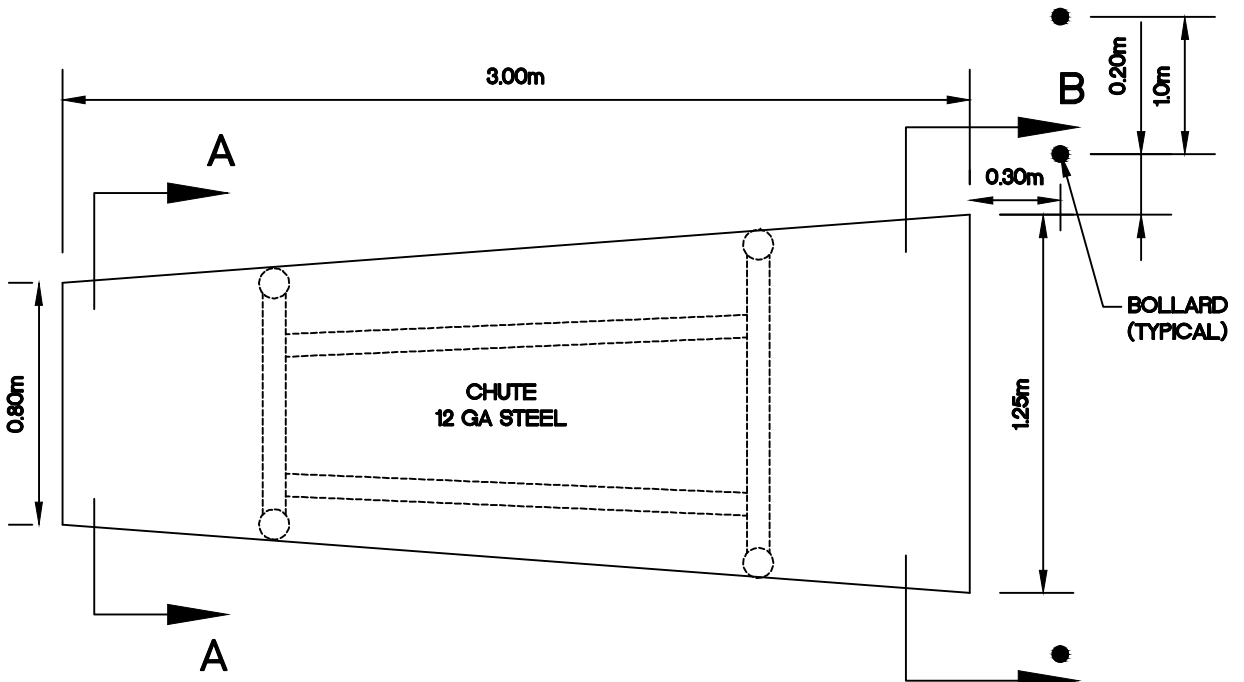


DISCHARGE CHUTE  
PLAN VIEW  
SCALE 1:25

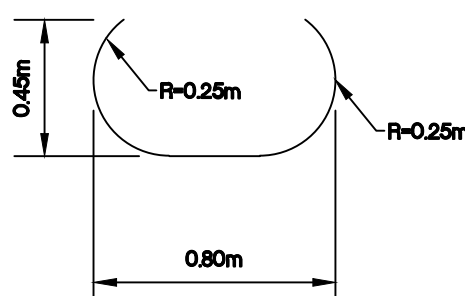

SECTION A-A  
SCALE 1:25

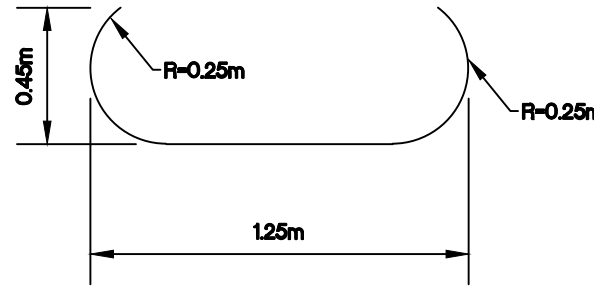


SECTION B-B  
SCALE 1:25

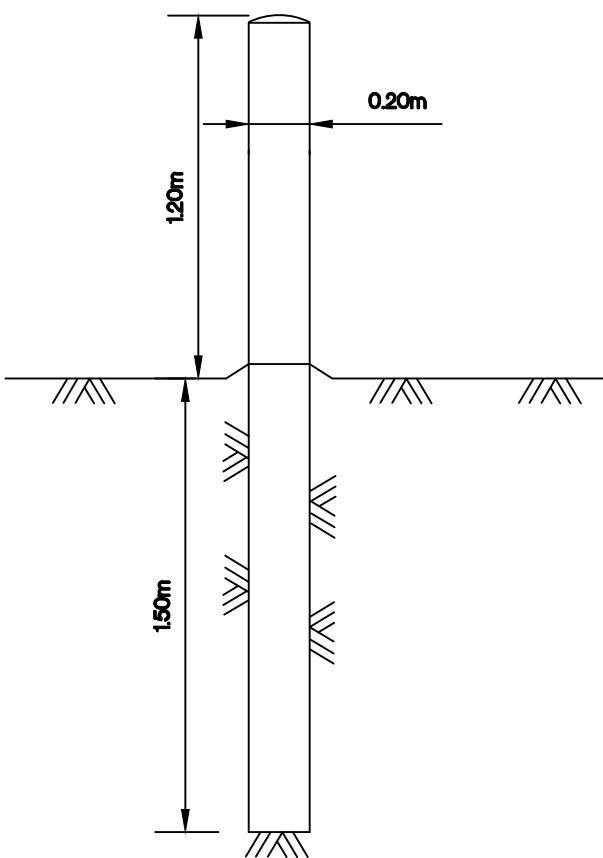

BOLLARD DETAIL  
SCALE 1:25

TRUCK DISCHARGE CHUTE DETAIL

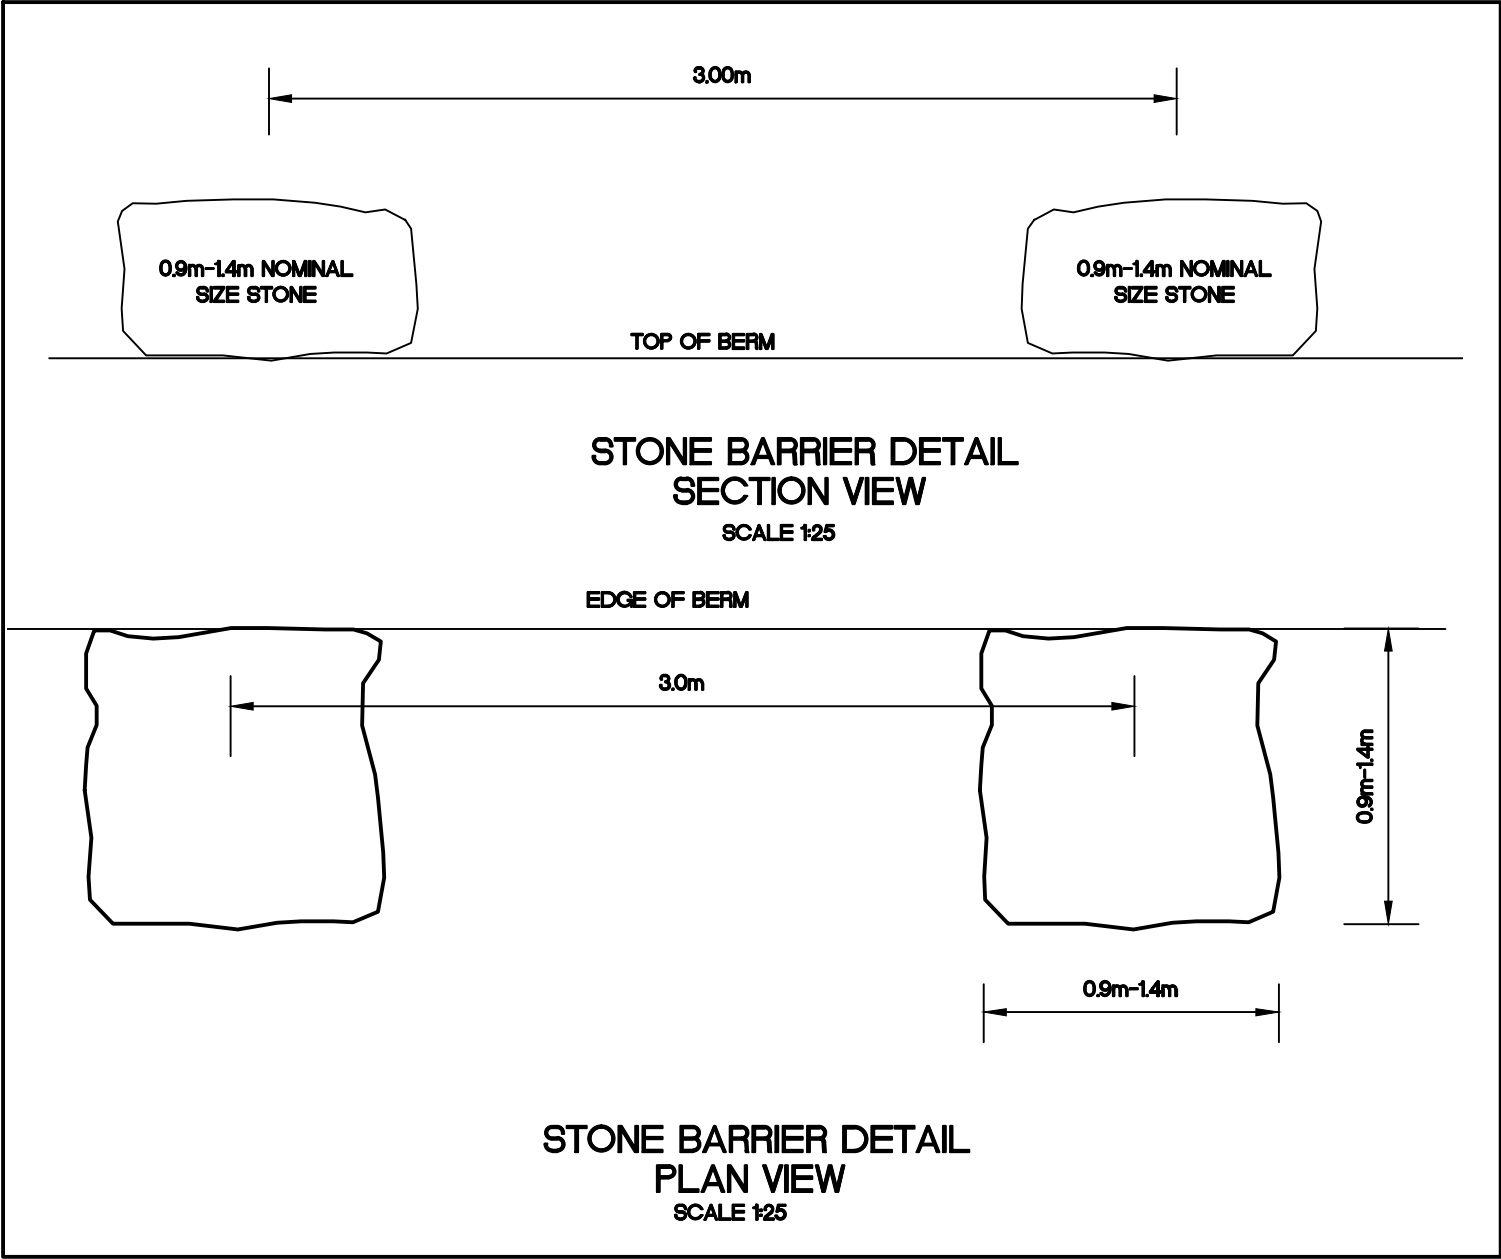

STONE BARRIER DETAIL  
PLAN VIEW  
SCALE 1:25

KEY PLAN


LEGEND

PERMIT OF PRACTICE  
TROW ASSOCIATES INC.  
Signature \_\_\_\_\_  
Date \_\_\_\_\_  
PERMIT NUMBER: P184  
The Association of Professional Engineers  
Geologists and Geophysicists of the NWT/NU

BENCH MARK

BM 1 ELEV. = 59.12  
CONTOUR ELEVATIONS WERE DREWN FROM NAD 83 CONTROL  
MONUMENT 7038914 LOCATED NORTH OF THE ARCTIC BAY  
AIRPORT UNDER CONSTRUCTION.

No.	DESCRIPTION	DATE	BY	APP'D
3	AS-CONSTRUCTED	17/11/11	MEB	SLB
2	TENDER SET	27/04/09	MMR	SLB
1	ISSUED FOR APPROVAL	24/04/08	MMR	SLB

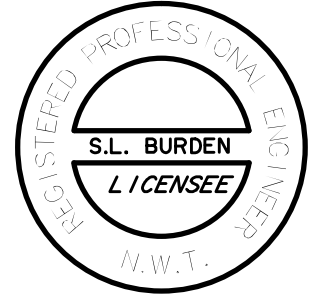

Trow Associates Inc.  
154 Colonnade Road South  
Ottawa, Ont. K2E 7J5  
Tel: (613) 225-9940  
Fax: (613) 225-7337

CLIENT  
GOVERNMENT OF NUNAVUT

PROJECT  
ARCTIC BAY WASTEWATER LAGOON

TITLE  
LOCATION PLAN FOR  
TRUCK DISCHARGE AND  
DECANTING

design by	SAD	project no.	OTCD000190544
drawn by	MEB	drawing no.	
checked by	SLB		
date	15/01/2008		
scale	HORIZ 1:500		

TD-1