

LEGEND

PERMIT OF PRACTICE
TROW ASSOCIATES INC.







Signature _____
Date _____

PERMIT NUMBER P184
The Association of Professional Engineers
Geologists and Geophysicists of the NWT/NU

BENCH MARK
BM 1 ELEV. = 59.12
CONTOUR ELEVATIONS WERE DRENNED FROM NAD 83 CONTROL MONUMENT 7038914 LOCATED NORTH OF THE ARCTIC BAY AIRPORT UNDER CONSTRUCTION.

No.	DESCRIPTION	DATE	BY	APP'D
3	AS-CONSTRUCTED	17/11/11	MEB	SLB
2	TENDER SET	27/04/09	MMR	SLB
1	ISSUED FOR APPROVAL	24/04/08	MMR	SLB

REVISIONS

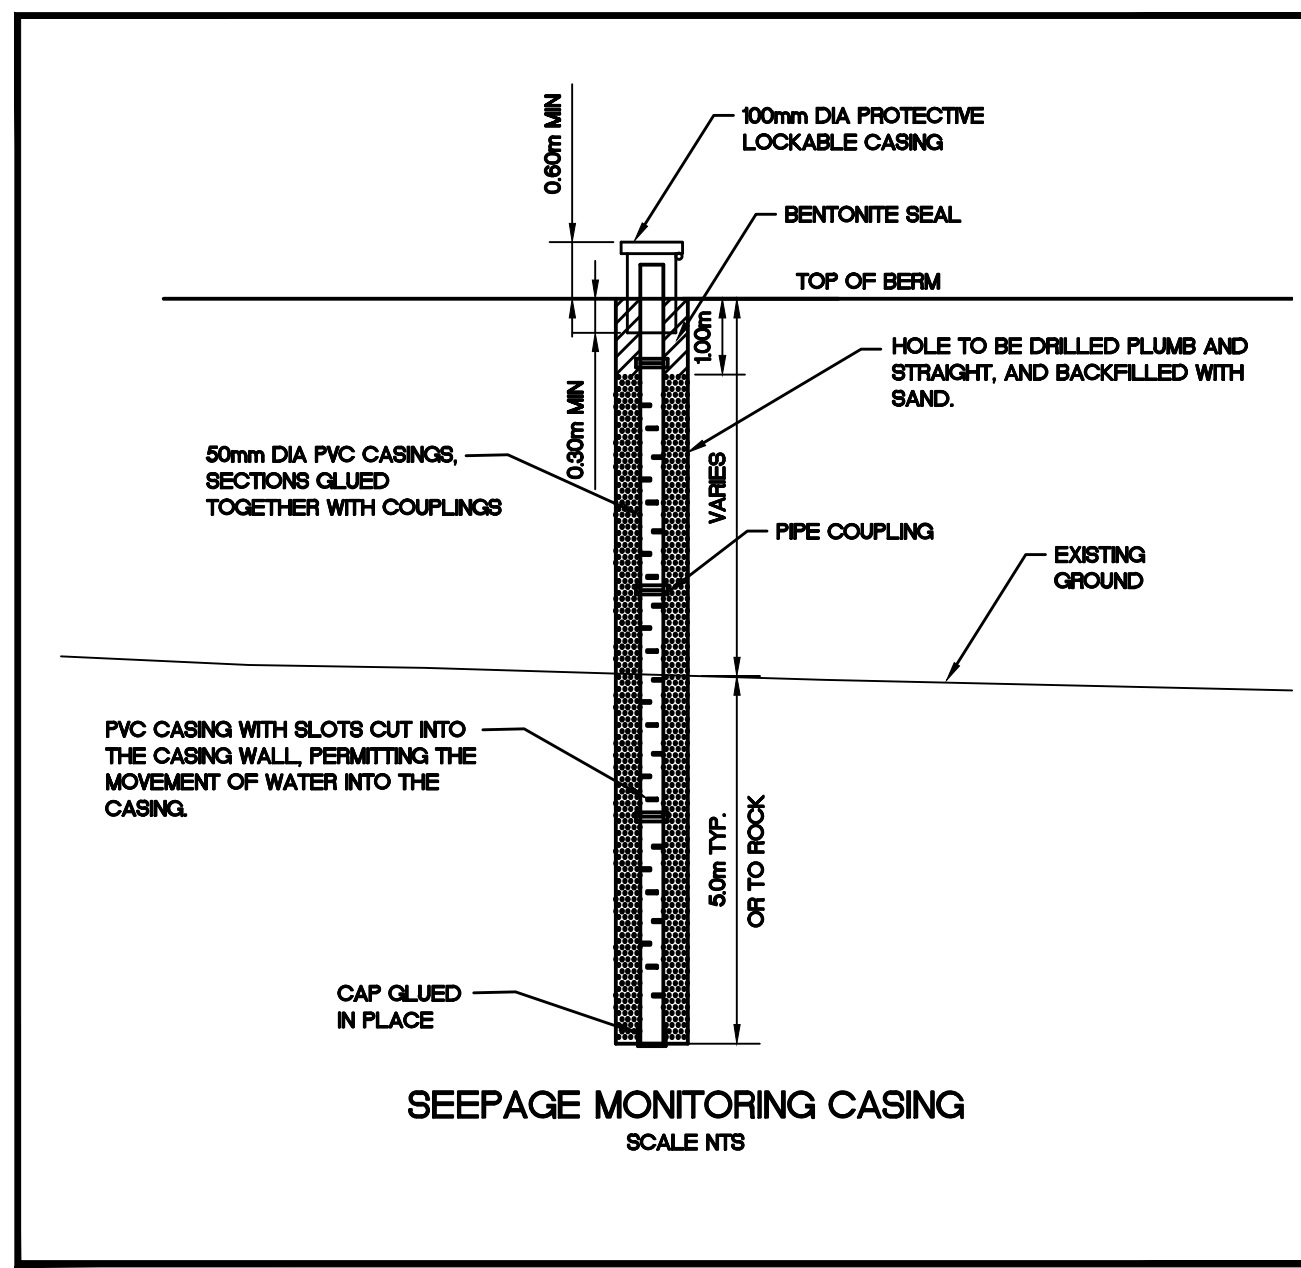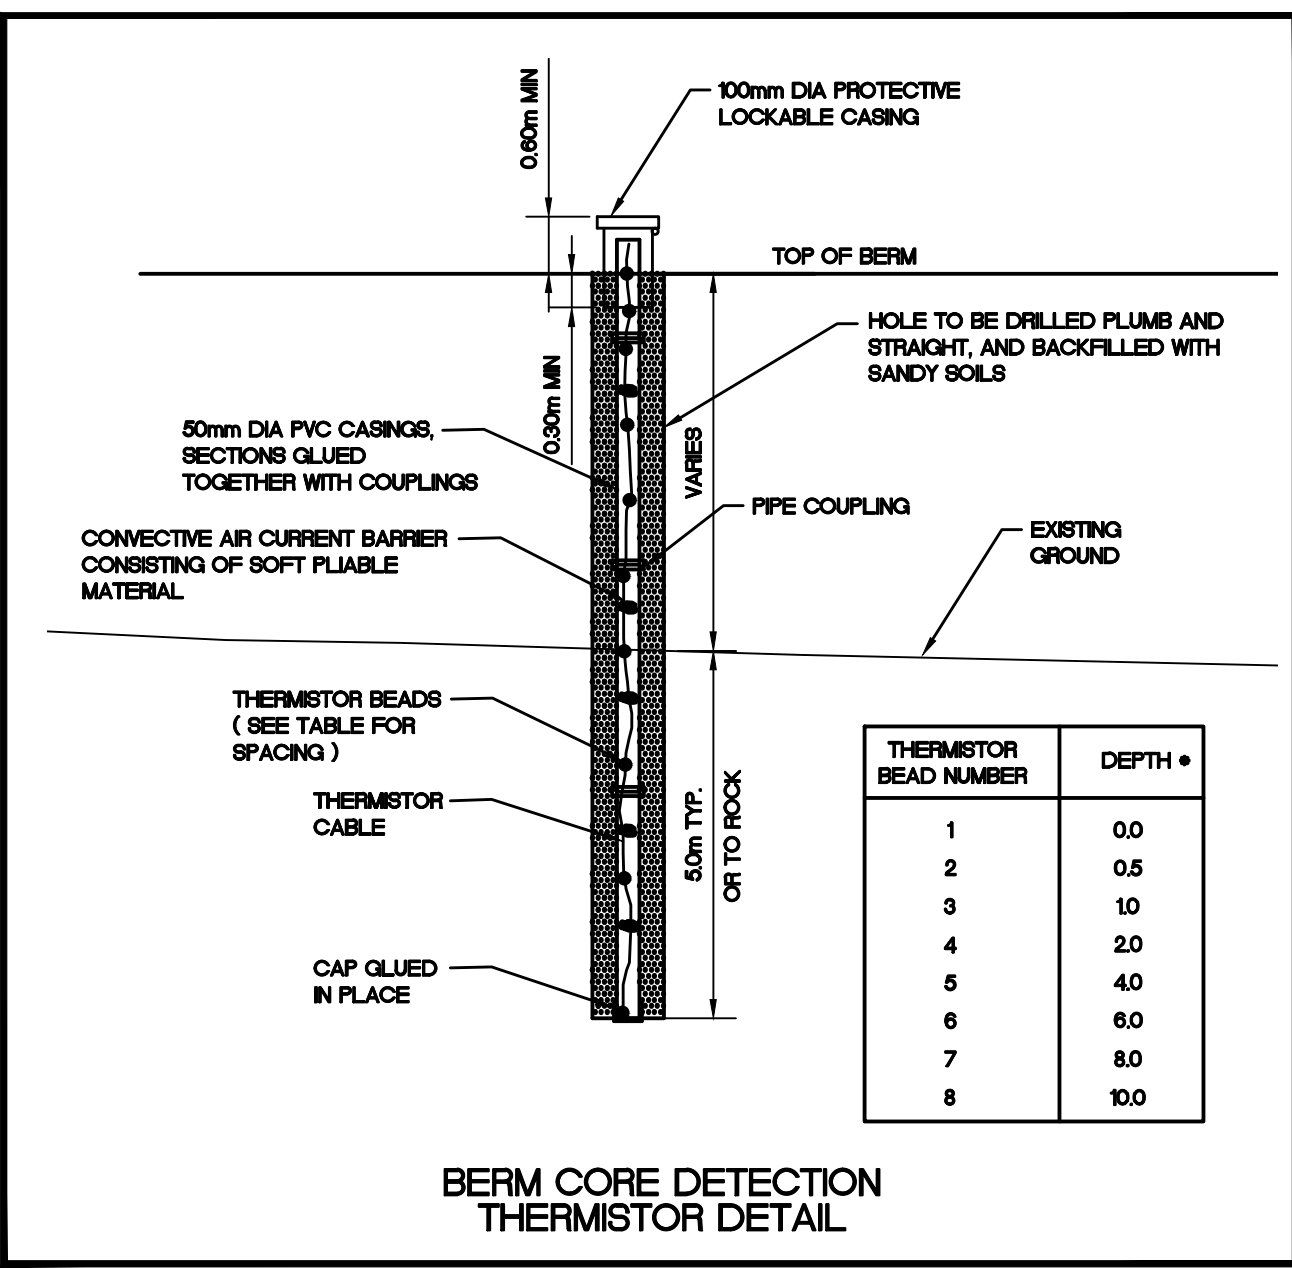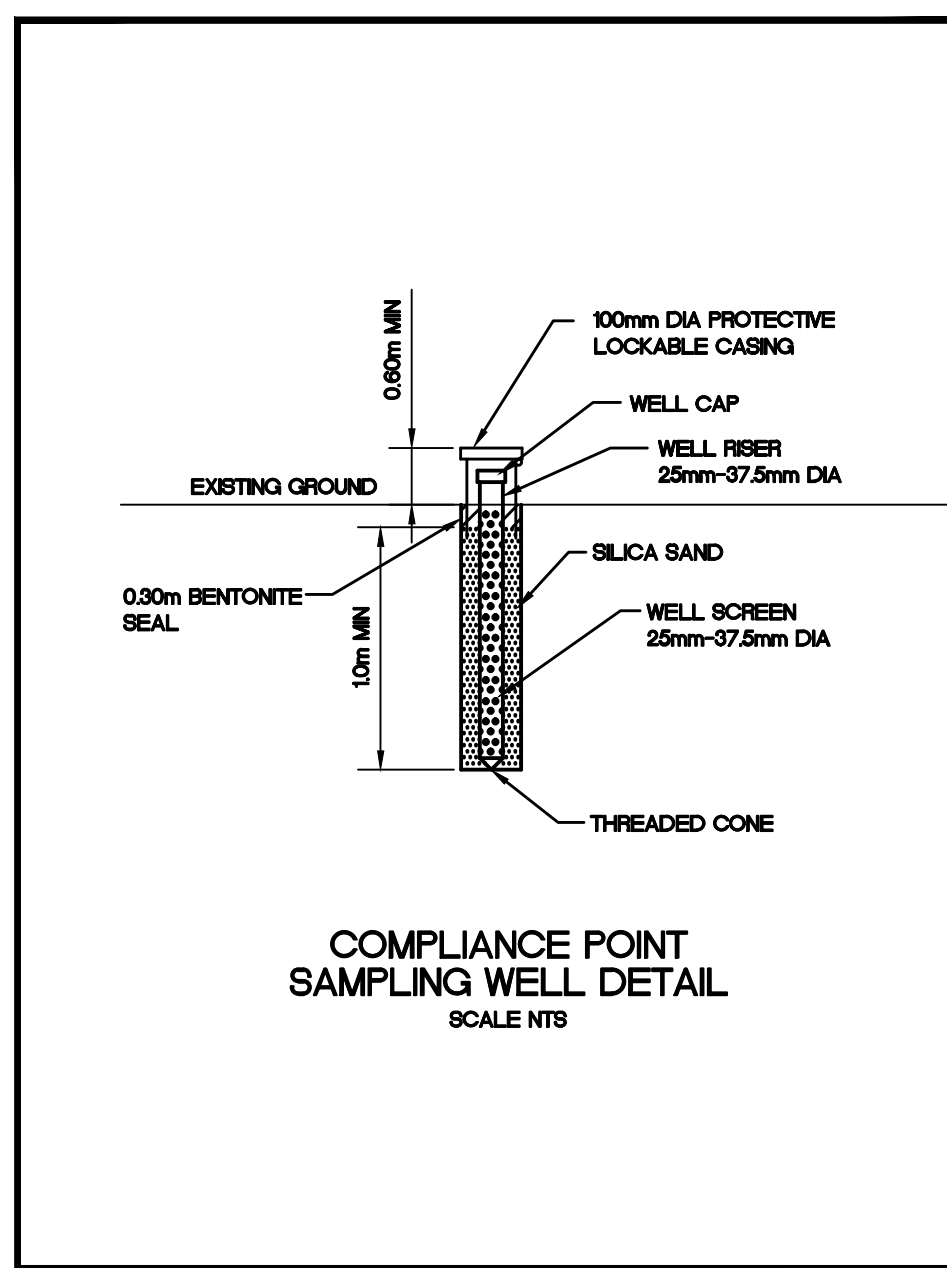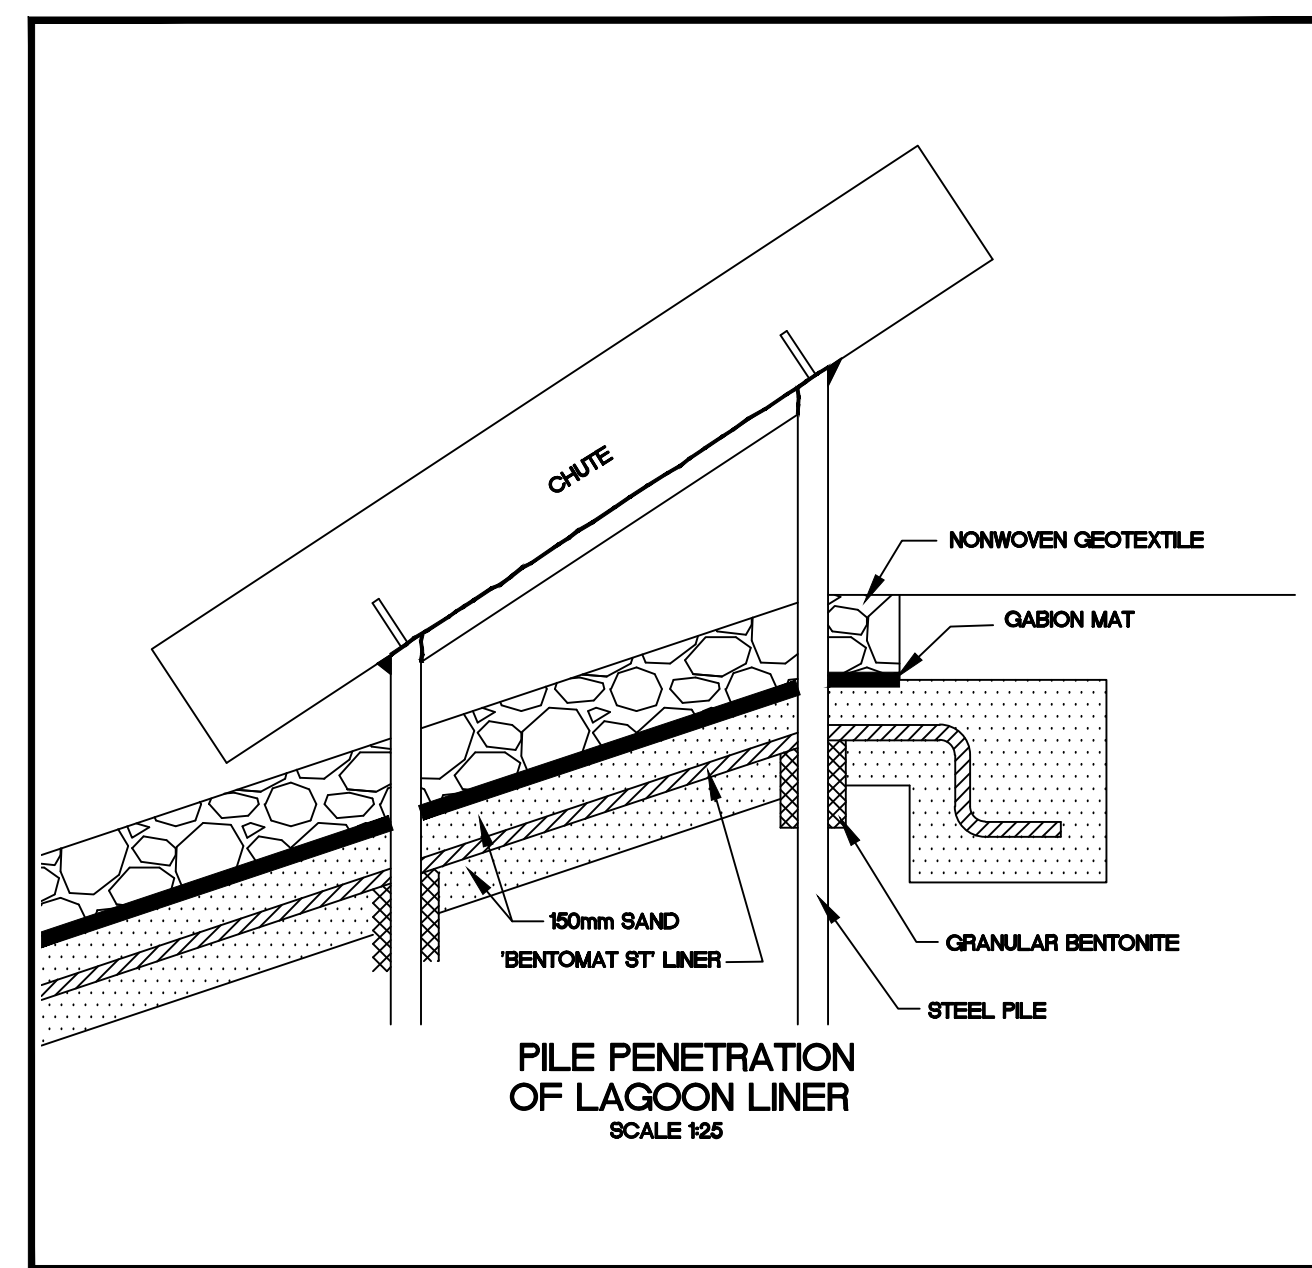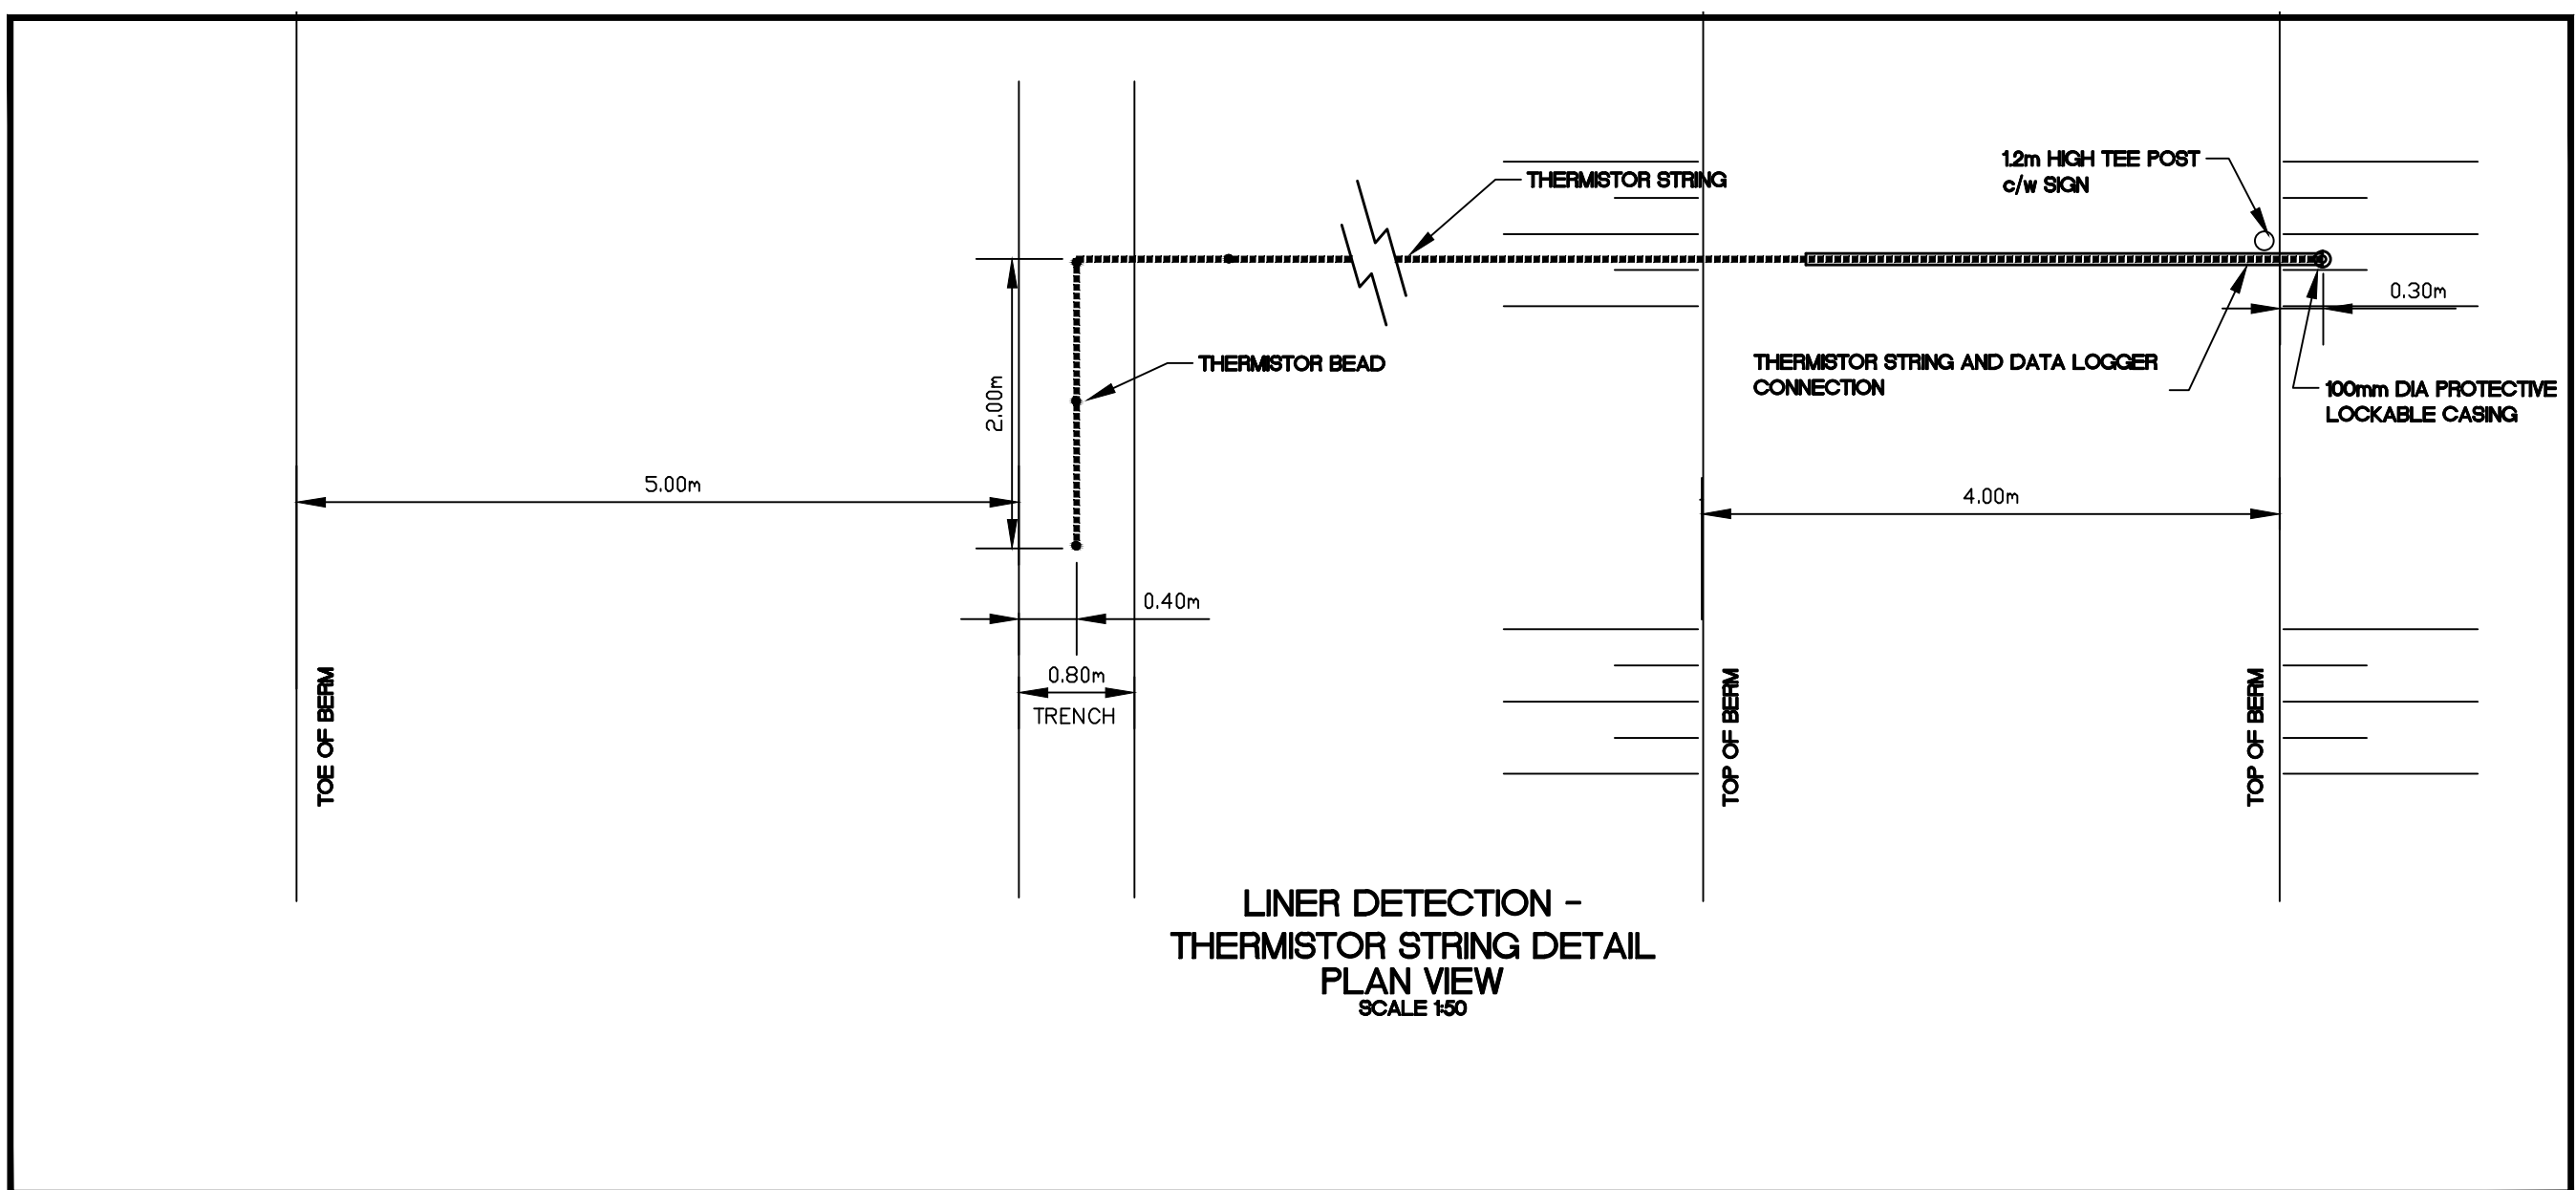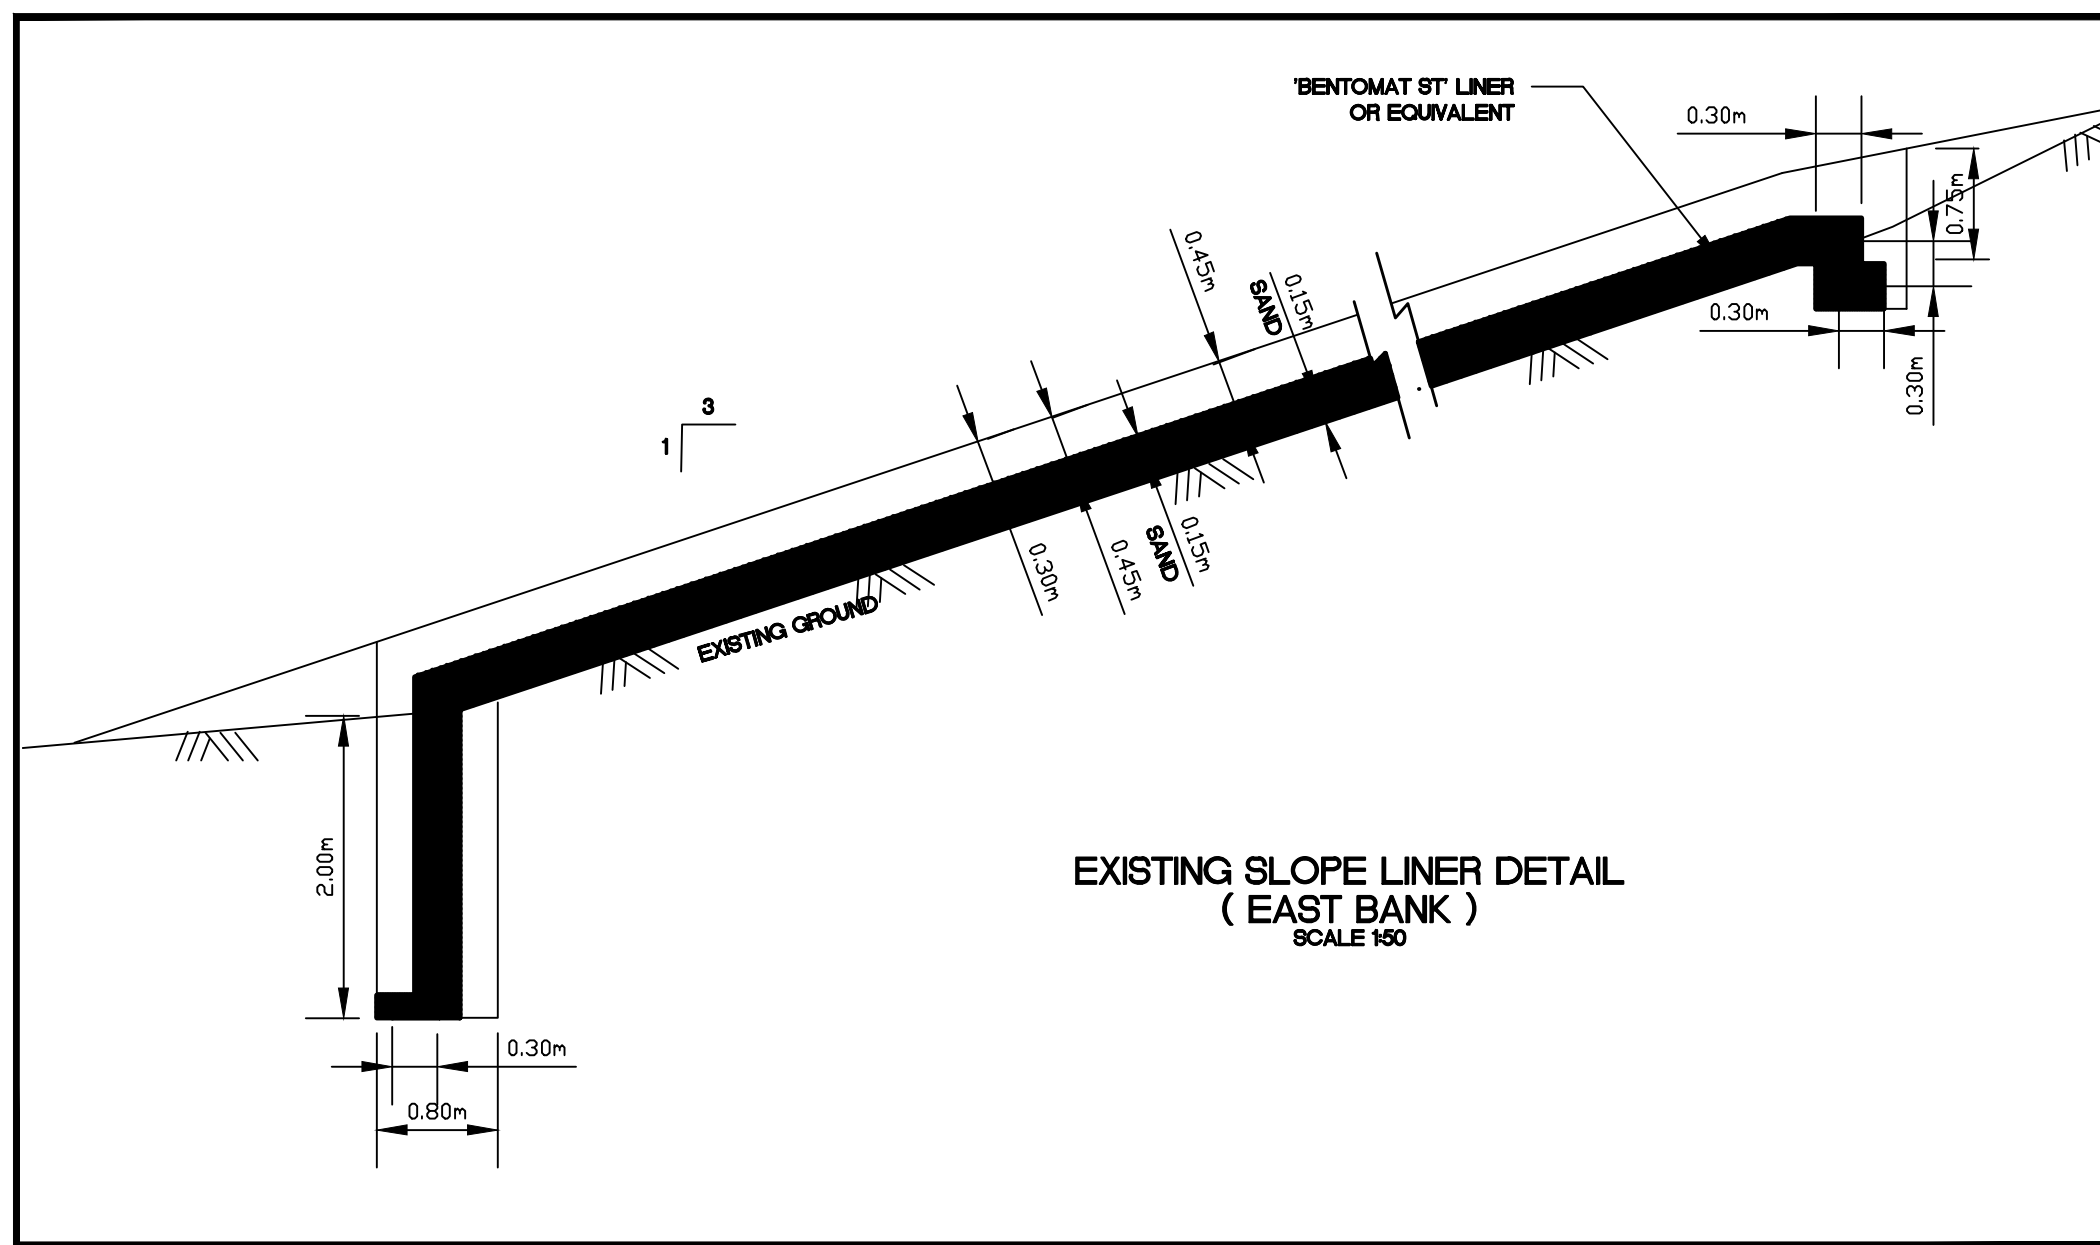

REGISTERED PROFESSIONAL ENGINEER
S.L. BURDEN
LICENSEE
N.W.T.

Trow Associates Inc.
154 Colonnade Road South
Ottawa, Ont. K2E 7J5
Tel: (613) 225-9940
Fax: (613) 225-7337

CLIENT
GOVERNMENT OF NUNAVUT

PROJECT
ARCTIC BAY WASTEWATER LAGOON

TITLE
DETAILS

design by SAD **project no.** OTC000190544
drawn by MEB **drawing no.**
checked by SLB
date 15/01/2008
scale

DE-2