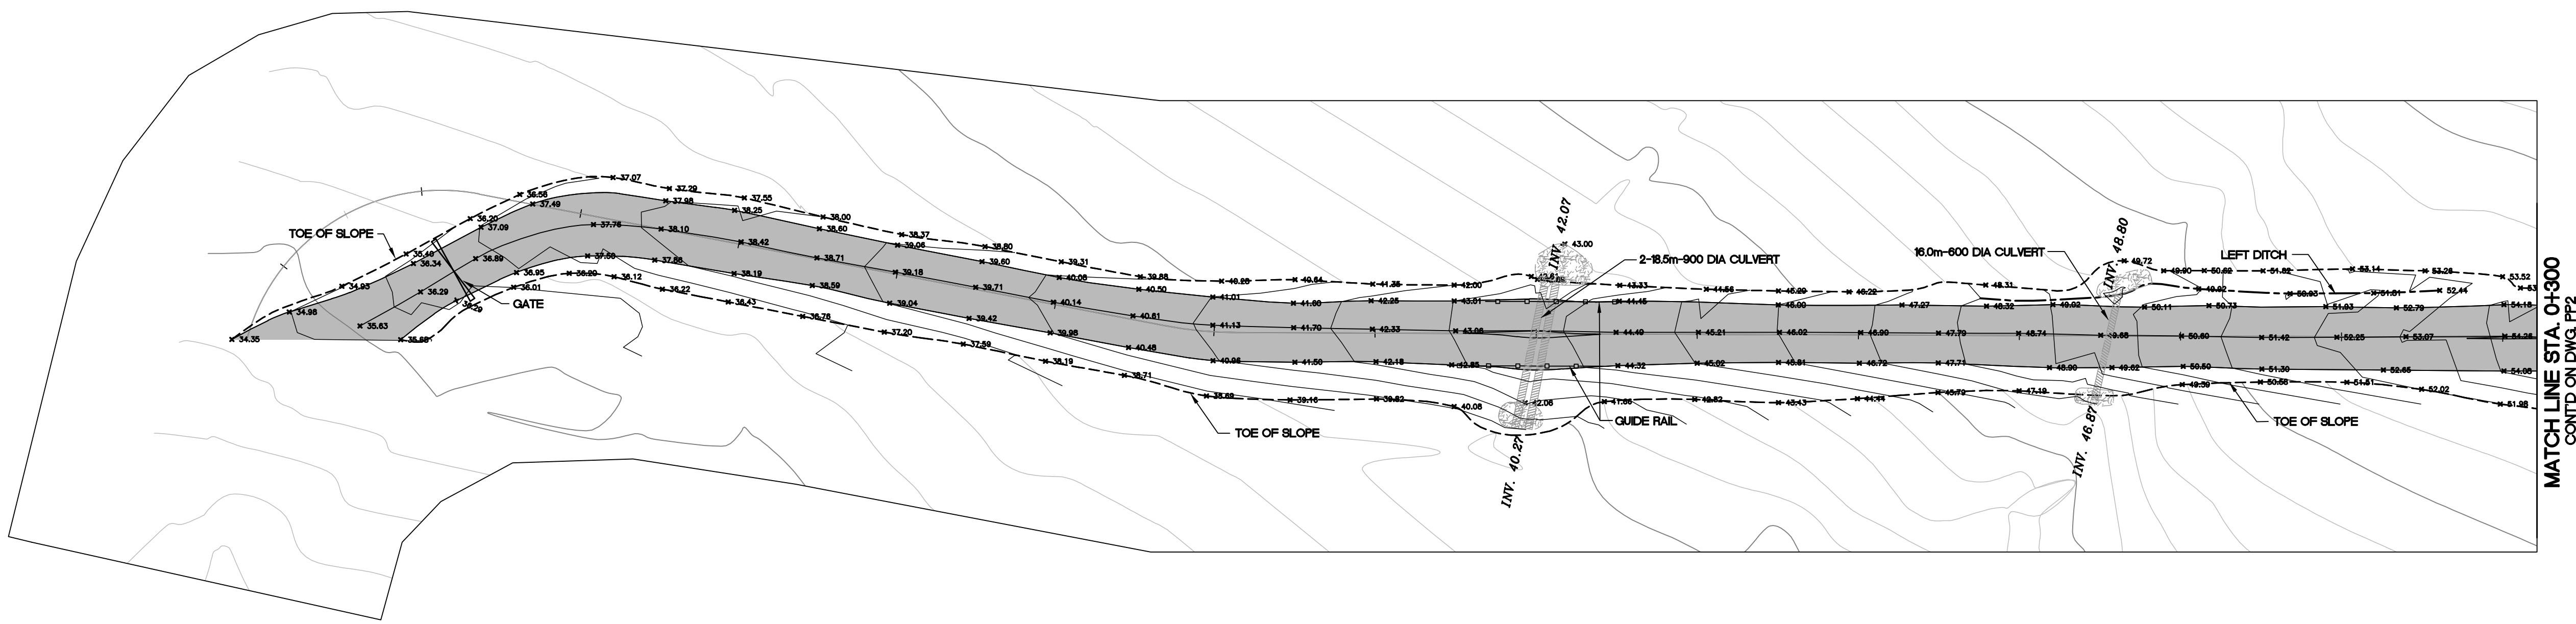


KEY PLAN


LEGEND

PERMIT OF PRACTICE
TROW ASSOCIATES INC.
Signature _____
Date _____
PERMIT NUMBER: P184
The Association of Professional Engineers
Geologists and Geophysicists of the NW7/NU

BENCH MARK

BM 1
DESCRIPTION HERE
ELEV. = 000.00

No.	DESCRIPTION	DATE	BY	APP'D
4	AS-CONSTRUCTED	17/11/11	MEB	SLB
3	ISSUED FOR CONSTRUCTION	14/09/09	MMR	SLB
2	TENDER SET	27/04/09	MMR	SLB
1	ISSUED FOR APPROVAL	24/04/08	MMR	SLB

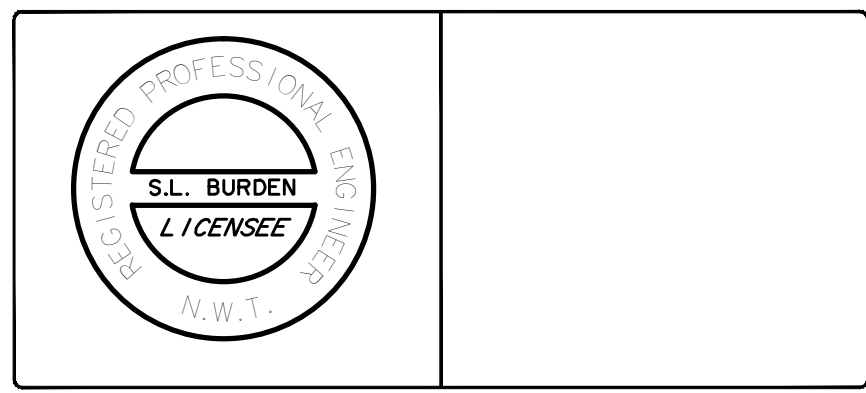


Trow Associates Inc.
154 Colonnade Road South
Ottawa, Ont. K2E 7J5
Tel: (613) 225-9940
Fax: (613) 225-7337

GOVERNMENT OF NUNAVUT

PROJECT
ARCTIC BAY
WASTE WATER
LAGOON ROAD

TITLE ACCESS ROAD PLAN & PROFILE STA. 0+000 TO STA. 0+300	
design by S.A.D.	project no. OTCD19054A
drawn by M.M.R.	drawing no. PP1
checked by S.L.B.	
date 21/04/08	
scale HORIZ 1:500 VERT 1:50	

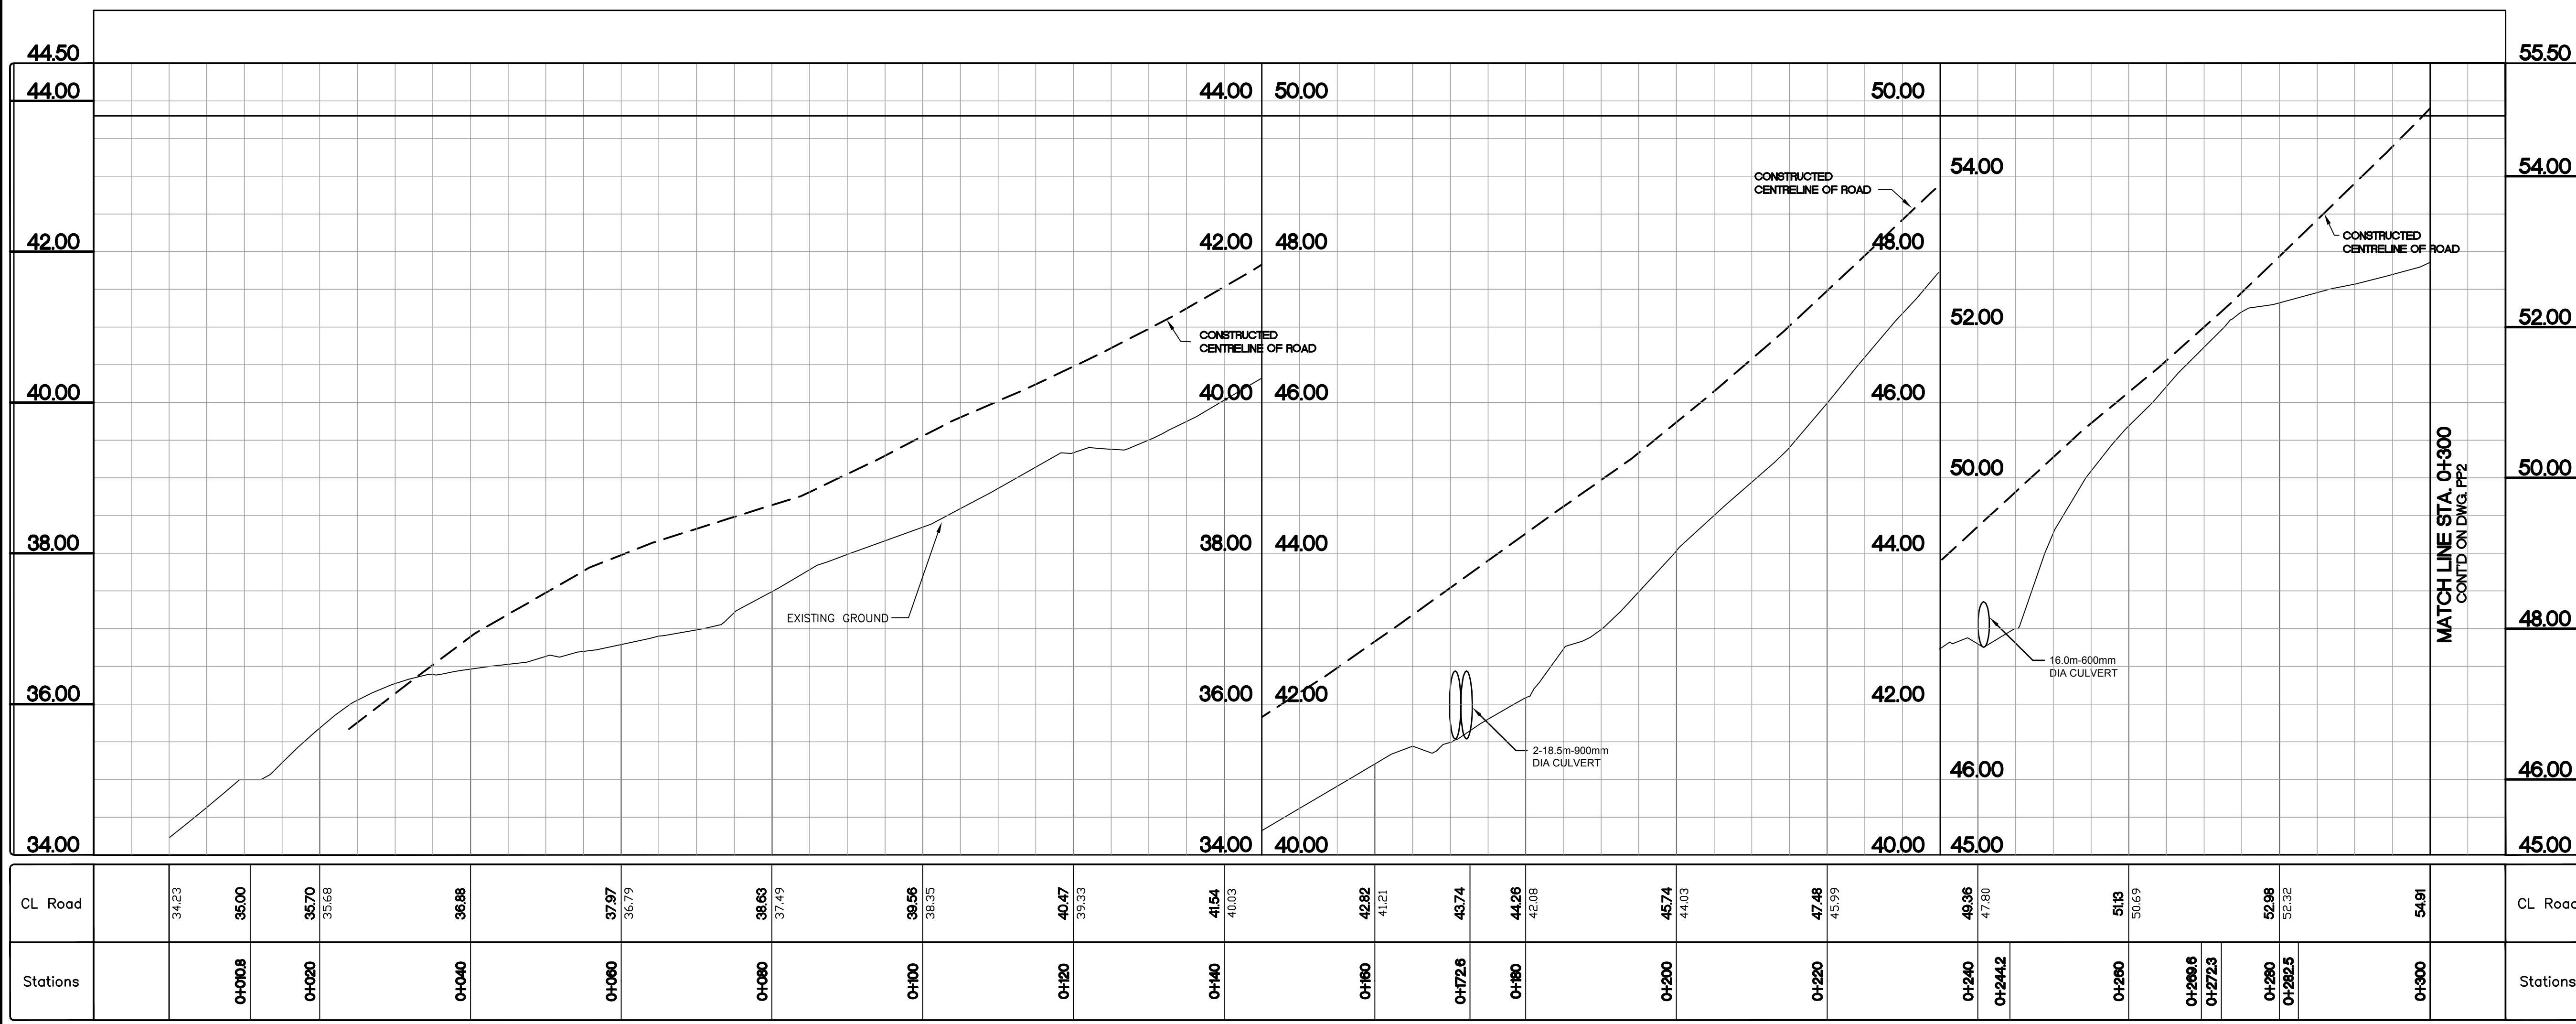

CL Road		34.23																				CL Road																																																																																												
Stations			0+008	35.00		0+020	35.70	35.68		0+040	36.88				0+060	37.97	36.79		0+080	38.63	37.49				0+100	39.56	38.35				0+120	40.47	39.33				0+140	41.54	40.03				0+160	42.82	41.21				0+172.6	43.74			0+180	44.26	42.68				0+200	45.74	44.03				0+220	47.48	45.99				0+240	49.36	47.80		0+244.2						0+260	51.3	50.69			0+266.6		0+272.3				0+280	52.98	52.32				0+282.5					0+300	54.91										Stations