
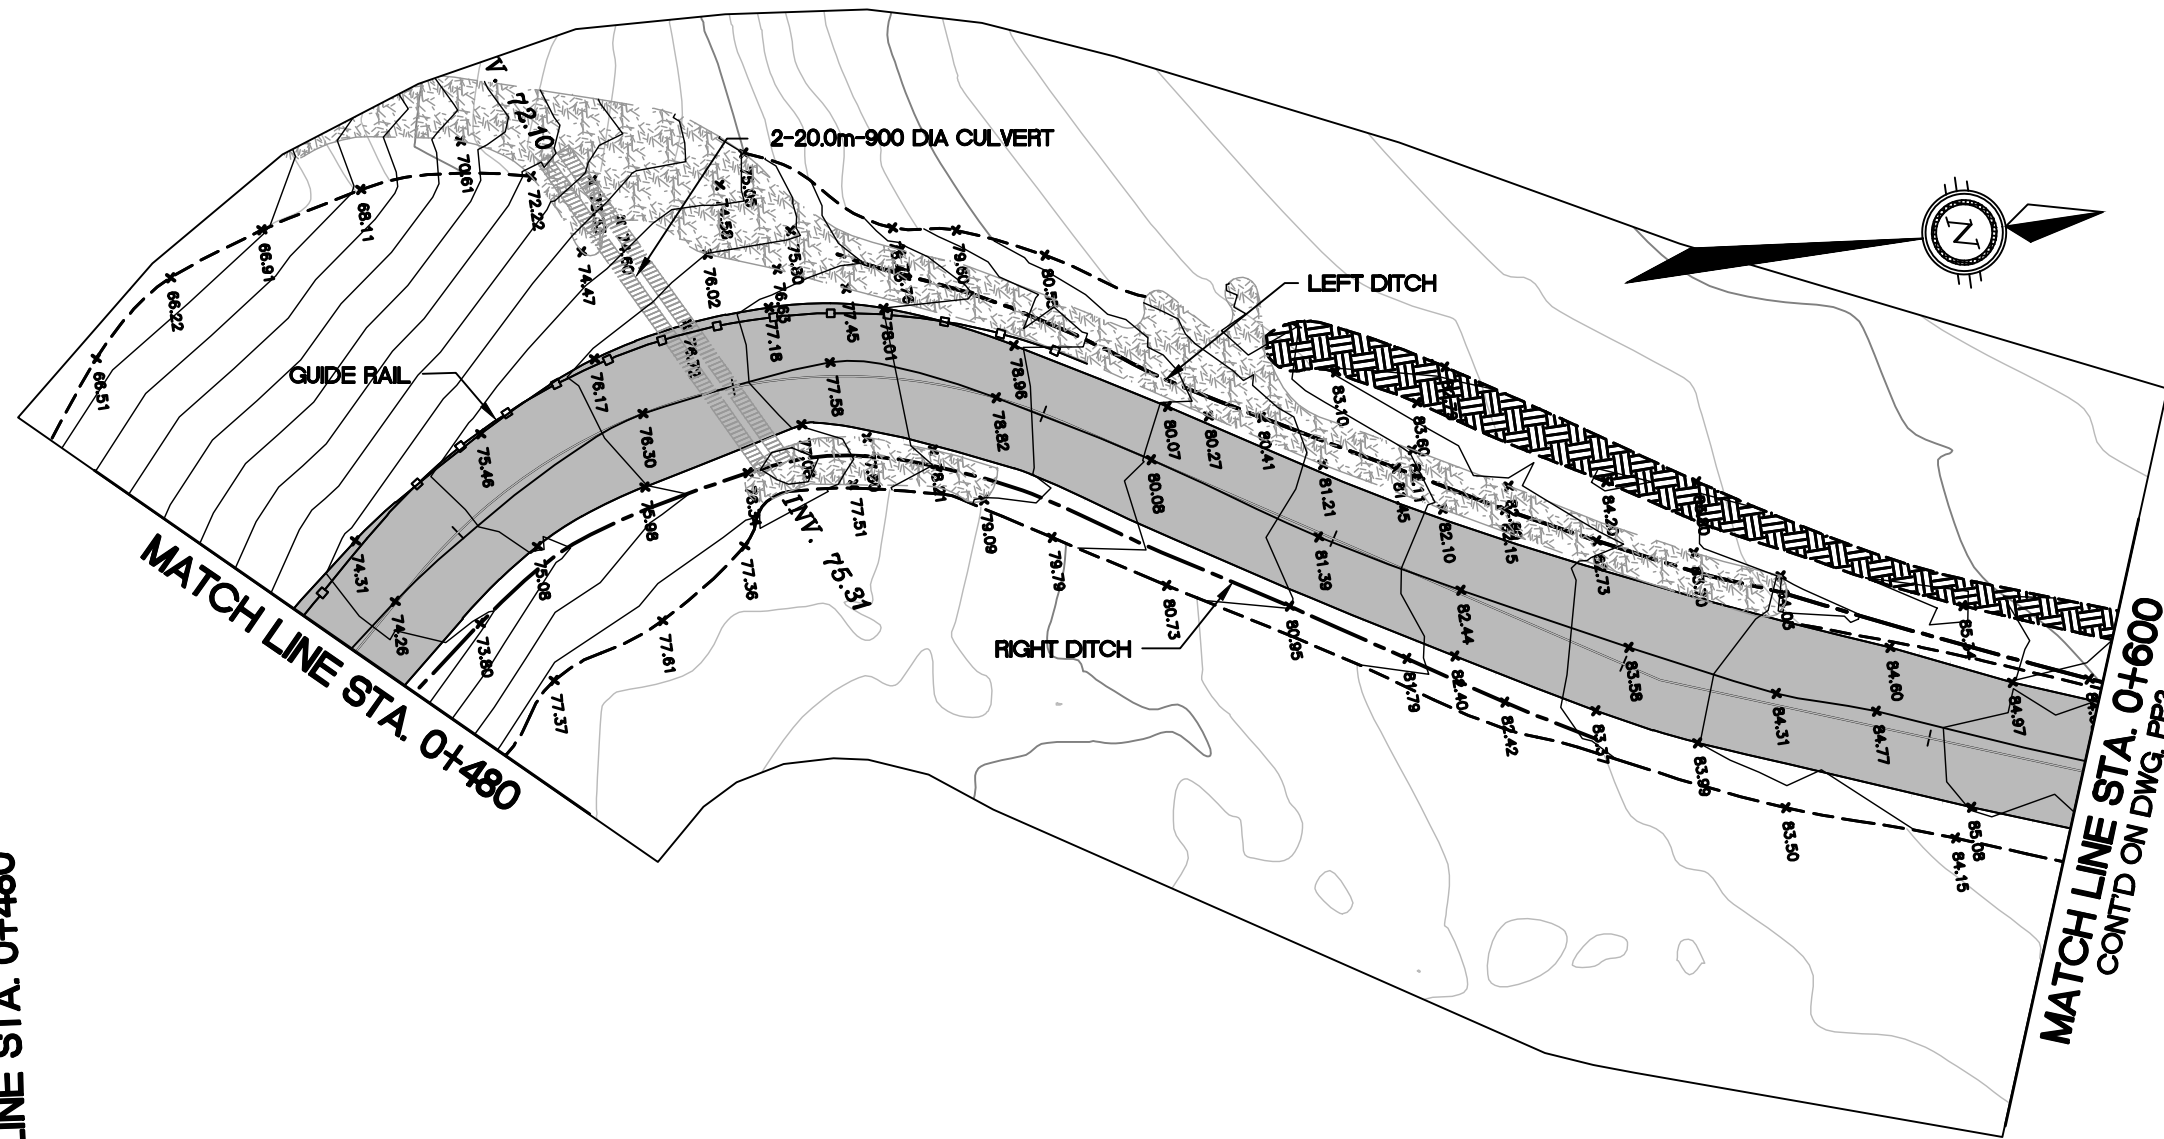


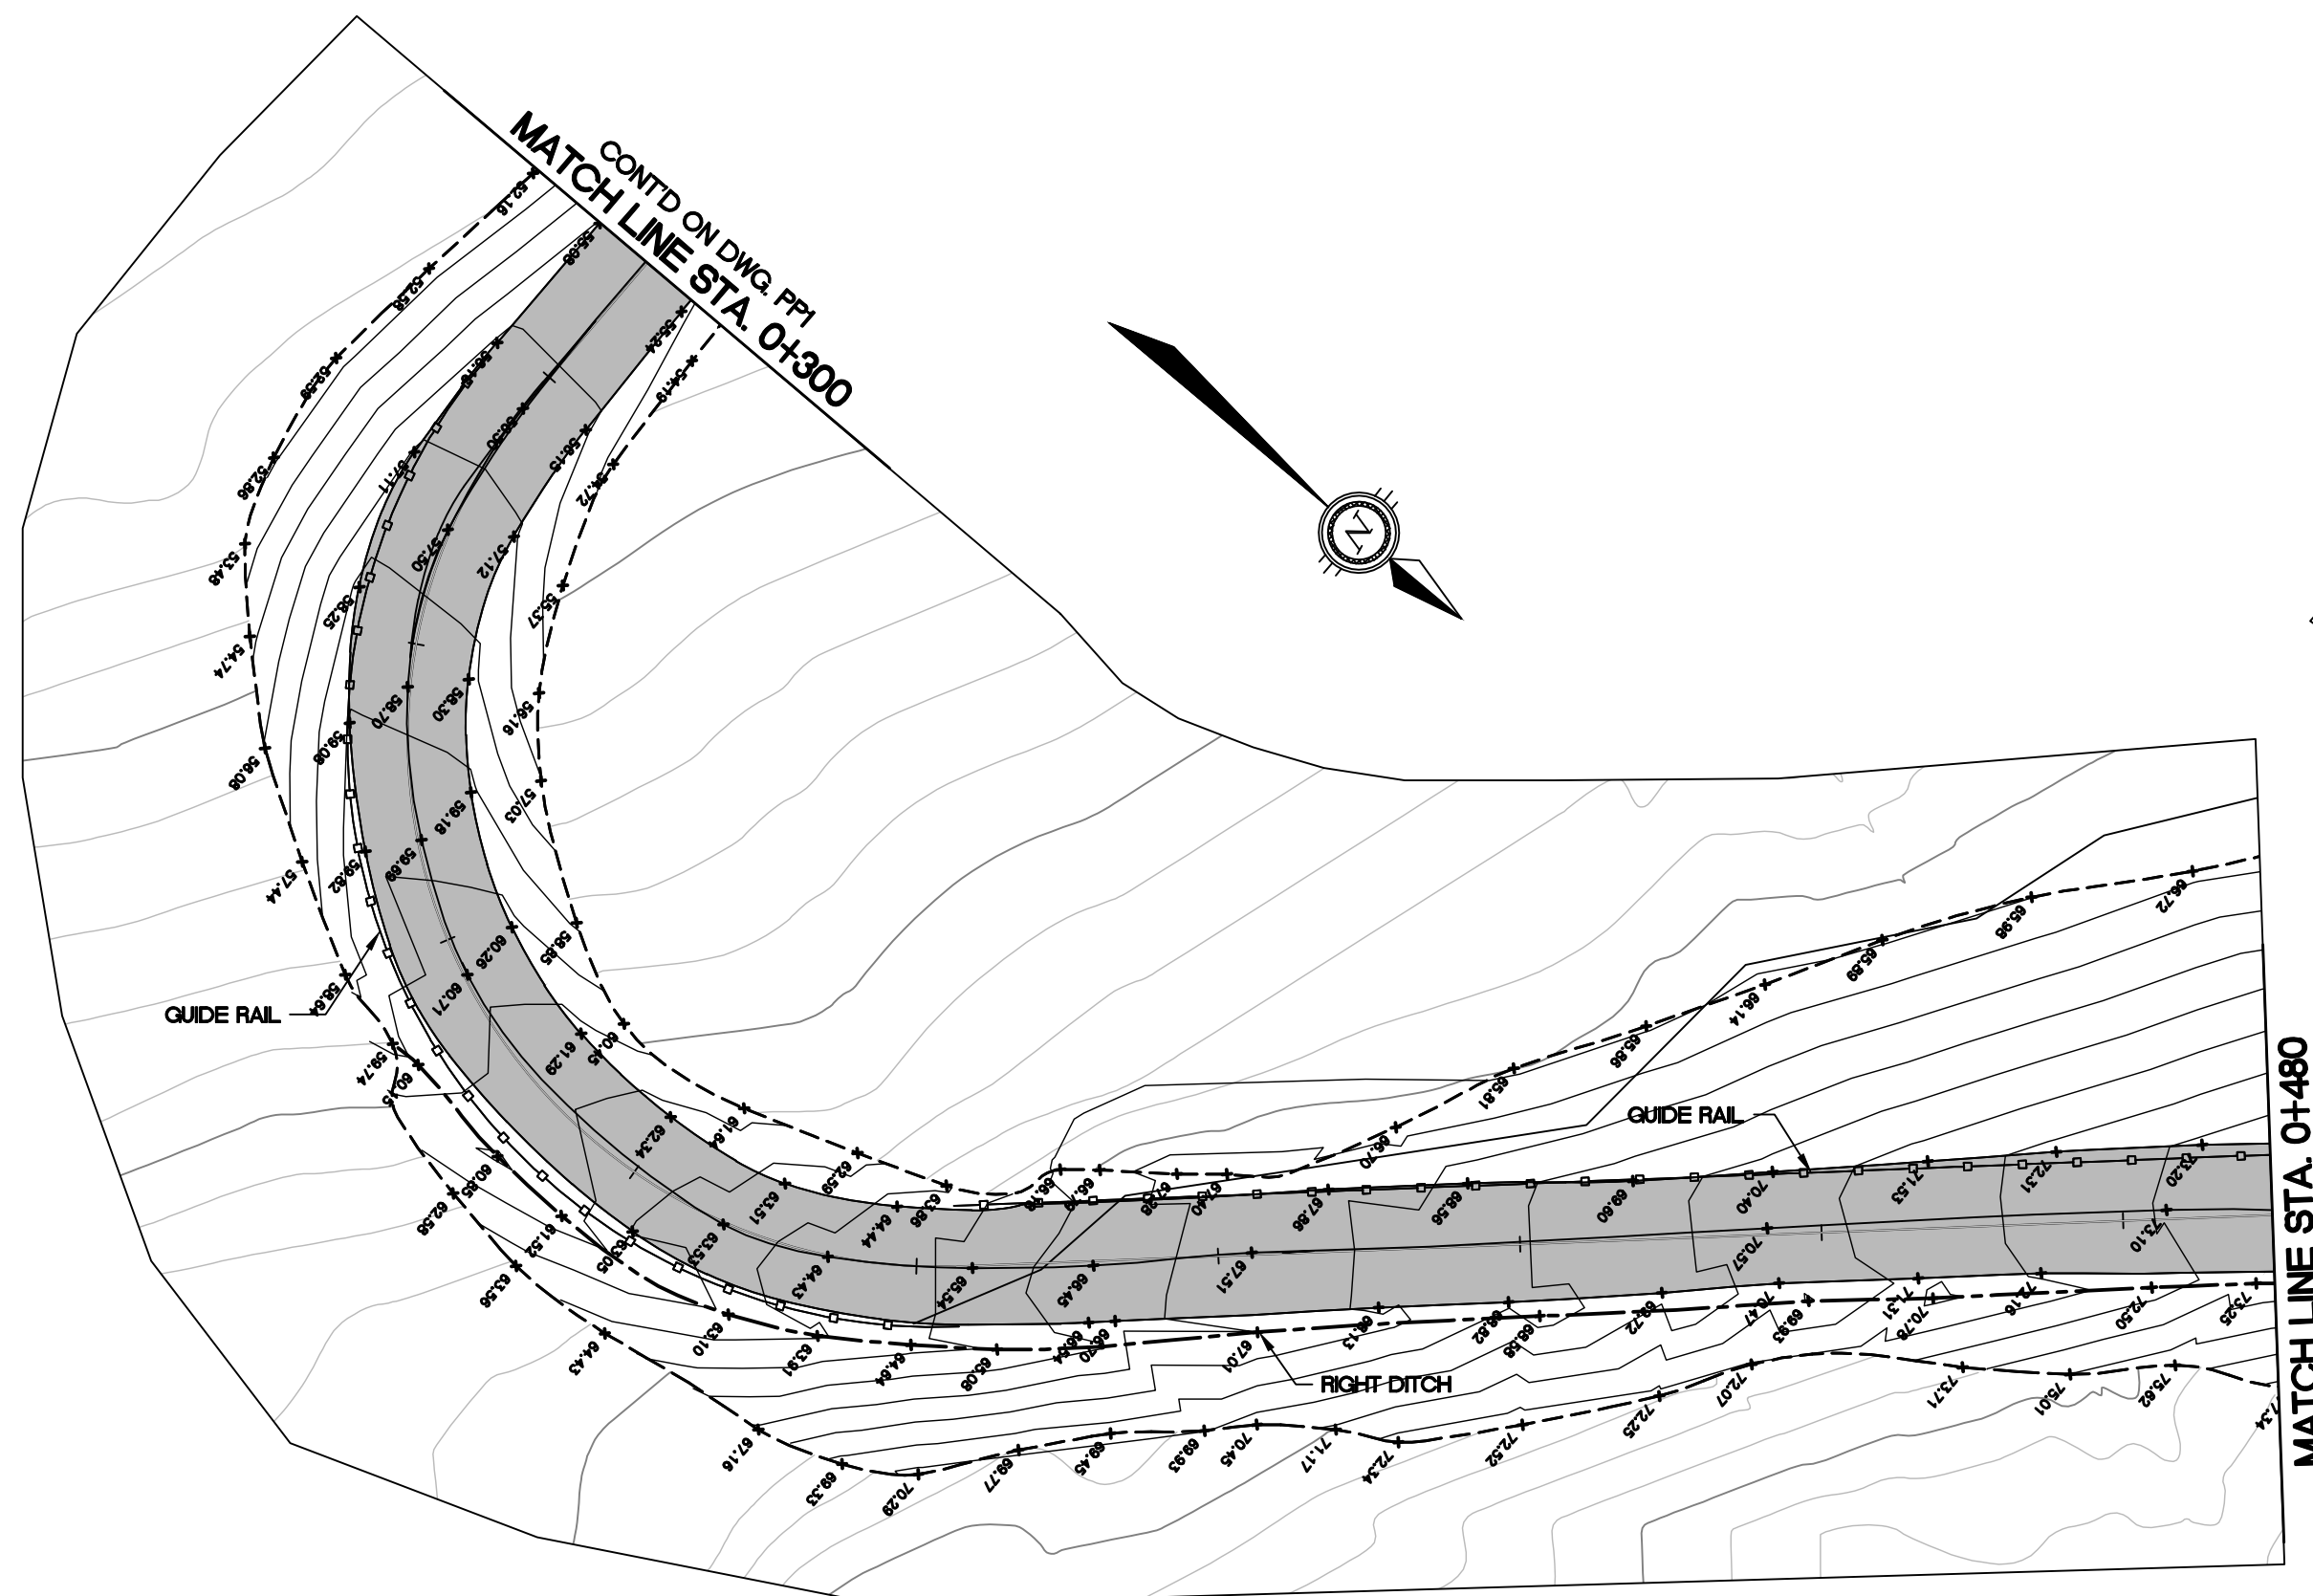

KEY PLAN


LEGEND

PERMIT OF PRACTICE  
TROW ASSOCIATES INC.  
Signature \_\_\_\_\_  
Date \_\_\_\_\_  
PERMIT NUMBER: PB84  
The Association of Professional Engineers  
Geologists and Geophysicists of the NWT/NU

BENCH MARK

BM 1 ELEV. = 000.00  
DESCRIPTION HERE

| No. | DESCRIPTION             | DATE     | BY  | APP'D |
|-----|-------------------------|----------|-----|-------|
| 4   | AS-CONSTRUCTED          | 17/11/11 | MEB | SLB   |
| 3   | ISSUED FOR CONSTRUCTION | 14/09/09 | MMR | SLB   |
| 2   | TENDER SET              | 27/04/09 | MMR | SLB   |
| 1   | ISSUED FOR APPROVAL     | 24/04/08 | MMR | SLB   |

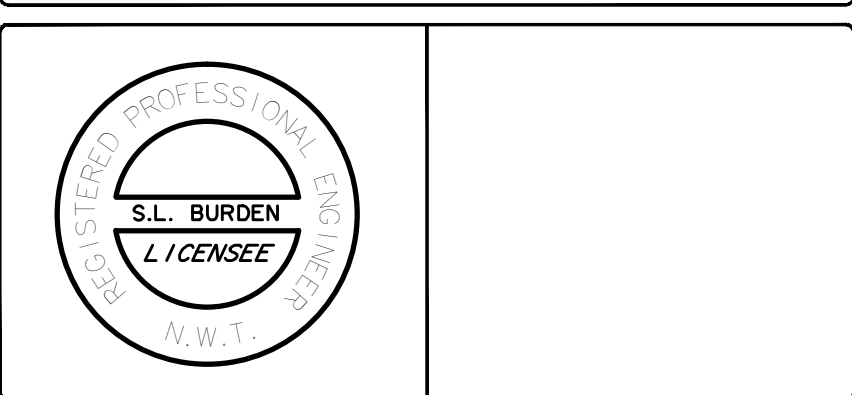


**Trow Associates Inc.**  
154 Colonnade Road South  
Ottawa, Ont. K2E 7J5  
Tel: (613) 225-9940  
Fax: (613) 225-7337

CLIENT  
GOVERNMENT OF NUNAVUT

PROJECT  
ARCTIC BAY  
WASTE WATER  
LAGOON ROAD

TITLE  
ACCESS ROAD  
PLAN & PROFILE  
STA. 0+300 TO STA. 0+600  
design by S.A.D. project no. OTCD19054A  
drawn by M.M.R. drawing no.  
checked by S.L.B.  
date 21/04/08  
scale HORIZ 1:500 VERT 1:50

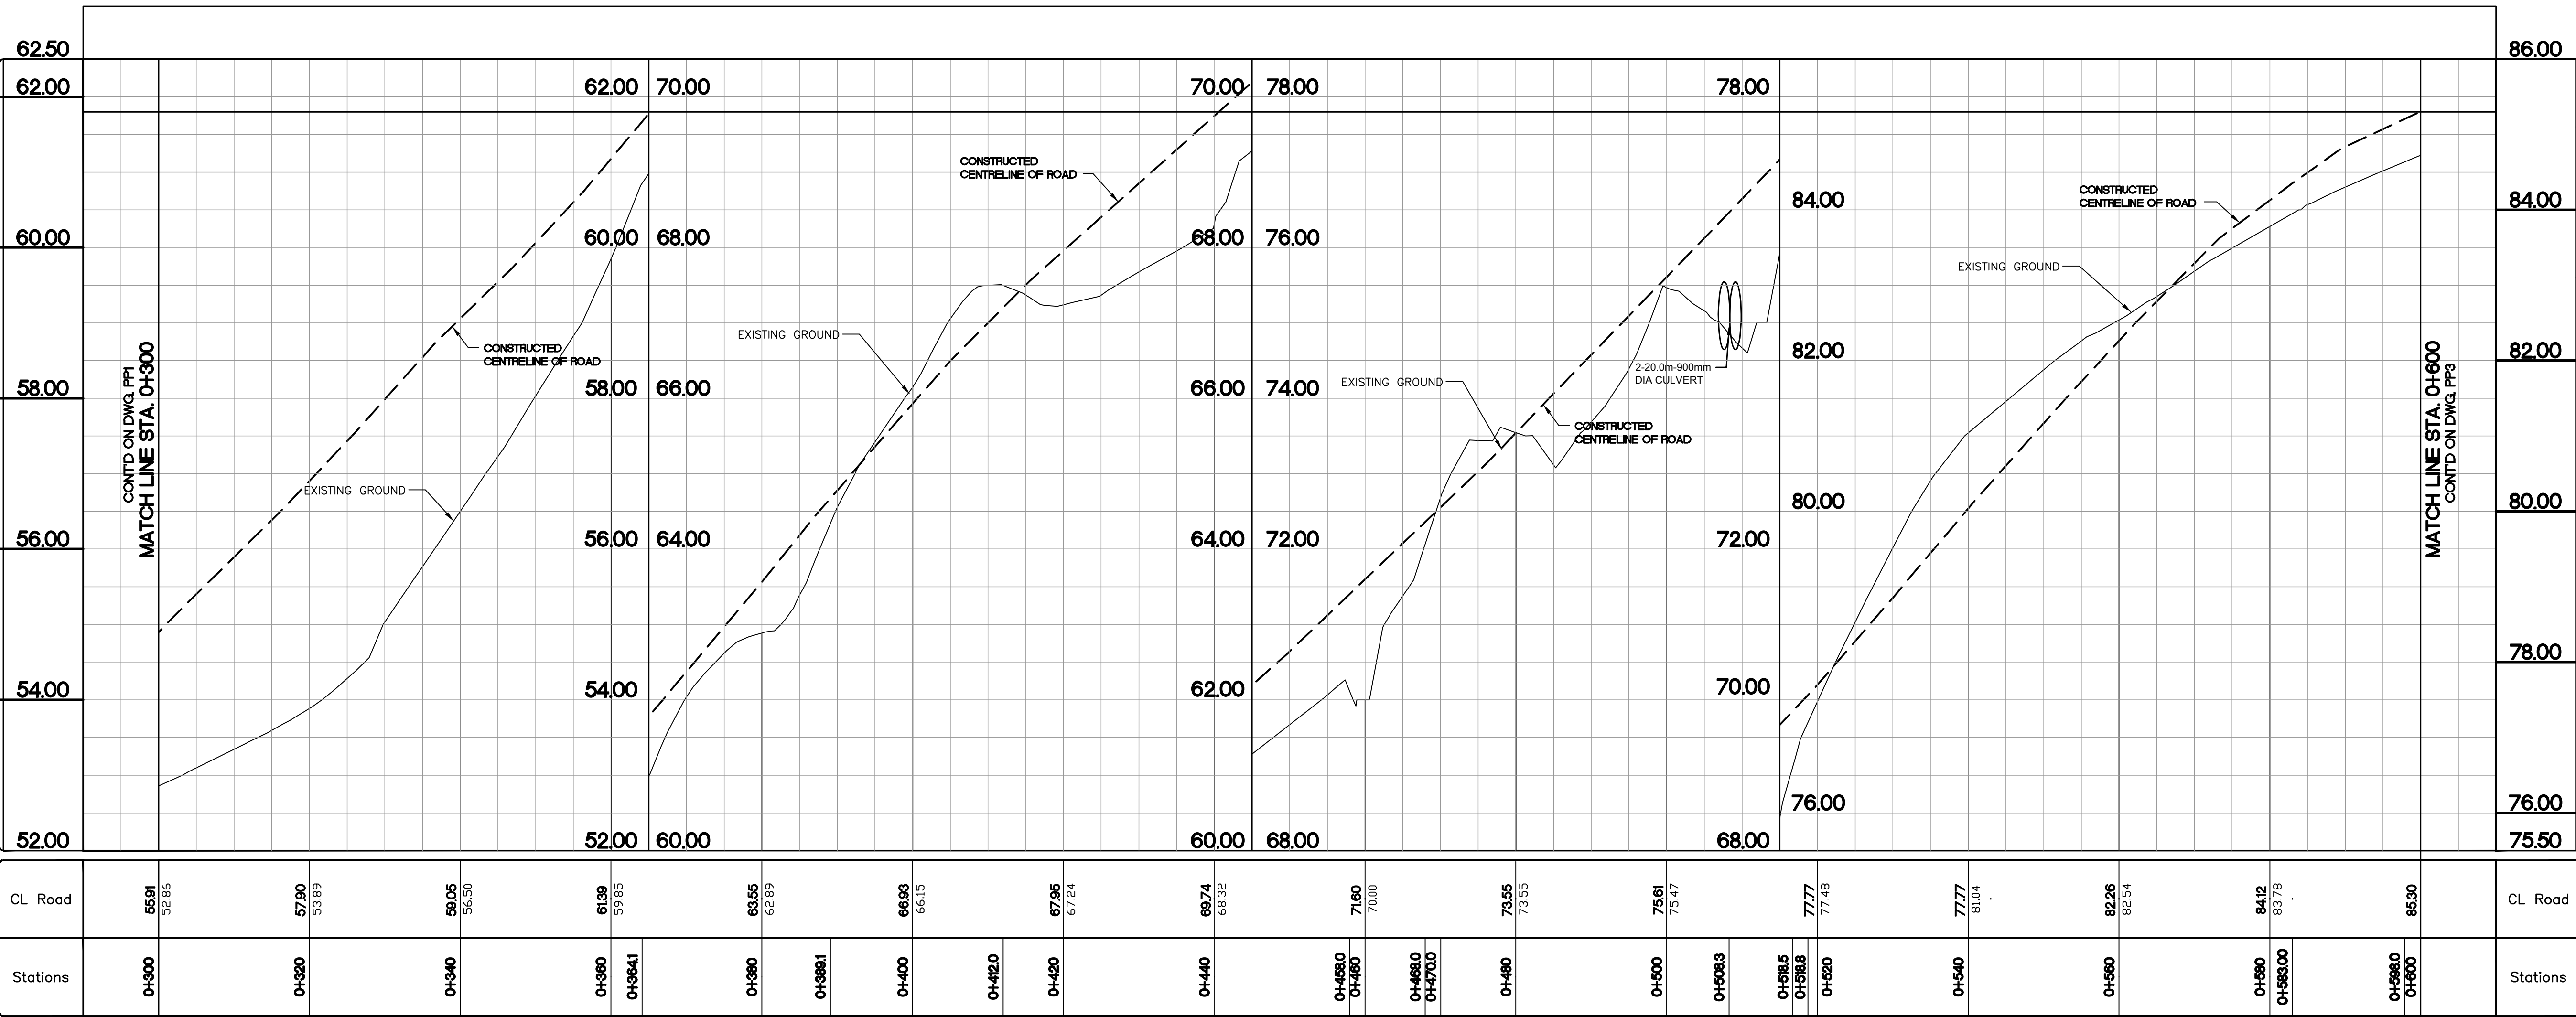

|          |       |----------|-------|-------|-------|-------|---------|-------|---------|-------|-------|-------|-------|-------|-------|-------|-------|---------|---------|-------|-------|-------|-------|----------|-------|-------|-------|-------|-------|-------|-------|-------|-------|----------|
| CL Road  | 55.91 | 52.86 | 57.90 | 53.89 | 59.05   | 56.50 | 61.39   | 59.85 | 63.55 | 62.89 | 66.93 | 66.15 | 67.95 | 67.24 | 69.74 | 68.32   | 71.60   | 70.00 | 73.55 | 73.55 | 75.61 | 75.47    | 77.77 | 77.48 | 77.77 | 81.04 | 82.26 | 82.54 | 84.12 | 83.78 | 85.30 | CL Road  |
| Stations | 0+300 | 0+320 | 0+340 | 0+360 | 0+384.1 | 0+380 | 0+398.1 | 0+400 | 0+420 | 0+420 | 0+440 | 0+460 | 0+480 | 0+480 | 0+500 | 0+508.5 | 0+518.8 | 0+520 | 0+540 | 0+560 | 0+580 | 0+583.00 | 0+580 | 0+600 | 0+600 | 0+600 | 0+600 | 0+600 | 0+600 | 0+600 | 0+600 | Stations |