


## AS-BUILT DATE: NOVEMBER 30, 2011

BENCH MARK

BM 1 ELEV. = 59.12 CONTOUR ELEVATIONS WERE DREIVED FROM NAD 83 CONTROL MONUMENT 7038914 LOCATED NORTH OF THE ARCTIC BAY AIRPORT UNDER CONSTRUCTION.

4	AS-BUILT	30/11/11	SAB	SLB
3	AS-CONSTRUCTED	17/11/11	MEB	SLB
2	TENDER SET	27/04/09	MMR	SLB
1	ISSUED FOR APPROVAL	24/04/08	MMR	SLB
No.	DESCRIPTION	DATE	BY	APP'[
	REVISION	N S	•	•

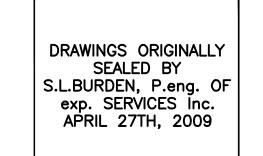



GOVERNMENT OF NUNAVUT

PROJECT				
ARCTIC	BAY	WASTEWA	ATER	LAGOON
TITLE				
		DETAILS		
design by	S/	SAD		OTCD000190
drawn by	МІ	MEB		
checked by	SI	SLB		E-2
date	15/01	/2008	7 0	

