






Stantec

4444 Centerville Road, Suite 140
White Bear Lake, MN 55127
651-255-5050
651-255-5060 (fax)

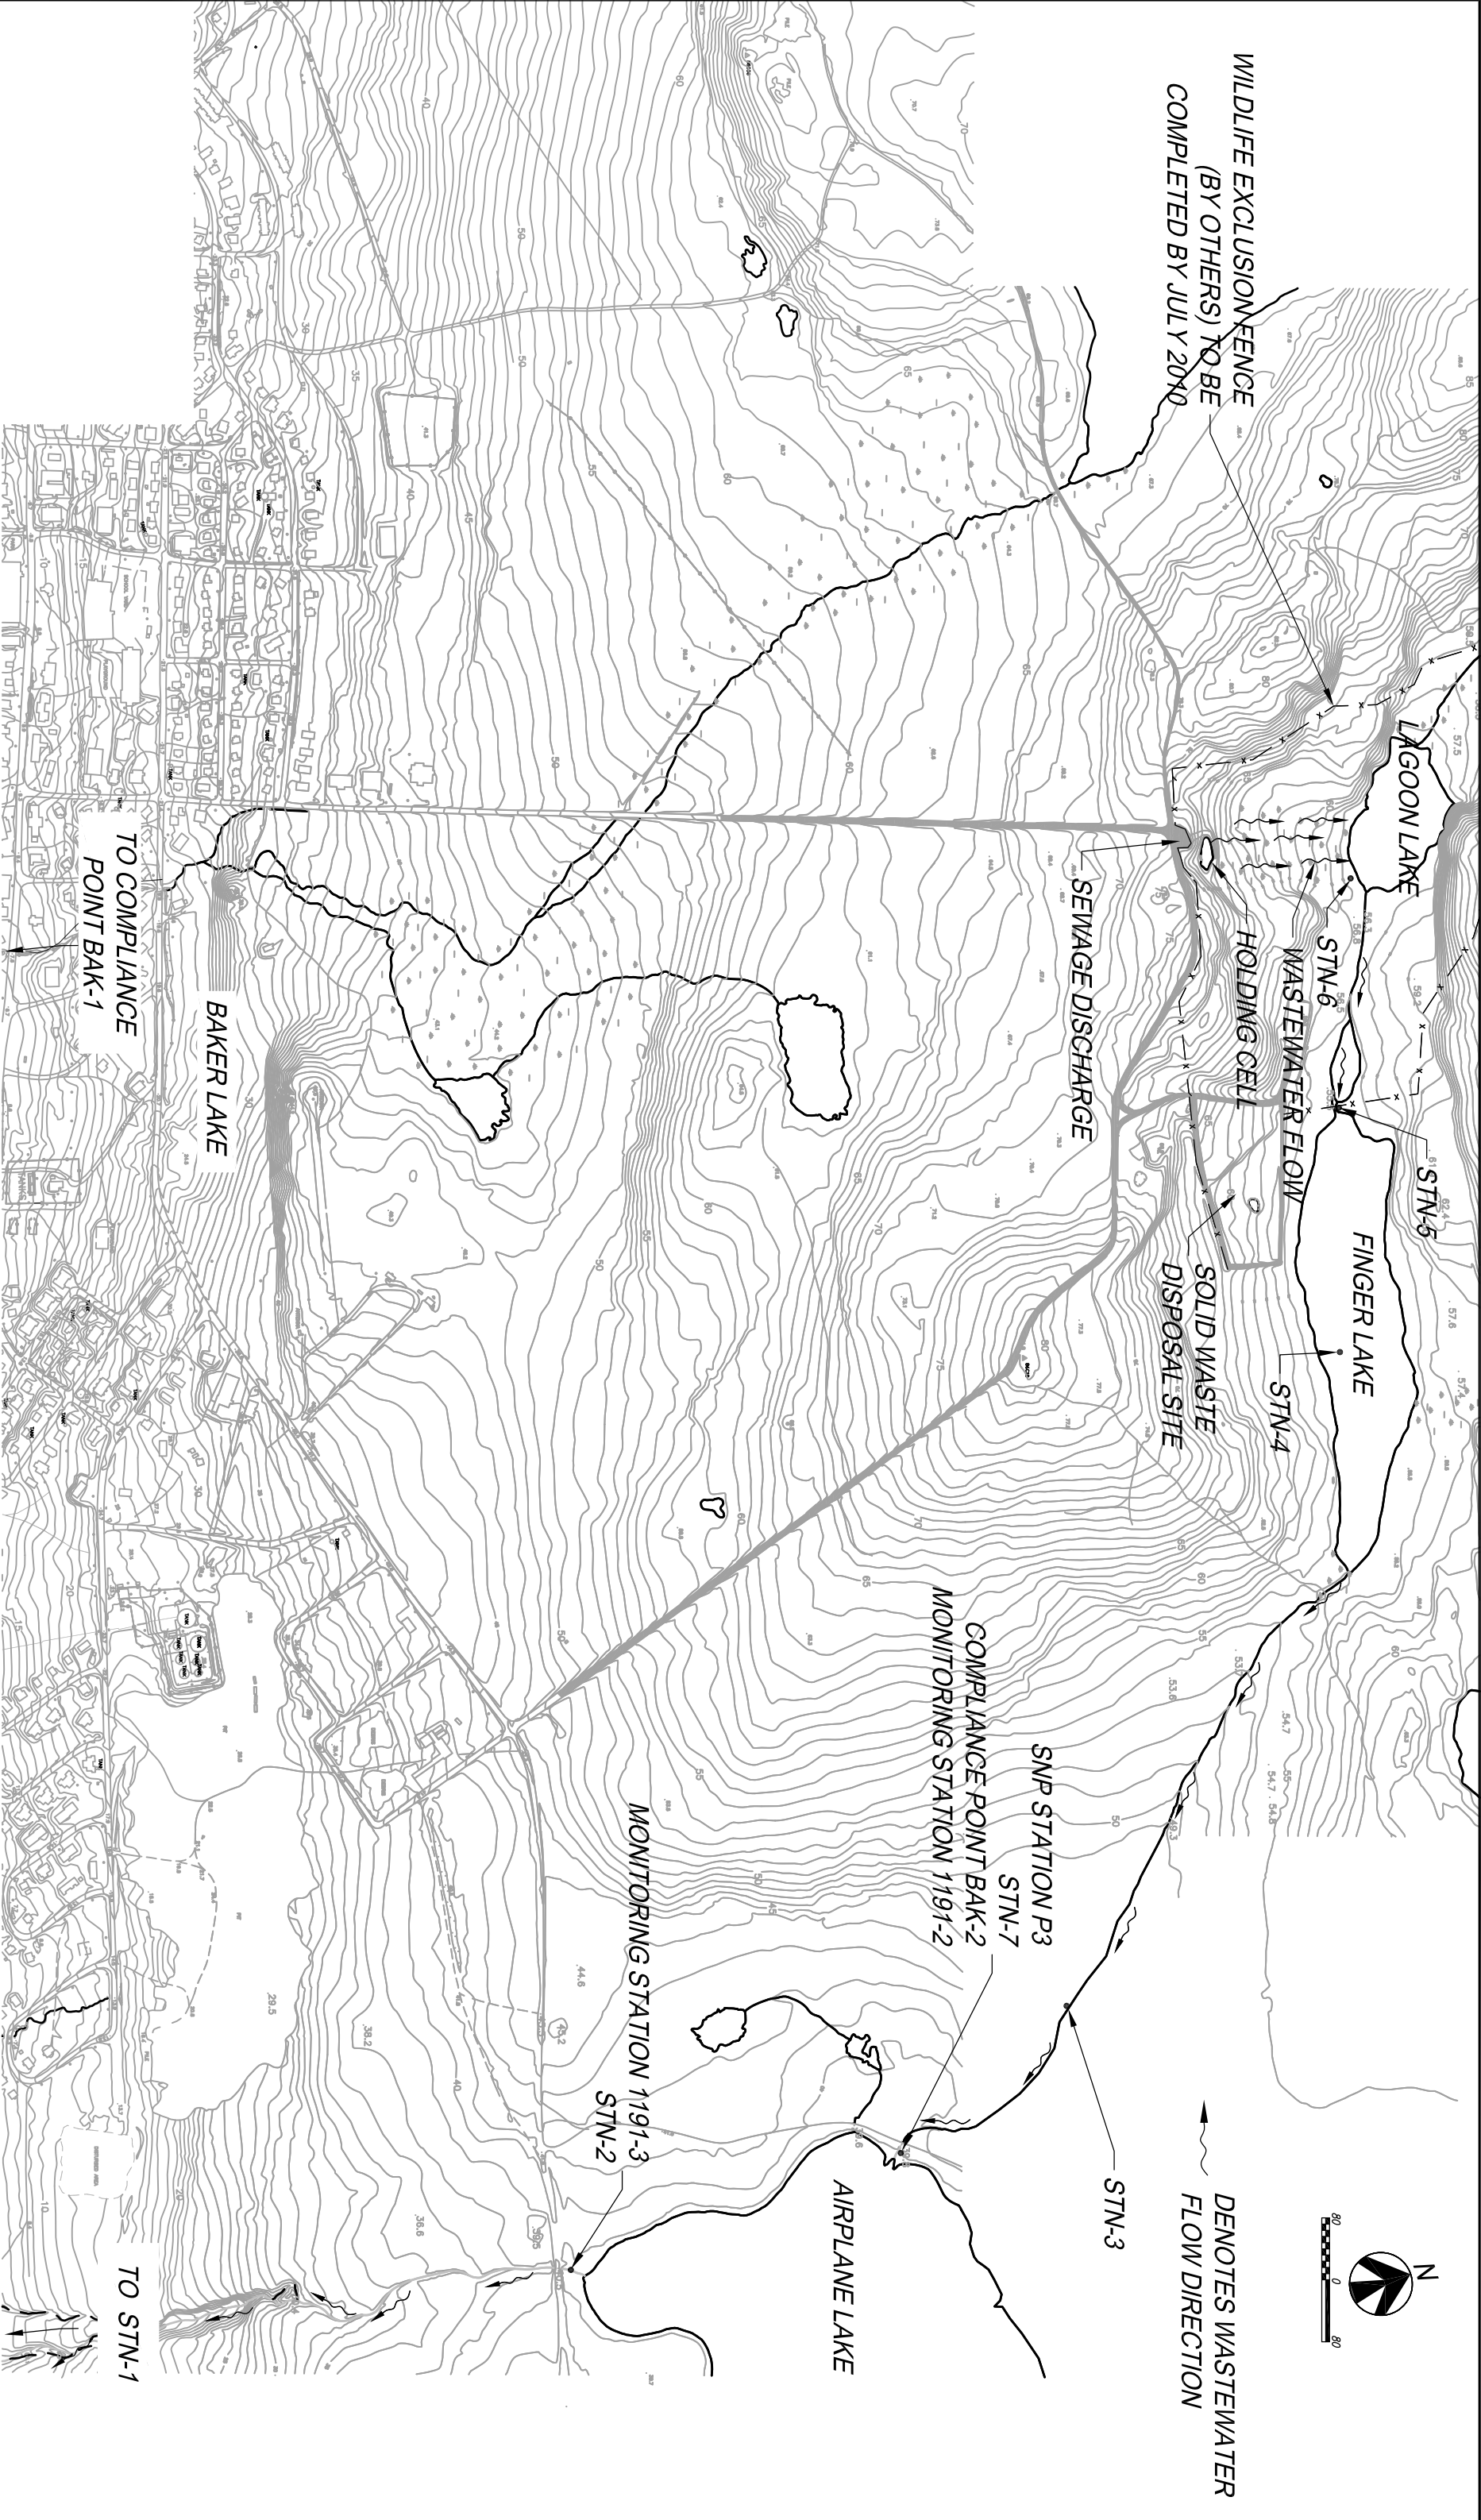

NUNAMI

JACQUES WHITFORD LIMITED

Rev	Date	Description
8	11/03/11	Record Drawing

GOVERNMENT OF NUNAVUT
DEPARTMENT OF COMMUNITY AND GOVERNMENT SERVICES
BAKER LAKE SEWAGE SYSTEM
IMPROVEMENTS
QAMAMITUAG, NUNAVUT

Site Plan
Existing Conditions

C-1

C:\Users\rwagner\Desktop\Stantec Projects\Baker Lake\1015263-C001.dwg

Copyright © 2011 Stantec