





Detail B - Bollard

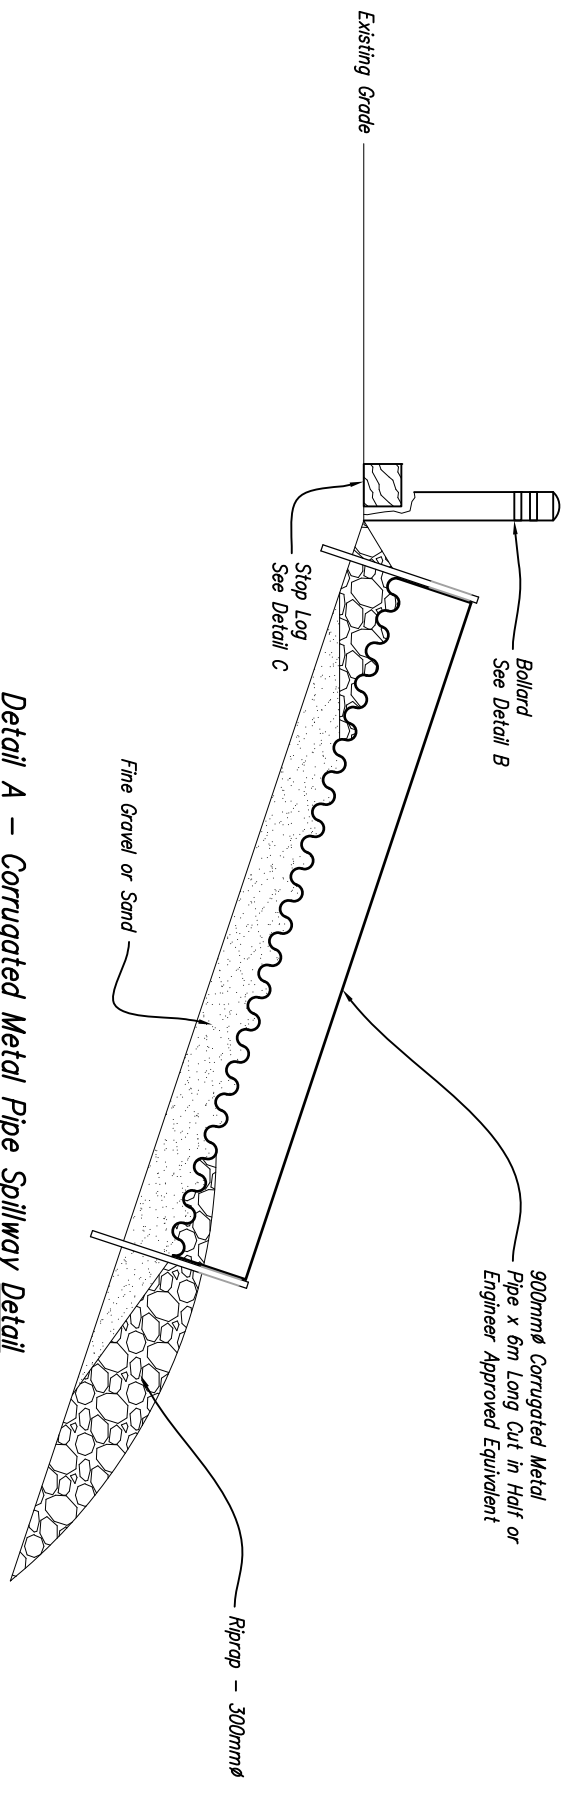

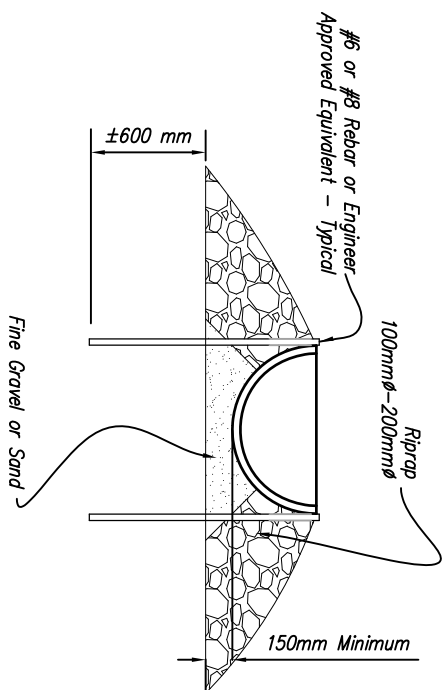

Detail A – Corrugated Metal Pipe Spillway Detail

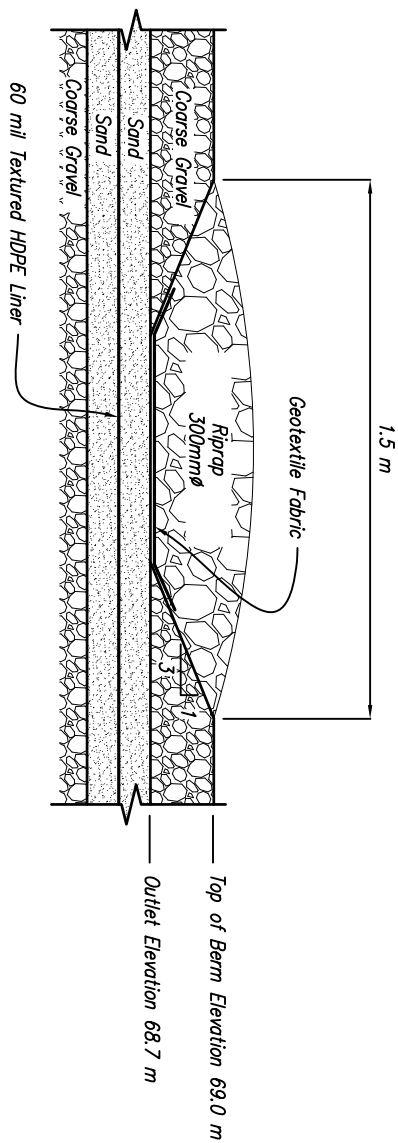

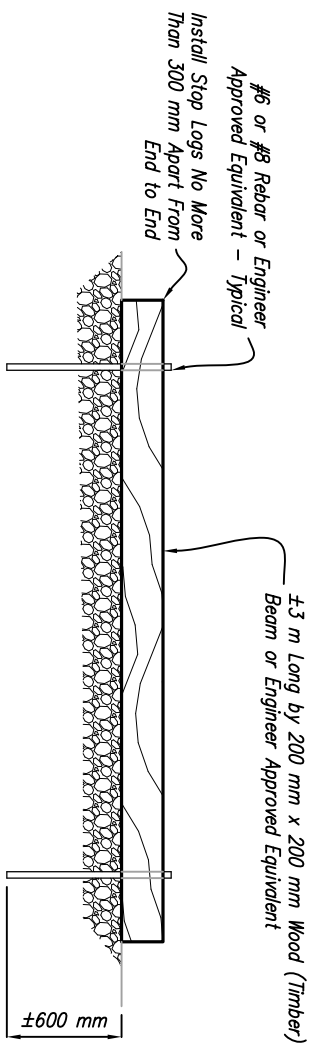Detail D - Holding Cell Berm Outlet



Detail C - Traffic Barrier Stop Log

 <p>Stantec 4444 Centerville Road, Suite 140 White Bear Lake, MN 55127 651-255-5080 651-255-5060 (fax)</p>	 <p>NUNAMI JACQUES WHITFORD LIMITED</p>	<p>GOVERNMENT OF NUNAVUT DEPARTMENT OF COMMUNITY AND GOVERNMENT SERVICES BAKER LAKE SEWAGE SYSTEM IMPROVEMENTS QAMANIUTUQA, NUNAVUT</p>	<p><i>Details</i></p>
			<p>C-8</p>
<p>8</p>	<p>11/03/11</p>	<p>Record Drawing</p>	
<p>Rev</p>	<p>Date</p>	<p>Description</p>	