

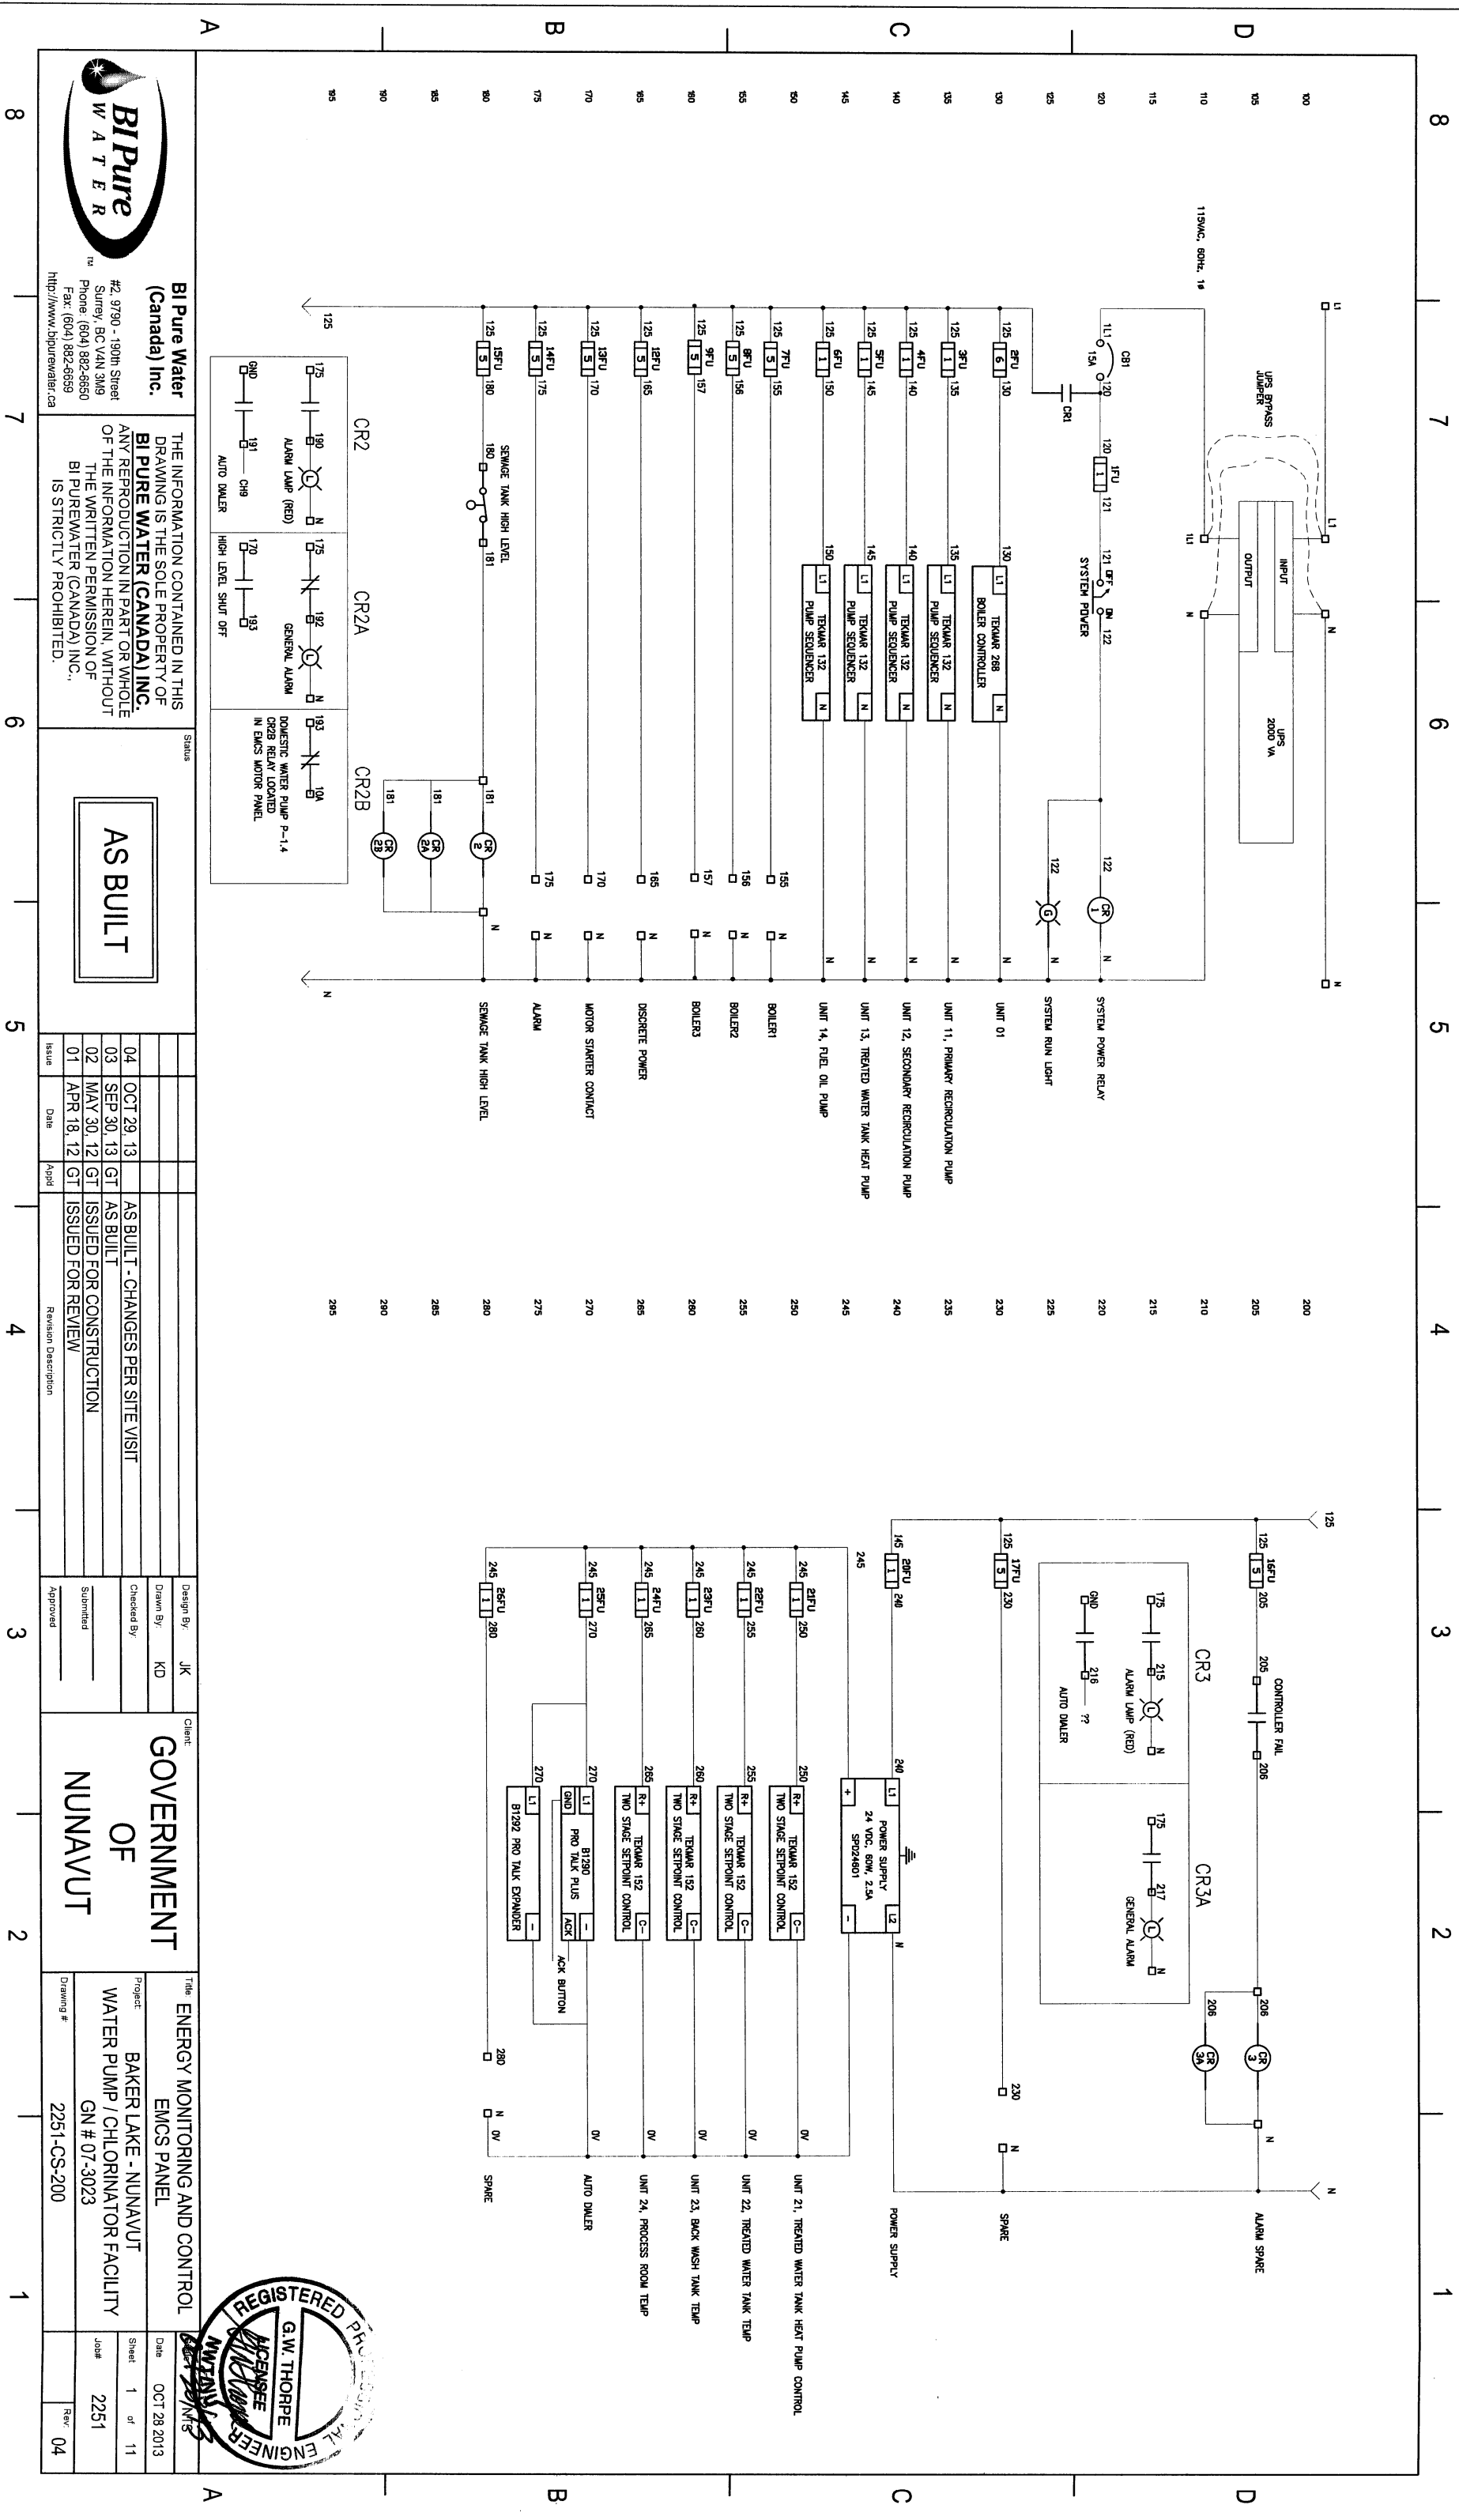


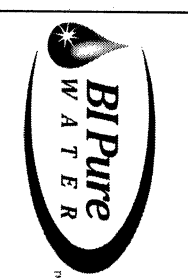

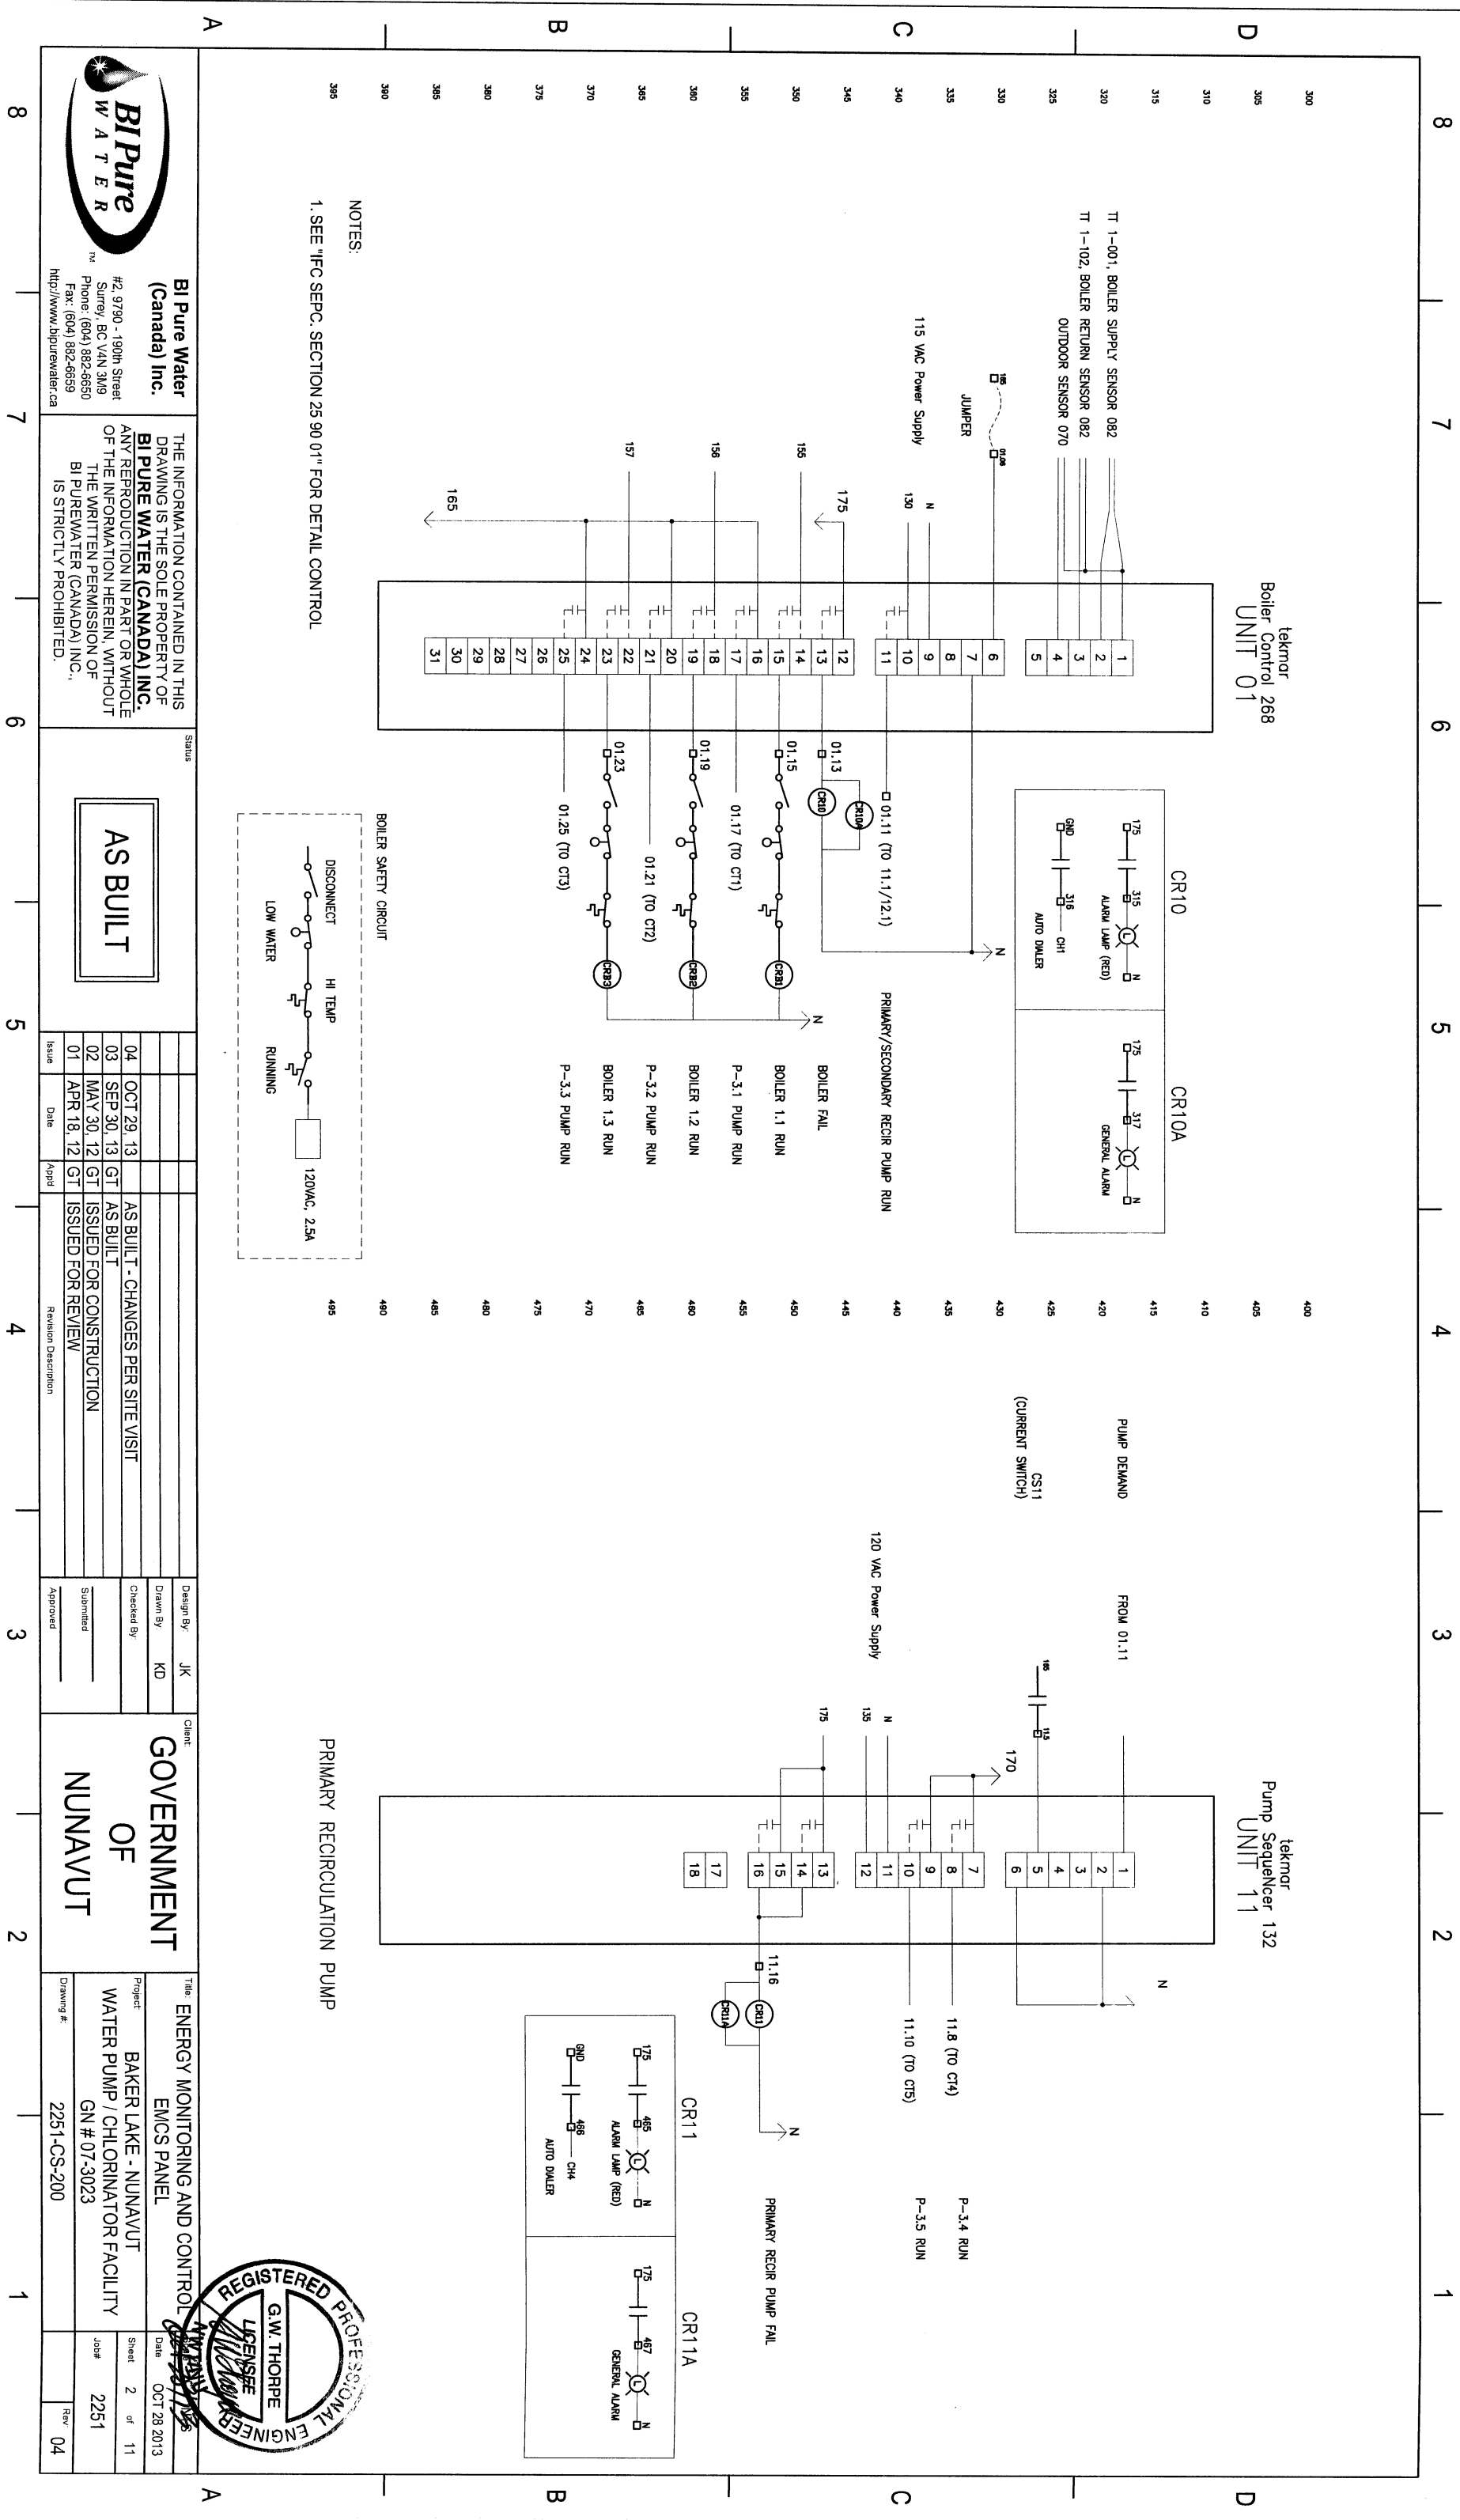

BI Pure Water (Canada) Inc.
#2, 9790 - 190th Street
Surrey, BC V4N 3M9
Phone: (604) 882-6650
Fax: (604) 882-6659
<http://www.bipurewater.ca>



THE INFORMATION CONTAINED IN THIS DRAWING IS THE SOLE PROPERTY OF **BI PURE WATER (CANADA) INC.** ANY REPRODUCTION IN PART OR WHOLE OF THE INFORMATION HEREIN, WITHOUT THE WRITTEN PERMISSION OF BI PURE WATER (CANADA) INC., IS STRICTLY PROHIBITED.

Status		Revision Description	
Issue	Date	Appd	Revision Description
04	OCT 29, 13		AS BUILT - CHANGES PER SITE VISIT
03	SEP 30, 13		AS BUILT
02	MAY 30, 12		ISSUED FOR CONSTRUCTION
01	APR 18, 12		ISSUED FOR REVIEW

Design By:	JK
Drawn By:	KD
Checked By:	
Submitted	
Approved	

Client		Title	
GOVERNMENT OF NUNAVUT		ENERGY MONITORING AND CONTROL	
Project		Sheet	
BAKER LAKE - NUNAVUT WATER PUMP / CHLORINATOR FACILITY		2 of 11	
Job #		Rev	
GN # 07-3023		2251	
Drawing #		Date	
2251-CS-200		OCT 28 2013	




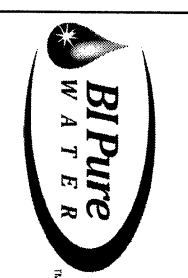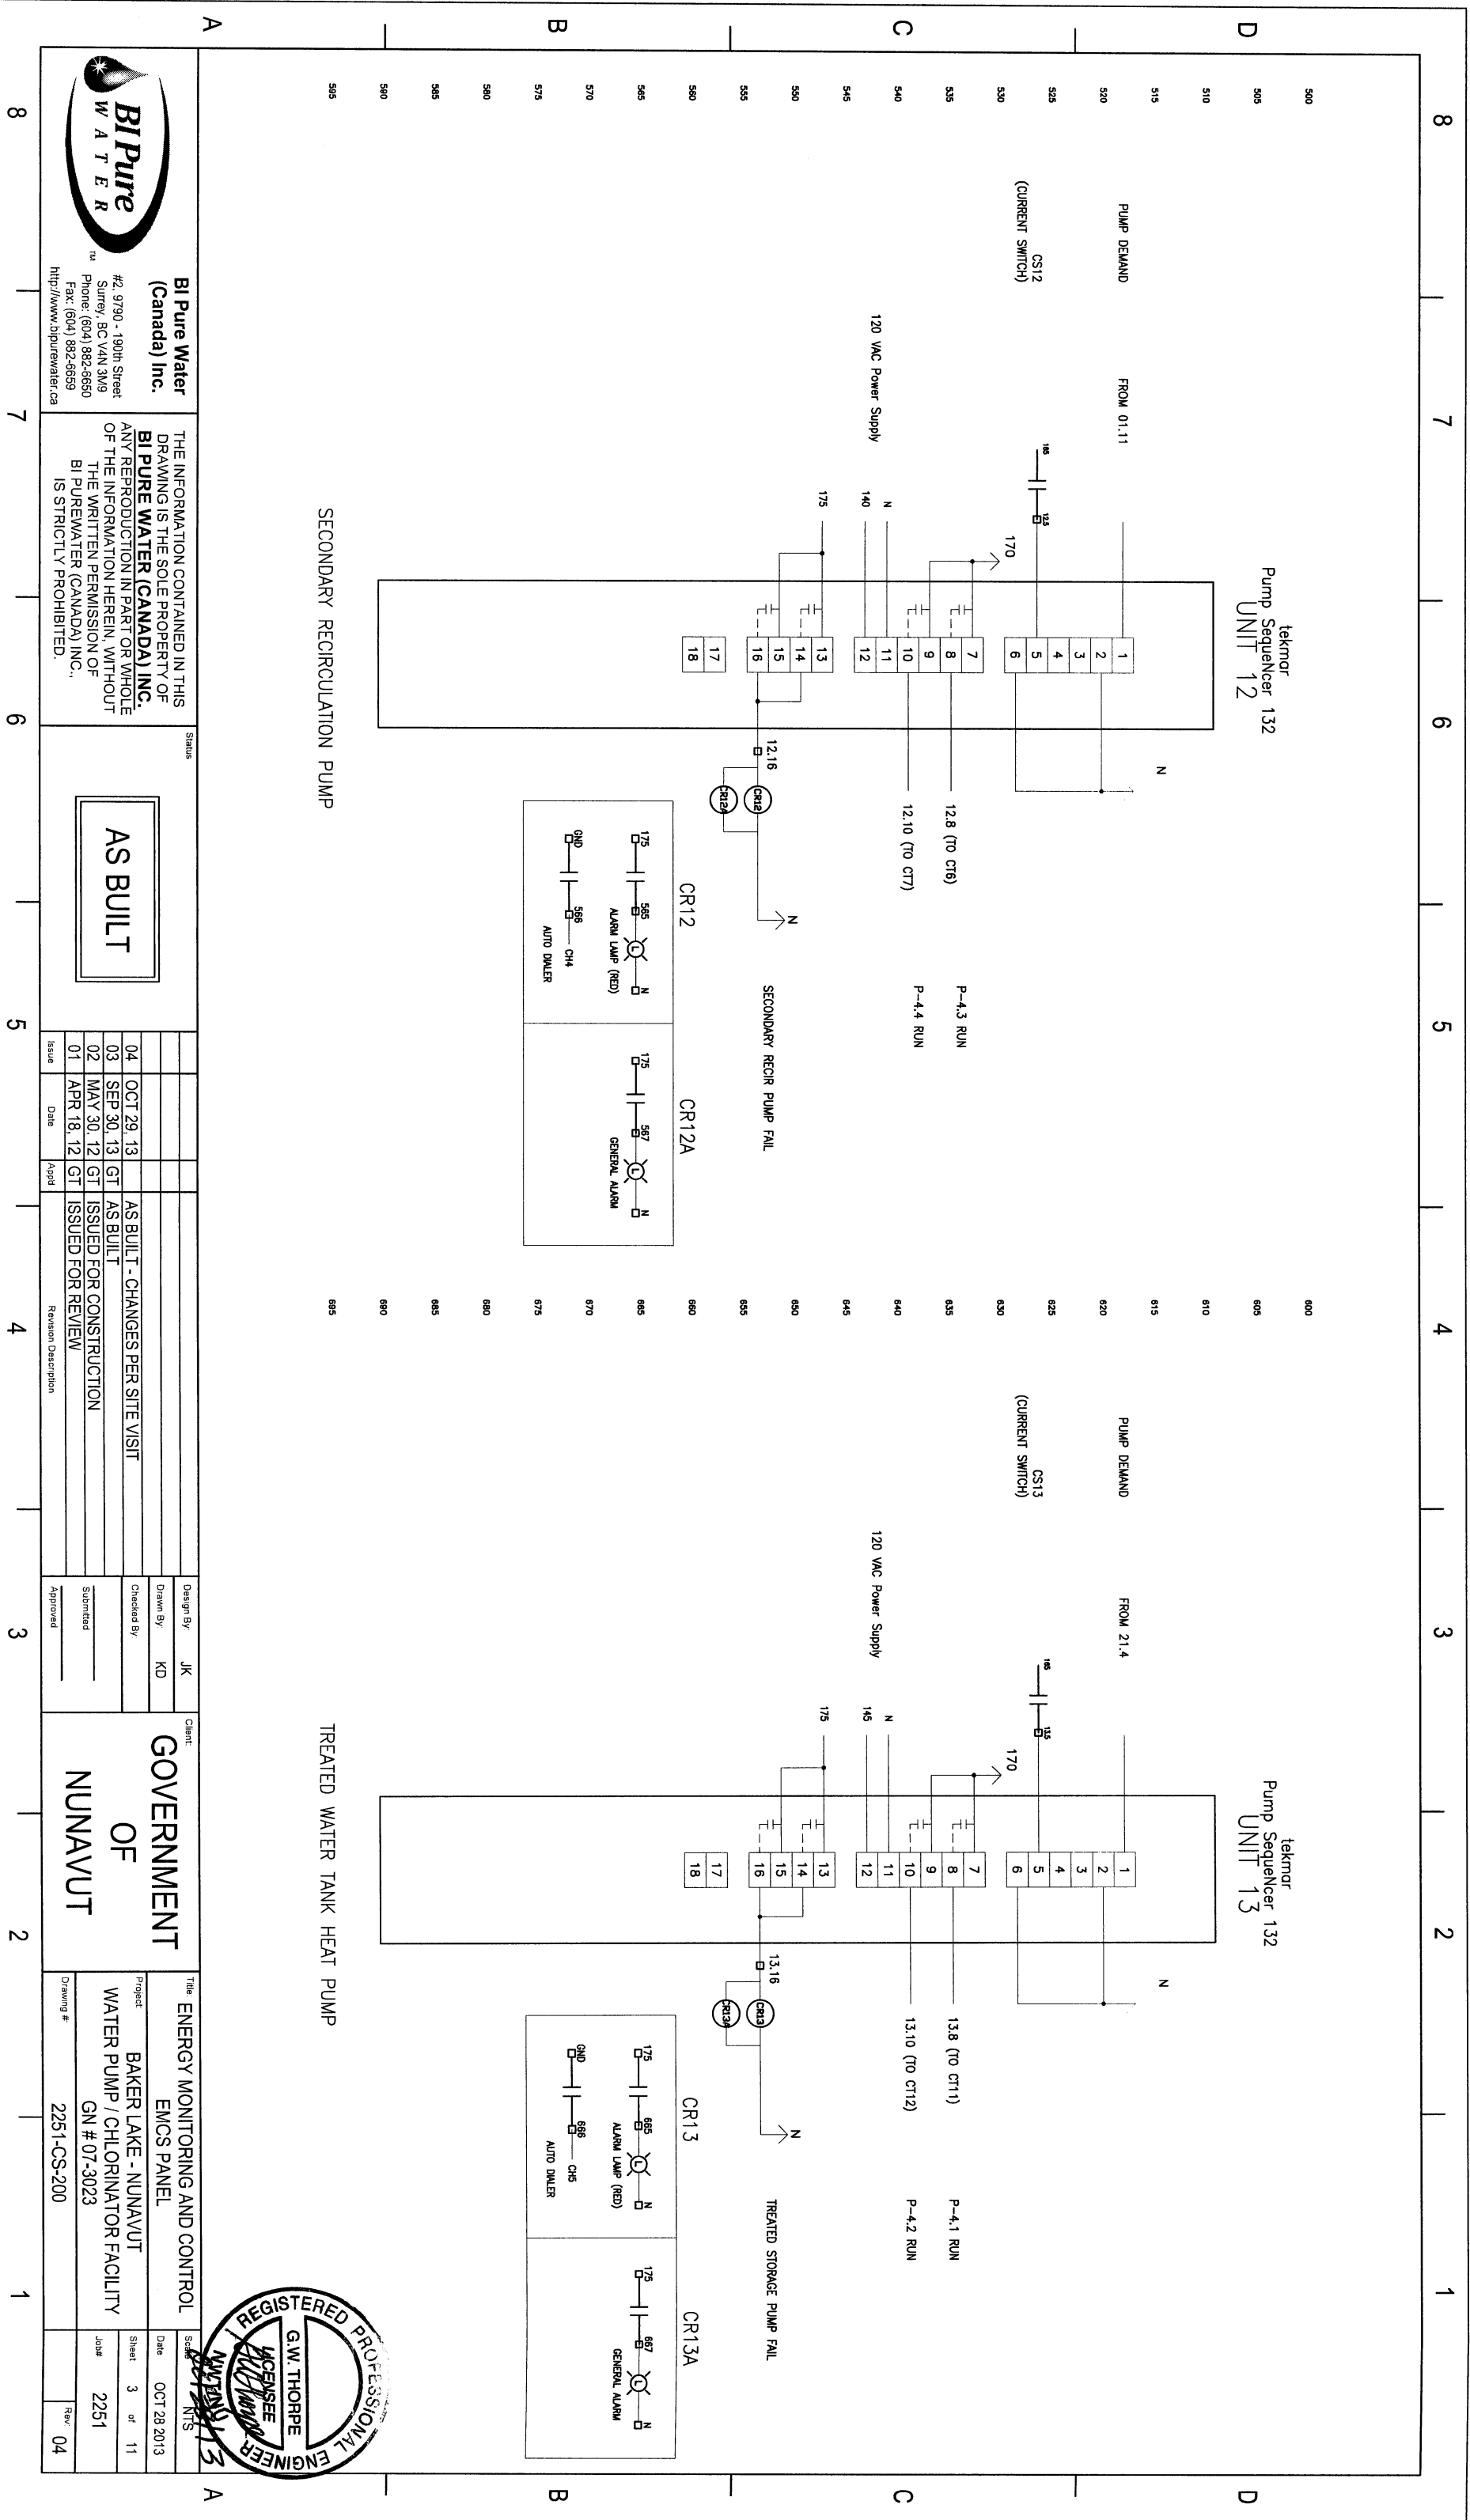


BI Pure Water (Canada) Inc.
#2, 9790 - 190th Street
Surrey, BC V4N 3M9
Phone: (604) 882-6650
Fax: (604) 882-6659
<http://www.bipurewater.ca>

THE INFORMATION CONTAINED IN THIS DRAWING IS THE SOLE PROPERTY OF **BI PURE WATER (CANADA) INC.**. ANY REPRODUCTION IN PART OR WHOLE OF THE INFORMATION HEREIN, WITHOUT THE WRITTEN PERMISSION OF BI PURE WATER (CANADA) INC., IS STRICTLY PROHIBITED.

AS BUILT

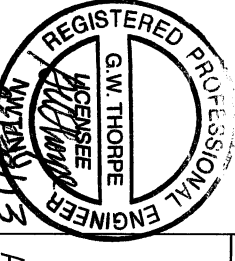

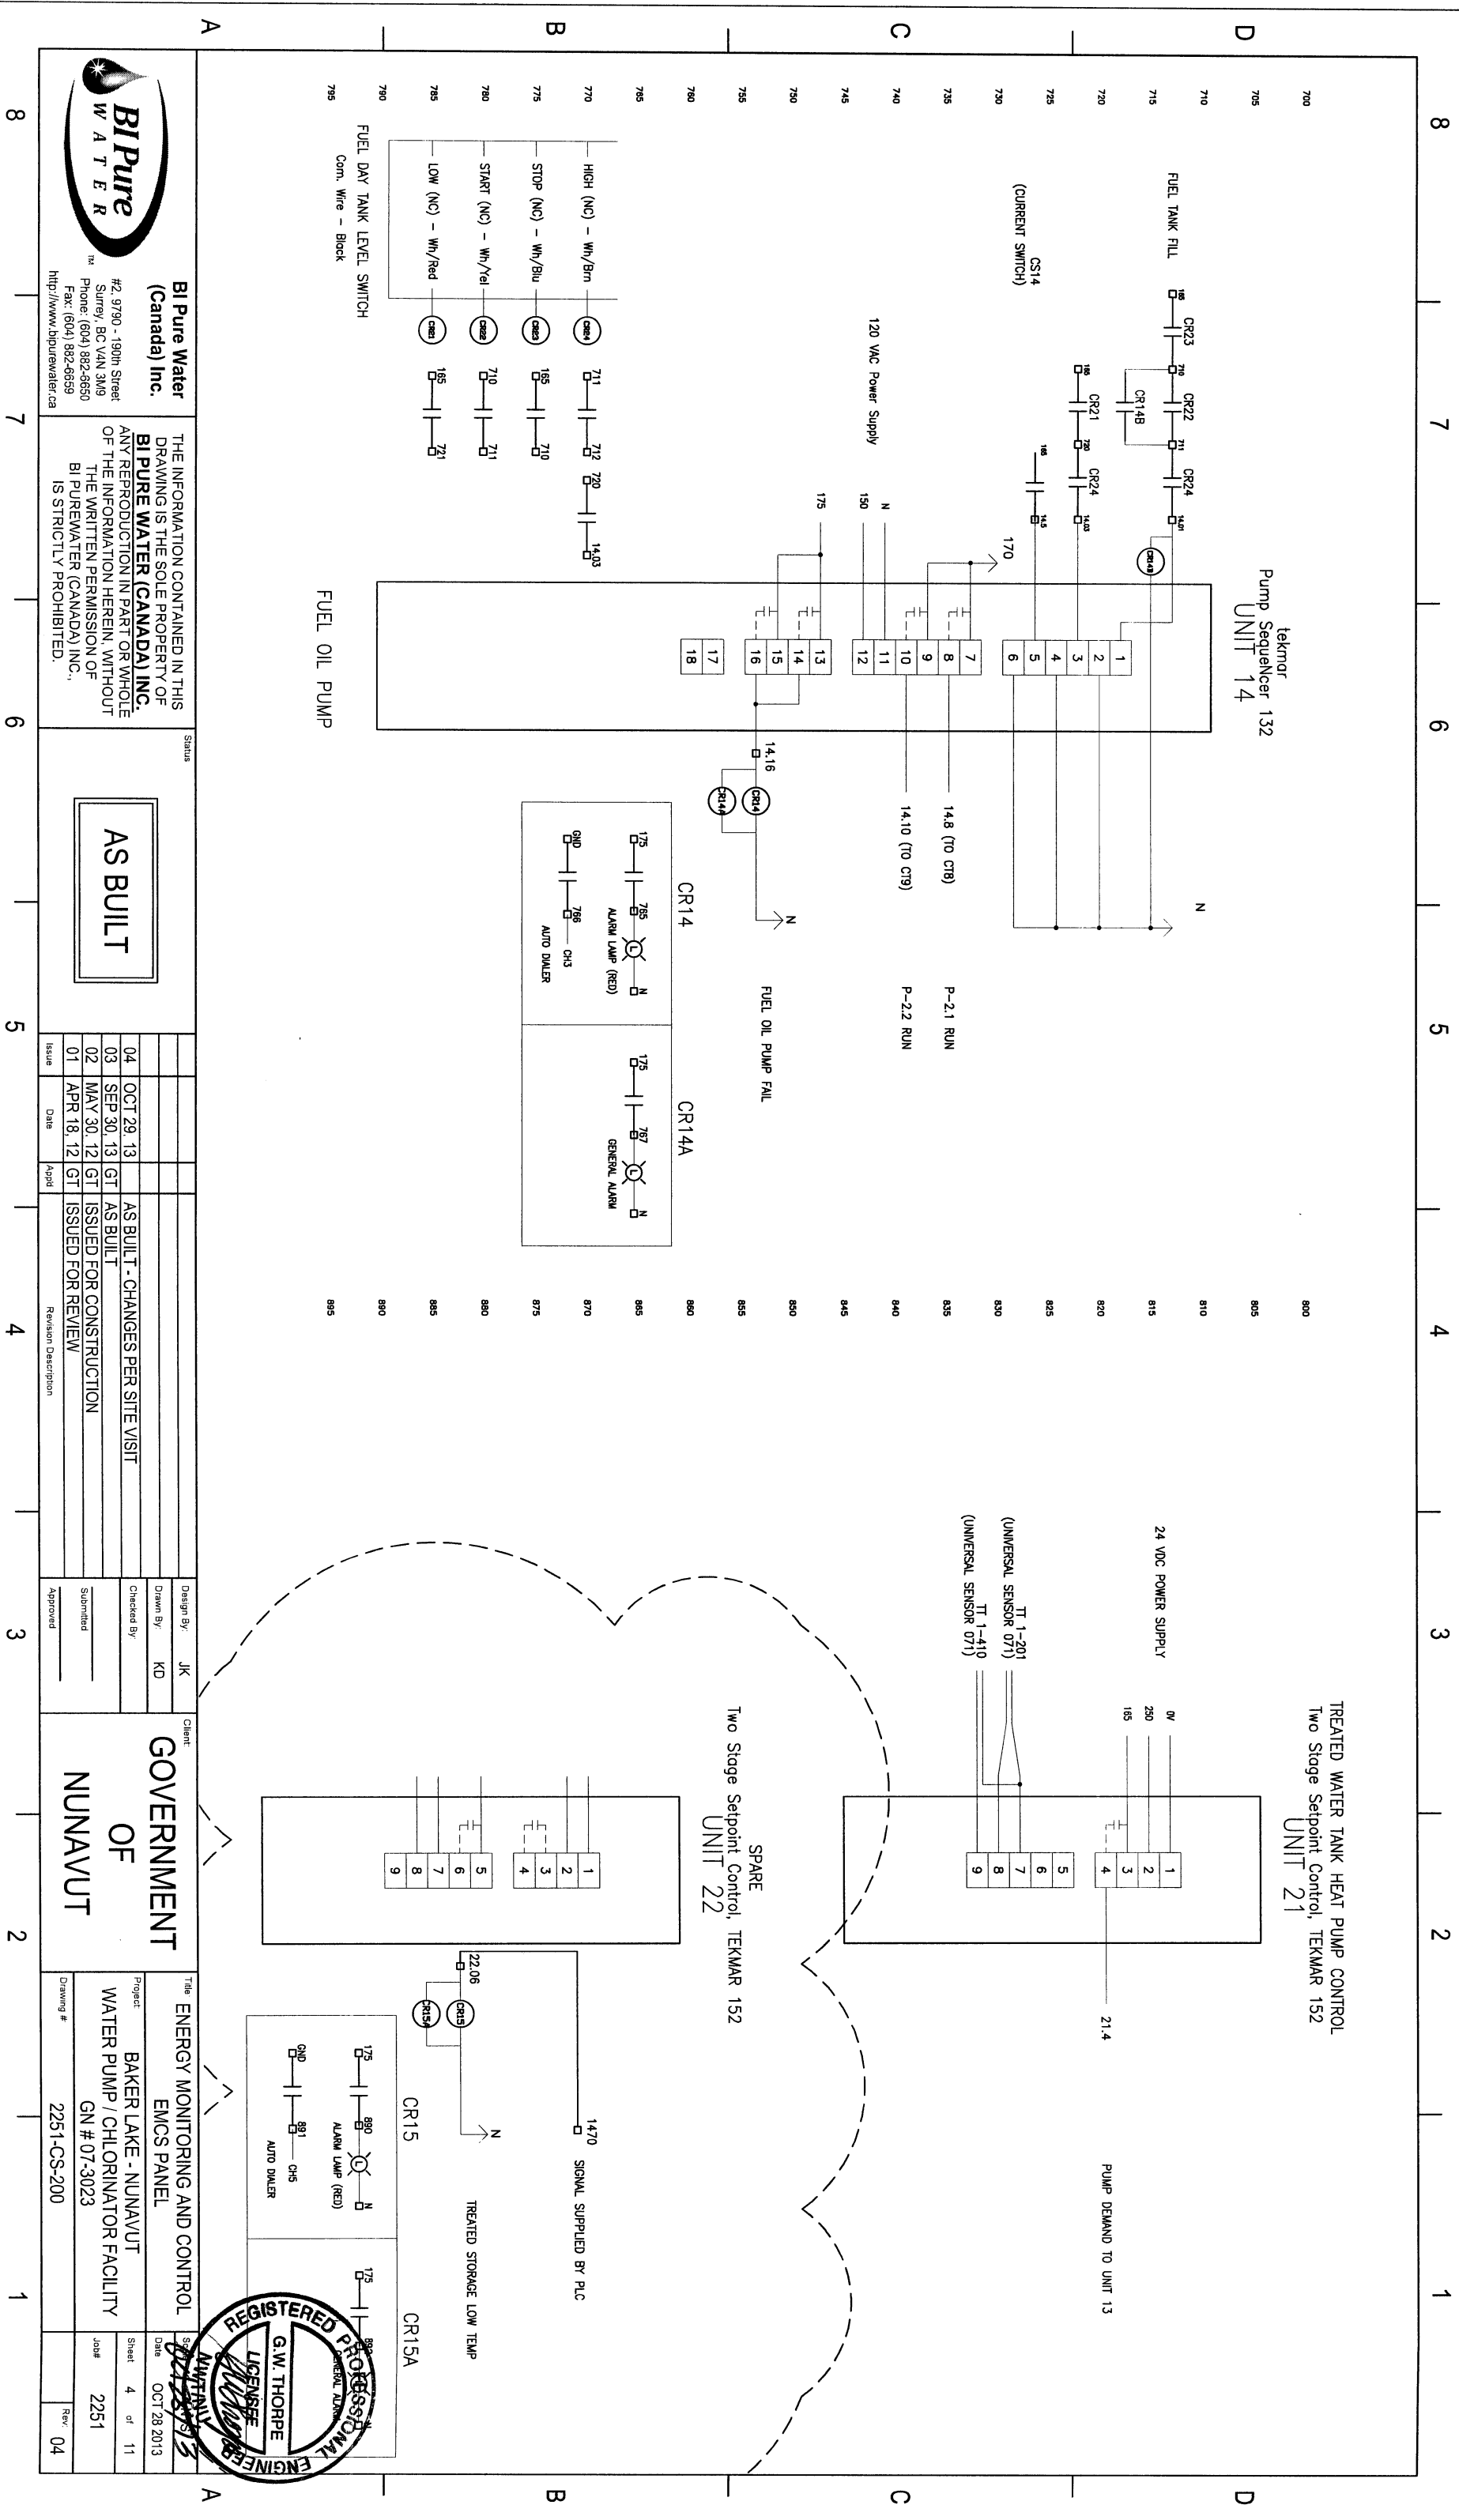

BI Pure Water (Canada) Inc.
#2, 9790 - 190th Street
Surrey, BC V4N 3M9
Phone: (604) 882-6650
Fax: (604) 882-6659
<http://www.bipurewater.ca>

THE INFORMATION CONTAINED IN THIS DRAWING IS THE SOLE PROPERTY OF BI PURE WATER (CANADA) INC.
ANY REPRODUCTION IN PART OR WHOLE OF THE INFORMATION HEREIN, WITHOUT THE WRITTEN PERMISSION OF BI PURE WATER (CANADA) INC., IS STRICTLY PROHIBITED.

AS BUILT



Issue	Date	Appd	Revision Description
04	OCT 29, 13		AS BUILT - CHANGES PER SITE VISIT
03	SEP 30, 13	GT	AS BUILT
02	MAY 30, 12	GT	ISSUED FOR CONSTRUCTION
01	APR 18, 12	GT	ISSUED FOR REVIEW

Client
GOVERNMENT OF NUNAVUT

Title
ENERGY MONITORING AND CONTROL
EMCS PANEL

Project
BAKER LAKE - NUNAVUT
WATER PUMP / CHLORINATOR FACILITY
GN # 07-3023

Sheet 4 of 11
Date OCT 28 2013
Job# 2251
Rev 04

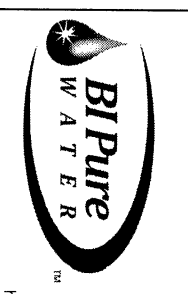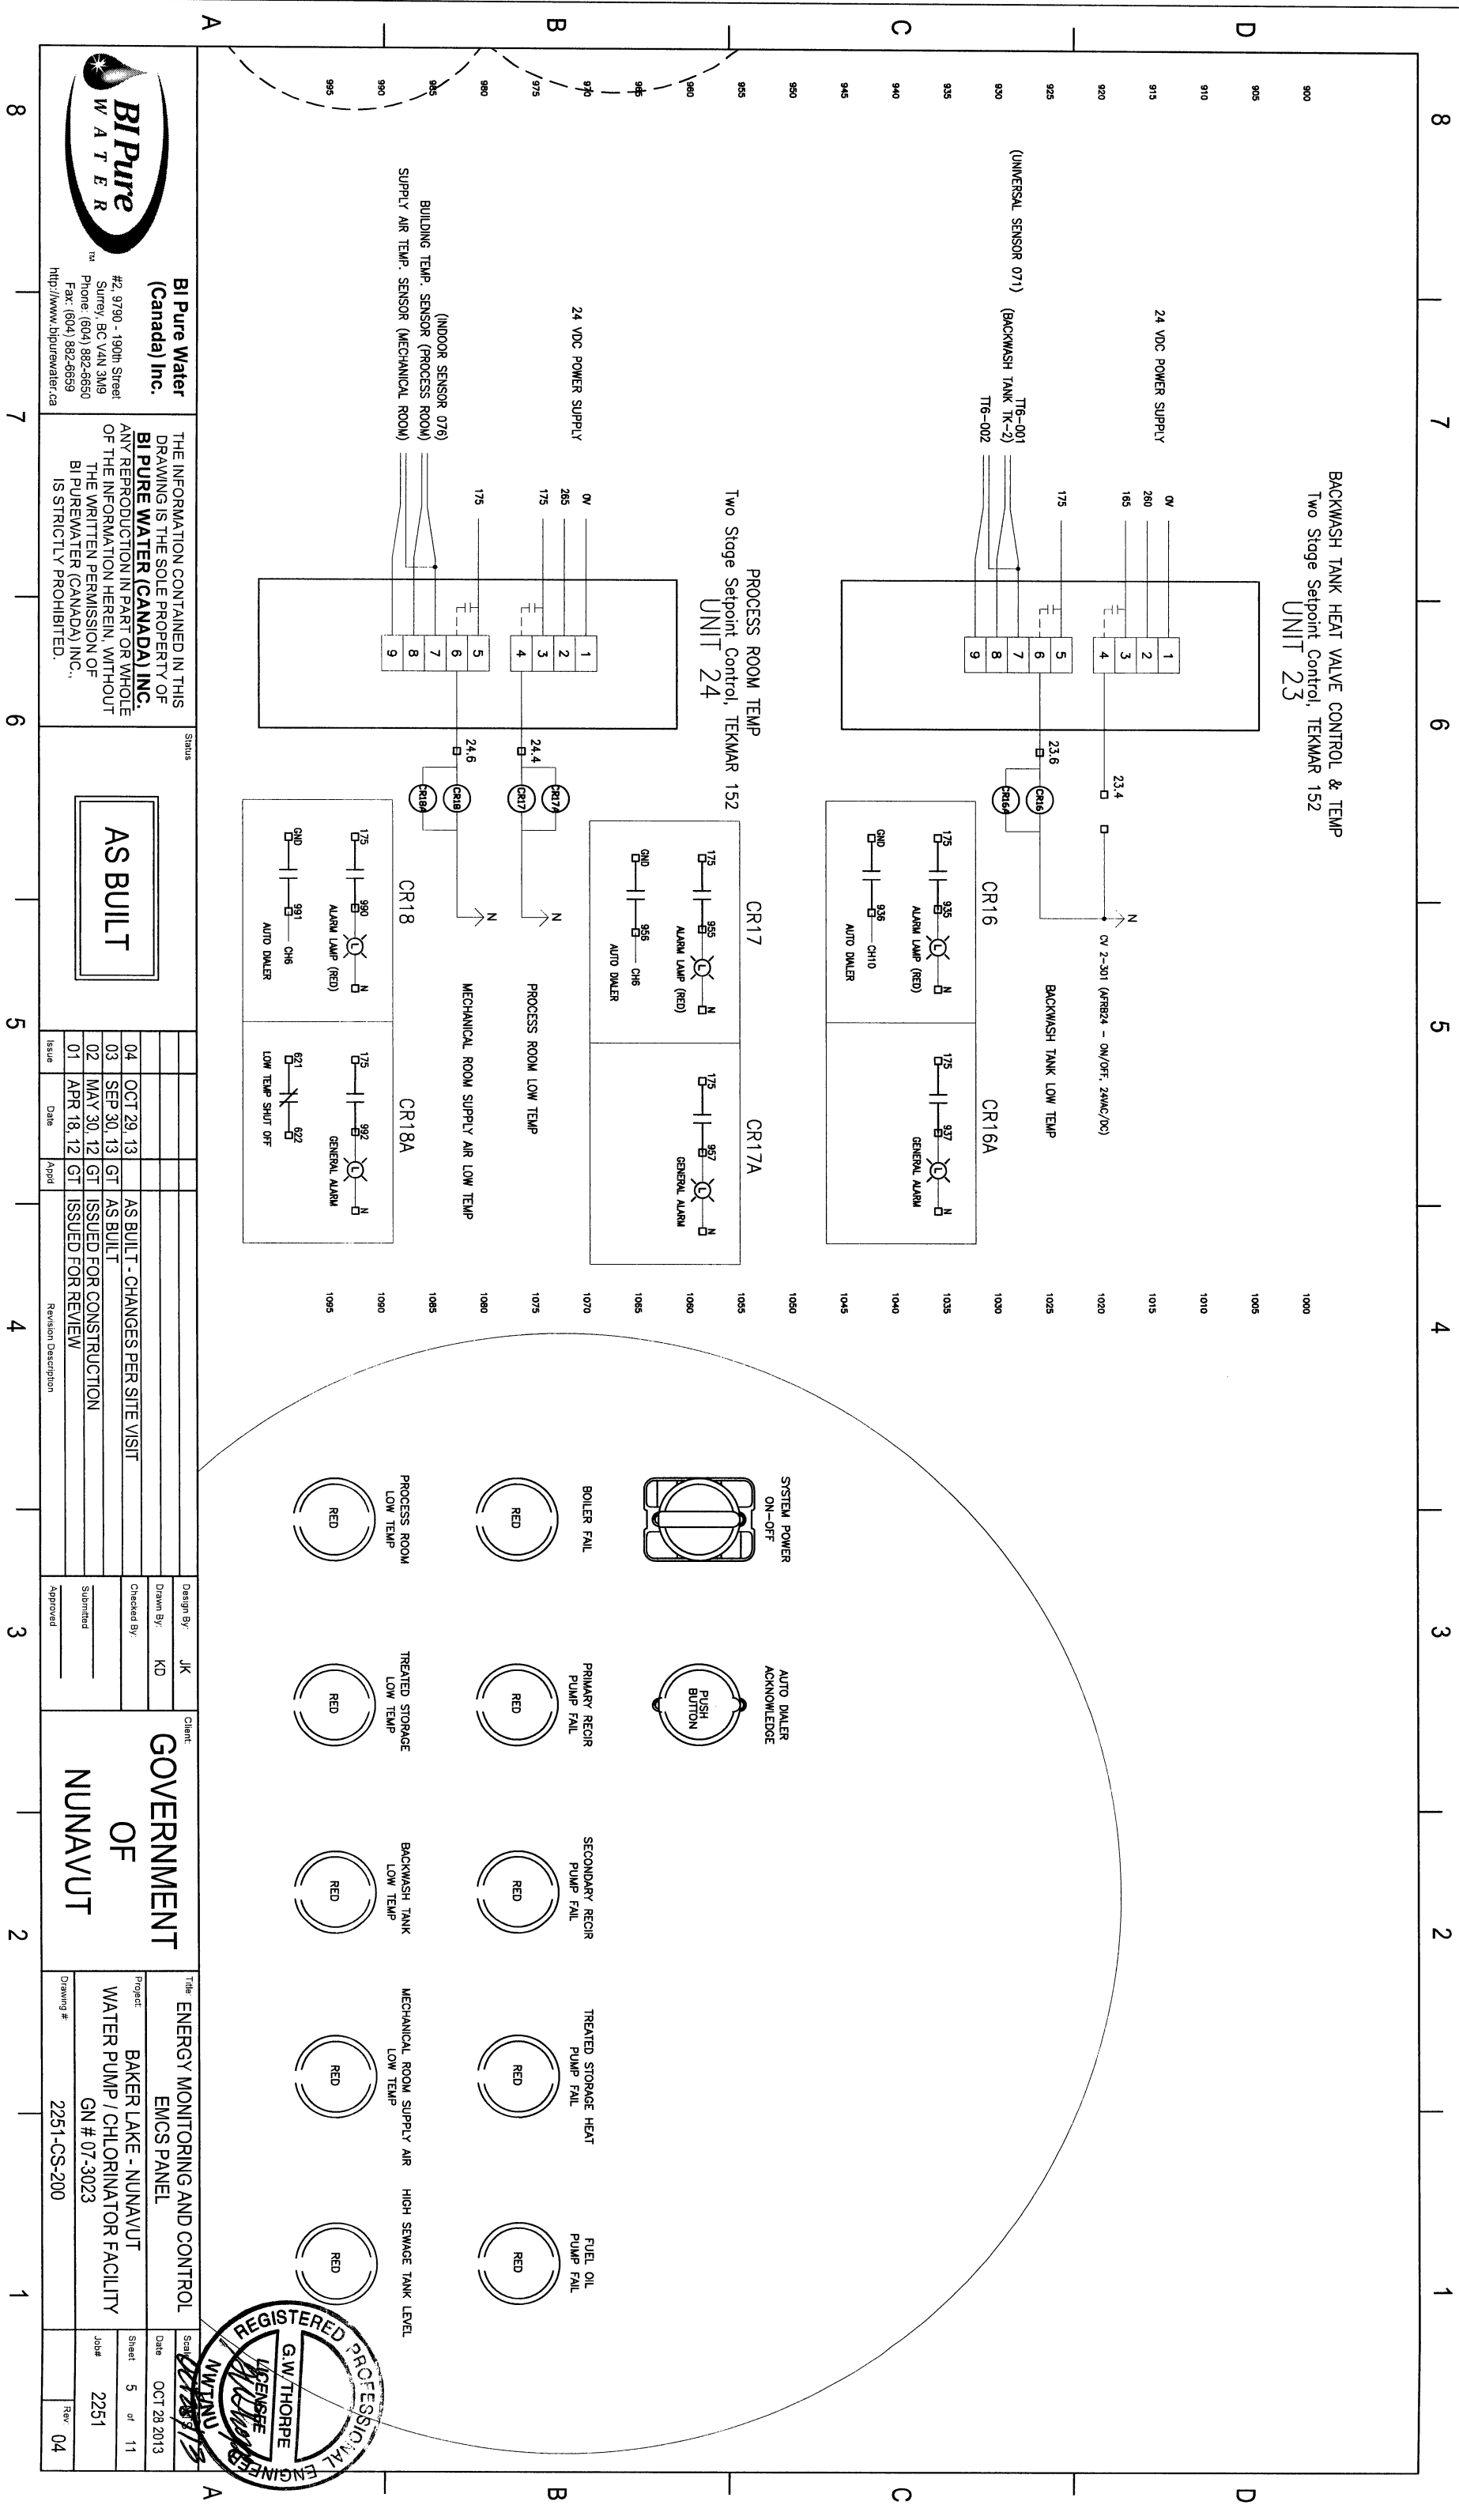

BI Pure Water
(Canada) Inc.
#2, 9790 - 190th Street
Surrey, BC V4N 3M9
Phone: (604) 882-6550
Fax: (604) 882-6559
http://www.bipurewater.ca


THE INFORMATION CONTAINED IN THIS DRAWING IS THE SOLE PROPERTY OF **BI PURE WATER (CANADA) INC.**. ANY REPRODUCTION IN PART OR WHOLE OF THE INFORMATION HEREIN, WITHOUT THE WRITTEN PERMISSION OF BI PURE WATER (CANADA) INC., IS STRICTLY PROHIBITED.

Issue	Date	App'd	Revision Description
04	OCT 29, 13		AS BUILT - CHANGES PER SITE VISIT
03	SEP 30, 13		AS BUILT
02	MAY 30, 12		ISSUED FOR CONSTRUCTION
01	APR 18, 12		ISSUED FOR REVIEW

Design By: JK	Client: GOVERNMENT OF NUNAVUT	Title: ENERGY MONITORING AND CONTROL
Drawn By: KD		Project: BAKER LAKE - NUNAVUT
Checked By:		WATER PUMP / CHLORINATOR FACILITY
Submitted:		GN # 07-3023
Approved:		Drawing # 2251-CS-200
		Sheet 5 of 11
		Job# 2251
		Rev 04



EMCS MOTOR PANEL
(30x24x8)

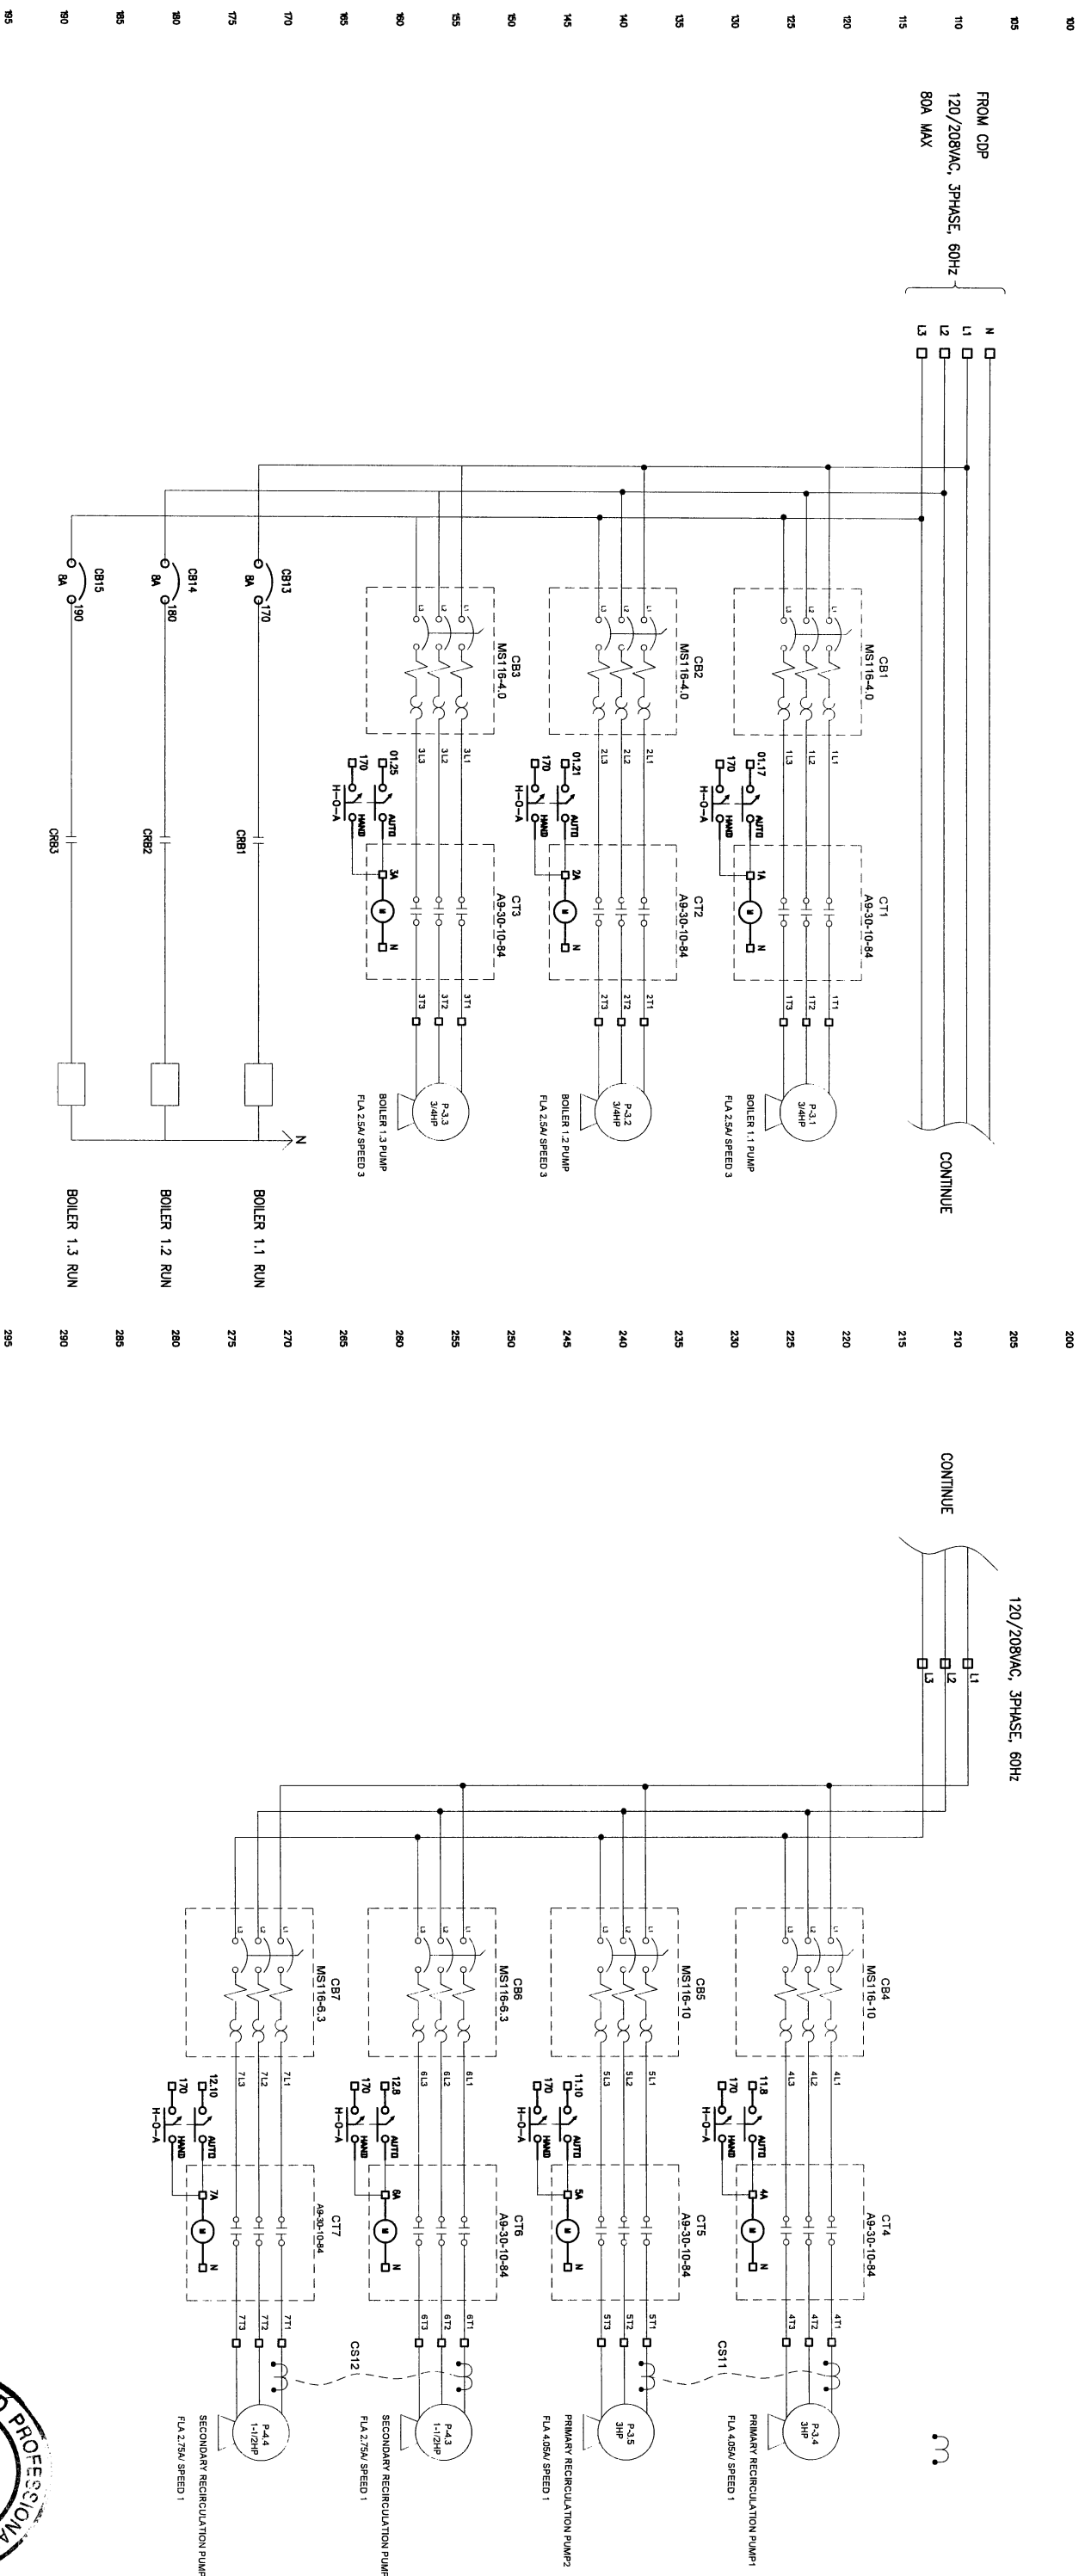


NOTES:

1. VFDs ARE MANUALLY SPEED CONTROLLED
2. CHANGE PARAMETER FOR RUNNING CONTACT USING MA & MC

Bi Pure Water (Canada) Inc. #2, 9790 - 190th Street Surrey, BC V4N 3M9 Phone: (604) 882-6650 Fax: (604) 882-6659 http://www.bipurewater.ca		THE INFORMATION CONTAINED IN THIS DRAWING IS THE SOLE PROPERTY OF BI PURE WATER (CANADA) INC. ANY REPRODUCTION IN PART OR WHOLE OF THE INFORMATION HEREIN, WITHOUT THE WRITTEN PERMISSION OF BI PURE WATER (CANADA) INC., IS STRICTLY PROHIBITED.		Status	
AS BUILT					
Issue		Date		App'd	
04		OCT 29, 13		AS BUILT - CHANGES PER SITE VISIT	
03		SEP 30, 13		GT AS BUILT	
02		MAY 30, 12		GT ISSUED FOR CONSTRUCTION	
01		APR 18, 12		GT ISSUED FOR REVIEW	
Revision Description		Approved			
Design By: JK		Checked By: KD		Client: GOVERNMENT OF NUNAVUT	
Title: ENERGY MONITORING AND CONTROL EMCS MOTOR PANEL		Project: BAKER LAKE - NUNAVUT WATER PUMP / CHLORINATOR FACILITY		Drawing #: 2251-CS-200	
Date: OCT 28 2013		Sheet: 6 of 11		Job#: 2251	
		Rev: 04			



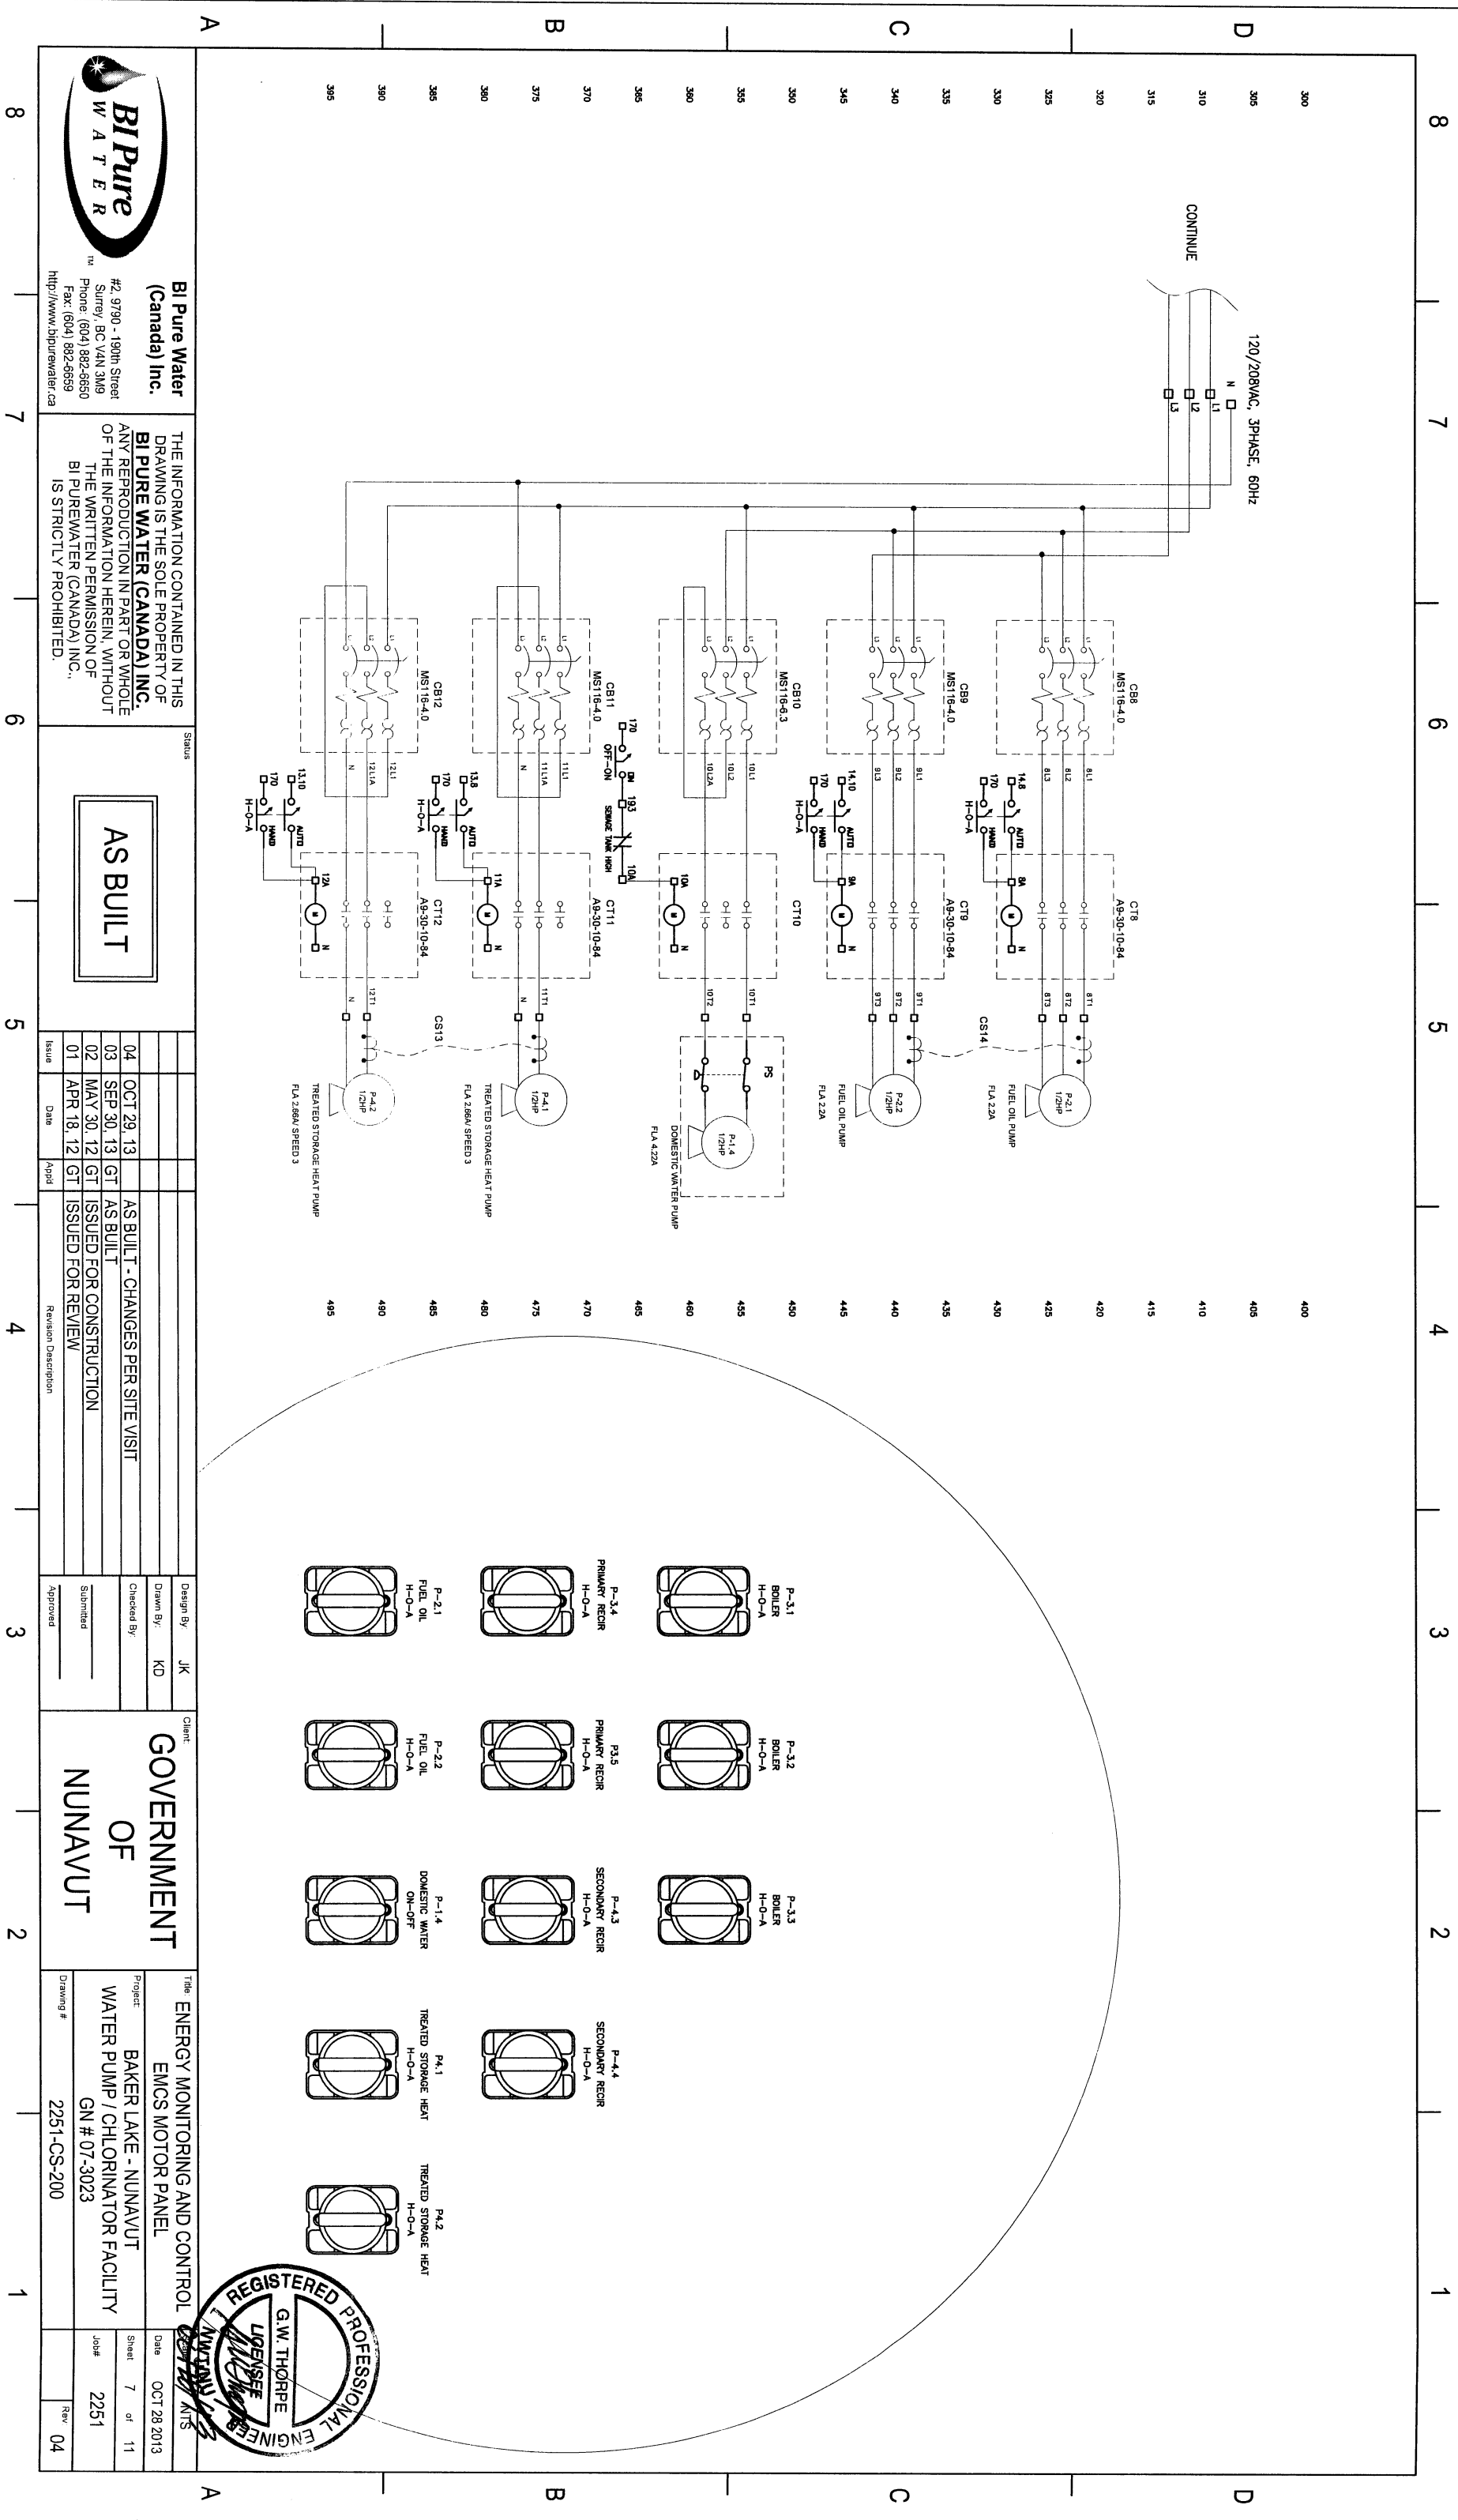



Bi Pure Water (Canada) Inc.
#2, 9790 - 190th Street
Surrey, BC V4N 3M9
Phone: (604) 882-6550
Fax: (604) 882-6559
<http://www.bipurewater.ca>

THE INFORMATION CONTAINED IN THIS DRAWING IS THE SOLE PROPERTY OF **BIPURE WATER (CANADA) INC.**
ANY REPRODUCTION IN PART OR WHOLE OF THE INFORMATION HEREIN, WITHOUT THE WRITTEN PERMISSION OF BIPURE WATER (CANADA) INC., IS STRICTLY PROHIBITED.

Status

AS BUILT

Issue	Date	Appld	Revision Description
04	OCT 29, 13		AS BUILT - CHANGES PER SITE VISIT
03	SEP 30, 13	GT	AS BUILT
02	MAY 30, 12	GT	ISSUED FOR CONSTRUCTION
01	APR 18, 12	GT	ISSUED FOR REVIEW

Design By	Checked By	Submitted	Approved
JK	KD		

Client: **GOVERNMENT OF NUNAVUT**

Title: **ENERGY MONITORING AND CONTROL EMCS MOTOR PANEL**

Project: **BAKER LAKE - NUNAVUT WATER PUMP / CHLORINATOR FACILITY**

Drawing # **2251-CS-200**



Sheet **7** of **11**

Job# **2251**

Rev **04**

Date **OCT 28 2013**



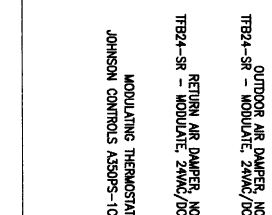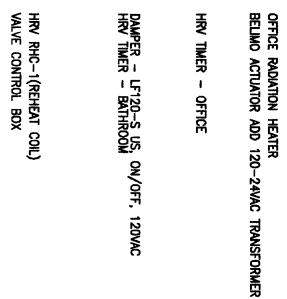

THE INFORMATION CONTAINED IN THIS DRAWING IS THE SOLE PROPERTY OF **BI PURE WATER (CANADA) INC.**. ANY REPRODUCTION IN PART OR WHOLE OF THE INFORMATION HEREIN, WITHOUT THE WRITTEN PERMISSION OF BI PURE WATER (CANADA) INC., IS STRICTLY PROHIBITED.

AS BUILT


Design By:	JK
Drawn By:	KD
Checked By:	
Submitted	
Approved	

Client:
GOVERNMENT
OF
NUNAVUT

Date	OCT 28 2013
Sheet	8 of 11
Job#	2251
Rev	04



CHLORINE ROOM EXHAUST CONTROL PANEL
(20x16x8)

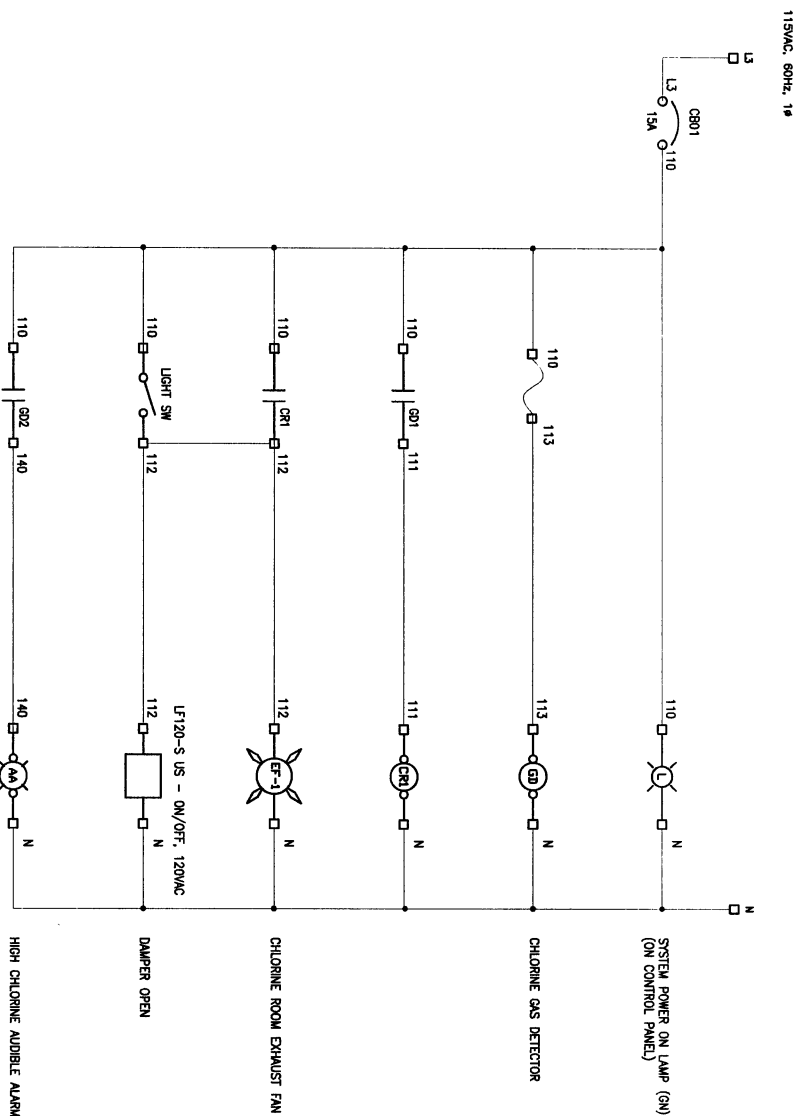

NOTES:

1. USE SINGLE THROW DOUBLE POLE SWITCH FOR EXHAUST FAN. ONE FOR LIGHT, THE OTHER FOR FAN



BI Pure Water
(Canada) Inc.
#2, 9790 - 190th Street
Surrey, BC V4N 3M9
Phone: (604) 882-8550
Fax: (604) 882-8559
<http://www.bipurewater.ca>

THE INFORMATION CONTAINED IN THIS DRAWING IS THE SOLE PROPERTY OF **BI PURE WATER (CANADA) INC.**. ANY REPRODUCTION IN PART OR WHOLE OF THE INFORMATION HEREIN, WITHOUT THE WRITTEN PERMISSION OF BI PURE WATER (CANADA) INC., IS STRICTLY PROHIBITED.

Status

Issue	Date	Appd	Revision Description
04	OCT 29, 13	JK	AS BUILT - CHANGES PER SITE VISIT
03	SEP 30, 13	GT	AS BUILT
02	MAY 30, 12	GT	ISSUED FOR CONSTRUCTION
01	APR 18, 12	GT	ISSUED FOR REVIEW

Client:

GOVERNMENT OF NUNAVUT

Title:

ENERGY MONITORING AND CONTROL
CHLORINE ROOM EXHAUST FAN CONTROL

Project:

BAKER LAKE - NUNAVUT
WATER PUMP / CHLORINATOR FACILITY
GN # 07-3023

Drawing #

2251-CS-200

Design By:

JK

Drawn By:

KD

Checked By:

Submitted

Approved

Sheet

9 of 11


Job#

2251

Rev

04





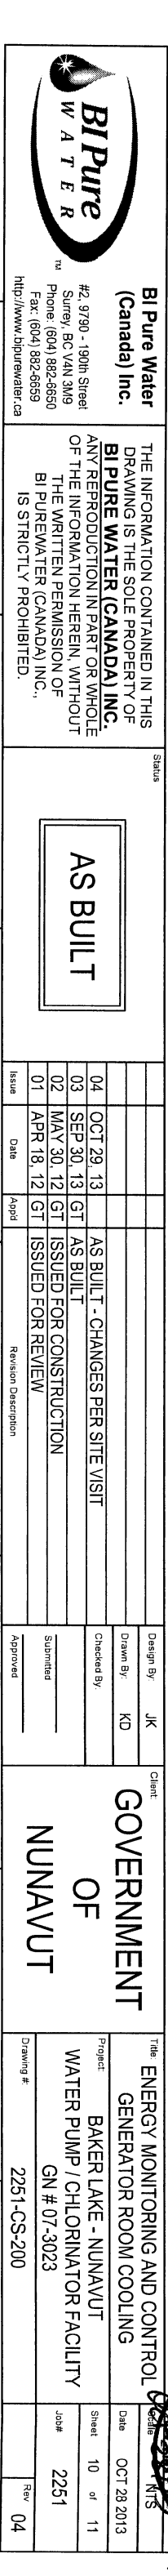

C. OFF: CLOSE AND DISABLE ACUAIOR

Client	Title			
GOVERNMENT OF NUNAVUT	ENERGY MONITORING AND CONTROL			
	GENERATOR ROOM COOLING			
	Project: BAKER LAKE - NUNAVUT			
	WATER PUMP / CHLORINATOR FACILITY			
	GN # 07-3023			
Drawing #	2251-CS-200			
			Sheet	10 of 11
			Issue	2251
			Rev	04

Scale	1/8" = 1' NTS
Date	OCT 28 2013
Sheet	10 of 11
Job#	2251
Rev	04

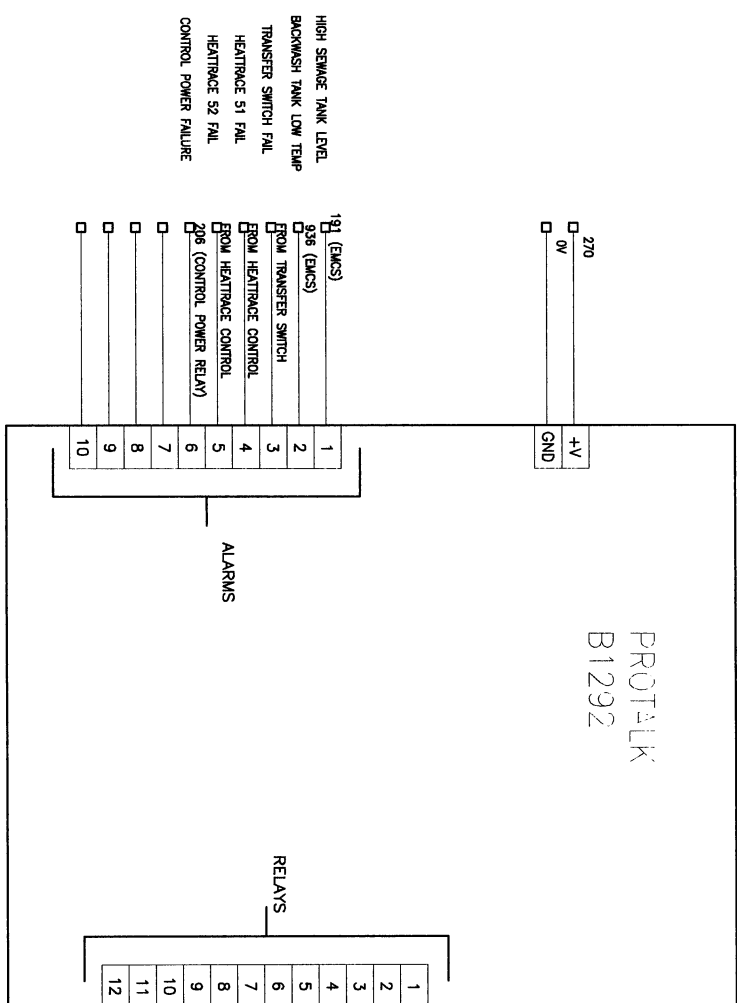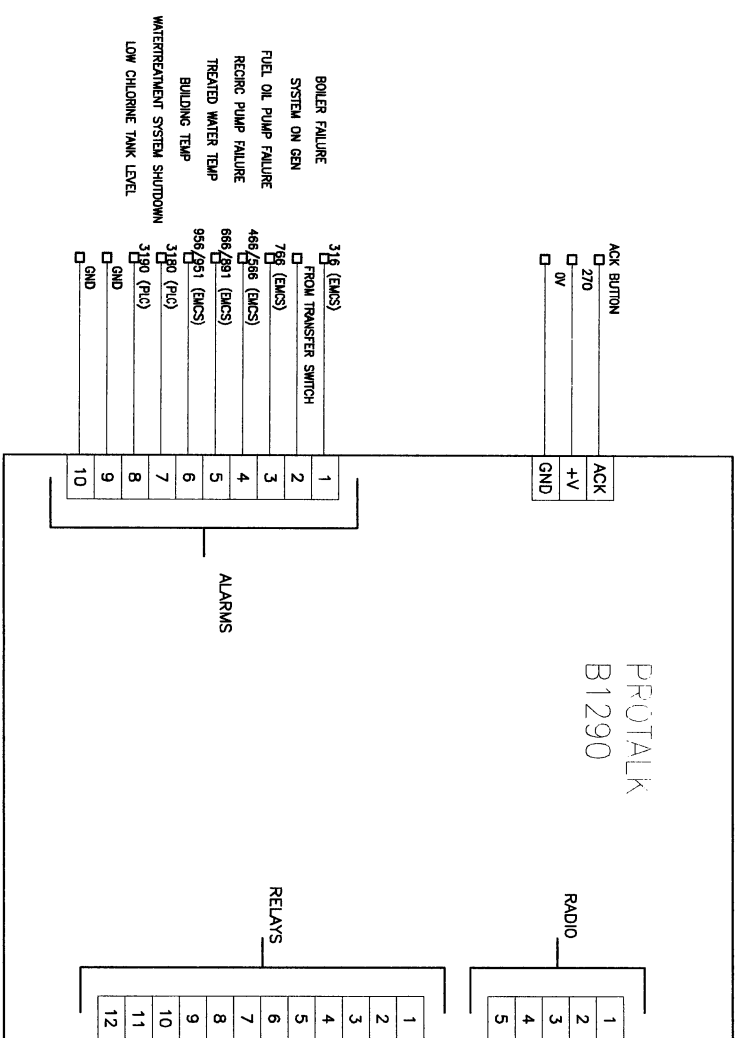[illegible]