



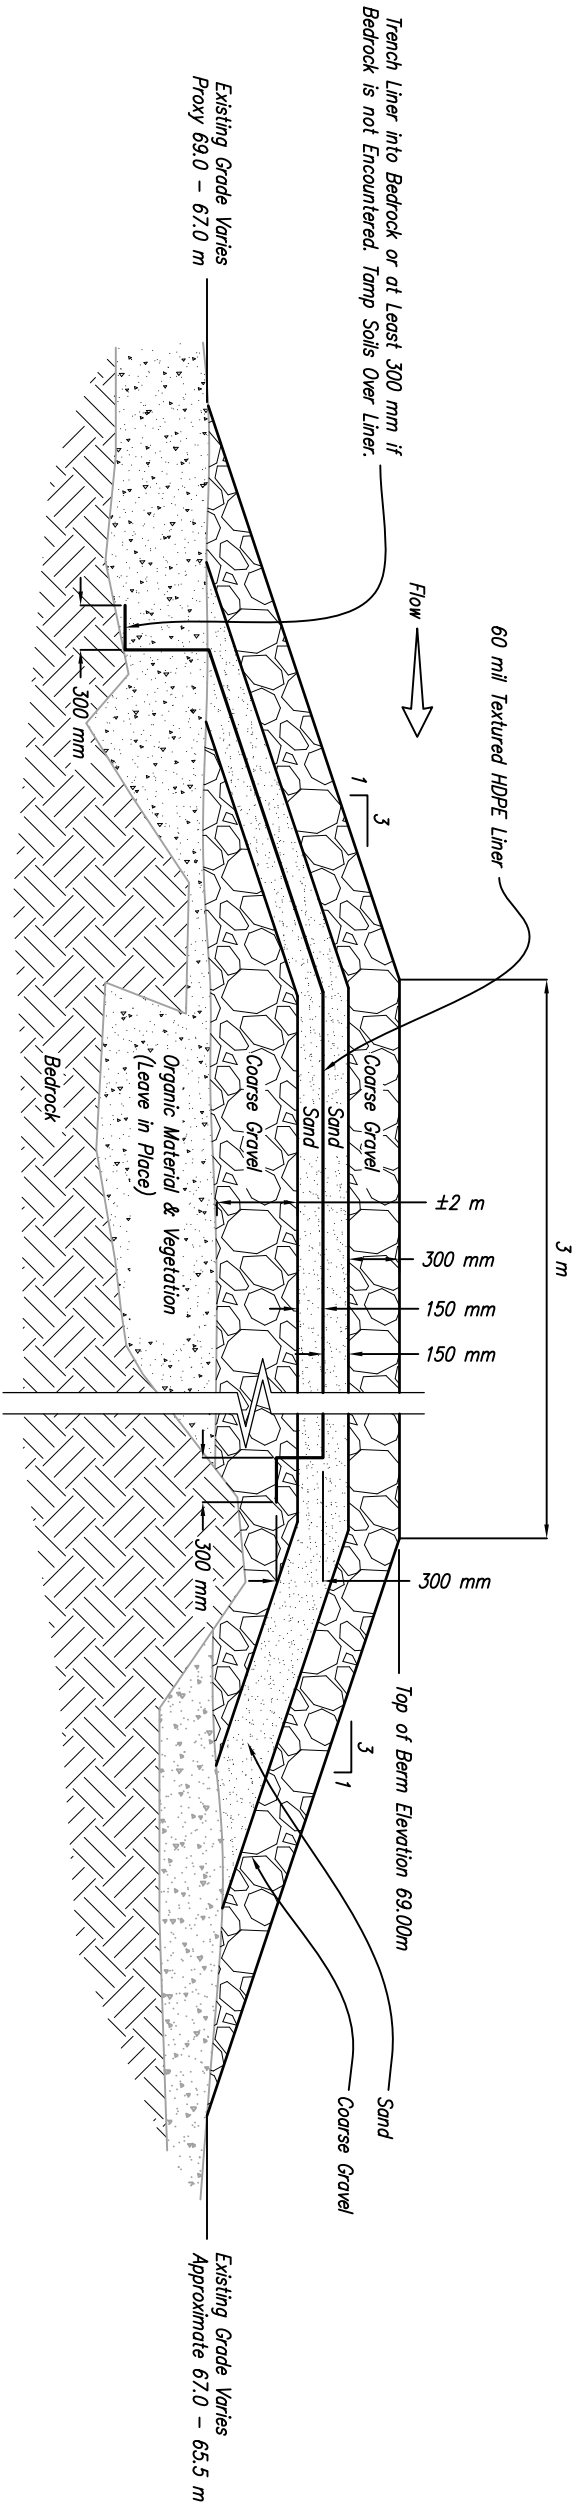

Holding Cell Berm Cross Section – A
Scale: None

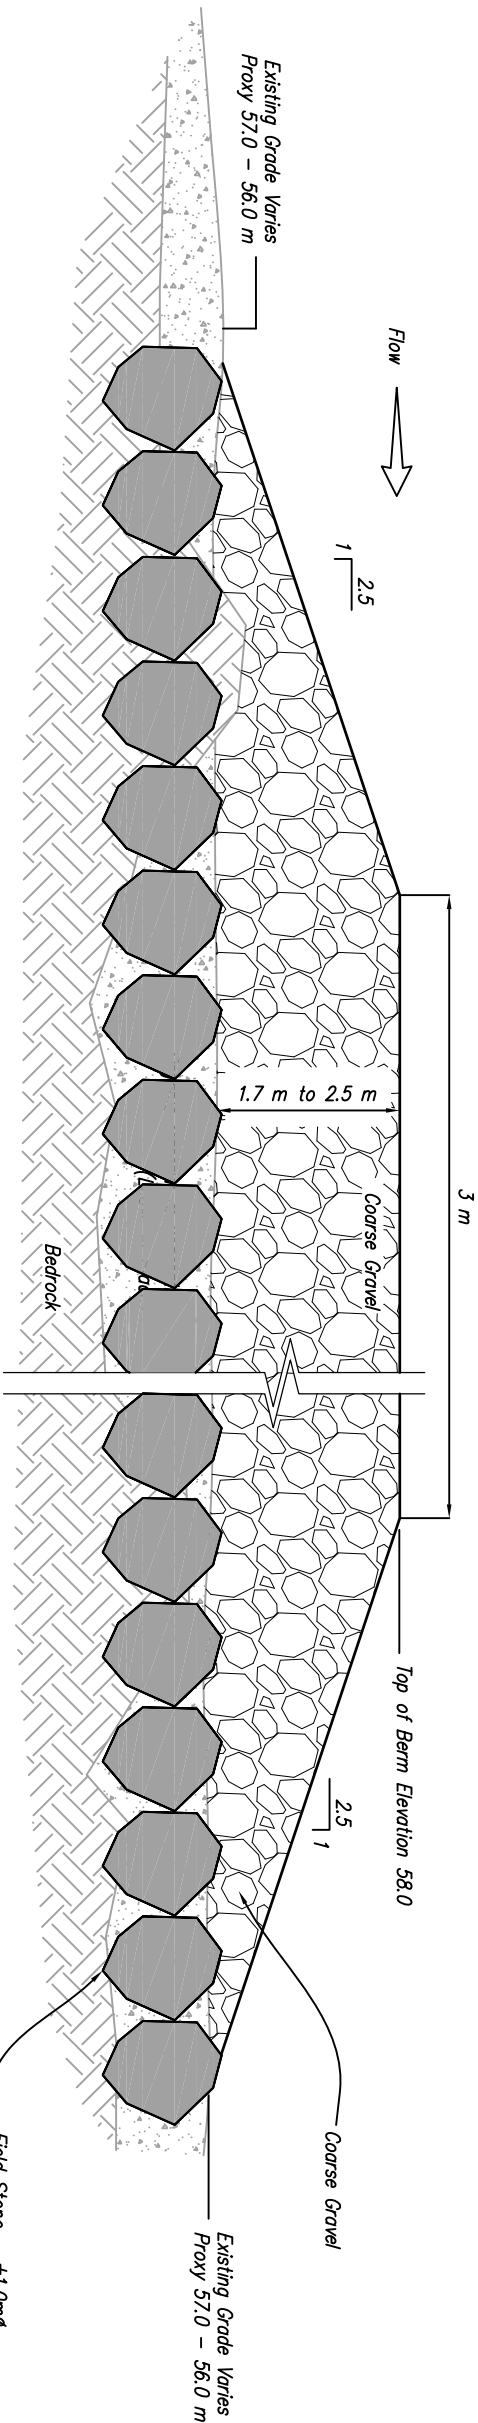

Typical Flow Attenuation Berm (Type 1) Cross Section – B
Scale: None

Note: Sand, Coarse Gravel and Field Stone Shall Meet the Applicable Specifications: 31 05 17, 31 24 13 and 32 11 23.



Stantec
4444 Centerville Road, Suite 140
White Bear Lake, MN 55127
651-255-5050
651-255-5060 (fax)



Rev	Date	Description
8	11/03/11	Record Drawing

GOVERNMENT OF NUNAVUT
DEPARTMENT OF COMMUNITY AND GOVERNMENT SERVICES
**BAKER LAKE SEWAGE SYSTEM
IMPROVEMENTS**
QAMAMITUAG, NUNAVUT

Berm Cross Sections

C-7