




FENCE ELEVATION

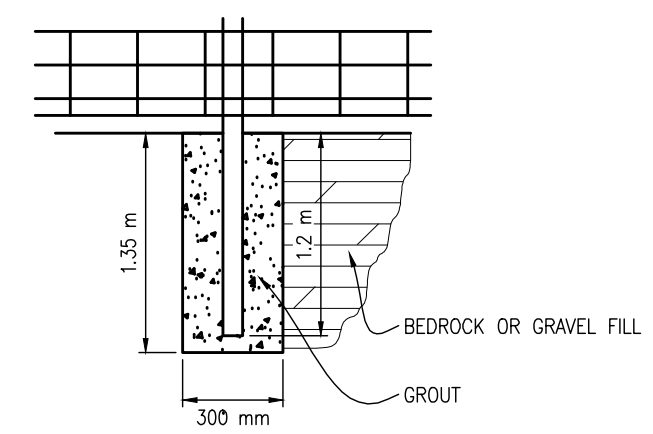

BEDROCK FOOTING DETAIL

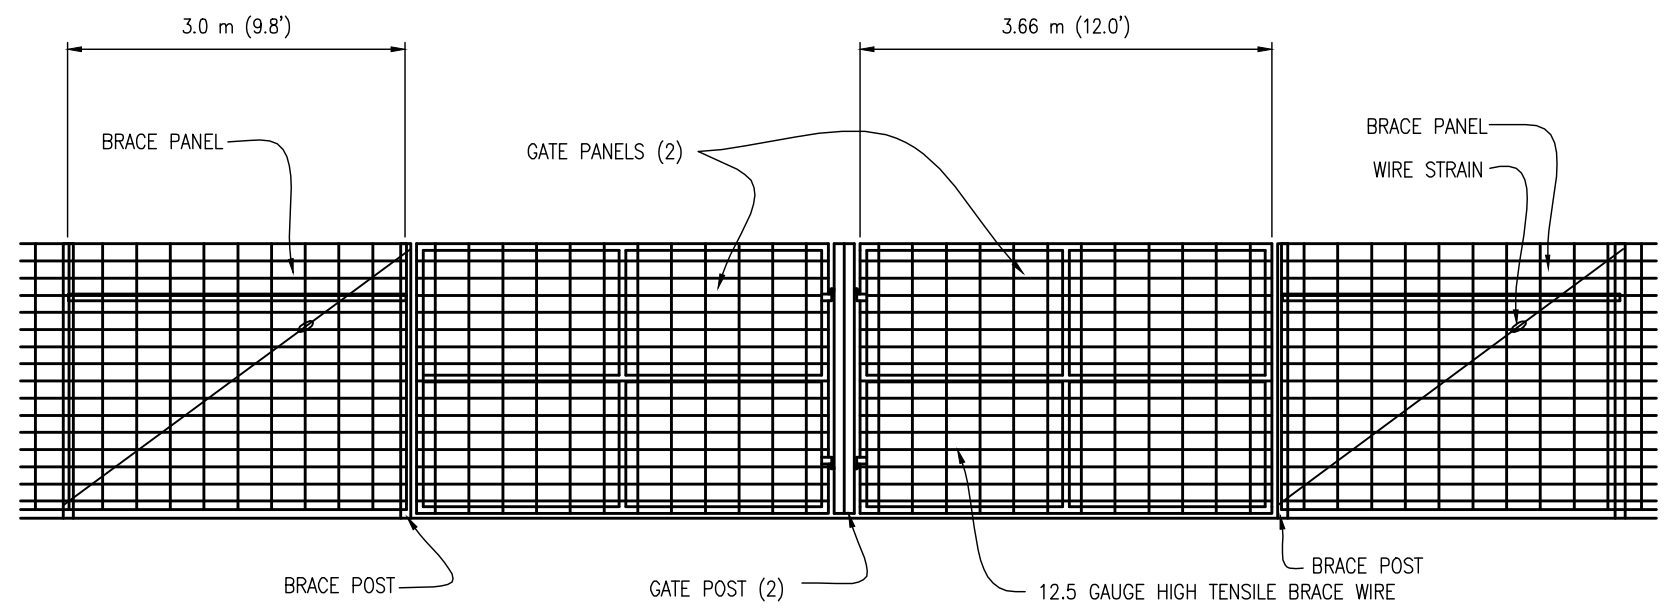

GATE DETAIL

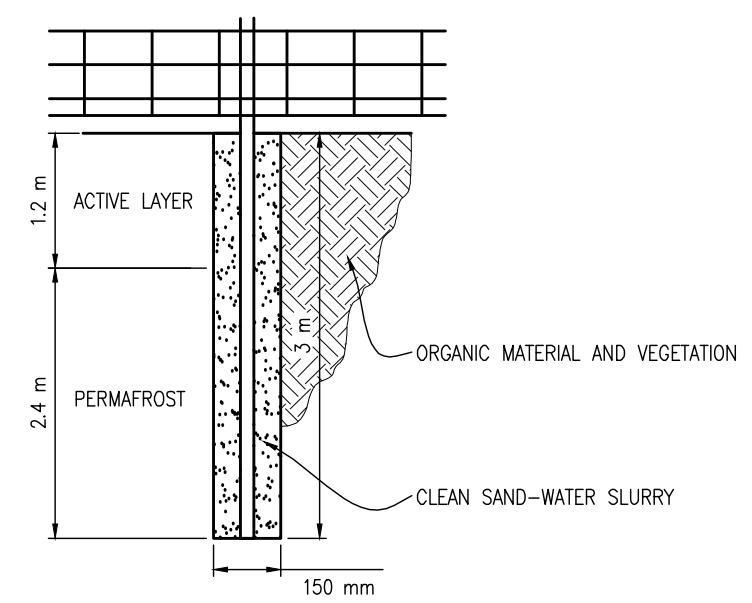

NON BEDROCK FOOTING DETAIL

NOTES

1. FENCE TO BE TIED TO POST A MINIMUM OF 4 SPOTS EACH POST.
2. FENCE SHALL BE TIED AT TOP OF EACH POST.
3. APPLY GREASE OR WAX TO THE FENCE POST WITHIN THE ACTIVE LAYER FOR NON BEDROCK FOOTING INSTALLATIONS.
4. CLEAN SAND SLURRY SHALL BE MIXED WITH COLD WATER. SLURRY SHALL HAVE A CONSISTENCY THAT WILL GIVE ABOUT A 152 MM (6 INCH) SLUMP.
5. PROVIDE ANNULAR SPACE OF 50 TO 100 MM AROUND FENCE POSTS FOR NON BEDROCK FOOTING INSTALLATIONS.

Plot Date: 20 November 2011 By: Wagner, Richard



**Stantec**  
4444 Centerville Road, Suite 140  
White Bear Lake, MN 55127  
651-255-5050  
651-255-5060 (fax)



2	06/27/11	Record Drawing
1	7/09/08	Issue for Tender
0	7/01/08	Issue for Review
Rev	Date	Description

GOVERNMENT OF NUNAVUT  
DEPARTMENT OF COMMUNITY AND GOVERNMENT SERVICES  
**BAKER LAKE SEWAGE SYSTEM  
IMPROVEMENTS**  
QAMANI'TUAQ, NUNAVUT

*Figure 2*  
**Fence Details**

**Figure 2**