

PILE LOAD SUMMARY

Load (kN)	Grid Line								Grid Line
	A	B	C	D	E	F	G	H	
Total Vertical	90	100	90	80	100	120	120	80	1
Service Load	30	32	30	26	36	46	45	26	
Snow Load	13	13	13	13	13	13	13	13	
Lateral Wind	5	4	4	4	4	4	4	5	
Total Vertical	110	120	110	100	120	140	140	100	2
Service Load	33	38	33	28	38	46	47	27	
Snow Load	21	21	21	21	21	21	21	21	
Lateral Wind	5	4	4	4	4	4	4	5	
Total Vertical	70	100	90	80	70	70	80	70	3
Service Load	21	34	31	26	22	22	26	21	
Snow Load	13	13	13	13	13	13	13	13	
Lateral Wind	5	4	4	4	4	4	4	5	

Legend

8.0 m

Denotes minimum embedment below grade for 141 mm diameter adfreeze pile

Note

If bedrock is encountered before indicated depth is reached, end-bearing may be included. Pile embedment may be reduced to 7.5 m or 1.0 m into rock, whichever is deeper.

Estimated Adfreeze Pile Design Parameters


Active Layer 2 m
Porewater Salinity 1 ppt
Mean Annual Ground Temperature -4.3 °C
Allowable Creep Settlement 30 mm in 30 years
Factor of Safety 2.0
EBA Reference File: Y14101354

Allowable Adfreeze Bonds (kPa)

Pile Diameter 141 mm

Long Term Loads 30
- Dead Load & Sustained Live Load
Combined Long Term & Short Term Loads 55
- Including Environmental Loads

Pile layout and loads derived from Drawing 2351-ST-301 Rev 02
Baker Lake - Nunavut Potable Water Supply System
by BI Pure Water (Canada) Inc.,
Issued for Approval, March 24, 2012

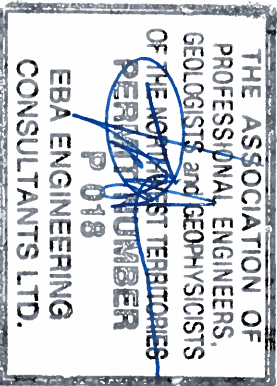

**PILE DESIGN
FOR WATER TRUCKFILL PLANT
BAKER LAKE, NT**


**PILE DESIGN AND
CONSTRUCTION PARAMETERS**

PROJECT NO. Y14101499
DATE October 2012


DWN MM
CHK TEH
REV 1

Figure 1


Q:\Edmonton\Drafting\PROJECTS\Y14\Y14101499\acad\Y14 101499 Figure 1-3.dwg [FIGURE 3] October 02, 2012 - 4:38:35 pm (BY: LEE, ELVIN)

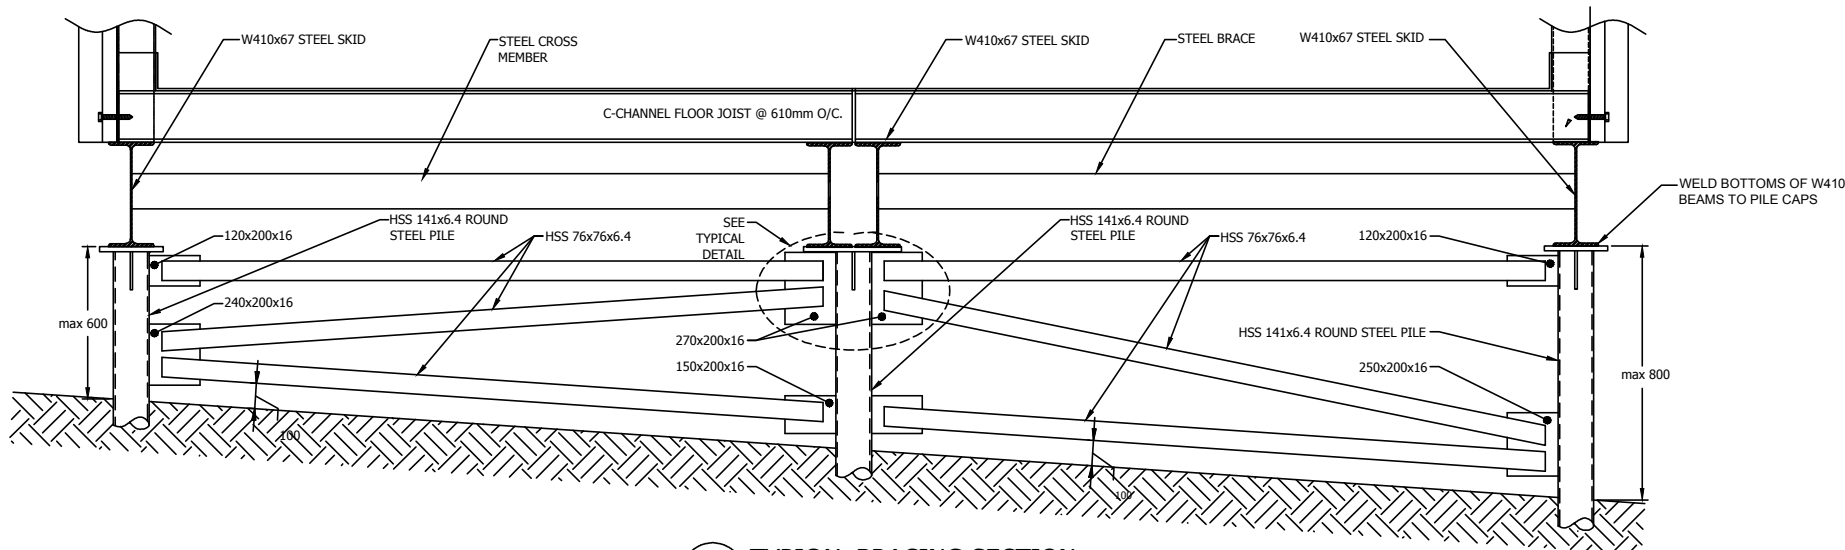


1 TYPICAL BRACING SECTION
1:15

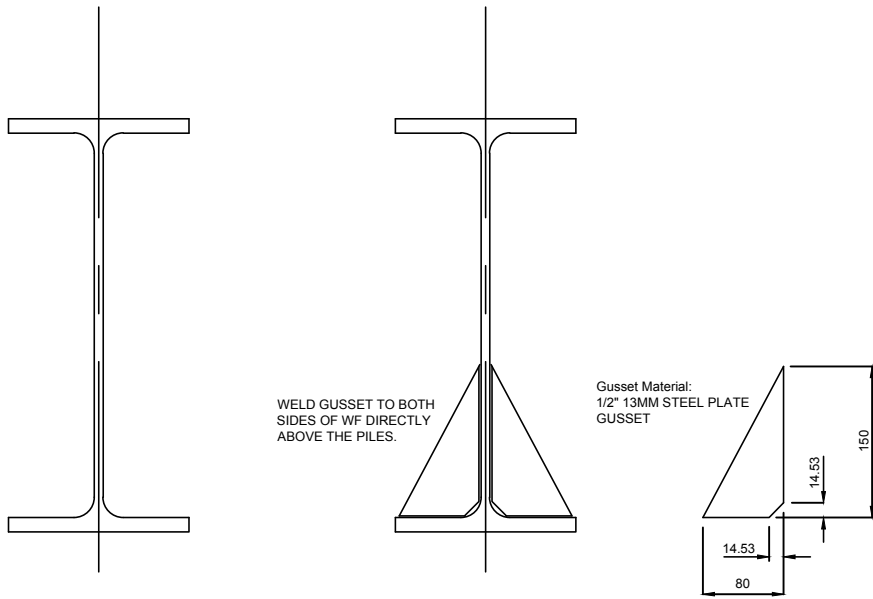

2 TYPICAL STIFFENER DETAIL
N.T.S.

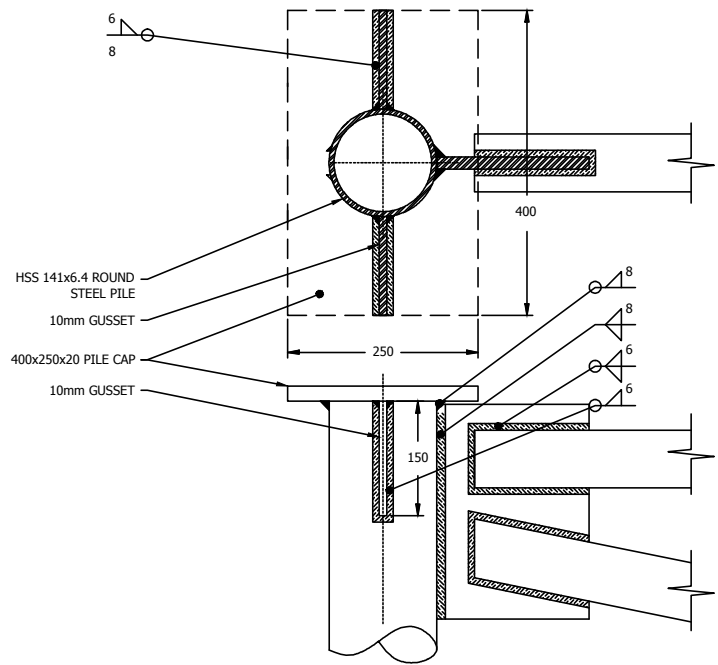

3 OUTER ROWS BRACING CONNECTION
1:5

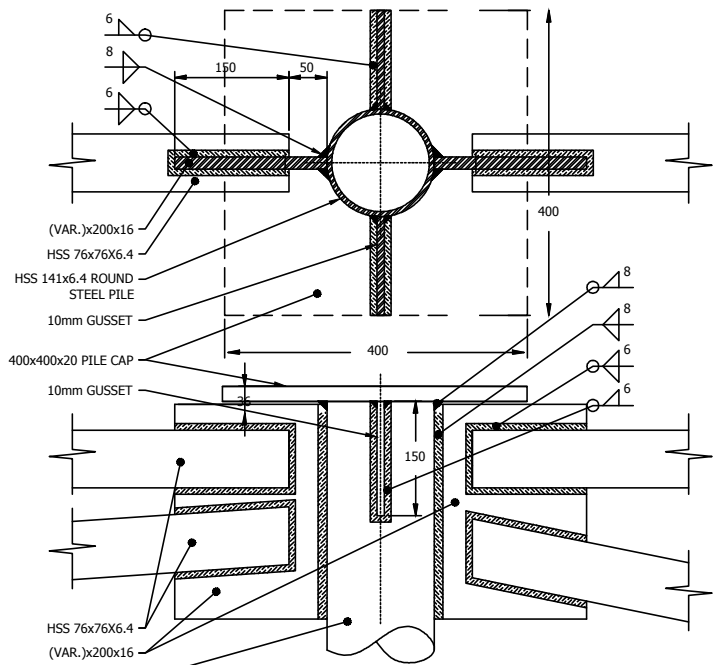

4 MIDDLE ROW BRACING CONNECTION
1:5

GENERAL


1. ALL WORK SHALL BE PERFORMED IN ACCORDANCE WITH NATIONAL BUILDING CODE OF CANADA 2010, THE GNWT SAFETY ACT AND ENVIRONMENTAL REGULATIONS.
2. ALL DIMENSIONS AND ELEVATIONS ARE IN MILLIMETRES (mm) UNLESS NOTED OTHERWISE. VERIFY ALL DIMENSIONS AND ELEVATIONS IN THE FIELD AND REPORT ANY DISCREPANCIES.



LOADING

1. ALL LOADS AND FORCES SHOWN ARE SERVICE (UNFACTORED) LOADS IN KILOPASCALS (kPa) AND KILONEWTONS (kN) UNLESS NOTED OTHERWISE.
2. MAXIMUM SERVICE LOADS FOR THE PILES WAS OBTAINED FROM FIGURE 1, "PILE DESIGN FOR WATER TRUCK FILL PLANT, BAKER LAKE, NT. EBA CONSULTANTS, MAY 7, 2012.
3. ENVIRONMENTAL LOADS NBC 2010 BAKER LAKE, NU.
 - GROUND SNOW LOAD $S_s = 2.9$ KPA
 - RAIN LOAD $S_r = 0.2$ KPA
 - ONE DAY RAIN 55 MM
 - UNIFORM SNOW $S = 0.8(2.9) + 0.2 = 2.52$ KPA
- WIND - BUILDING CATEGORY II
 - Q(1/50) HOURLY PRESSURE 0.54 KPA
 - Q(1/10) HOURLY PRESSURE 0.42 KPA
4. SEISMIC
 - $S_a(0.2) = 0.095$, $S_a(0.5) = 0.057$, $S_a(1.0) = 0.027$, $S_a(2.0) = 0.008$, $PGA = 0.036$
 - FOUNDATION CLASS B, $F_a = (0.8)$
 - NBC 4.4.8.4.(6) IF $S(0.2) = F_a * S_a(0.2) \leq 0.12$ THEN SEISMIC CAN BE NEGLECTED
 - $S(0.2) = 0.076 < 0.12$ THEREFORE SEISMIC NEED NOT BE CONSIDERED
5. MAXIMUM SERVICE LOADS FOR THE PILES WAS OBTAINED FROM FIGURE 1, "PILE DESIGN FOR WATER TRUCK FILL PLANT, BAKER LAKE, NT. EBA CONSULTANTS, MAY 7, 2012.
6. THE FOUNDATION DESIGN IS BASED ON DRILLED ADFREEZE PILES WITH AN ALLOWABLE BOND CAPACITY OF 50 KPA INSTALLED A MINIMUM OF 1 M INTO BEDROCK WITH THE DETAIL PROVIDED.

MATERIALS

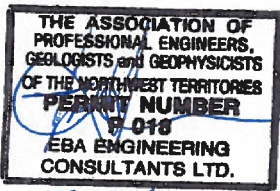1. ALL PILES WILL BE HSS 141 O.D. X 6.35 WT GRADE 350W CLASS C
2. PLATES AND MISC STEEL WILL BE 300W



CLIENT		PILE DESIGN FOR WATER TRUCKFILL PLANT BAKER LAKE, NT				
		PILE CAP AND CROSS-BRACING DETAILS				
 A TETRA TECH COMPANY	PROJECT NO. Y14101499	DWN EL	CKD TEH	REV 0	Figure 3	
	OFFICE EDM	DATE September 2012				