
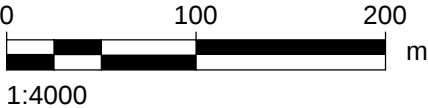


Appendix A:

As-built drawing of facilities showing monitoring location

Cambridge Bay Water Licence 3BM-CAM0914

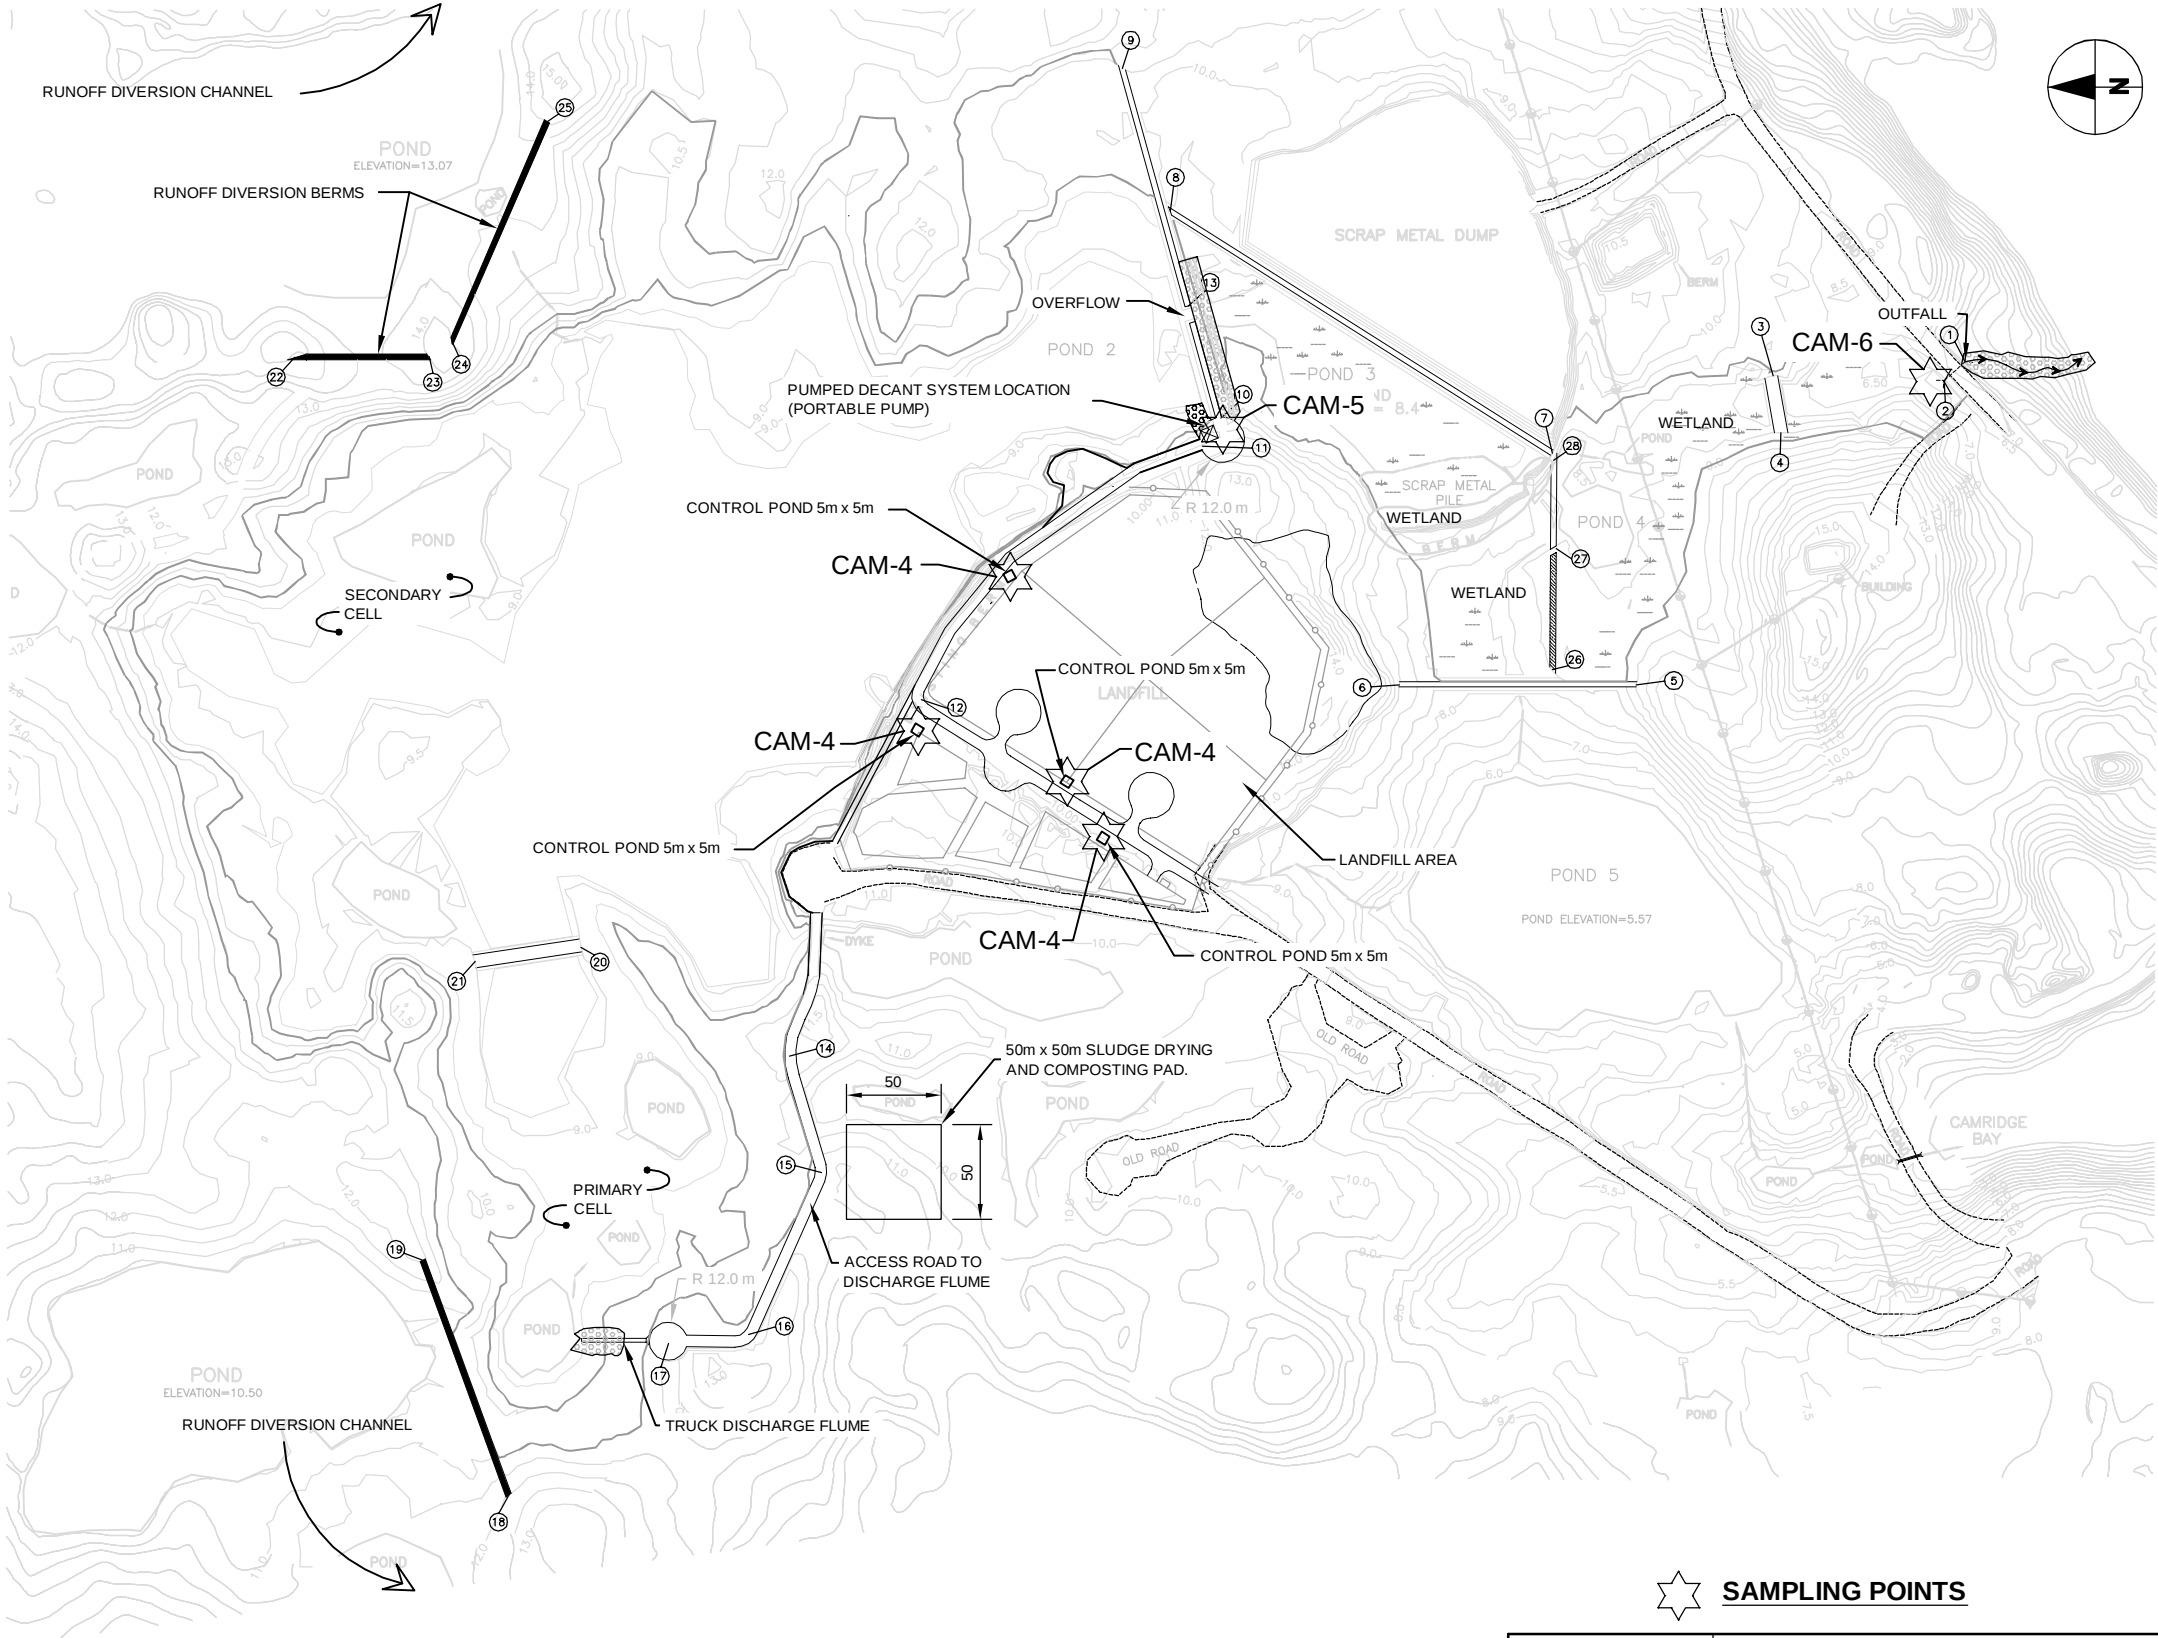

 SAMPLING POINTS

SAMPLING LOCATION	DESCRIPTION
CAM-4	EFFLUENT FROM MODIFIED SOLID WASTE DISPOSAL FACILITIES BEING DISCHARGED TO THE RETENTION SEWAGE LAGOON
CAM-5	FINAL DISCHARGE POINT FOR EFFLUENT FROM THE RETENTION SEWAGE LAGOON TO THE SEWAGE WETLAND
CAM-6	OUTFALL AREA FOR THE SEWAGE WETLAND

LEGEND

EDGE OF ROAD (ELEV. 10.0m)	
DRAINAGE ROUTE	
RIP-RAP	
SEWAGE LAGOON/WETLAND BERM	
RUNOFF DIVERSION BERM	
OPEN WATER SECTION OF WETLAND	
FREE BOARD	
MAX OPERATION WATER LEVEL	
OPEN WATER SECTION	
SAMPLE POINT	

NOTES:

ELEVATIONS ARE EXPRESSED IN METER OR DECIMALS THEREOF.

CAM-4 SAMPLING LOCATION(S) CONSIST OF ANY LOCATION(S) WHERE LIQUID ORIGINATING IN THE LANDFILL AREA IS DISCHARGED TO THE LAGOON.

BERM LOCATION POINTS

BERM POINTS	NORTHING	EASTING
1	7667952.67	498928.34
2	7667964.75	498917.18
3	7668055.83	498919.56
4	7668050.75	498889.87
5	7668126.82	499757.16
6	7668252.15	498757.16
7	7668170.48	498878.77
8	7668372.90	499006.76
9	7668397.97	499082.42
10	7668347.00	498898.03
11	7668357.13	498883.20
12	7668505.96	498748.79
13	7668363.63	498956.63
14	7668573.61	498560.76
15	7668557.39	498499.29
16	7668597.34	498411.69
17	7668638.10	498410.28
18	7668722.31	498329.19
19	7668767.59	498452.94
20	7668684.04	498619.15
21	7668740.07	498610.20
22	7668835.17	498930.79
23	7668764.43	498930.23
24	7668752.28	498938.93
25	7668702.41	499054.24
26	7668171.72	498764.31
27	7668171.12	498829.37
28	7668170.48	498878.77
29	7667956.60	498915.42
30	7667970.84	498901.51