




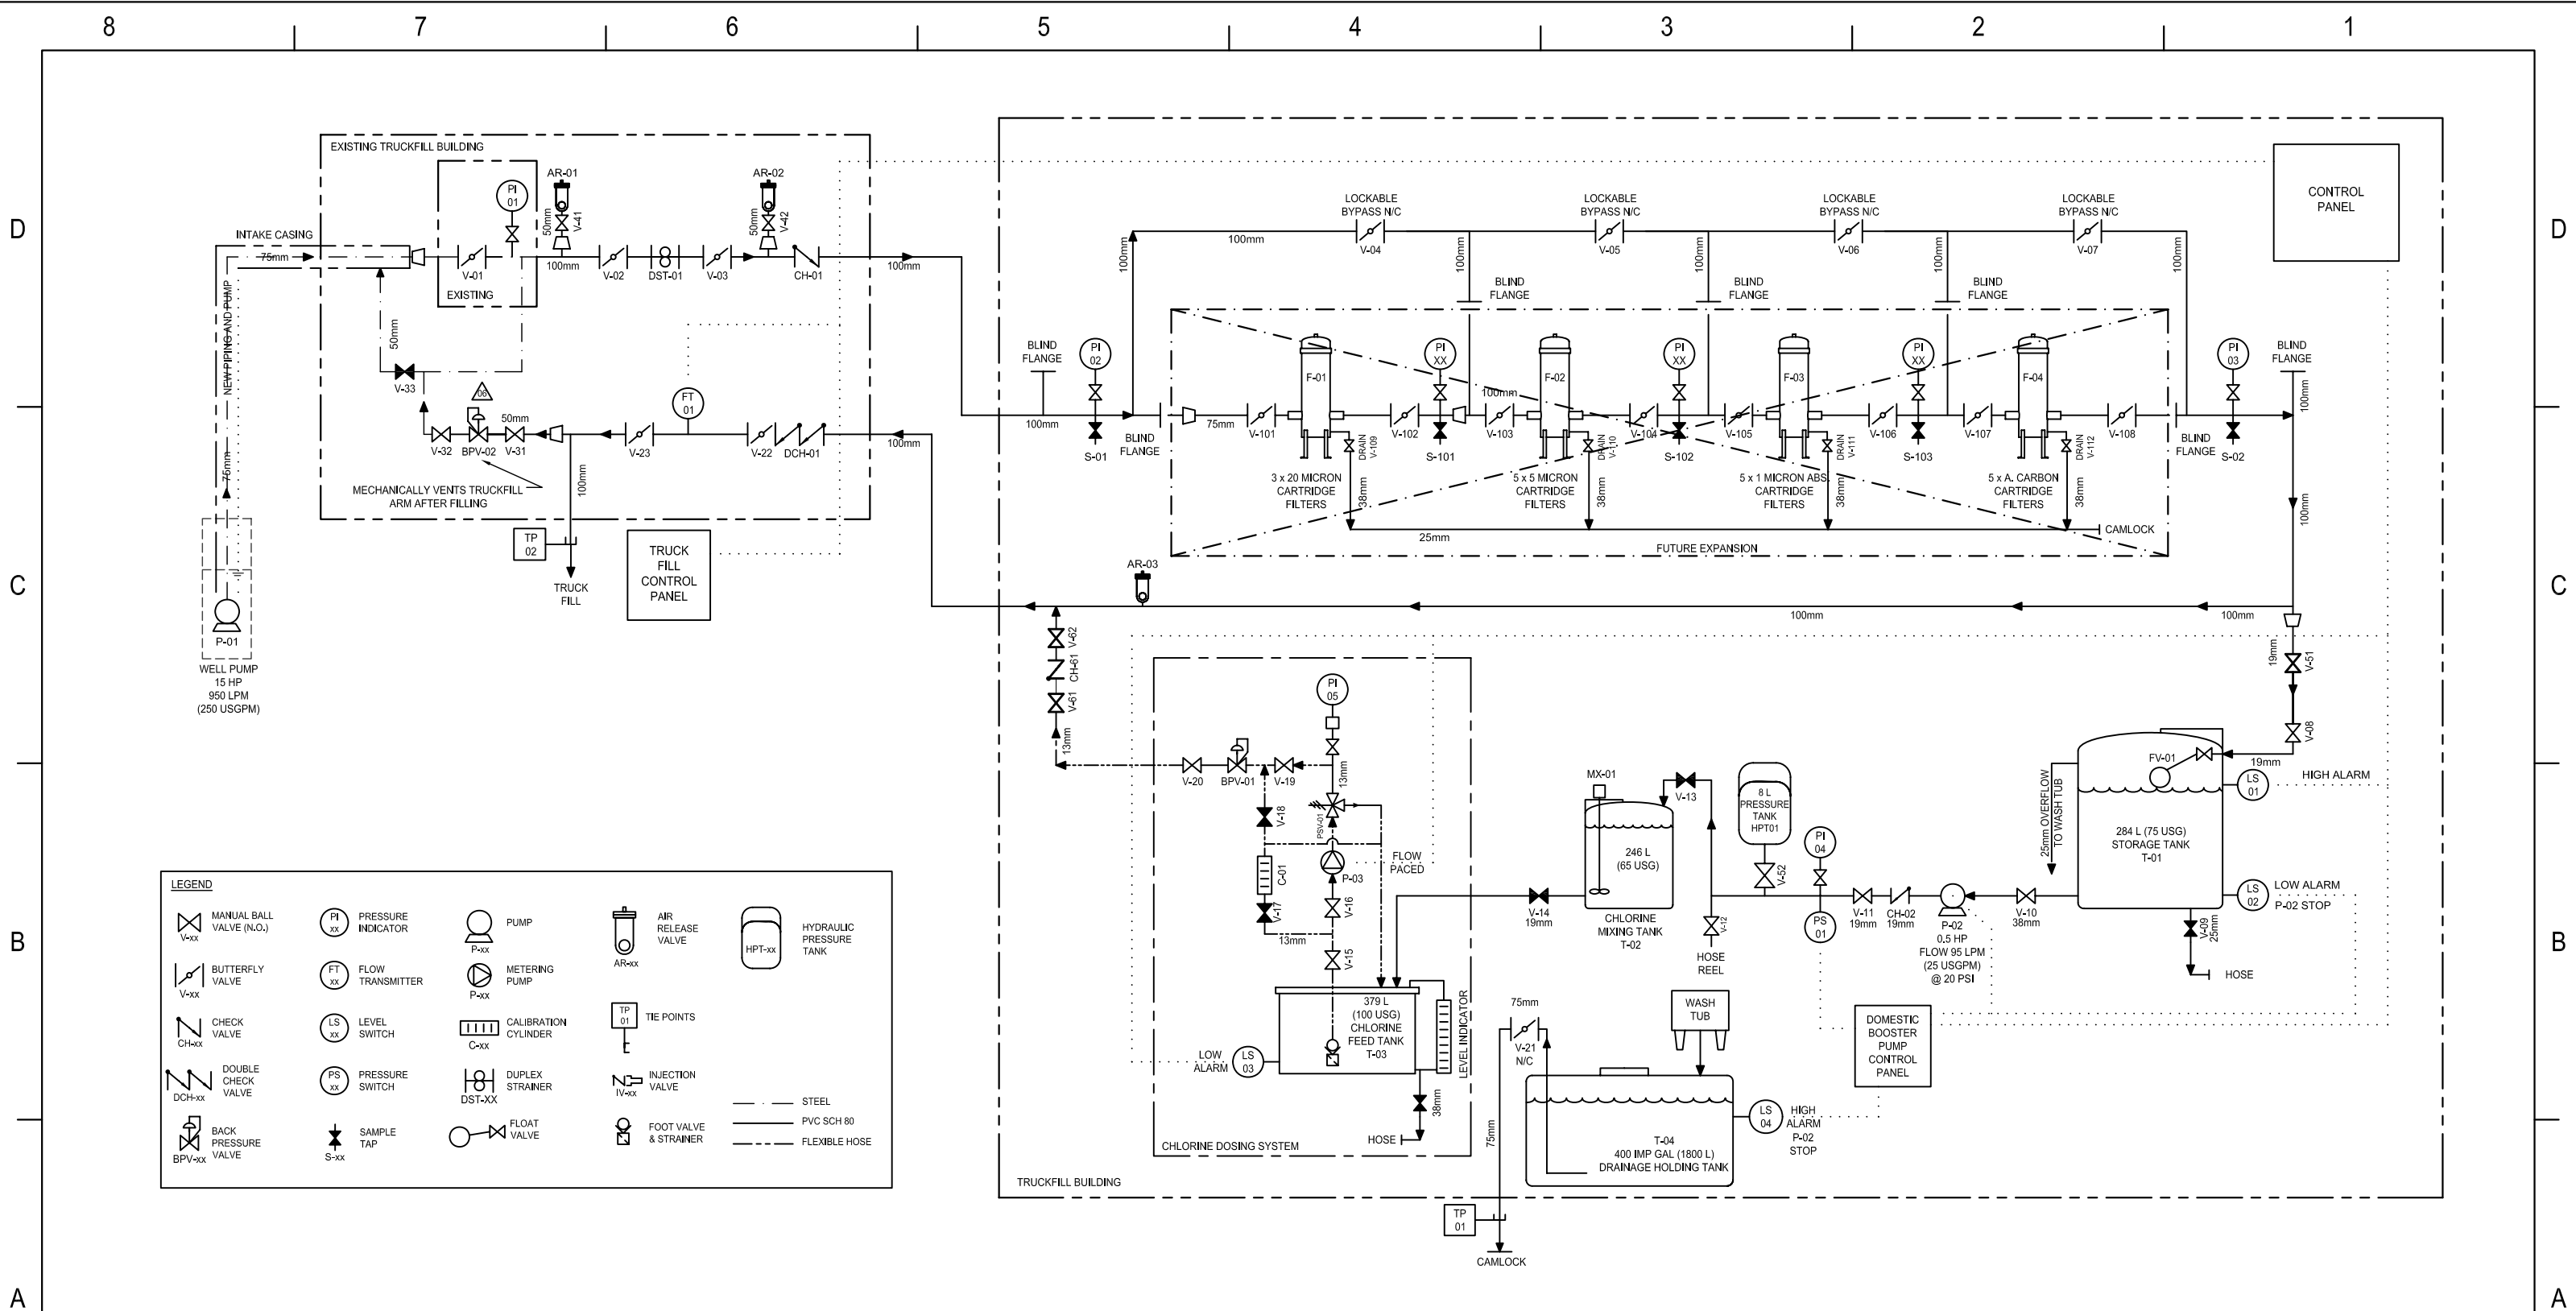

BI Pure Water (Canada) Inc.

#2, 9790 - 190th Street
Surrey, BC V4N 3M9
Phone: (604) 882-6650
Fax: (604) 882-6659
<http://www.bipurewater.ca>

THE INFORMATION CONTAINED IN THIS DRAWING IS THE SOLE PROPERTY OF **BI PURE WATER (CANADA) INC.** ANY REPRODUCTION IN PART OR WHOLE OF THE INFORMATION HEREIN, WITHOUT THE WRITTEN PERMISSION OF BI PUREWATER (CANADA) INC., IS STRICTLY PROHIBITED.

Status

AS BUILT

Issue	Date	Appld	Revision Description
06	JUN 7/12		AS-BUILT
05	JUN 28/10	JT	ISSUED FOR CONSTRUCTION
04	MAR 16/10	GT	REVISED FOR REVIEW
03	NOV 16/09	JT	REVISED FOR REVIEW
02	APR 21/09	GT	REVISED FOR REVIEW
01	APR 08/09	GT	ISSUED FOR REVIEW

Design By: GT

Drawn By: JT

Checked By:

Submitted

Approved

Client:

GOVERNMENT OF NUNAVUT

Title: MAIN PROCESS DIAGRAM

Scale: NTS

Date: APR 8, 09

Project: POTABLE WATER TREATMENT PLANT CHESTERFIELD INLET

Sheet: 1 of 1

Job#: 1472

Drawing #: 1472-PI-101

Rev: 06