


AS-CONSTRUCTED
2011

PERMIT OF PRACTICE
TROW ASSOCIATES INC.
Signature _____
Date _____
PERMIT NUMBER: P84
The Association of Professional Engineers
Geologists and Geophysicists of the NWT/NU

BENCH MARK
BM 1 ELEV. = 65.16
RE-BAR SET NEAR THE INTERSECTION OF THE LAGOON ACCESS
ROAD AND METAL DUMP ACCESS ROAD, NORTH-EAST OF THE
LAGOON SITE.

No.	DESCRIPTION	DATE	BY	APP'D
5	AS-CONSTRUCTED 2011	18/11/11	MEB	SLB
4	AS-CONSTRUCTED	02/12/10	MEB	SLB
3	ISSUED FOR CONSTRUCTION	15/06/09	MMR	SLB
2	REVISED FOR TENDER	28/05/08	MMR	SLB
1	ISSUED FOR TENDER	28/04/08	MMR	SLB
REVISIONS				

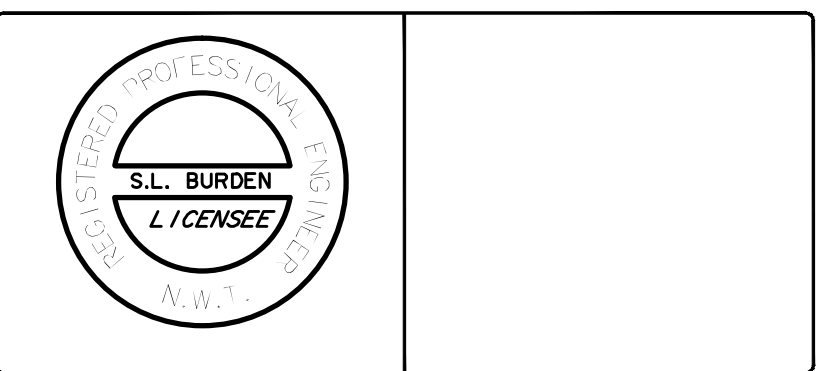

Trow Associates Inc.
154 Colonnade Road South
Ottawa, Ont. K2E 7J5
Tel: (613) 225-9940
Fax: (613) 225-7337

CLIENT
GOVERNMENT OF NUNAVUT

PROJECT CLYDE RIVER WASTEWATER LAGOON	
TITLE OVERALL SITE PLAN	
design by SAD	project no. OTCD00019055A
drawn by MEB	drawing no.
checked by SLB	
date 30/08/2007	
scale HORIZ 1:1500	

SP-1

NOTES
CONTOUR INFORMATION WAS DERIVED BY TROW ASSOCIATES INC.
SURVEY DATED AUGUST 23, 2007.
CONTOUR INTERVALS ARE SET AT 1.00m