


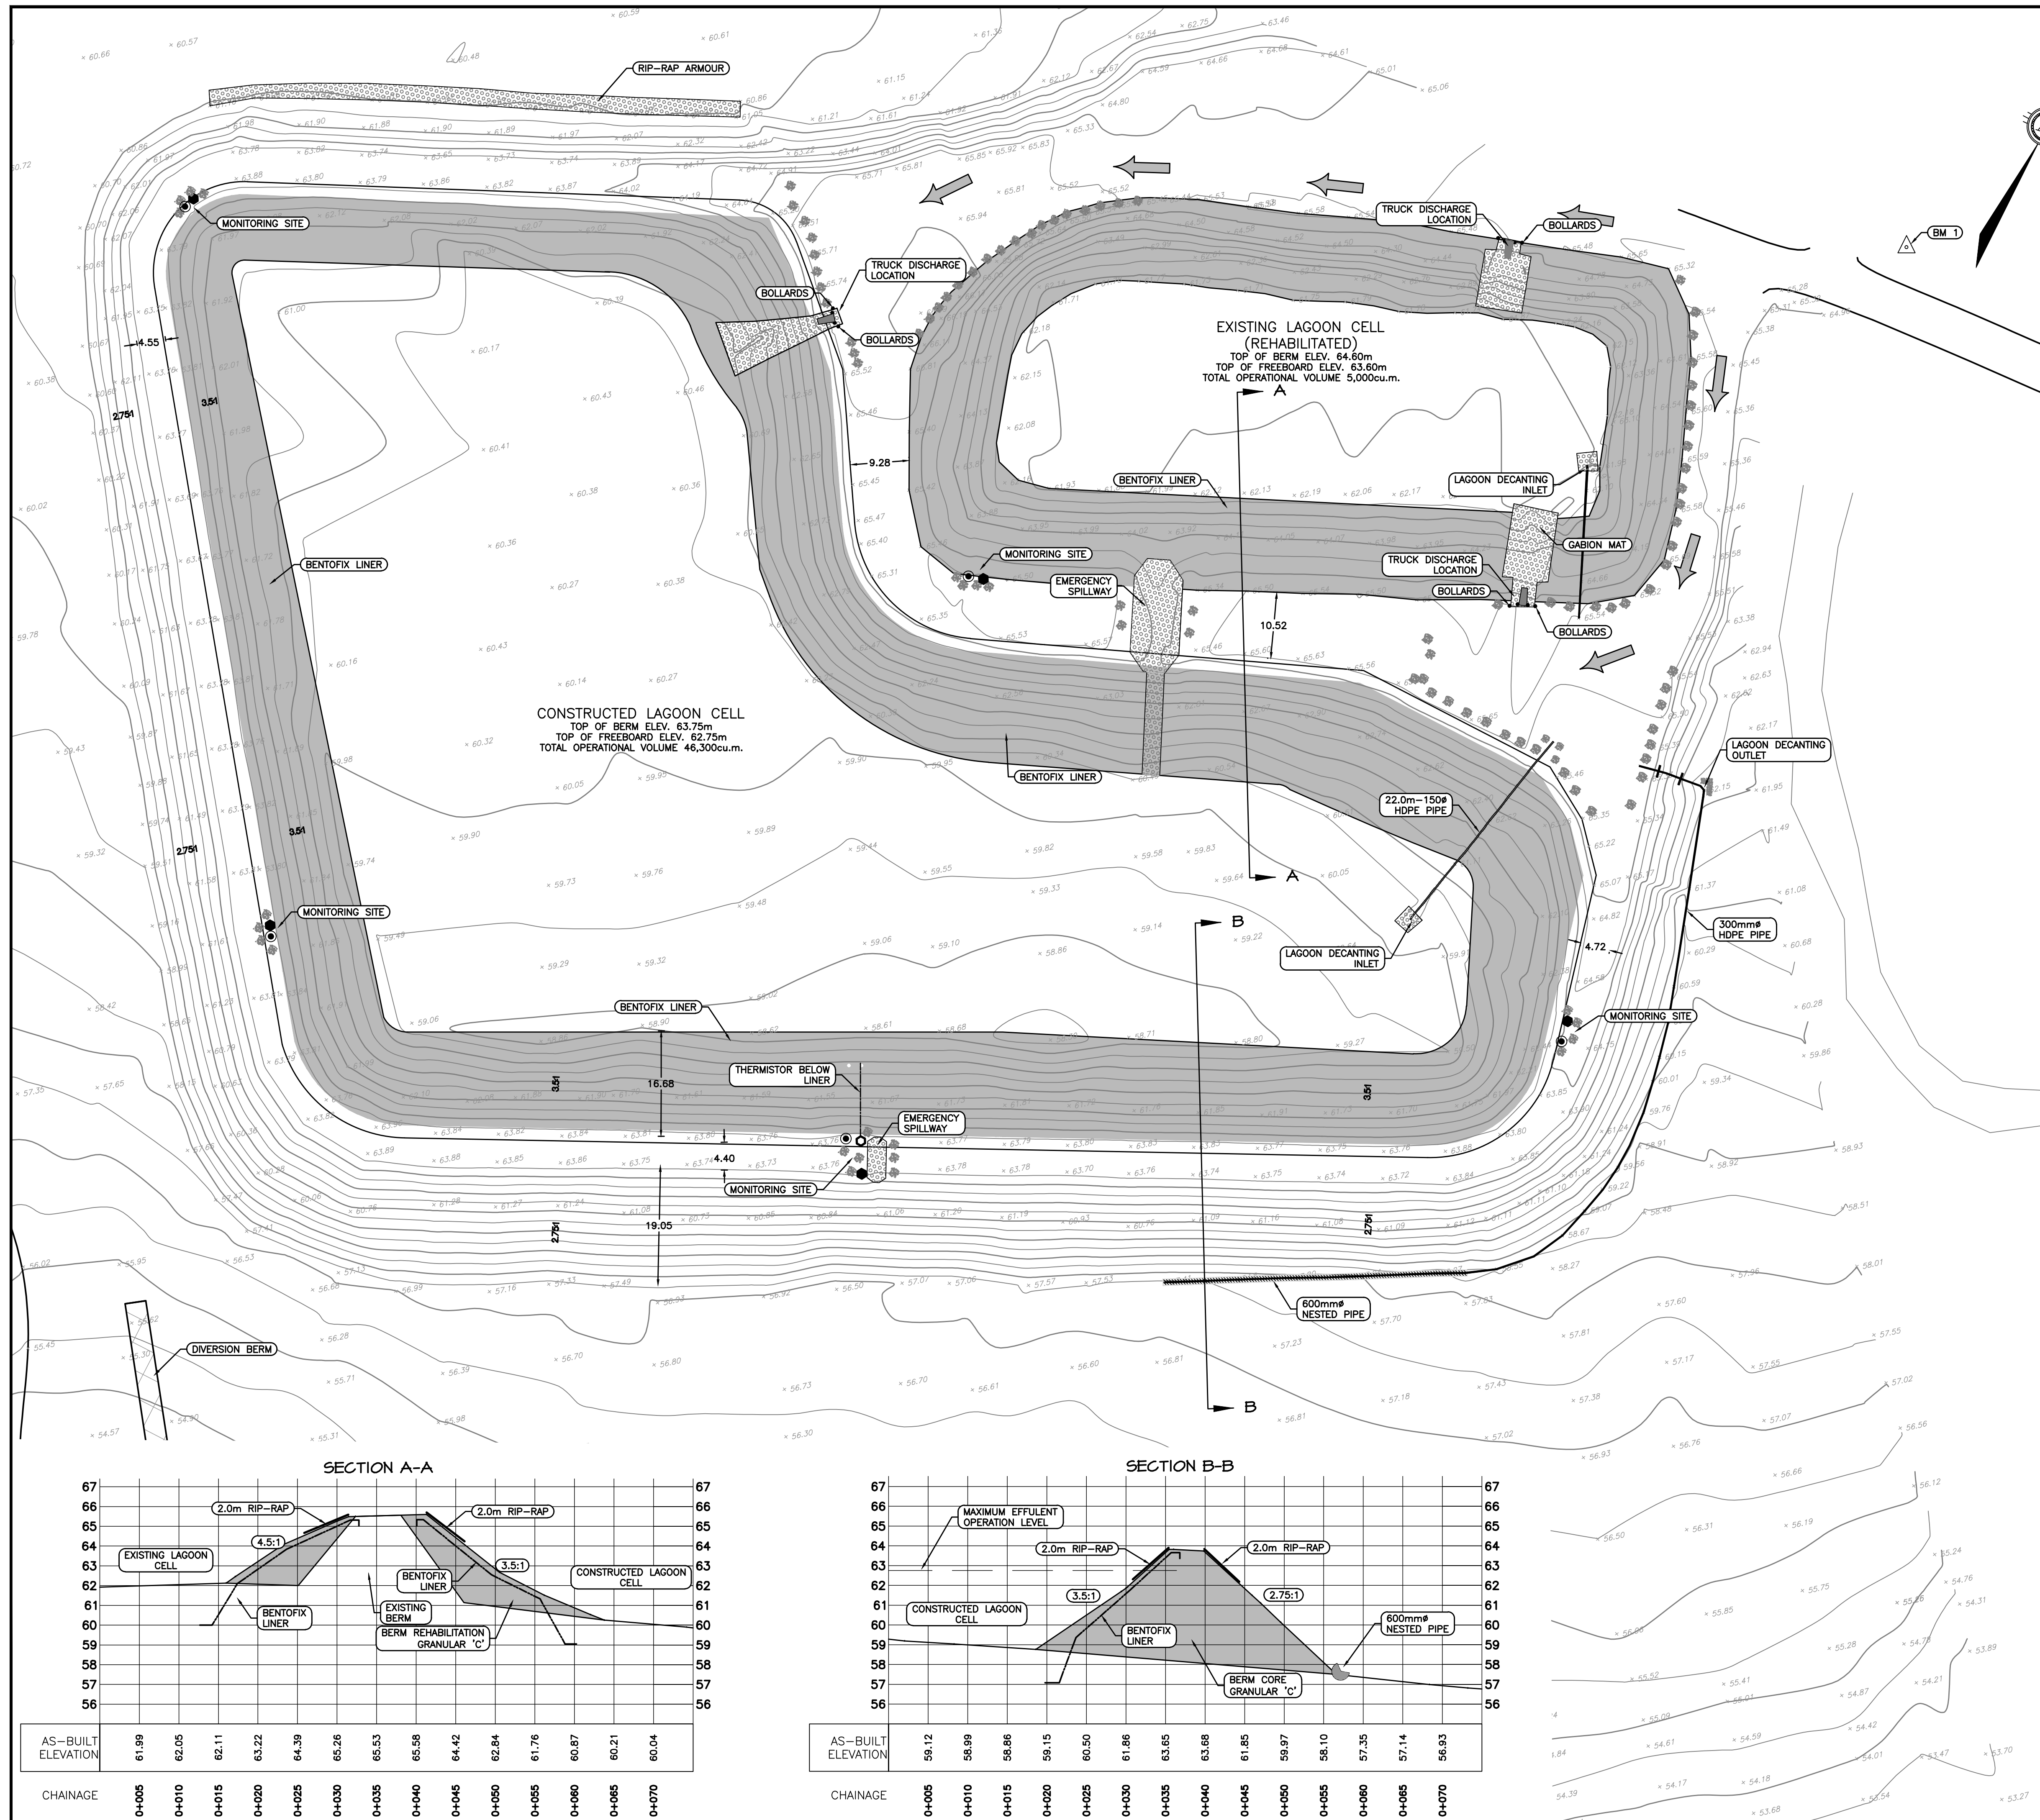

LEGEND

- MONITORING WELL (SAMPLING POINT)
- THERMISTOR
- THERMISTOR BELOW LINER
- 10 SPOT ELEVATION
- AB BOULDER
- GABION MAT
- BENTOFIX LINER
- TRUCK ROUTE

AS-CONSTRUCTED

2011

PERMIT OF PRACTICE
TROW ASSOCIATES INC.

Signature _____

Date _____


PERMIT NUMBER: P184
The Association of Professional Engineers
Geologists and Geophysicists of the NWT/NNU

BENCH MARK

BM 1 ELEV. = 65.16

RE-BAR SET NEAR THE INTERSECTION OF THE LAGOON ACCESS ROAD AND METAL DUMP ACCESS ROAD, NORTH-EAST OF THE LAGOON SITE.

REVISIONS				
5	AS-CONSTRUCTED 2011	18/11/11	MEB	SLB
4	AS-CONSTRUCTED	02/12/10	MEB	SLB
3	ISSUED FOR CONSTRUCTION	15/06/09	MMR	SLB
2	REVISED FOR TENDER	28/05/08	MMR	SLB
1	ISSUED FOR TENDER	28/04/08	MMR	SLB
No.	DESCRIPTION	DATE	BY	APP'D

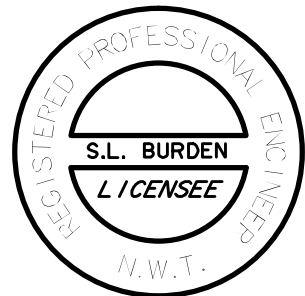

Trow Associates Inc.

100-2650 Queensview Drive PHONE: (613) 688-1889
Ottawa, Ont. K2B 8H6 FAX: (613) 225-7337

CLIENT

GOVERNMENT OF NUNAVUT

PROJECT

CLYDE RIVER
WASTEWATER LAGOON

TITLE

SITE PLAN

design by	SAD	project no.	OTCD00019055A
drawn by	MEB	drawing no.	
checked by	SLB		
date	30/08/2007		
scale	HORIZ 1:500		

SP-2