




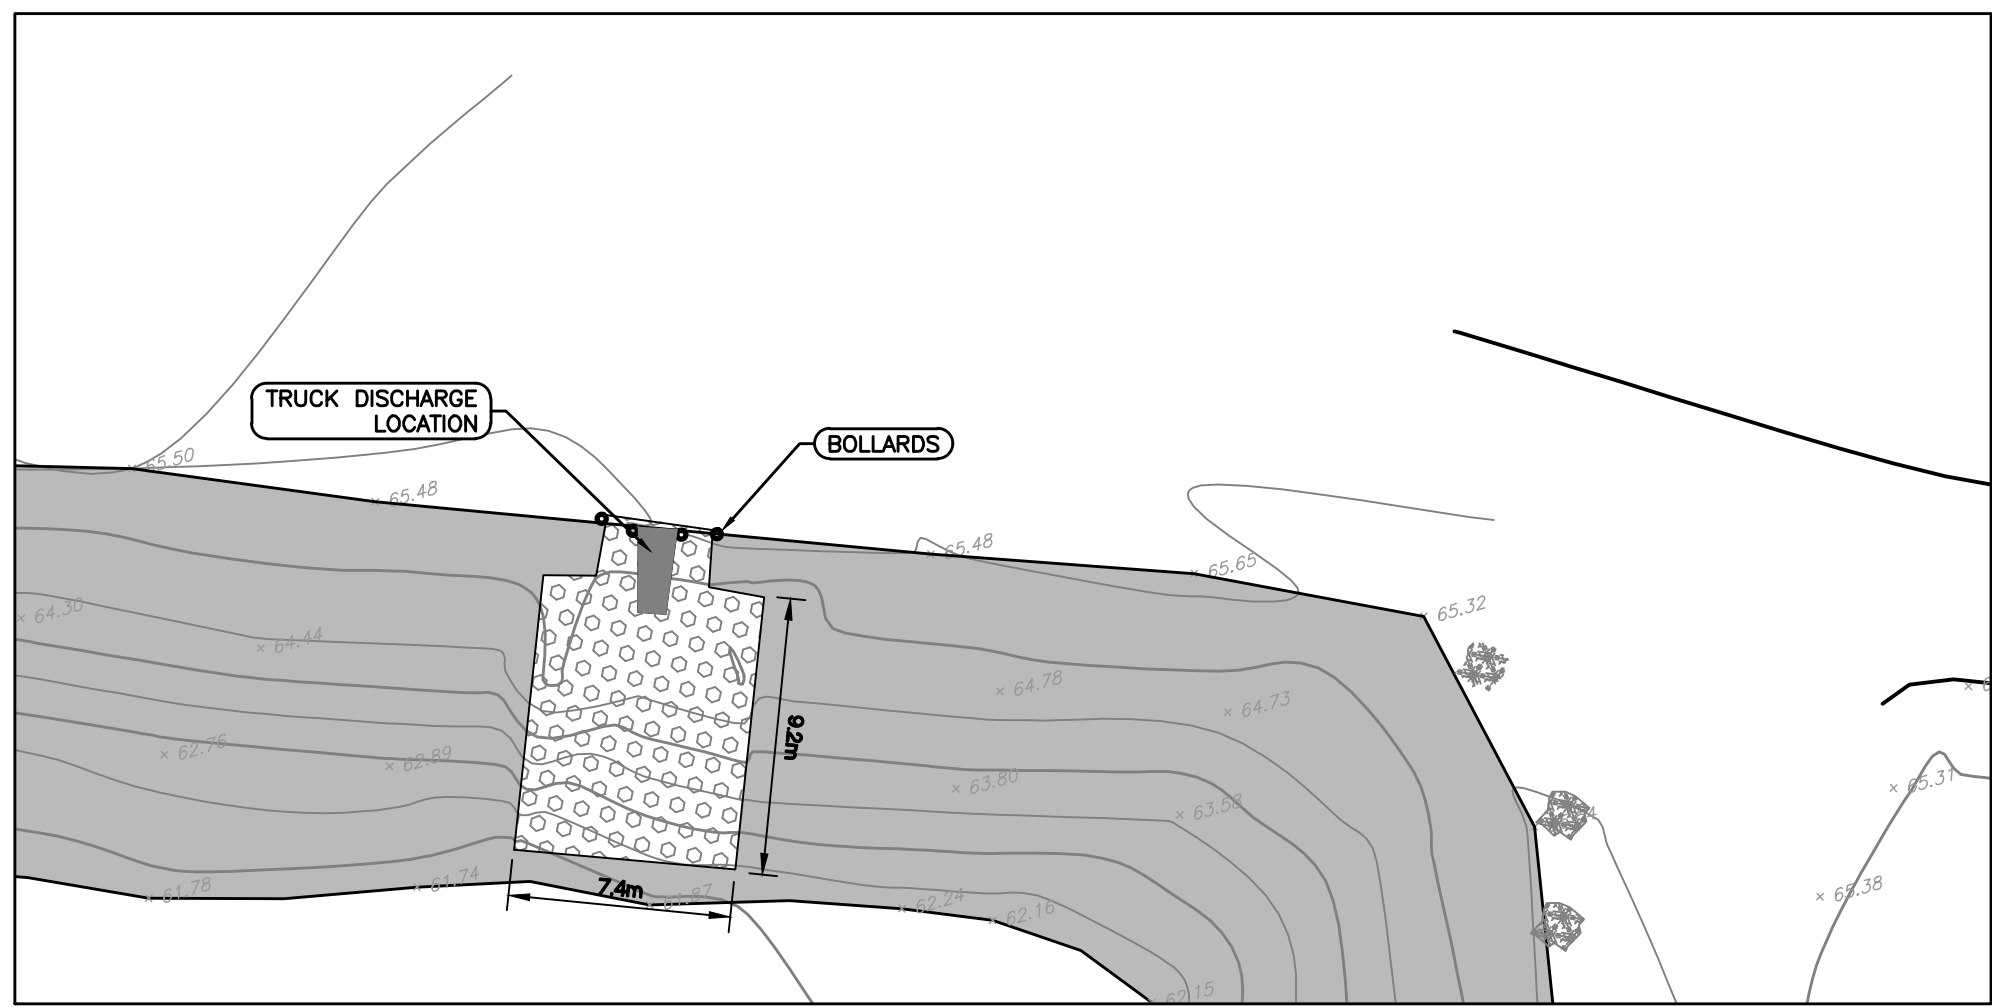


NORTH TRUCK DISCHARGE SITE PLAN

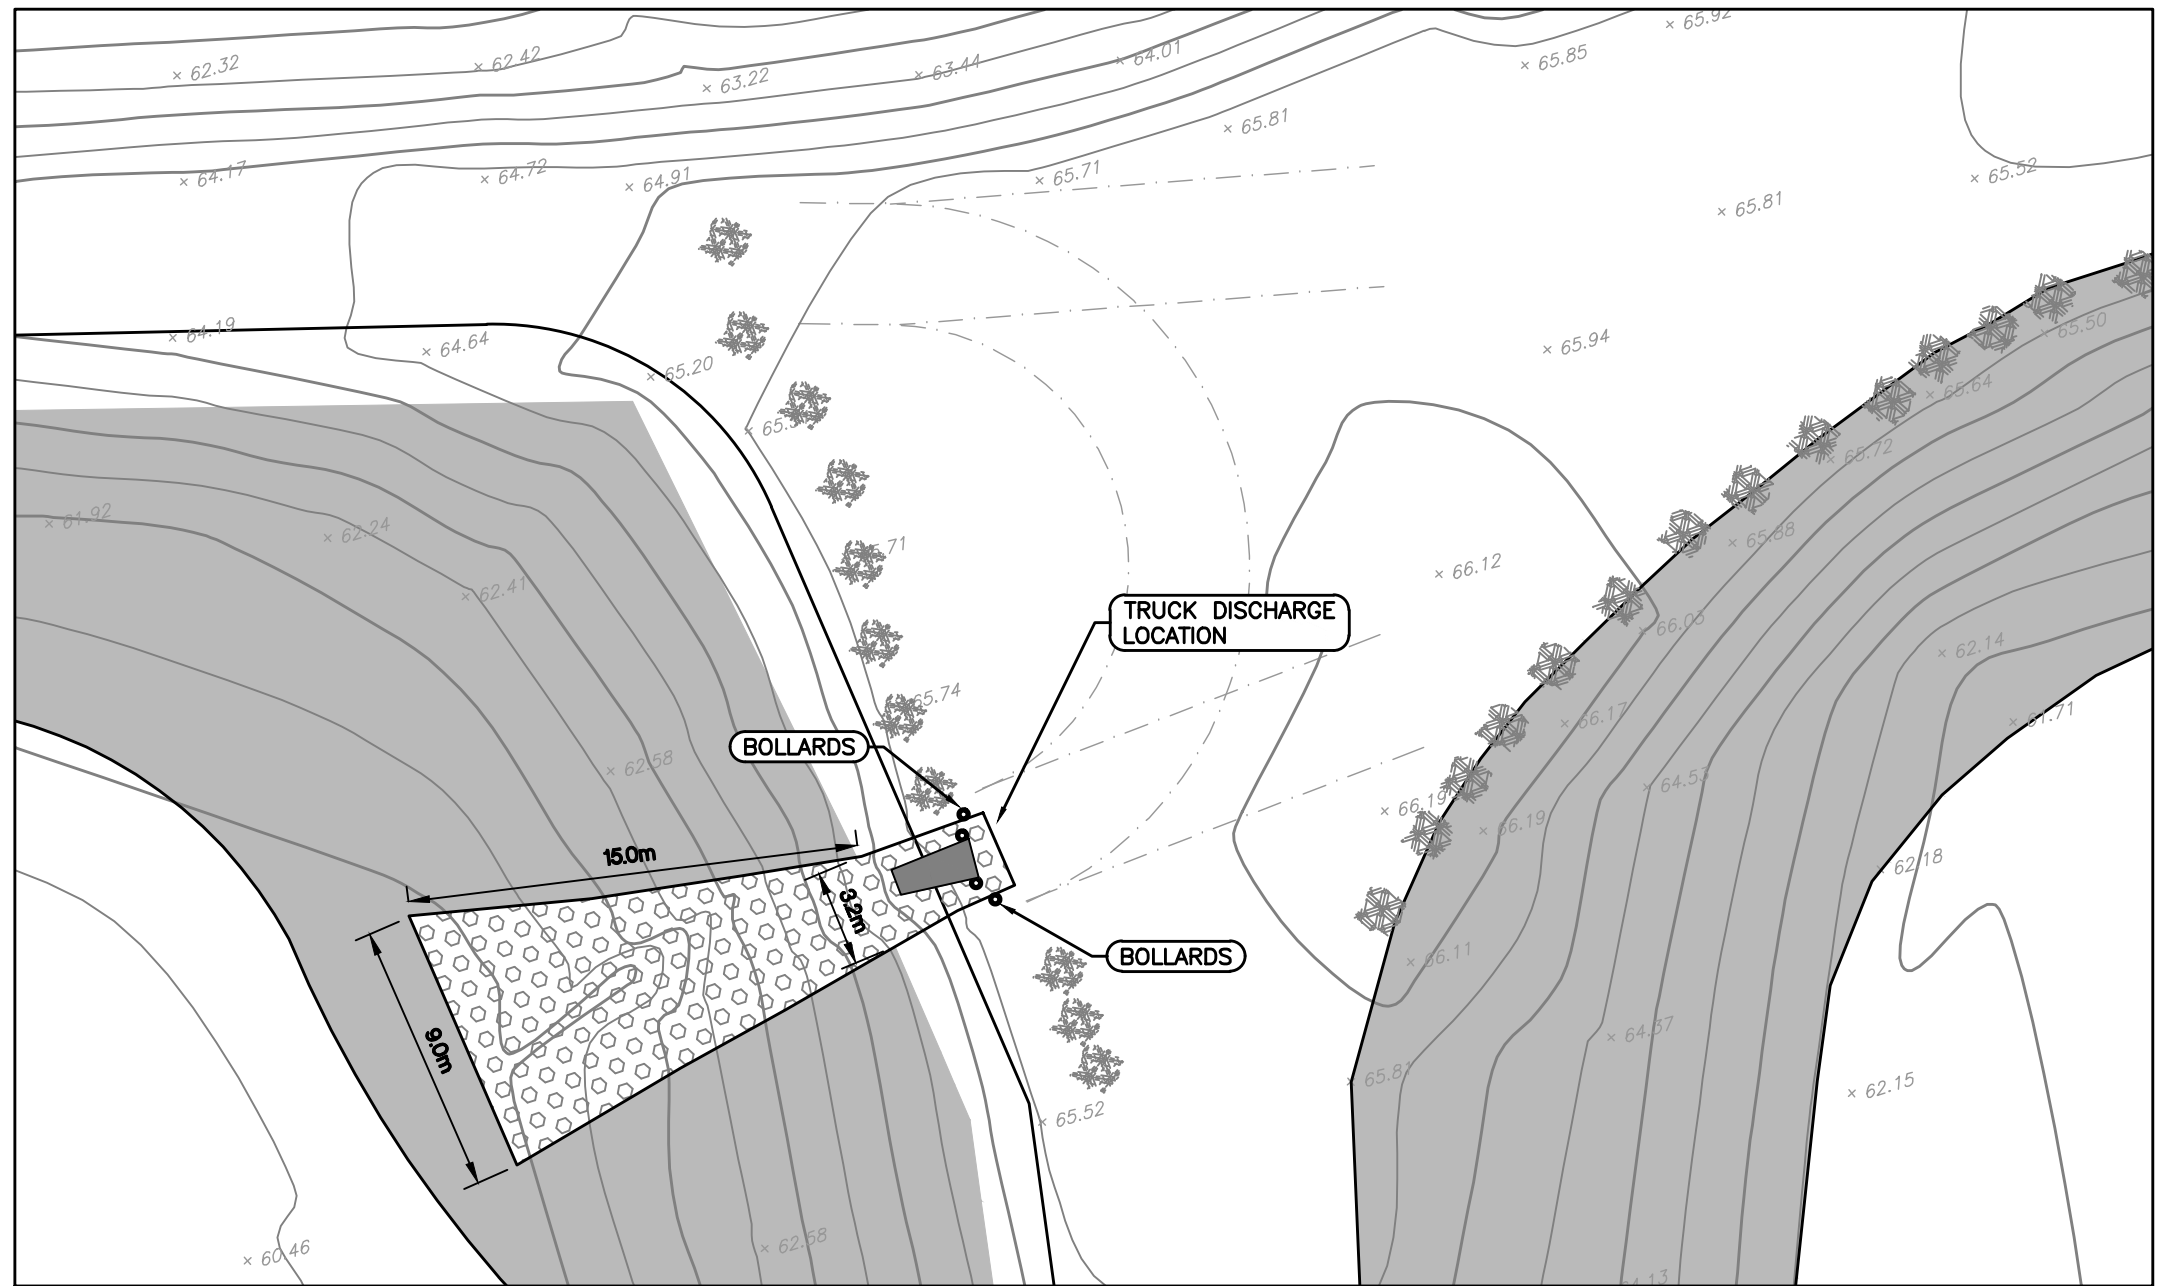


WEST TRUCK DISCHARGE SITE PLAN

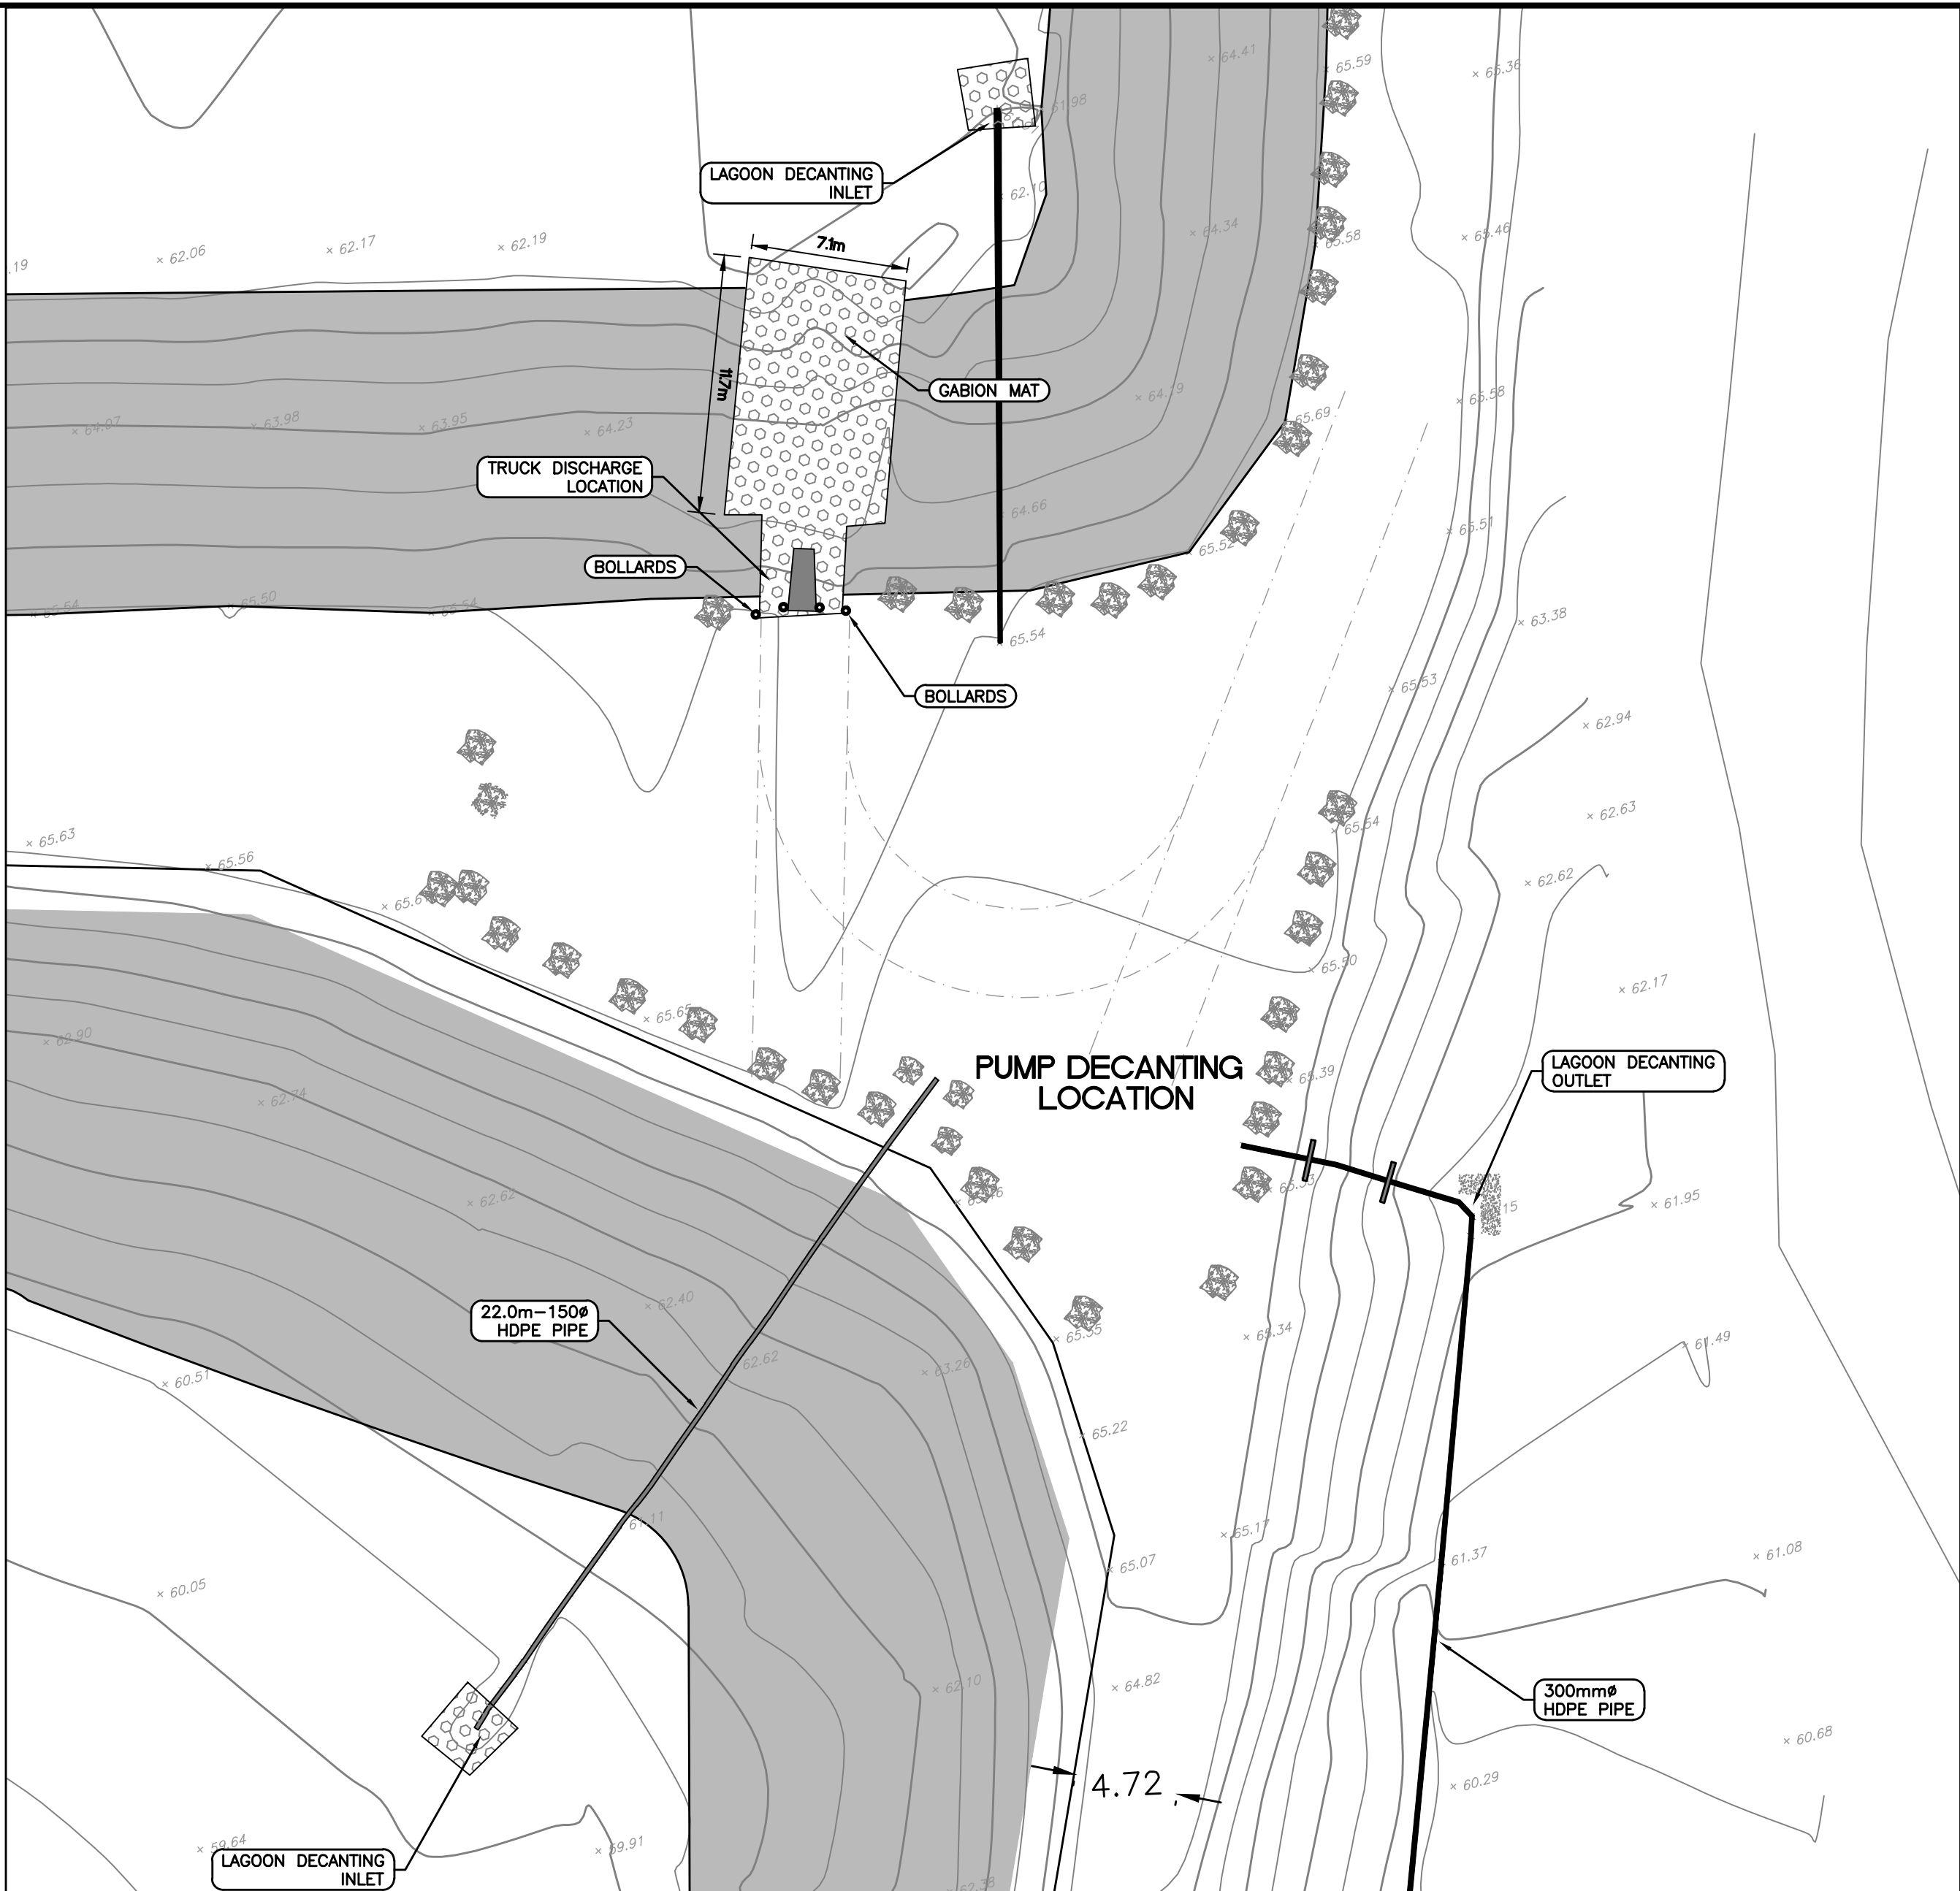


SOUTH TRUCK DISCHARGE SITE PLAN

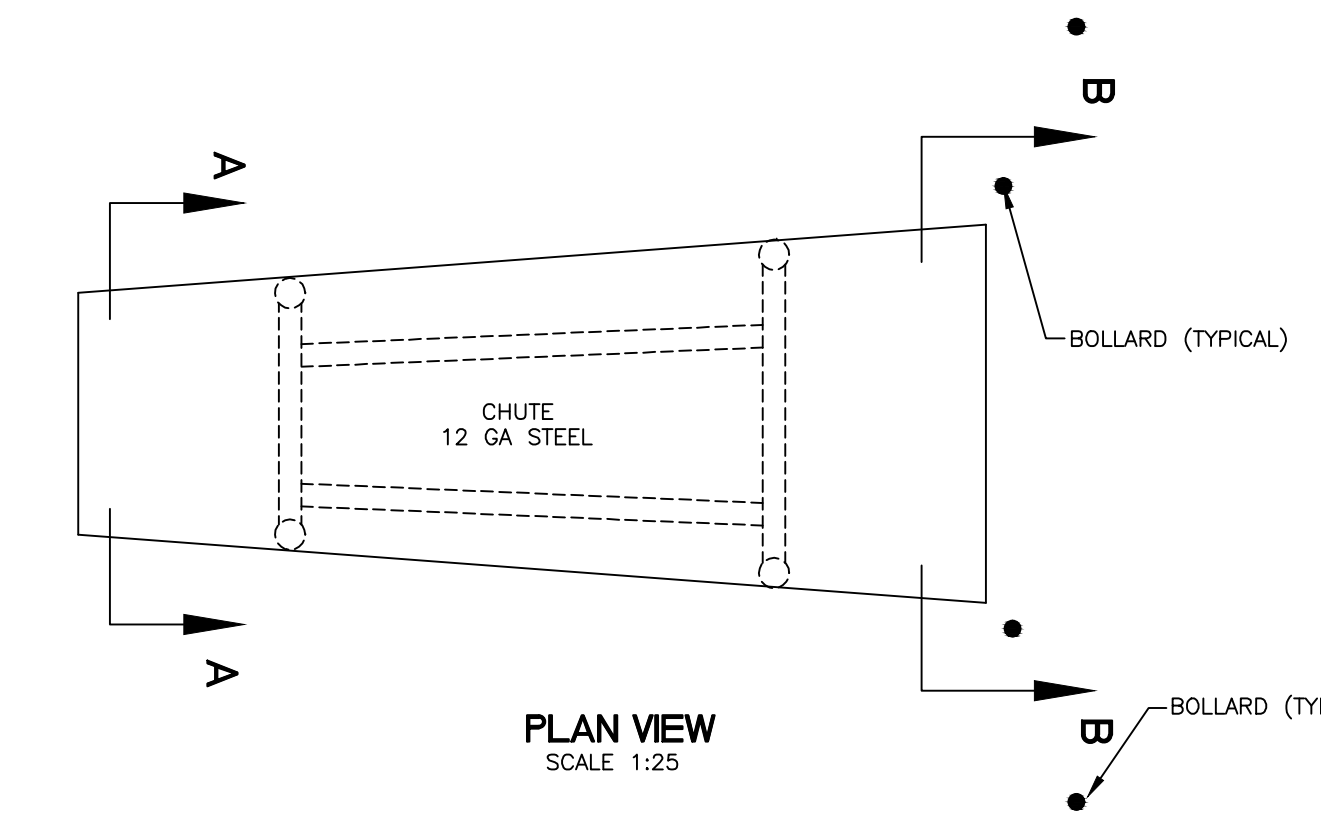

TRUCK DISCHARGE CHUTE DETAIL

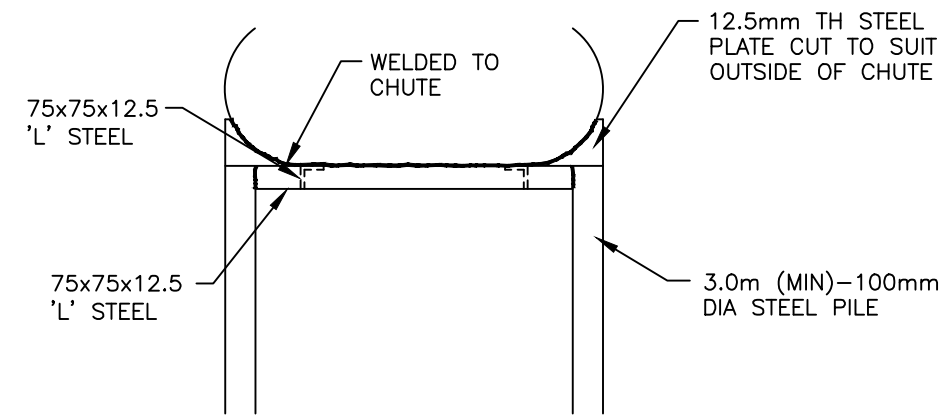


END VIEW
SCALE 1:25

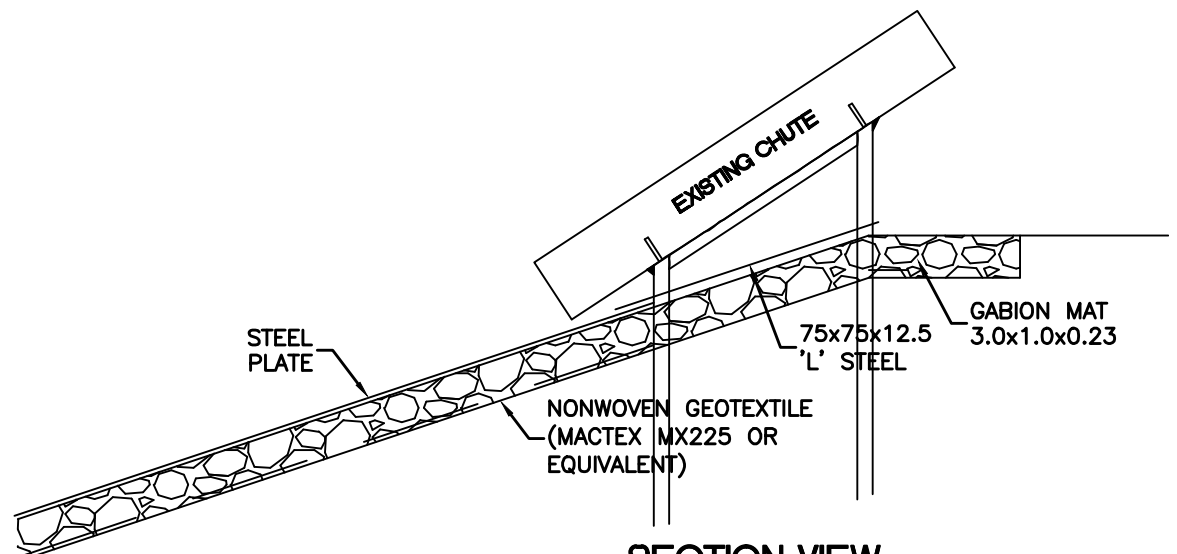


SECTION VIEW
SCALE 1:50


INSET

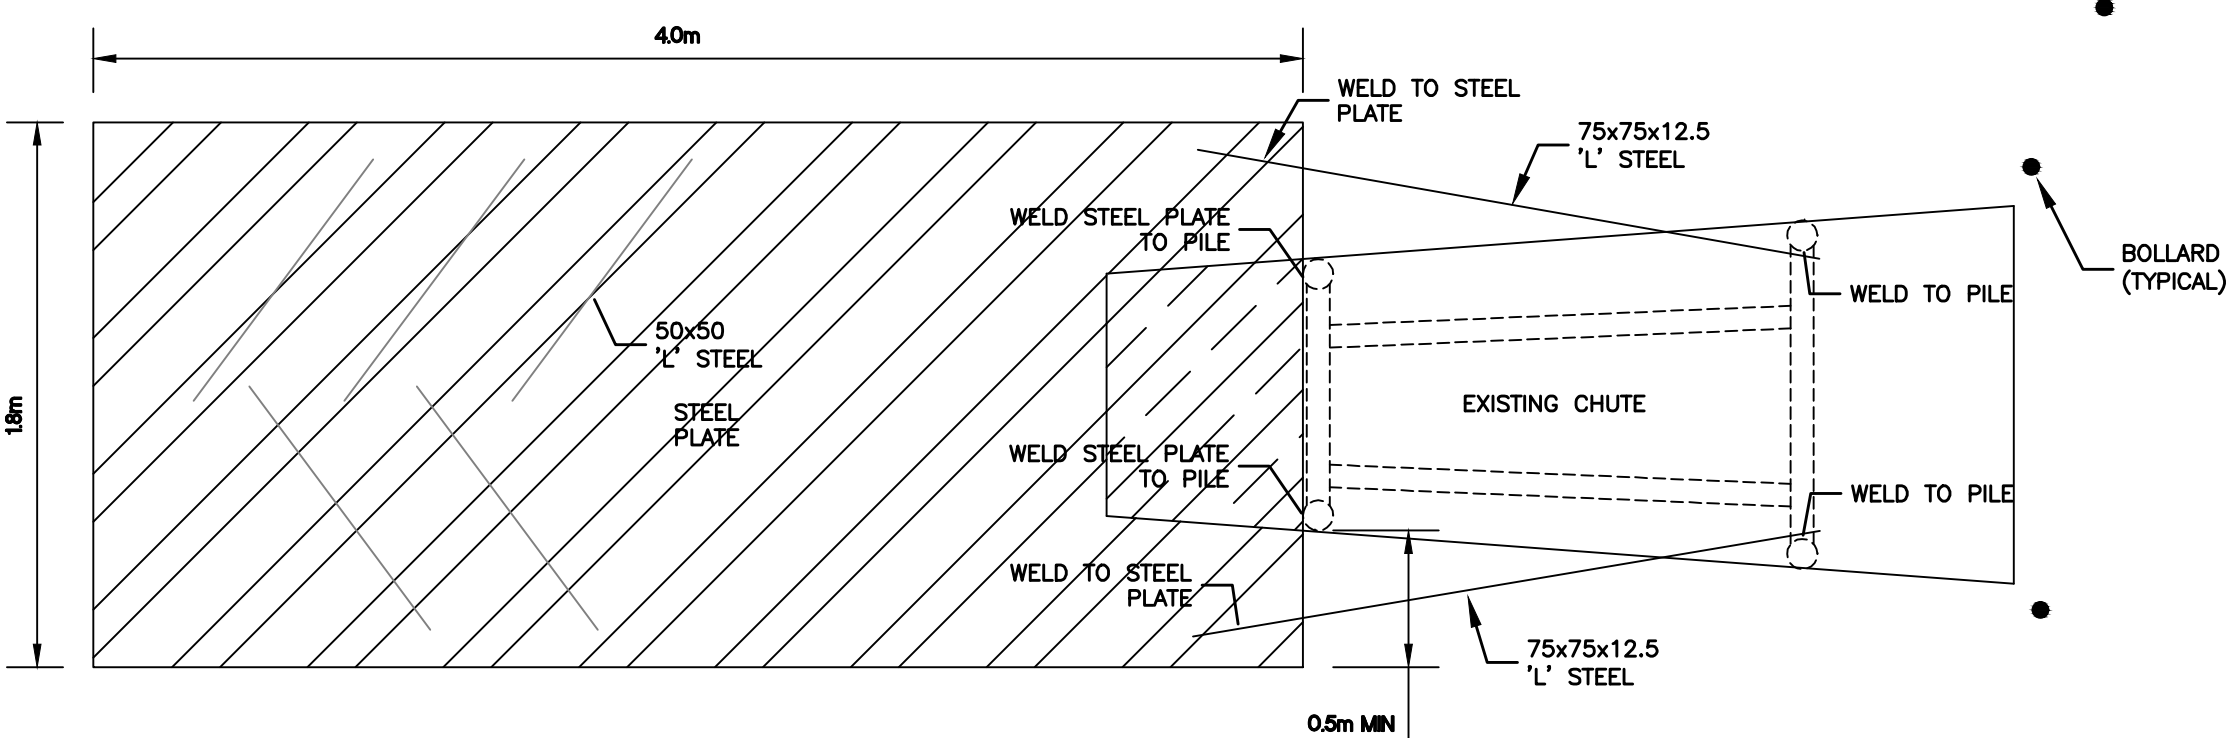

PLAN VIEW
SCALE 1:25

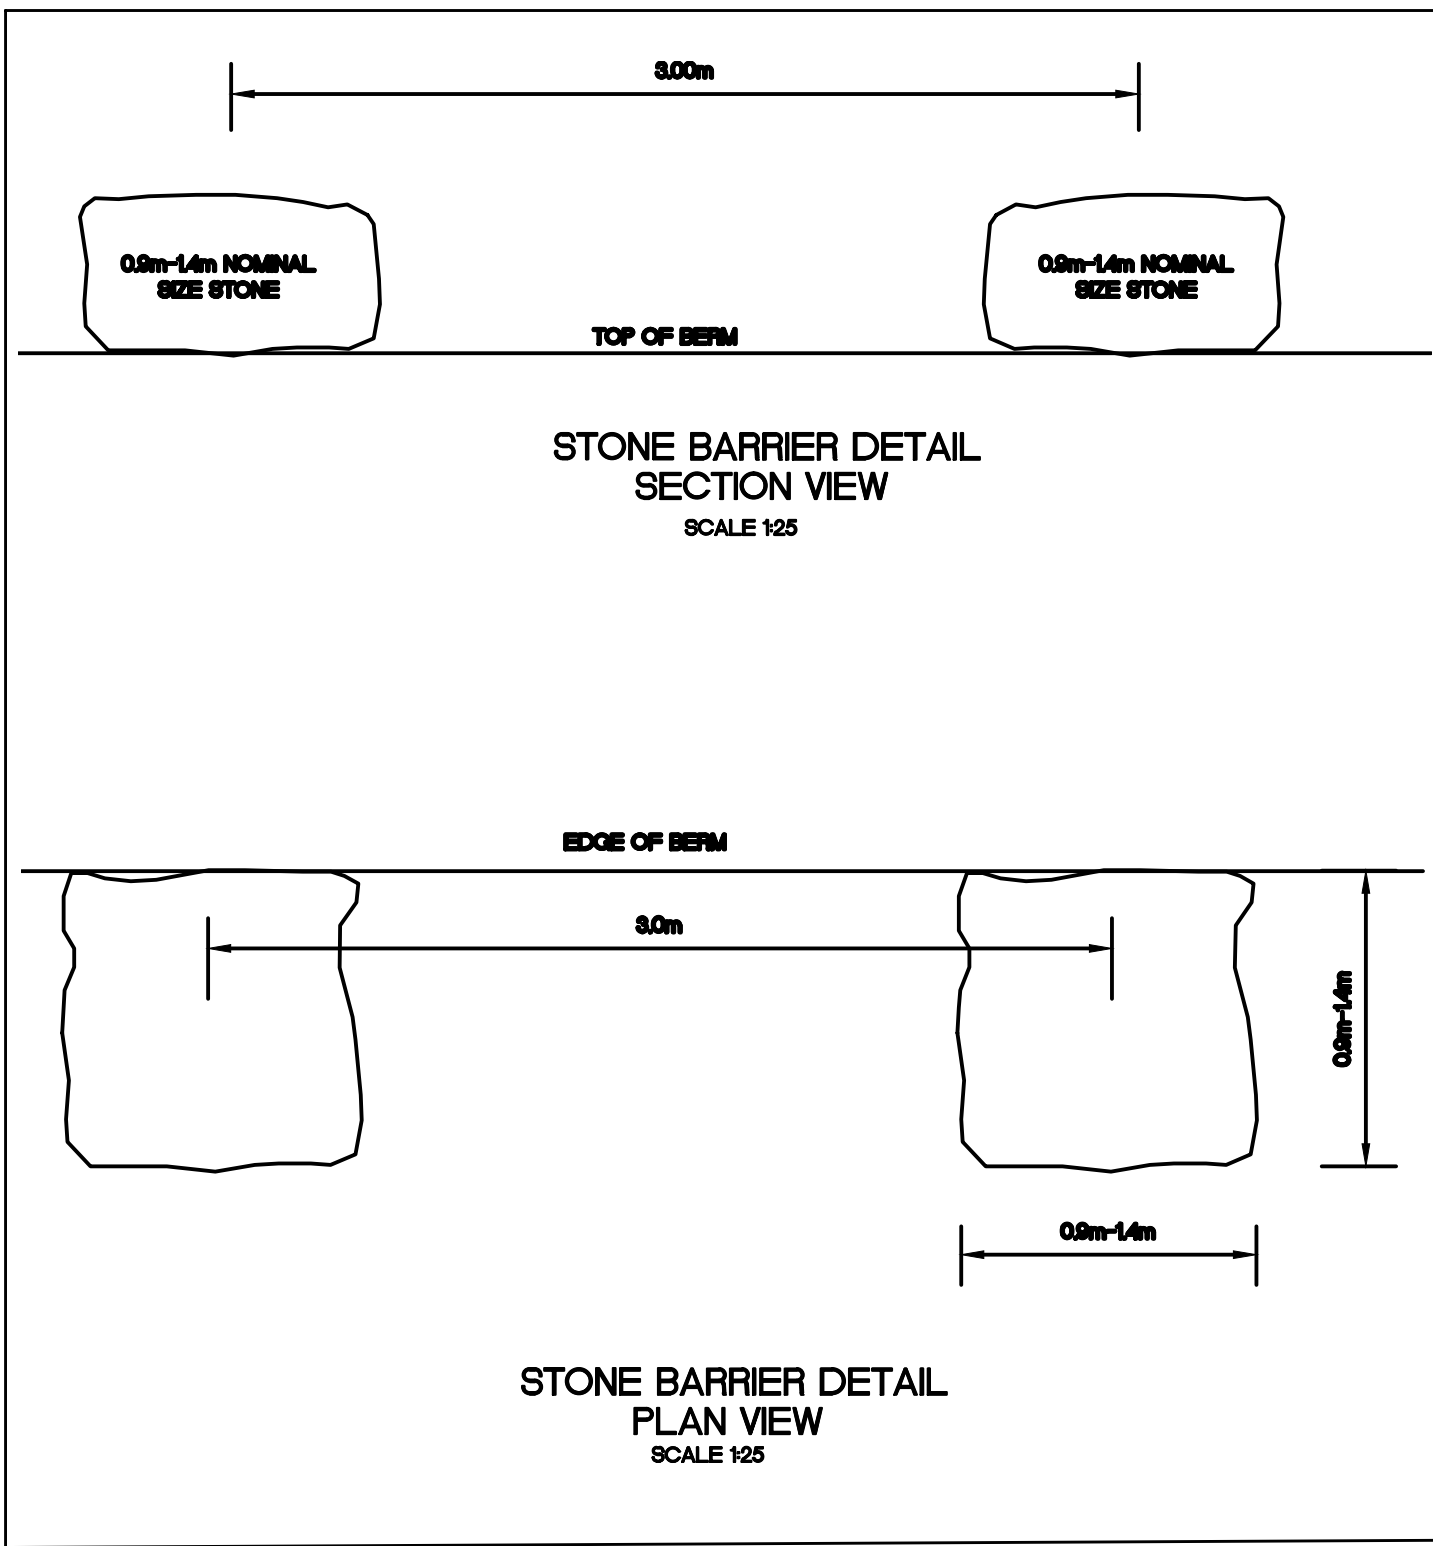

STONE BARRIER DETAIL
PLAN VIEW
SCALE 1:25

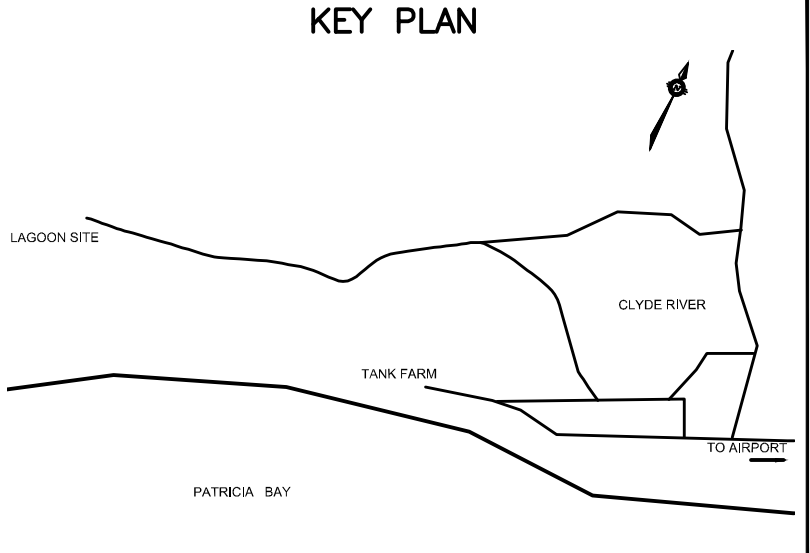

AS-CONSTRUCTED
2011

PERMIT OF PRACTICE
TROW ASSOCIATES INC.
Signature _____
Date _____
PERMIT NUMBER: P184
The Association of Professional Engineers
Geologists and Geophysicists of the NWT/NU

BENCH MARK
BM 1 ELEV. = 65.16
RE-BAR SET NEAR THE INTERSECTION OF THE LAGOON ACCESS
ROAD AND METAL DUMP ACCESS ROAD, NORTH-EAST OF THE
LAGOON SITE.

No.	DESCRIPTION	DATE	BY	APP'D
6	AS-CONSTRUCTED 2011	18/11/11	MEB	SLB
5	AS-CONSTRUCTED	02/12/10	MEB	SLB
4	REV DEWATERING INLET	10/08/09	MMR	SLB
3	ISSUED FOR CONSTRUCTION	15/06/09	MMR	SLB
2	REVISED FOR TENDER	28/05/08	MMR	SLB
1	ISSUED FOR TENDER	28/04/08	MMR	SLB



Trow Associates Inc.
100-2650 Queensview Drive PHONE: (613) 688-1899
Ottawa, Ont. K2B 8H6 FAX: (613) 225-7337

CLIENT
GOVERNMENT OF NUNAVUT

PROJECT
CLYDE RIVER
WASTEWATER LAGOON
TITLE
TRUCK DISCHARGE
SITE PLANS

design by	SAD	project no.	OTCD000190554
drawn by	MEB	drawing no.	
checked by	S.L.B.		
date	30/08/2007		
scale	1:250		

TD1