


GOVERNMENT OF NUNAVUT

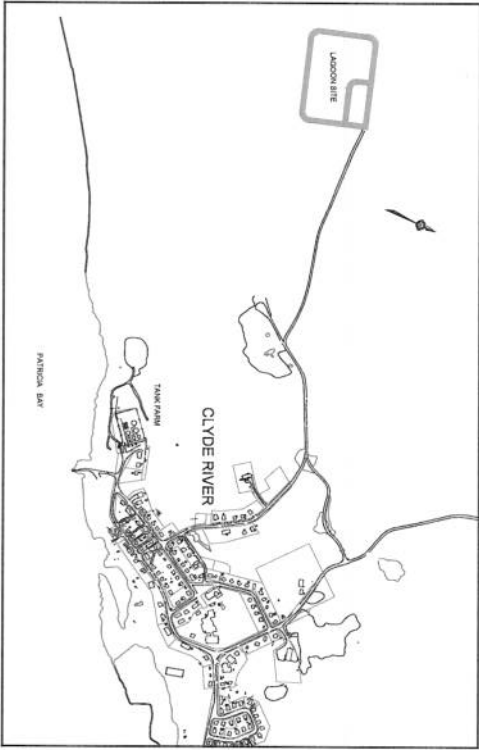

INDEX OF INCLUDED DRAWINGS

DRAWING NO.	REVISION	DESCRIPTION
070200010004-01	REV 3	CONCRETE
070200010004-02	REV 5	CONCRETE, SEE PLAN
070200010004-03	REV 6	SEE PLAN
070200010004-04	REV 8	WATER DRAINAGE, SEE PLAN
070200010004-05	REV 9	DETAILS
070200010004-06	REV 3	DETAILS
070200010004-07	REV 1	WATER, LAGOON PLAN


CLYDE RIVER WASTEWATER LAGOON (NEW SEWAGE LAGOON AND REHABILITATE EXISTING LAGOON)



Trow Associates Inc.
100-2650, Queensview Drive
OTTAWA, ONT. K2B 8H6
PHONE: (613) 688-1899
FAX: (613) 229-7337

**RECORD
DRAWING**
DATE: MAY 26, 2014

**RECORD
DRAWING**
DATE MAY 26, 2014

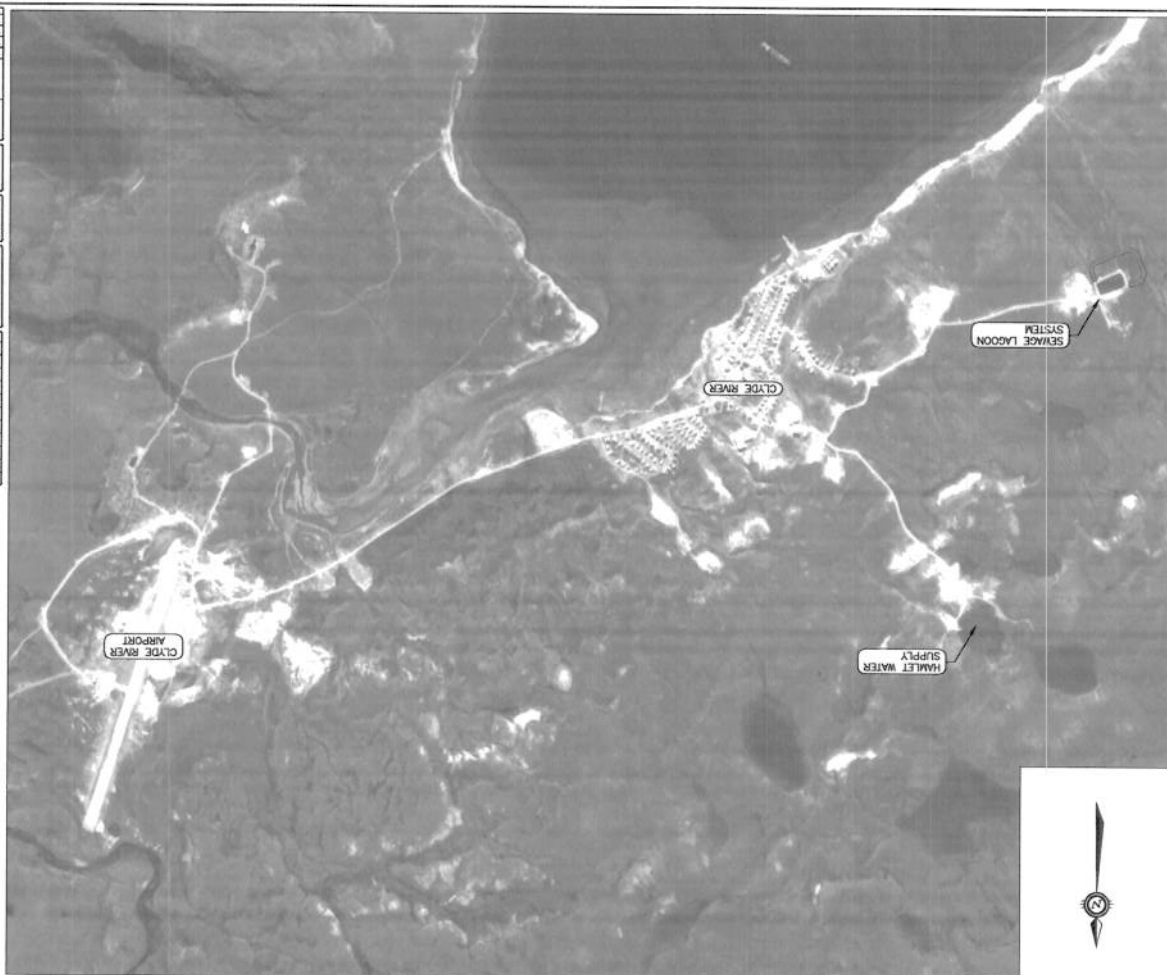

RECORD DRAWING
DATE: MAY 28, 2014

LEGEND

- MONITORING WELL (SAMPLING POINT)
- THERMISTOR
- THERMISTOR (WATER LEVEL)
- SPOT ELEVATION
- BENCHMARK
- GROUND WATER
- TRACK ROUTE

REVISIONS

NO.	DATE	DESCRIPTION
1	05/28/14	ISSUED FOR CONSTRUCTION
2	05/28/14	ISSUED FOR CONSTRUCTION
3	05/28/14	ISSUED FOR CONSTRUCTION
4	05/28/14	ISSUED FOR CONSTRUCTION
5	05/28/14	ISSUED FOR CONSTRUCTION

PROJECT INFORMATION


PROJECT NAME: CLYDE RIVER WASTEWATER LAGOON

CLIENT: GOVERNMENT OF NUNAVUT

DESIGNER: TROW ASSOCIATES INC.

SCALE: 1" = 100'

DATE: MAY 28, 2014

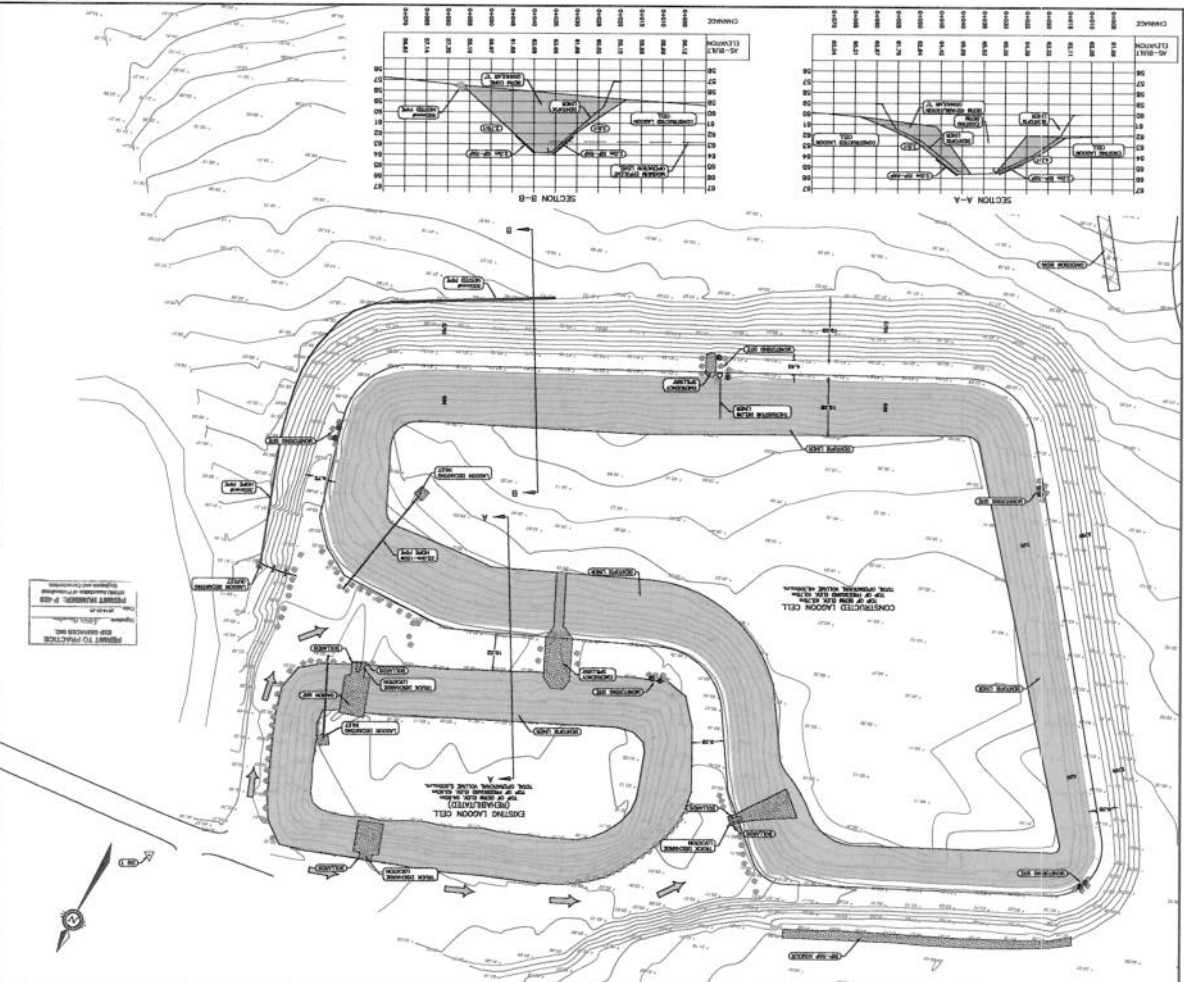


7-20	DATE OF	1971
	20/11/71	1971
	TIME	11:00 AM
	BY	11:00 AM
7-20	DATE OF	1971
20/11/71	20/11/71	1971
TIME	11:00 AM	11:00 AM
BY	11:00 AM	11:00 AM

STIN

DE RIVER
TE WATER
AGOON

NT OF NUNAVUT

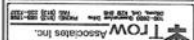

ENGINEER				
CLASS	AGE	DATE	REMARKS	NO.
010	0000	00/00/00	ENGINEER 001 00000	1
010	0000	00/00/00	ENGINEER 002 00000	2
010	0000	00/00/00	ENGINEER 003 00000	3
010	0000	00/00/00	ENGINEER 004 00000	4
010	0000	00/00/00	ENGINEER 005 00000	5
010	0000	00/00/00	ENGINEER 006 00000	6
010	0000	00/00/00	ENGINEER 007 00000	7
010	0000	00/00/00	ENGINEER 008 00000	8
010	0000	00/00/00	ENGINEER 009 00000	9
010	0000	00/00/00	ENGINEER 010 00000	10

PURCHASE AND PRELIMINARY
EXP. SERVICES BLD.

**RECORD
DRAWING**
MAY 26, 2014

