




NORTH TRUCK DISCHARGE SITE PLAN

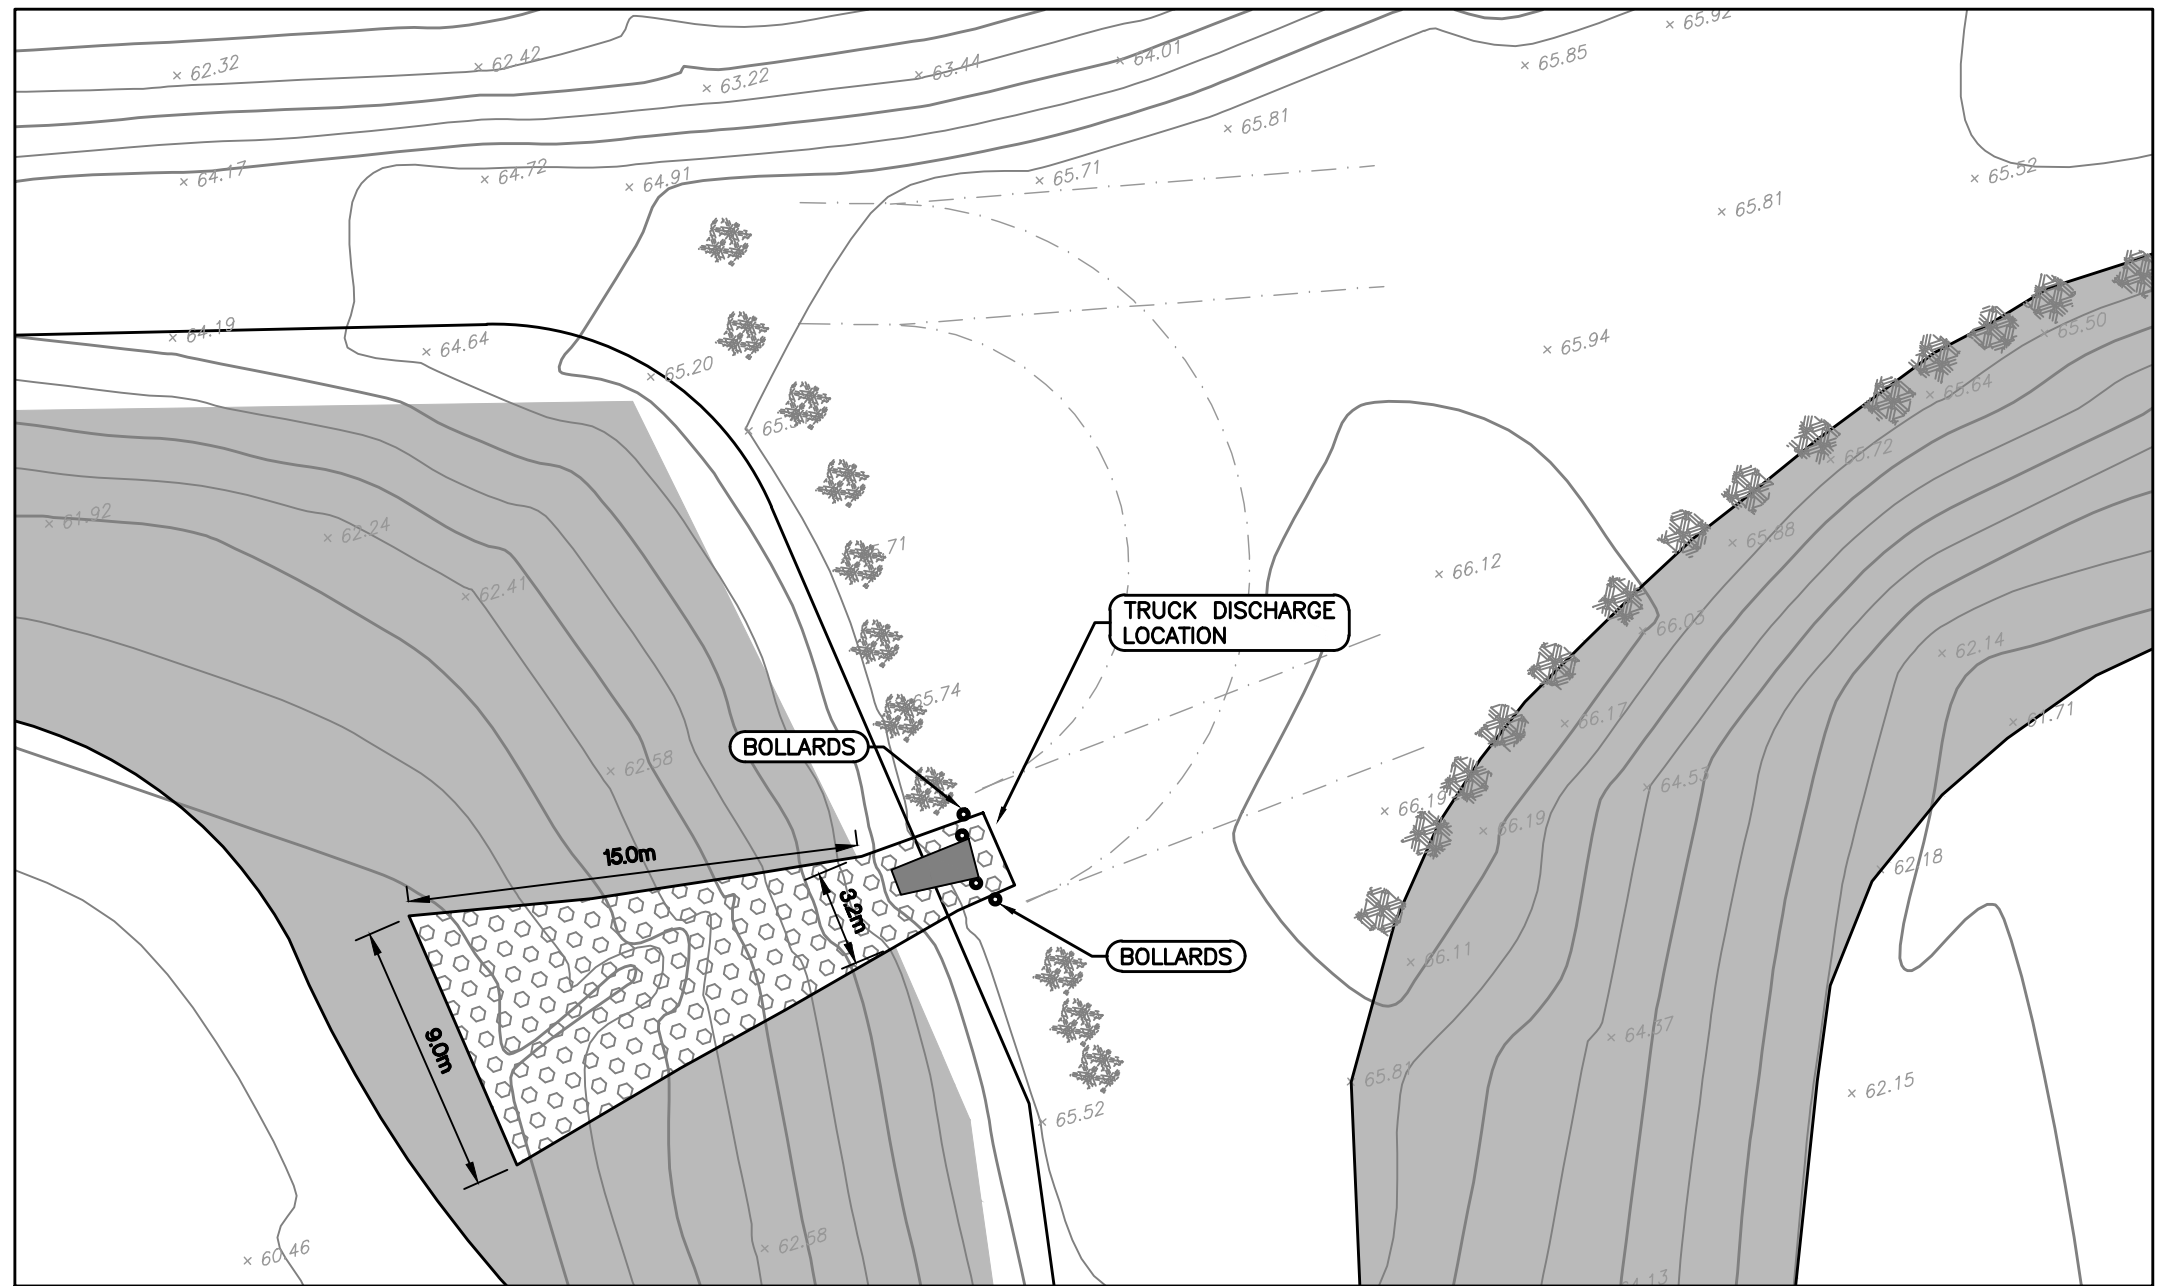


WEST TRUCK DISCHARGE SITE PLAN

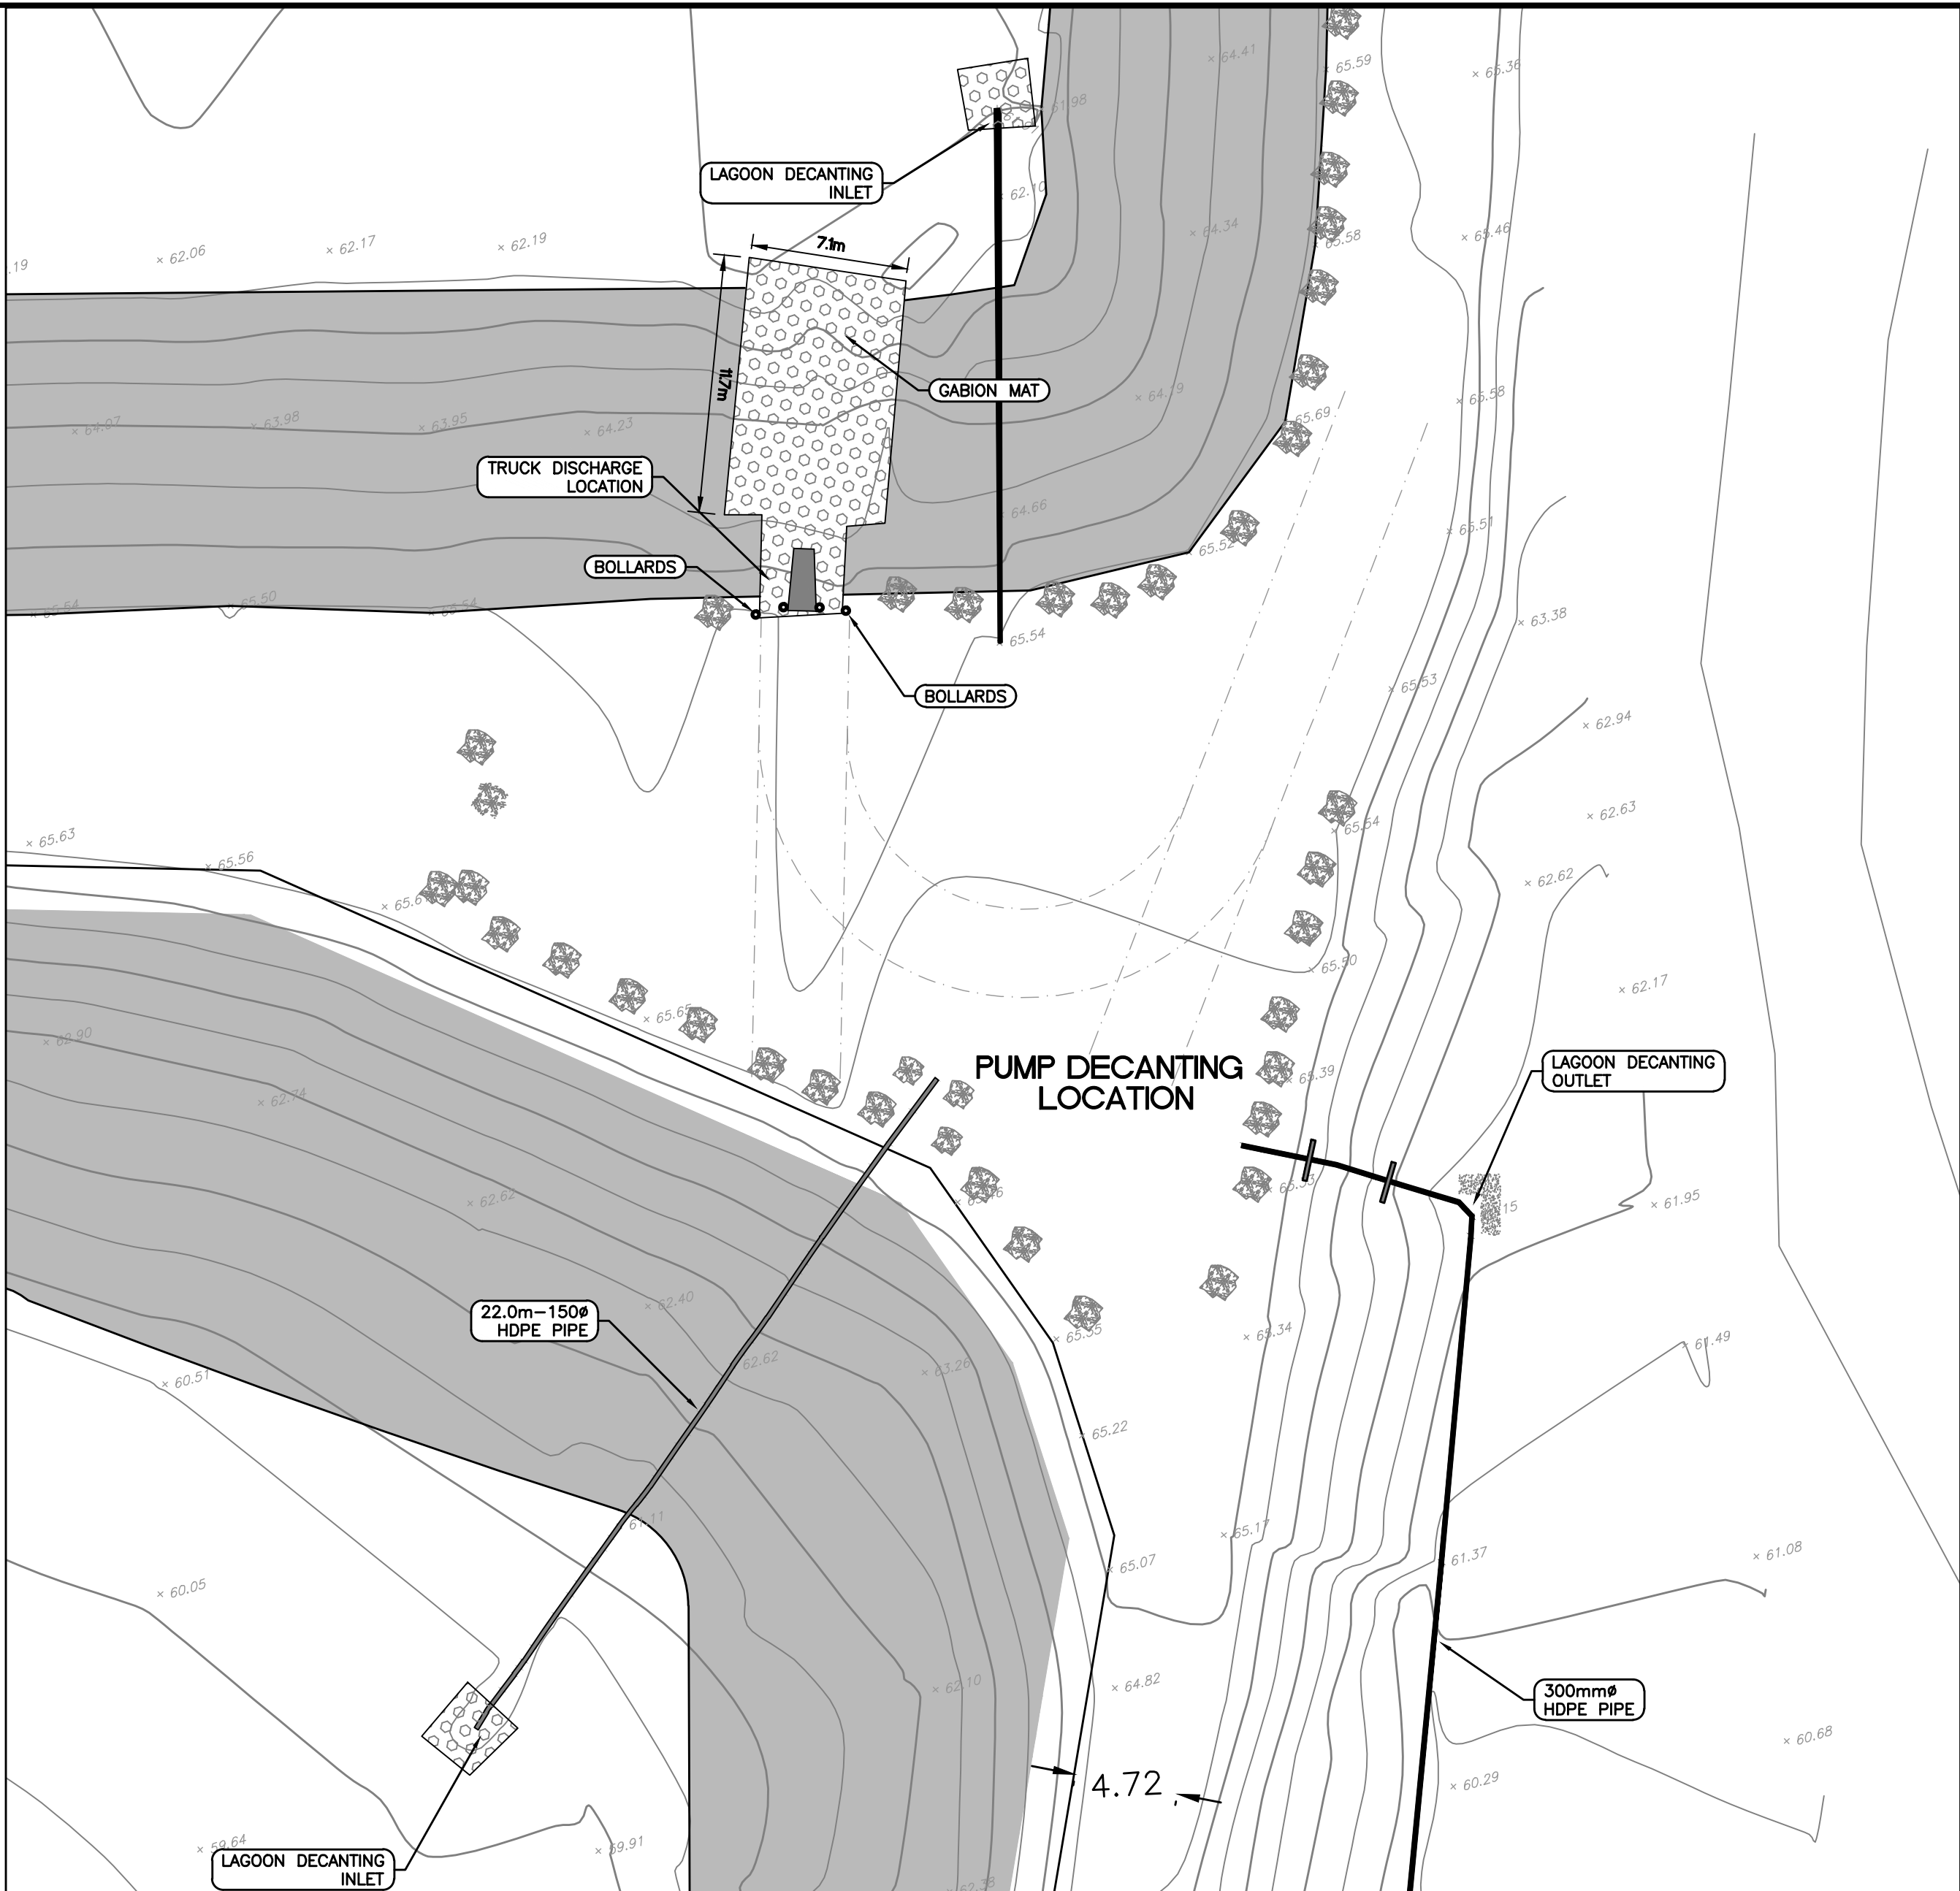


SOUTH TRUCK DISCHARGE SITE PLAN

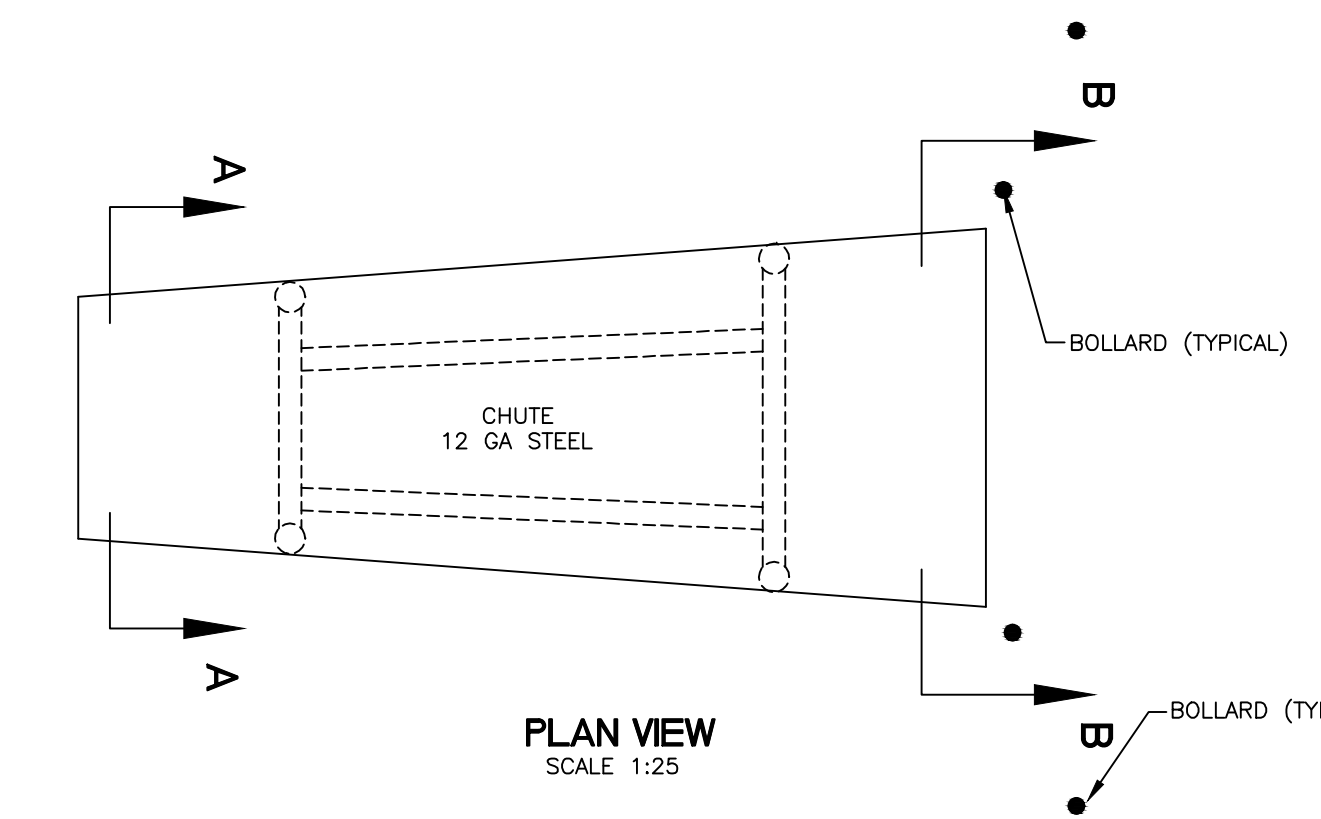

TRUCK DISCHARGE CHUTE DETAIL

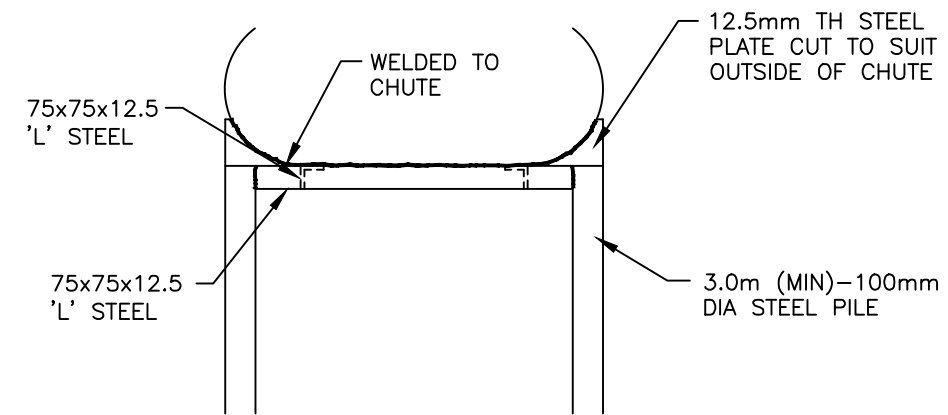


END VIEW
SCALE 1:25

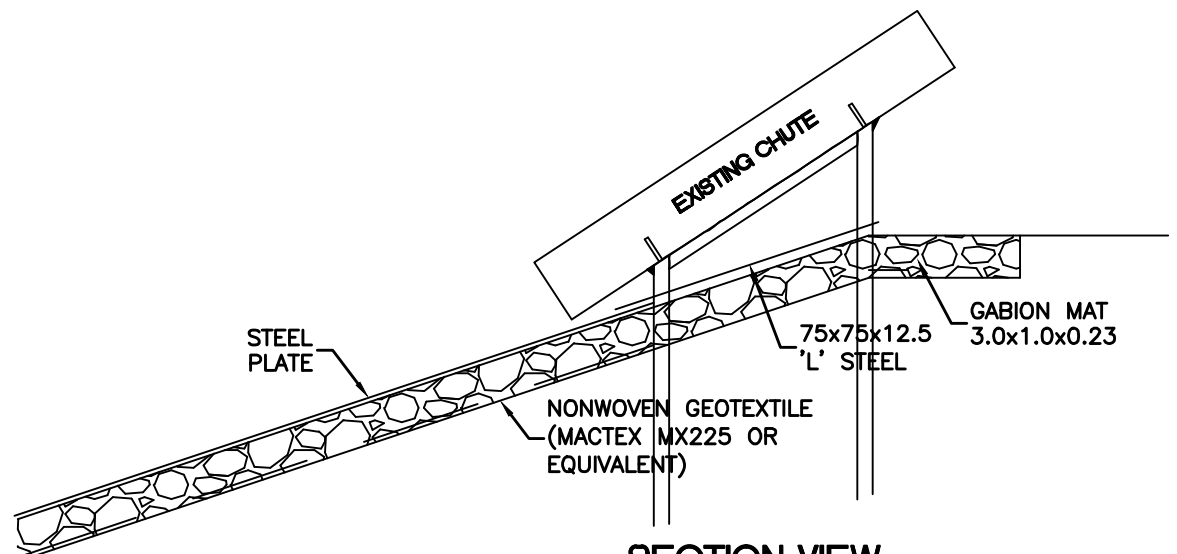


SECTION VIEW
SCALE 1:50


INSET

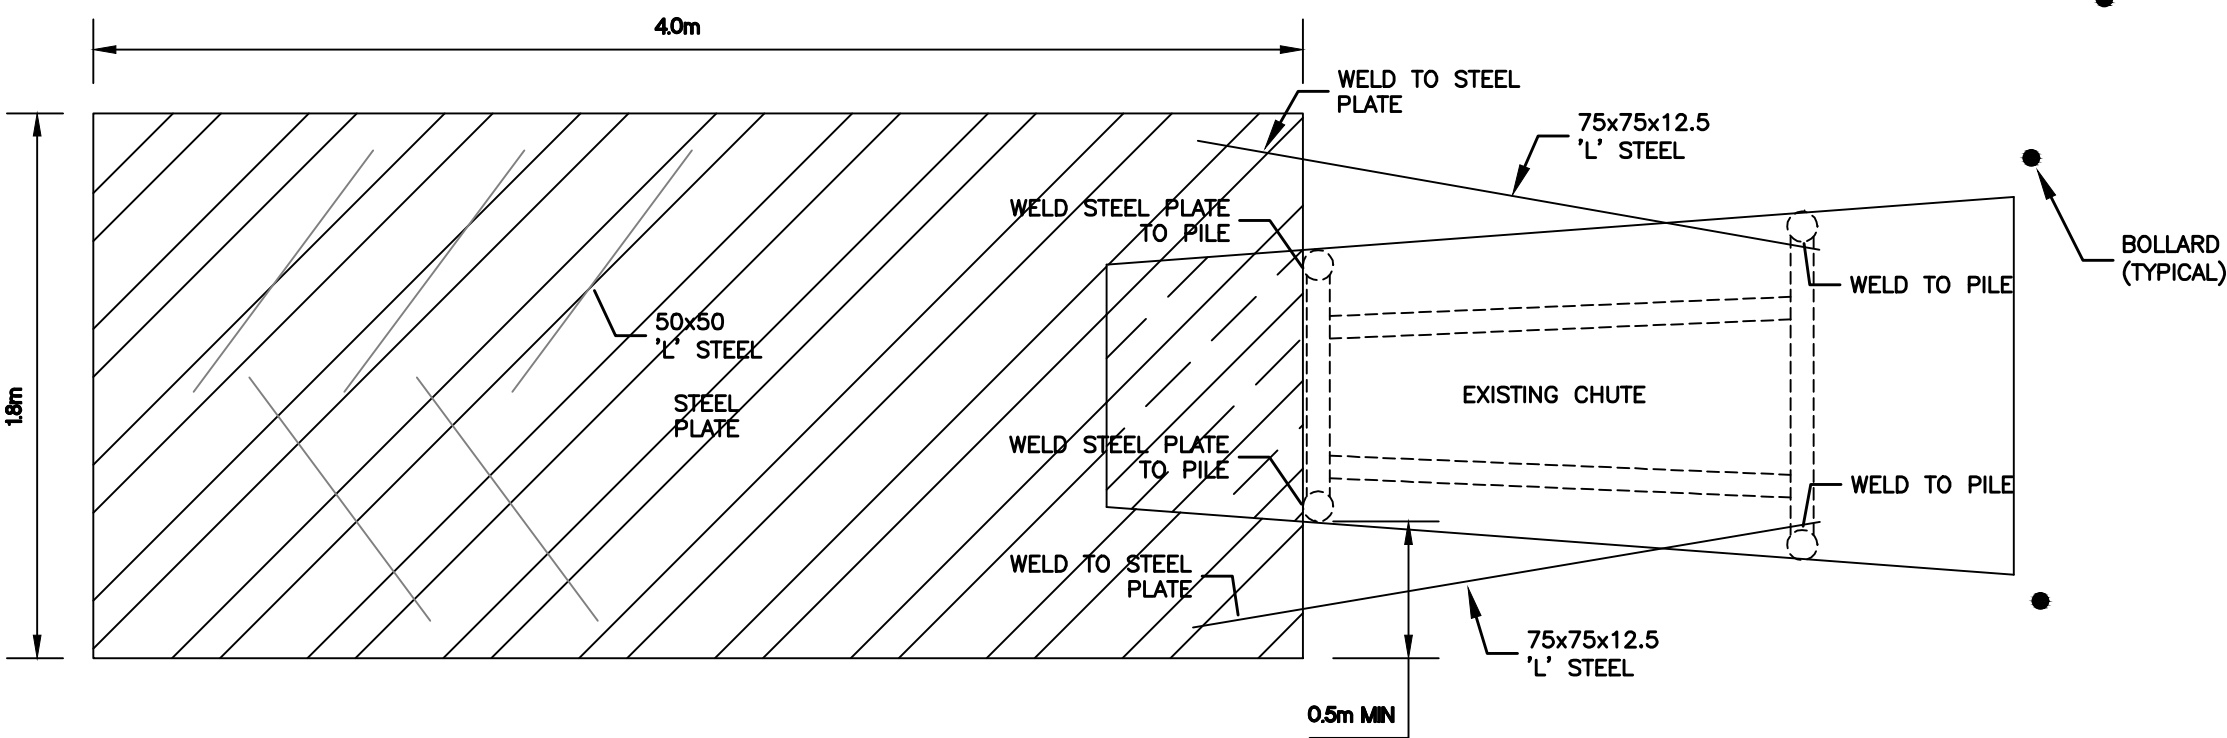

PLAN VIEW
SCALE 1:25

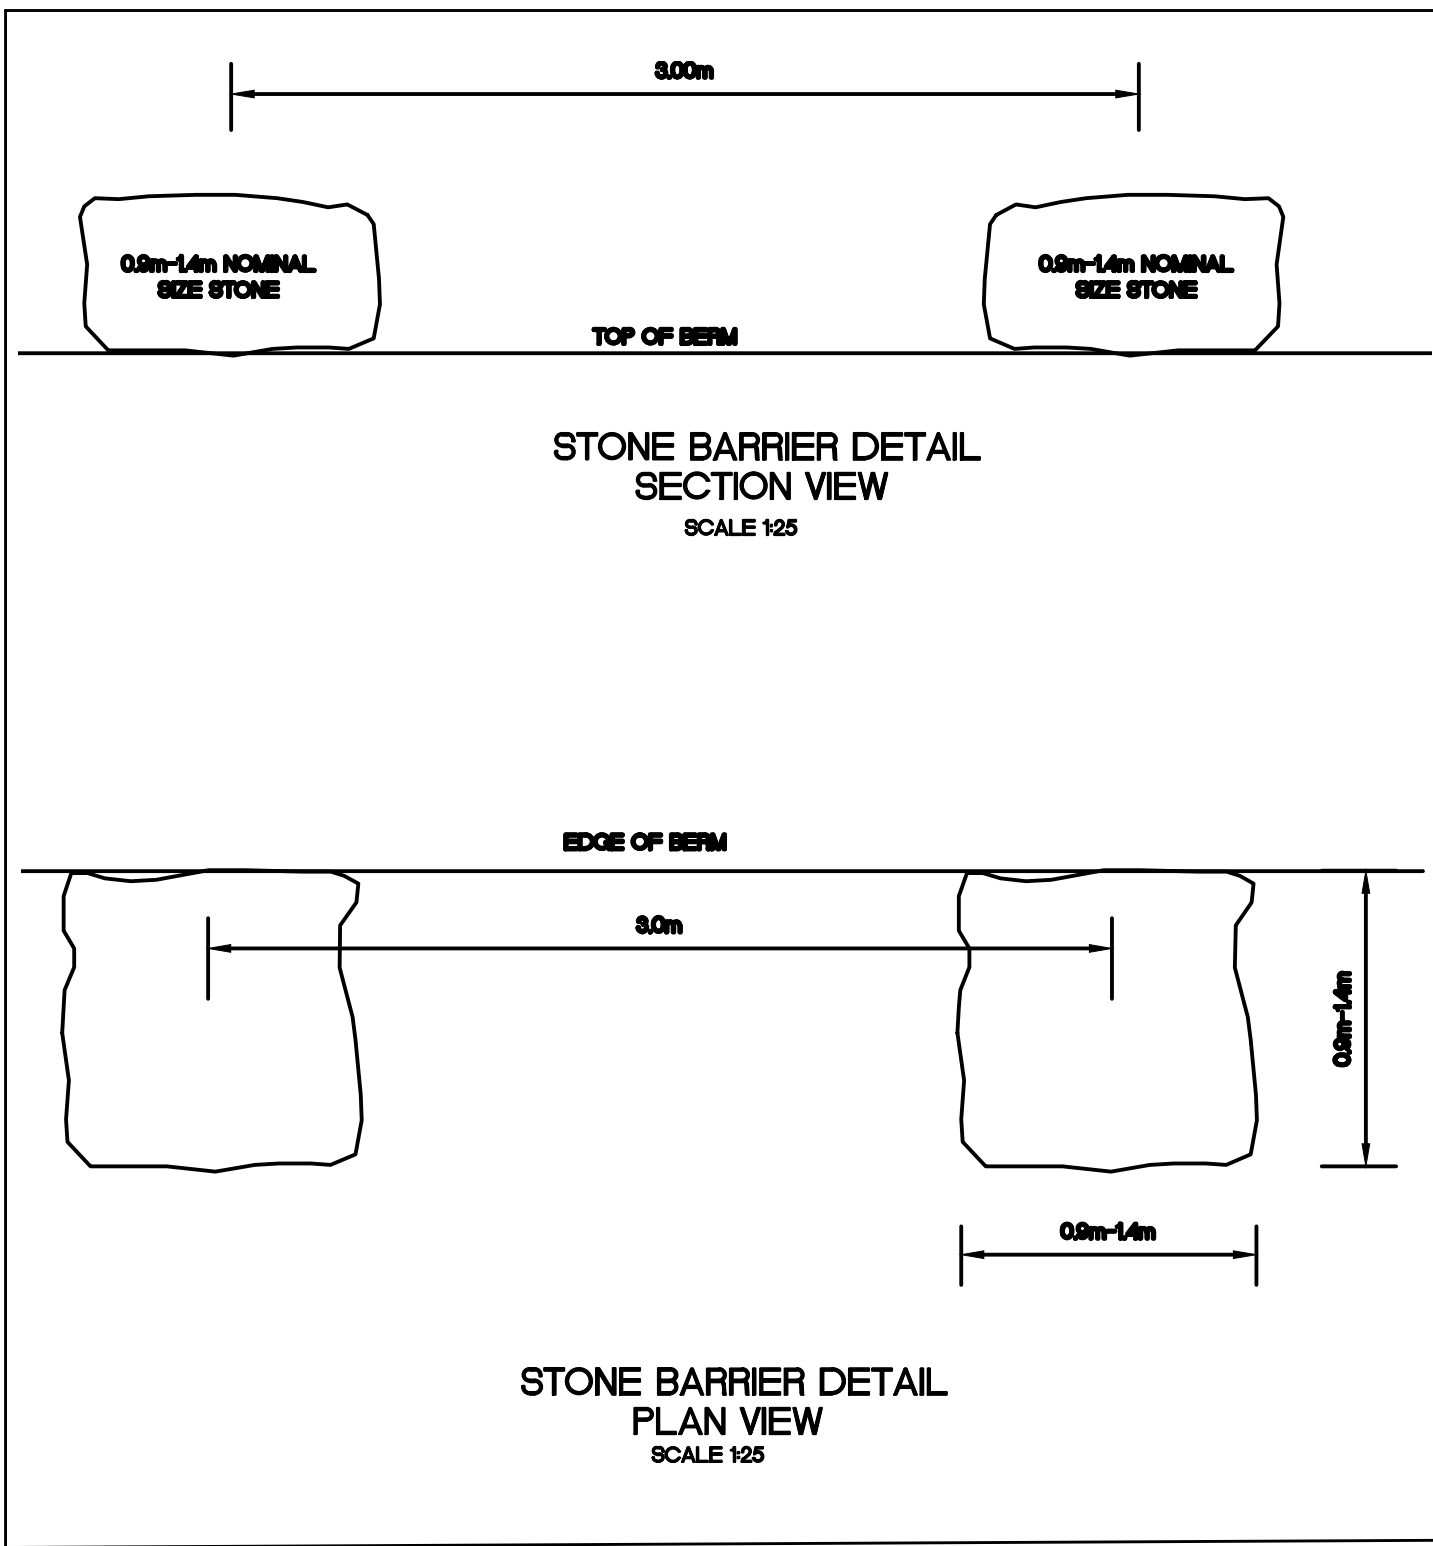

STONE BARRIER DETAIL
PLAN VIEW
SCALE 1:25

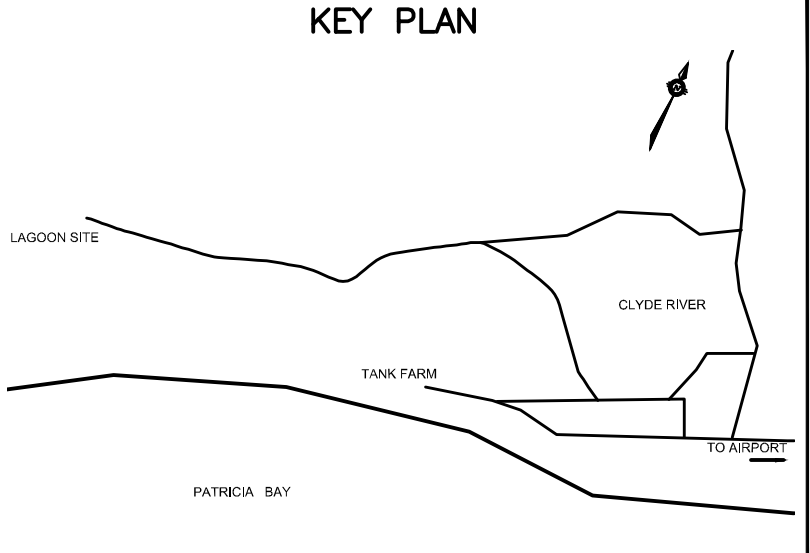

AS-BUILT

DATE: DECEMBER 31st, 2011

BENCH MARK
BM 1
RE-BAR SET NEAR THE INTERSECTION OF THE LAGOON ACCESS ROAD AND METAL DUMP ACCESS ROAD. NORTH-EAST OF THE LAGOON SITE.
ELEV. = 65.16

No.	DESCRIPTION	DATE	BY	APP'D
7	AS-BUILT	31/12/11	MEB	SLB
6	AS-CONSTRUCTED 2011	18/11/11	MEB	SLB
5	AS-CONSTRUCTED	02/12/10	MEB	SLB
4	REV DEWATERING INLET	10/08/09	MMR	SLB
3	ISSUED FOR CONSTRUCTION	15/06/09	MMR	SLB
2	REVISED FOR TENDER	28/05/08	MMR	SLB
1	ISSUED FOR TENDER	28/04/08	MMR	SLB

DRAWINGS ORIGINALLY SEALED BY
S.L.BURDEN, P.eng. OF
exp. SERVICES Inc.
MAY 28TH, 2008

Trow Associates Inc.
100-2650 Queensview Drive PHONE: (613) 688-1899
Ottawa, Ont. K2B 8H6 FAX: (613) 225-7337

CLIENT
GOVERNMENT OF NUNAVUT

PROJECT
CLYDE RIVER
WASTEWATER LAGOON

TITLE
TRUCK DISCHARGE
SITE PLANS

design by SAD project no. OTC000190554
drawn by MEB drawing no.
checked by S.L.B.
date 30/08/2007
scale 1:250

TD1