

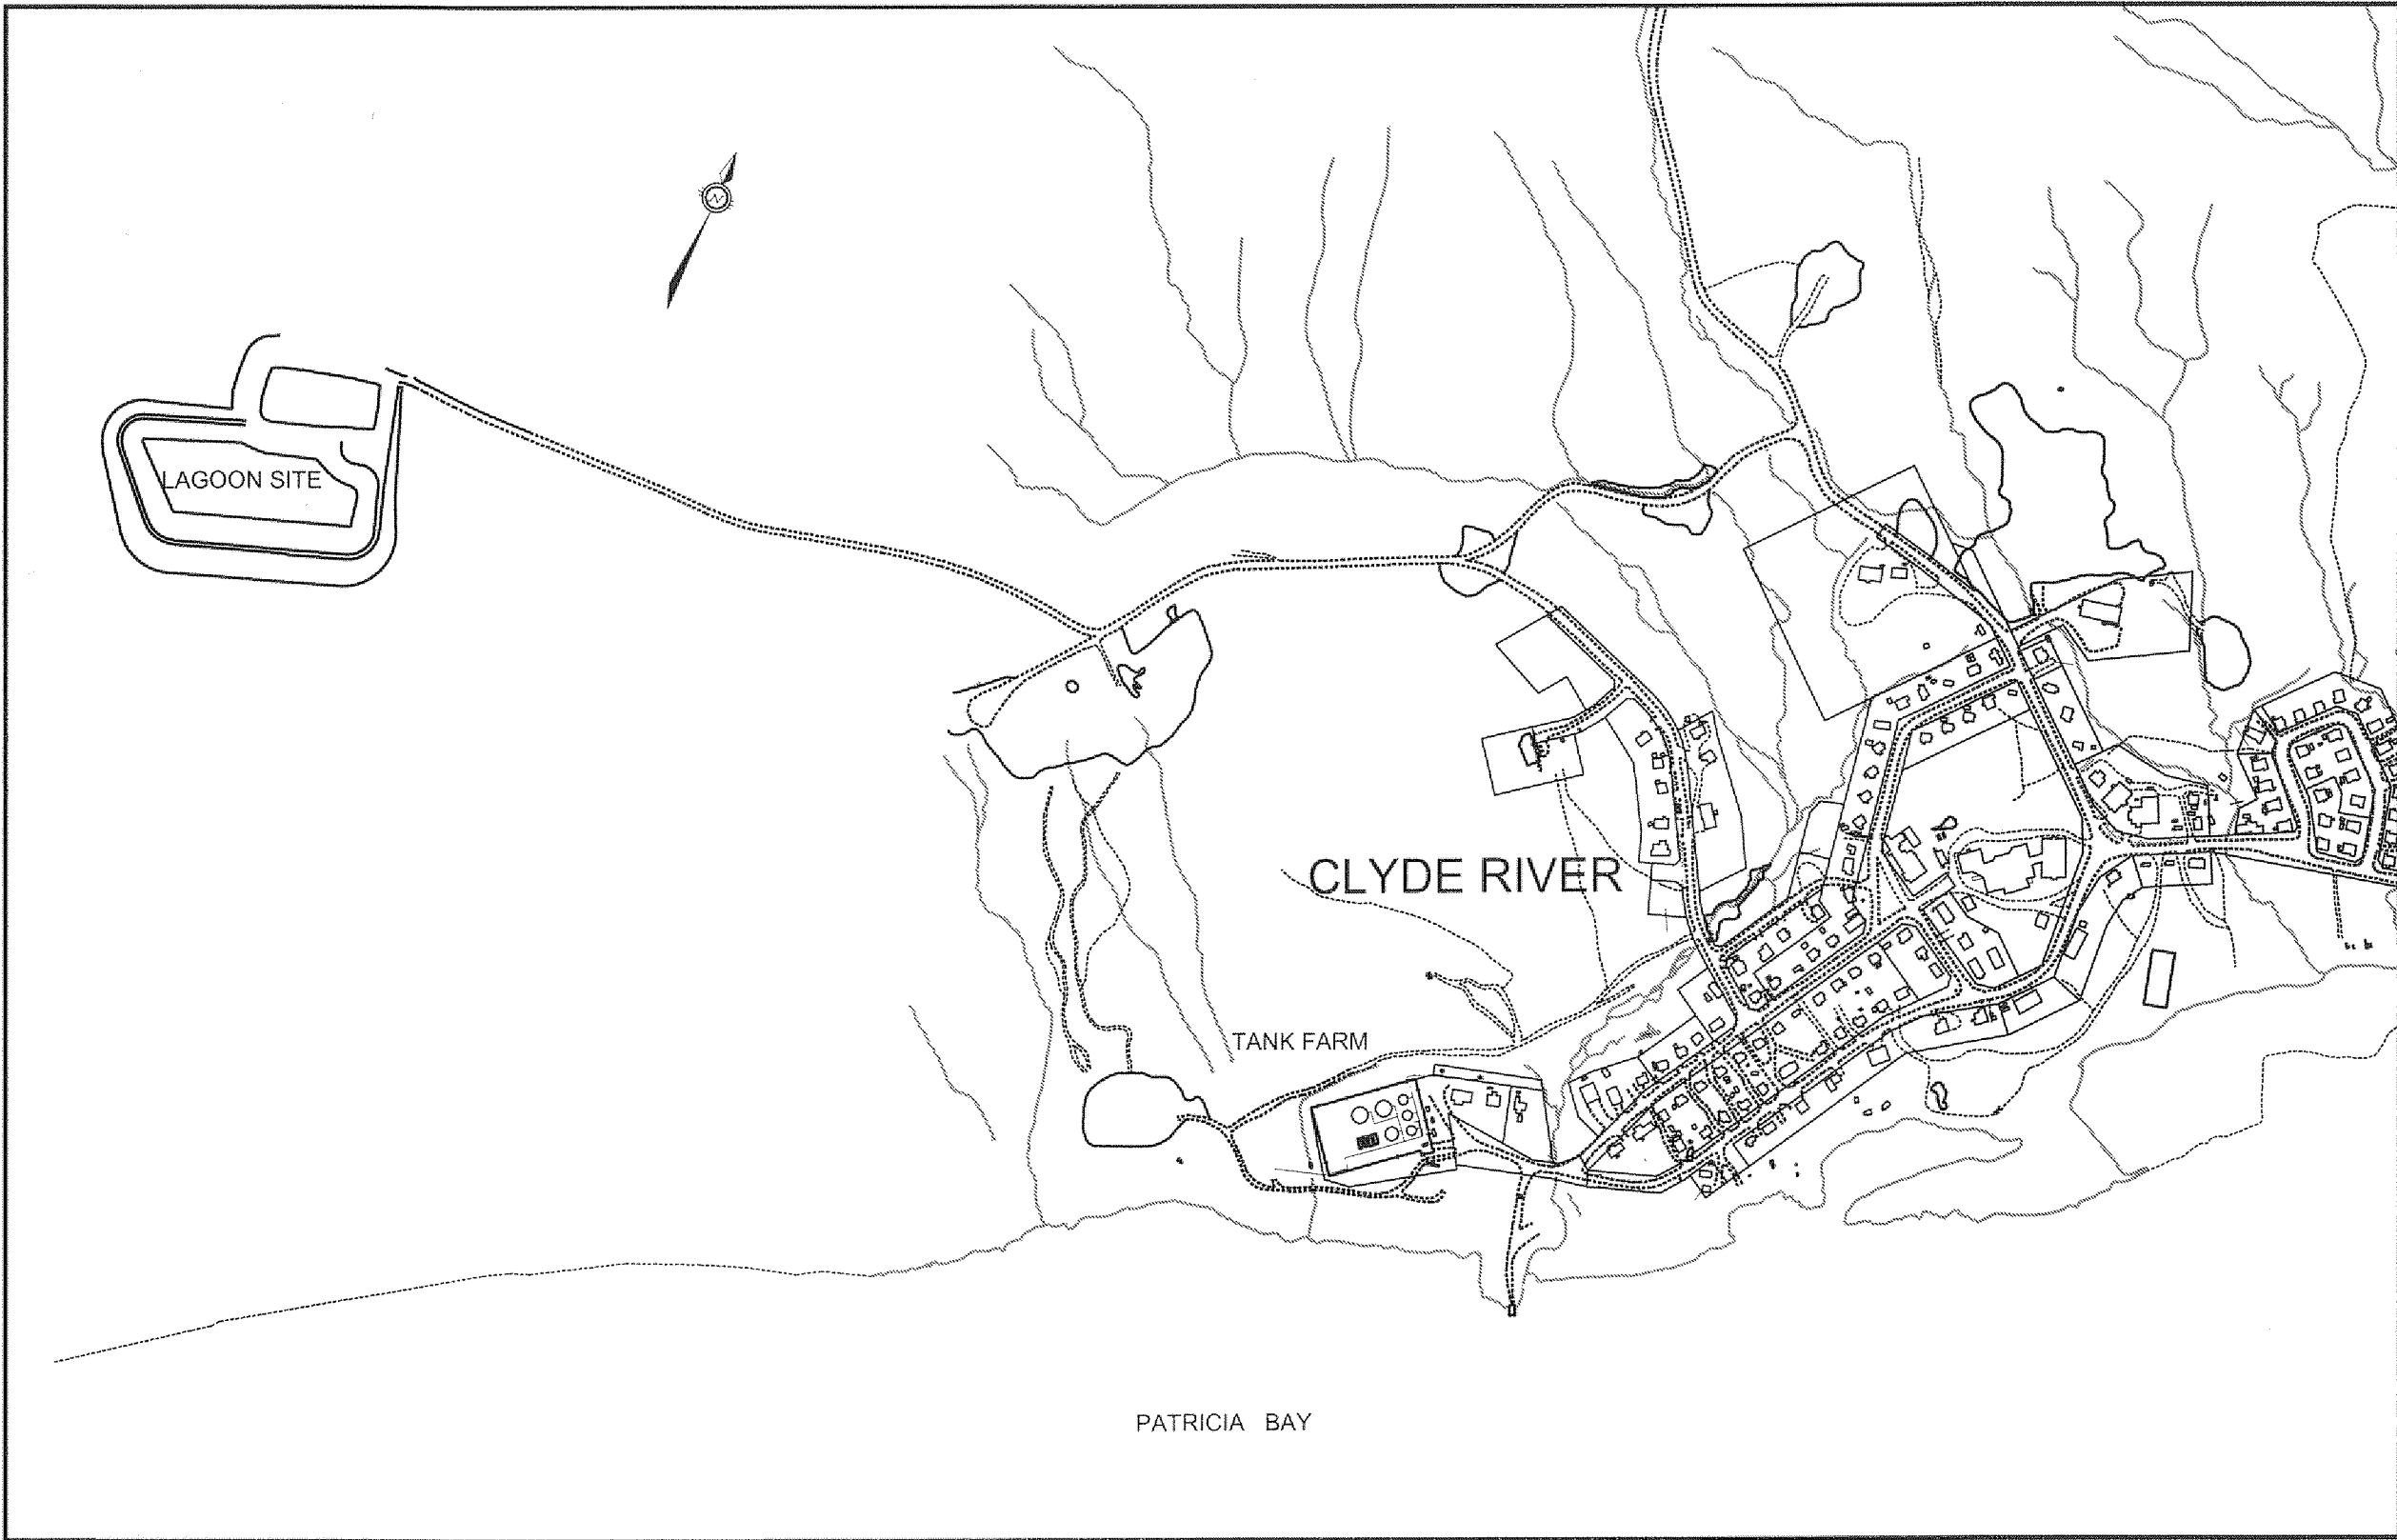


GOVERNMENT OF NUNAVUT

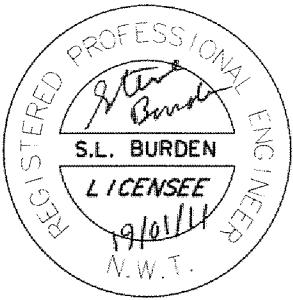


INDEX OF INCLUDED DRAWINGS

DRAWING NO.	REVISION	DESCRIPTION
		COVER
OTCD00019055A-SP1	REV 4	OVERALL SITE PLAN
OTCD00019055A-SP2	REV 4	SITE PLAN
OTCD00019055A-TD1	REV 5	TRUCK DISCHARGE SITE PLANS
OTCD00019055A-DE1	REV 4	DETAILS
OTCD00019055A-DE2	REV 4	DETAILS
OTCD00019055A-T1	REV 1	MUNICIPAL LOCATION PLAN

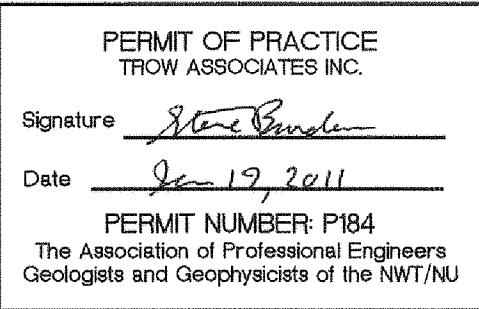



CLYDE RIVER WASTEWATER LAGOON (NEW SEWAGE LAGOON AND REHABILITATE EXISTING LAGOON)

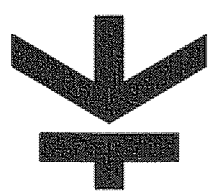

Trow Associates Inc.

100-2650 Queensview Drive PHONE: (613) 688-1899
Ottawa, Ont. K2B 8H6 FAX: (613) 225-7337

AS-CONSTRUCTED
2010

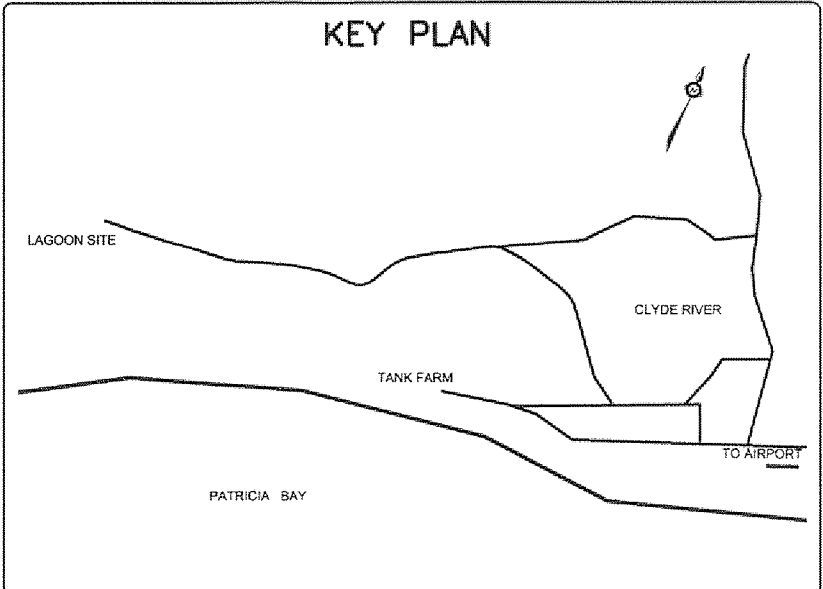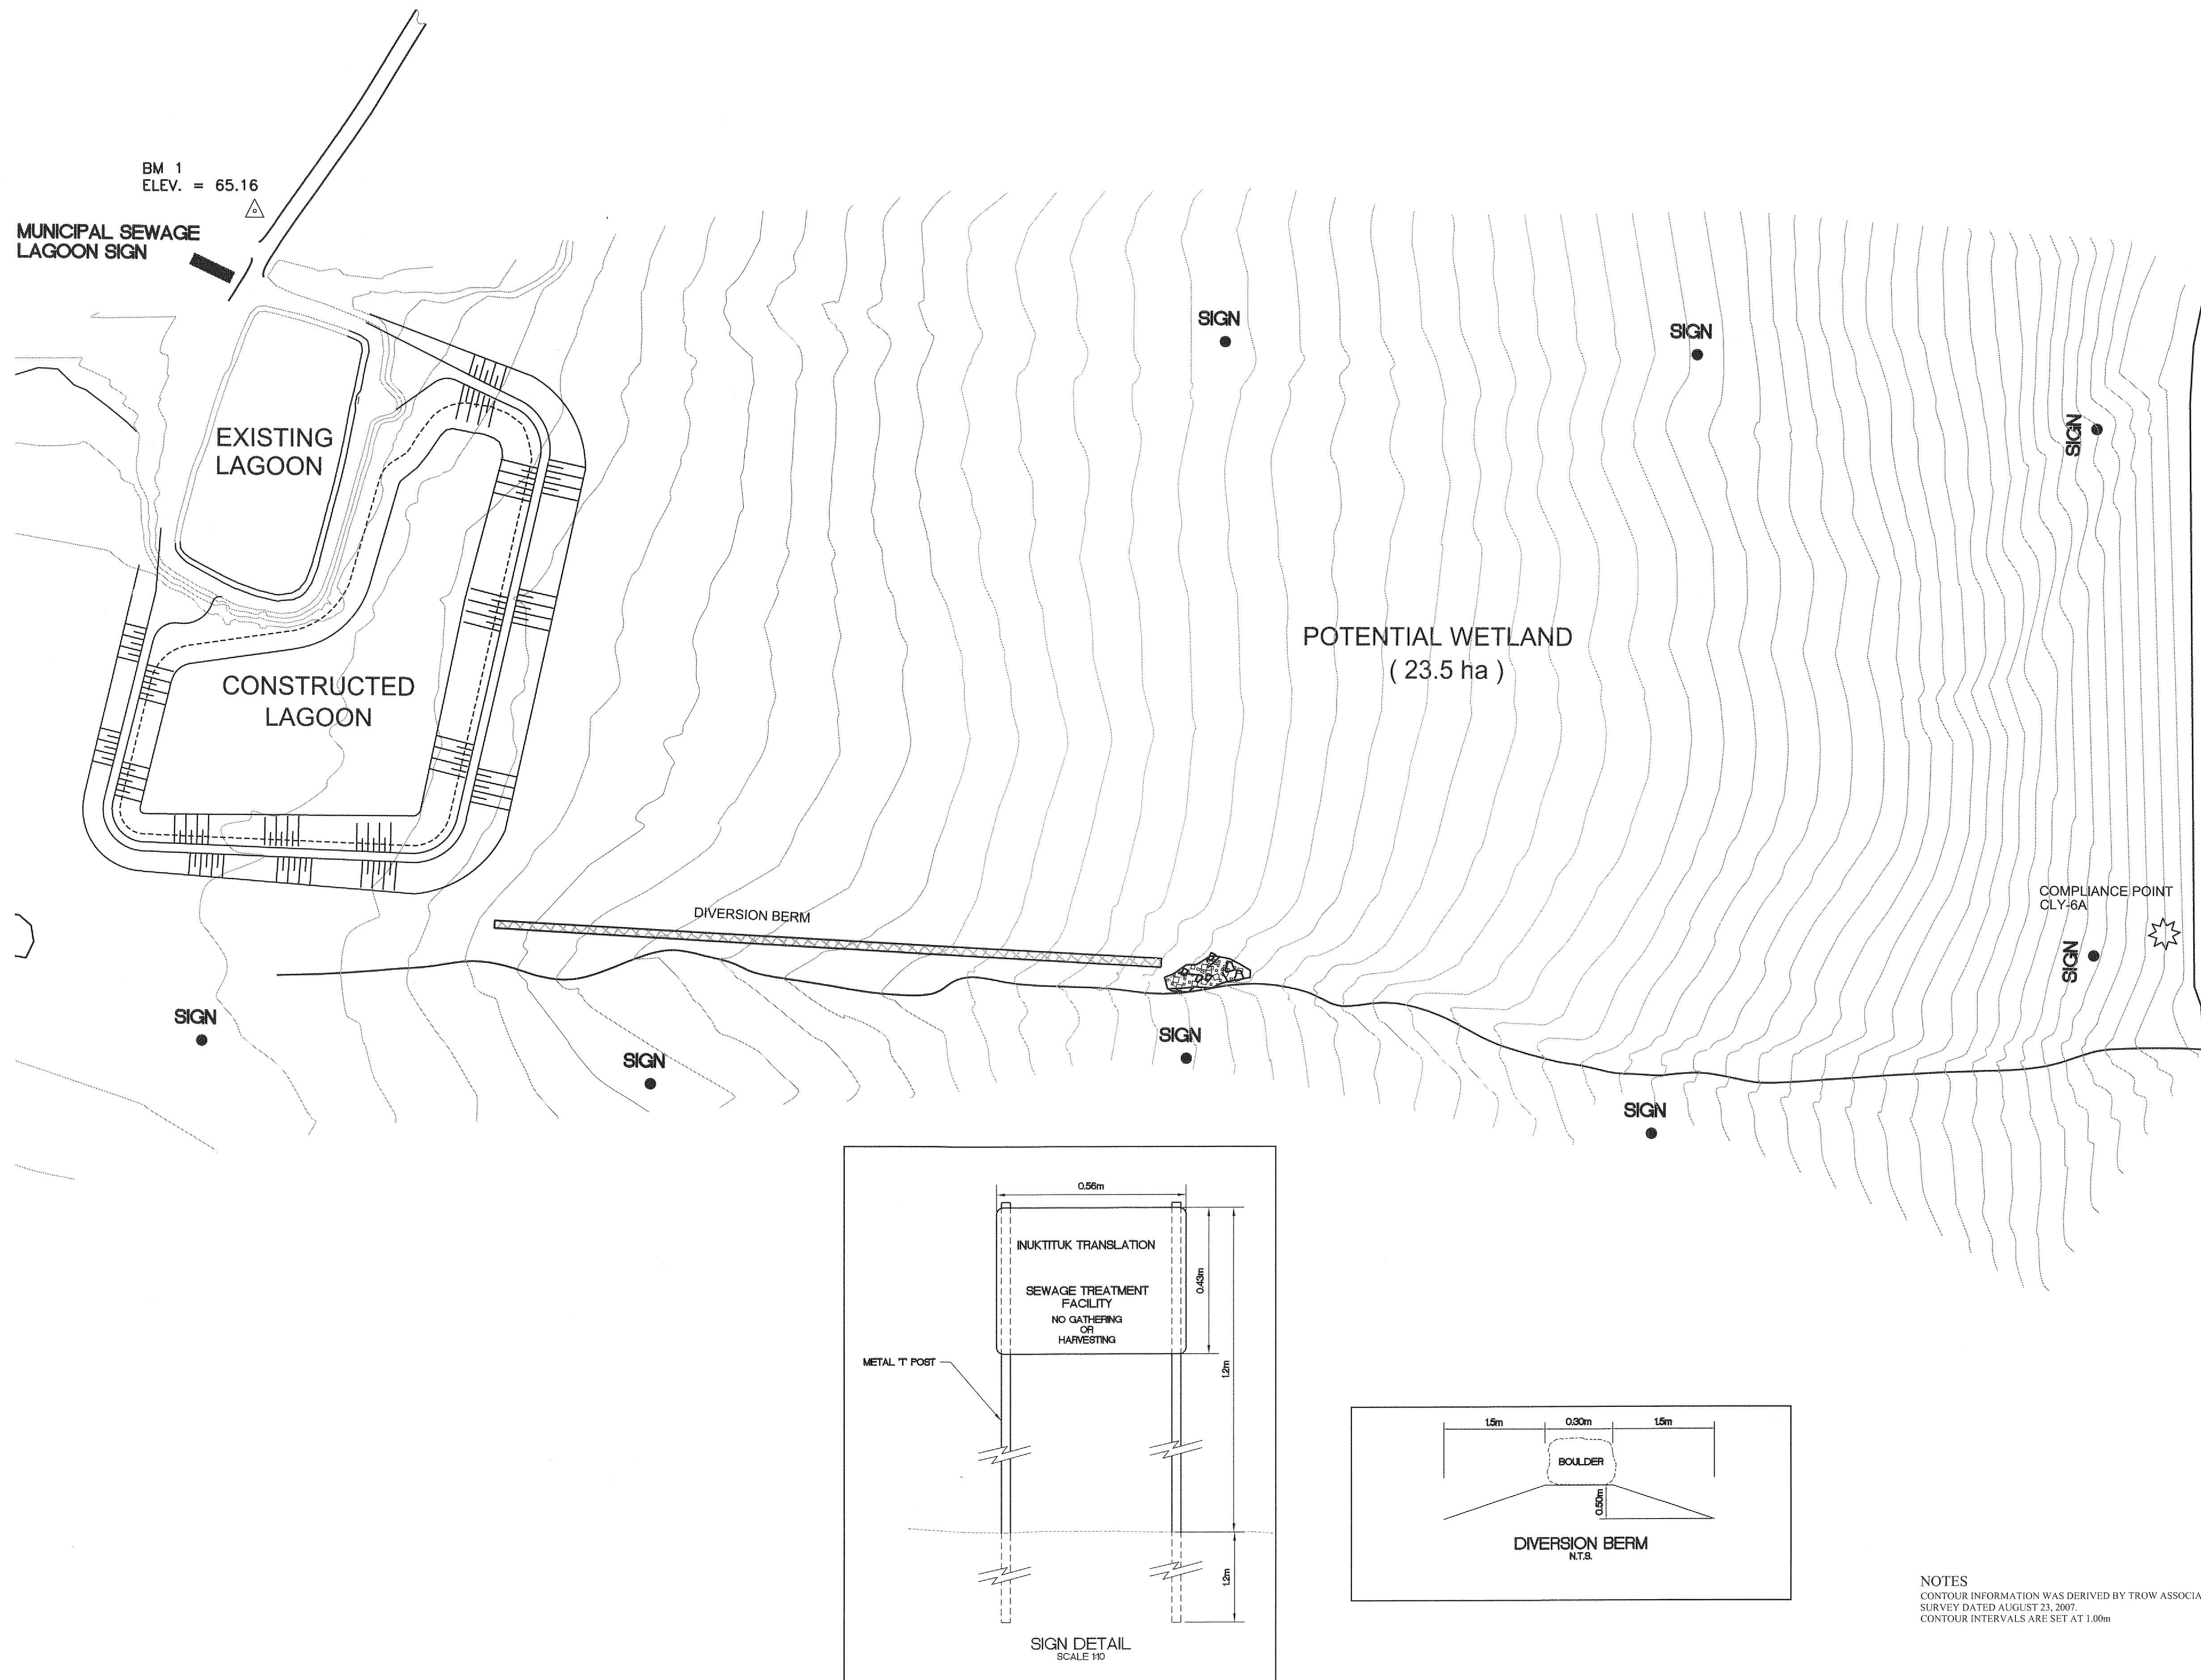


AS-CONSTRUCTED
2010

PERMIT OF PRACTICE
TROW ASSOCIATES INC.
Signature *[Signature]*
Date *June 19, 2011*
PERMIT NUMBER: P184
The Association of Professional Engineers
Geologists and Geophysicists of the NWT/NU

BENCH MARK
BM 1 ELEV. = 65.16
RE-BAR SET NEAR THE INTERSECTION OF THE LAGOON ACCESS
ROAD AND METAL DUMP ACCESS ROAD, NORTH-EAST OF THE
LAGOON SITE.

No.	DESCRIPTION	DATE	BY	APP'D
4	AS-CONSTRUCTED	02/12/10	MEB	SLB
3	ISSUED FOR CONSTRUCTION	15/06/09	MMR	SLB
2	REVISED FOR TENDER	28/05/08	MMR	SLB
1	ISSUED FOR TENDER	28/04/08	MMR	SLB

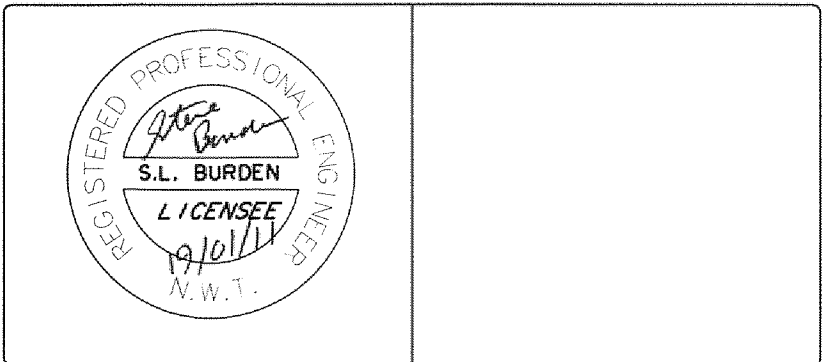


Trow Associates Inc.
154 Colonnade Road South
Ottawa, Ont. K2E 7J5
Tel: (613) 225-9940
Fax: (613) 225-7337

CLIENT
GOVERNMENT OF NUNAVUT

PROJECT
CLYDE RIVER
WASTEWATER LAGOON
TITLE
OVERALL
SITE PLAN

design by	SAD	project no.	OTCD00019055A
drawn by	MEB	drawing no.	SP-1
checked by	SLB		
date	30/08/2007		
scale	HORIZ 1:1500		

NOTES
CONTOUR INFORMATION WAS DERIVED BY TROW ASSOCIATES INC.
SURVEY DATED AUGUST 23, 2007
CONTOUR INTERVALS ARE SET AT 1.00m

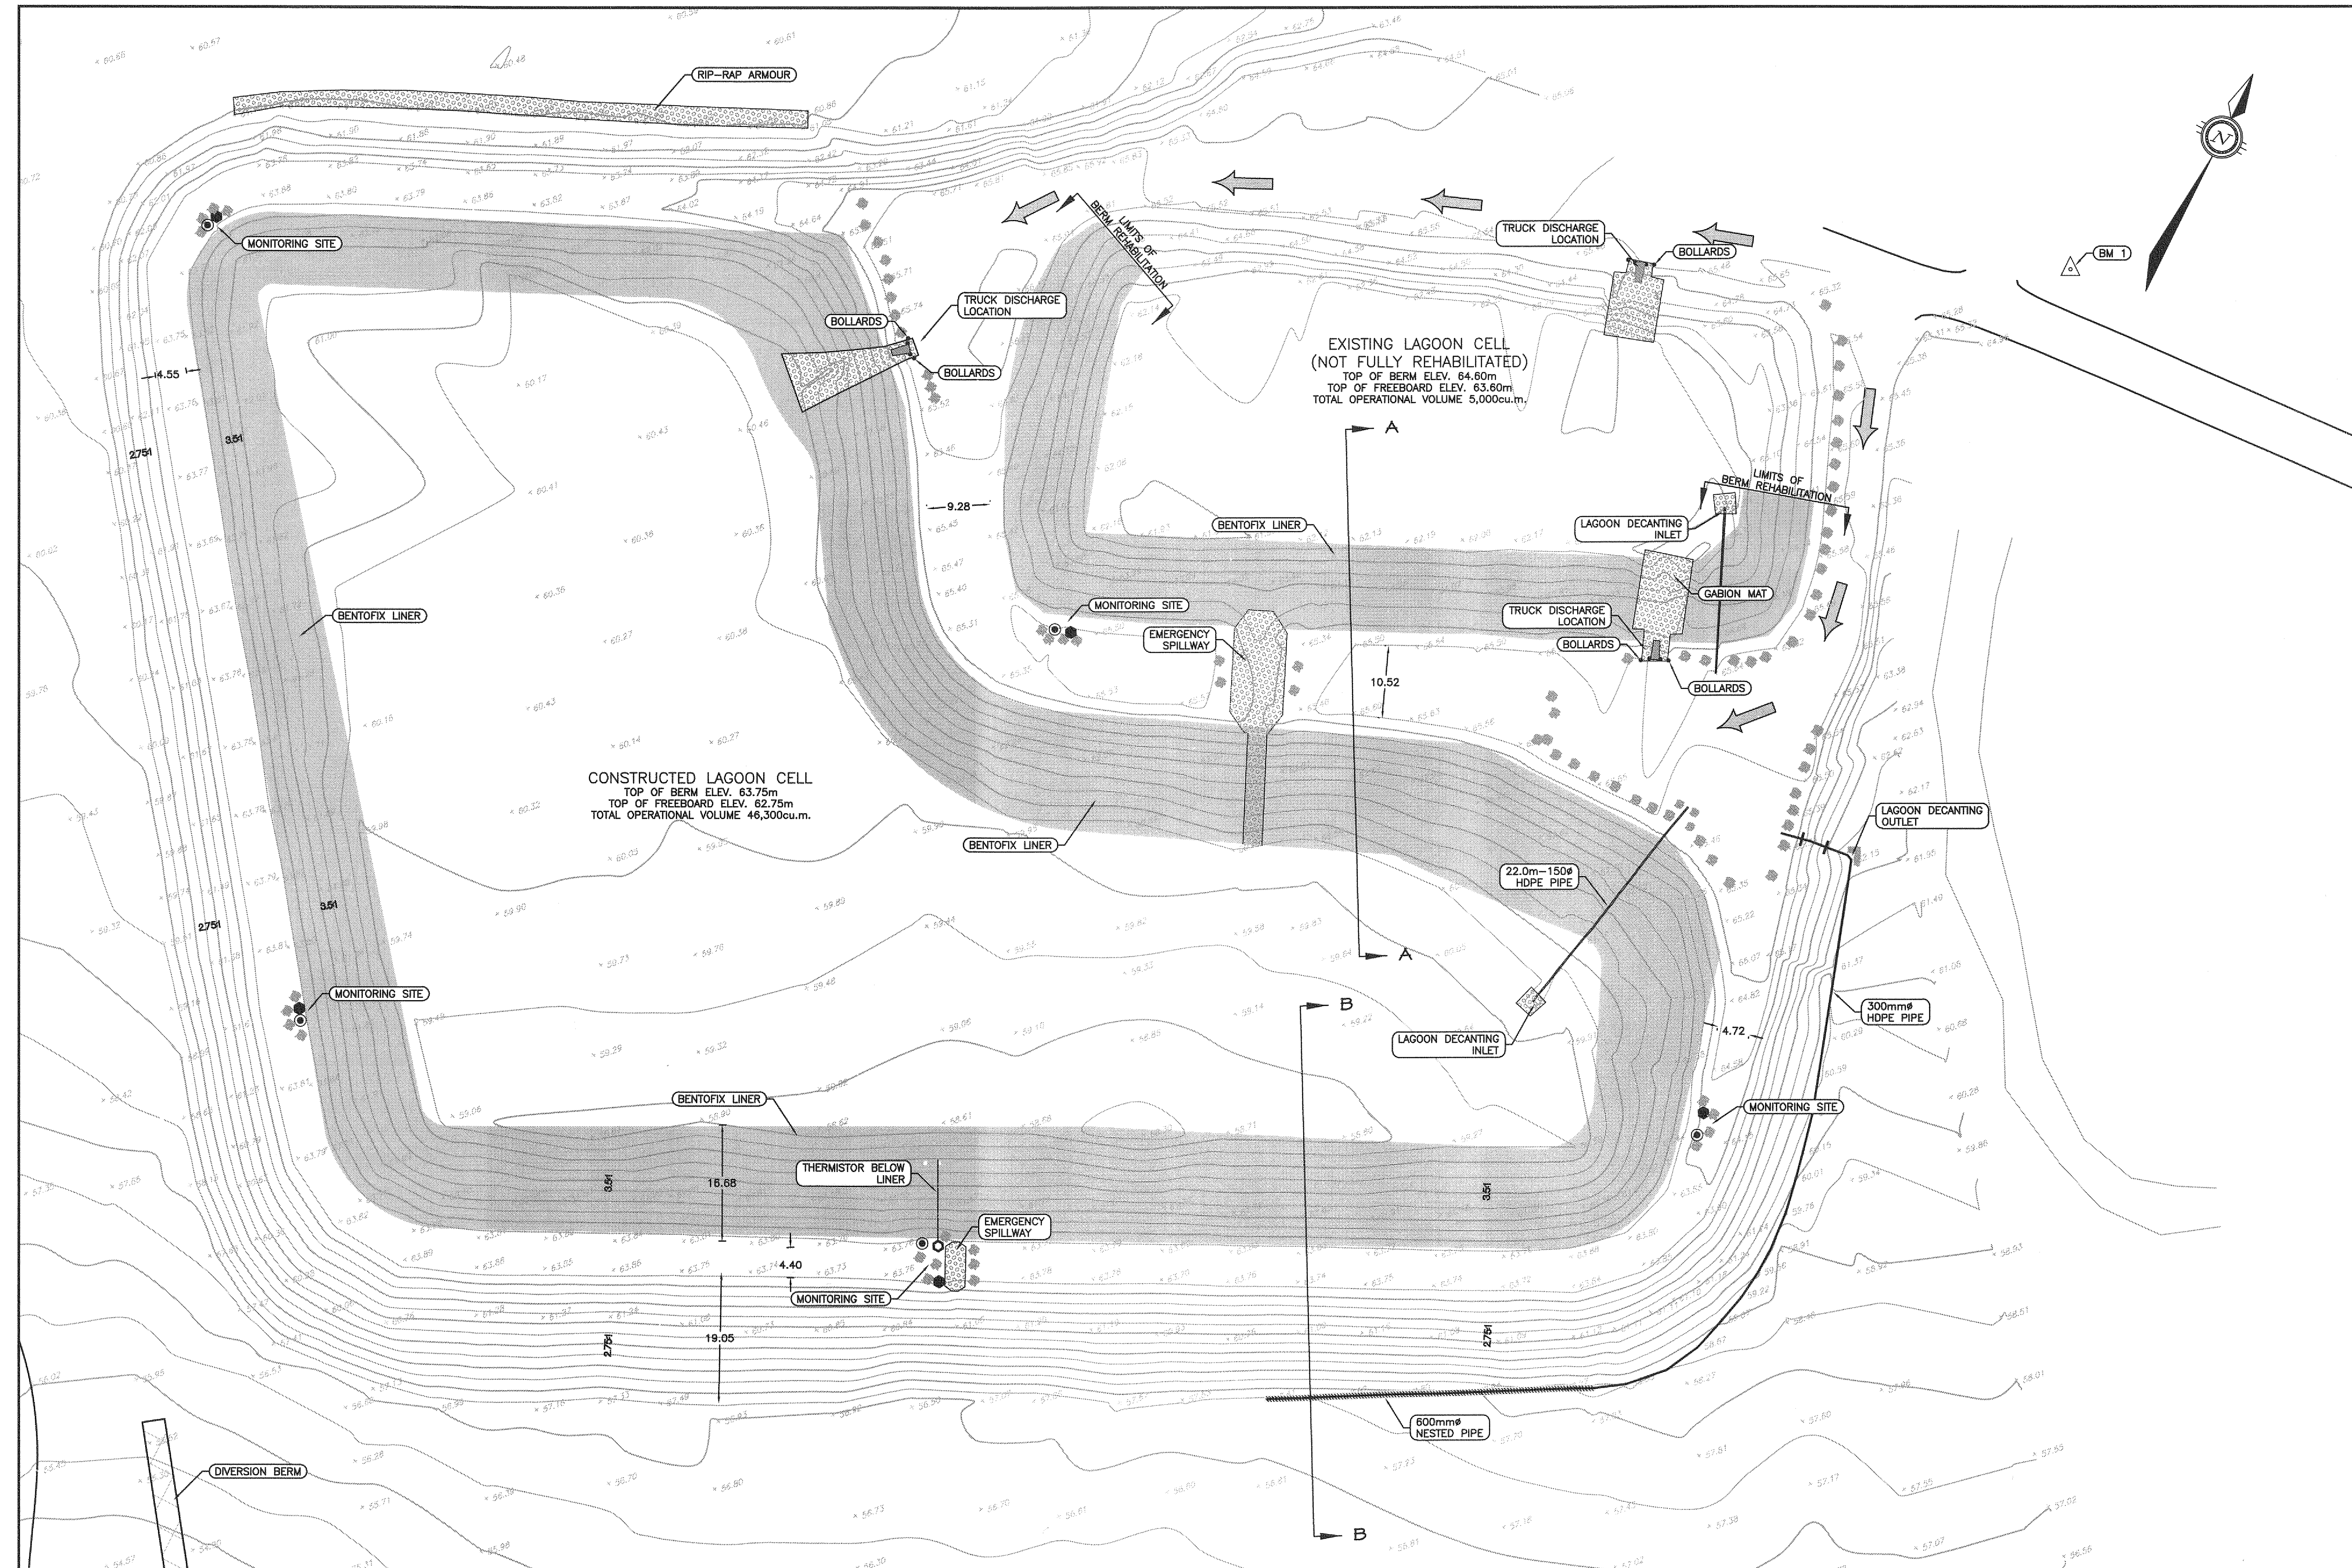

LEGEND

- MONITORING WELL (SAMPLING POINT)
- THERMISTOR
- THERMISTOR BELOW LINER
- SPOT ELEVATION
- BOULDER
- GABION MAT
- BENTOFIX LINER
- TRUCK ROUTE

AS-CONSTRUCTED 2010

PERMIT OF PRACTICE
TROW ASSOCIATES INC.
Signature: *[Signature]*
Date: *19/11/11*
PERMIT NUMBER: P184
The Association of Professional Engineers
Geologists and Geophysicists of the NWT/NU

BENCH MARK
BM 1 ELEV. = 65.16
RE-BAR SET NEAR THE INTERSECTION OF THE LAGOON ACCESS ROAD AND METAL DUMP ACCESS ROAD, NORTH-EAST OF THE LAGOON SITE.

No.	DESCRIPTION	DATE	BY	APP'D
4	AS-CONSTRUCTED	02/12/10	MEB	SLB
3	ISSUED FOR CONSTRUCTION	15/06/09	MMR	SLB
2	REVISED FOR TENDER	28/05/08	MMR	SLB
1	ISSUED FOR TENDER	28/04/08	MMR	SLB

REVISIONS

REGISTERED PROFESSIONAL ENGINEER
S.L. BURDEN
L.T. CENSEE
N.W.T.



Trow Associates Inc.
100-2650 Queensview Drive
Ottawa, Ont. K2B 8H6
PHONE: (613) 688-1899
FAX: (613) 225-7337


CLIENT
GOVERNMENT OF NUNAVUT

PROJECT
CLYDE RIVER
WASTEWATER LAGOON


TITLE
SITE PLAN

design by	SAD	project no.	OTCD00019055A
drawn by	MEB	drawing no.	SP-2
checked by	SLB		
date	30/08/2007		
scale	HORIZ 1:500		

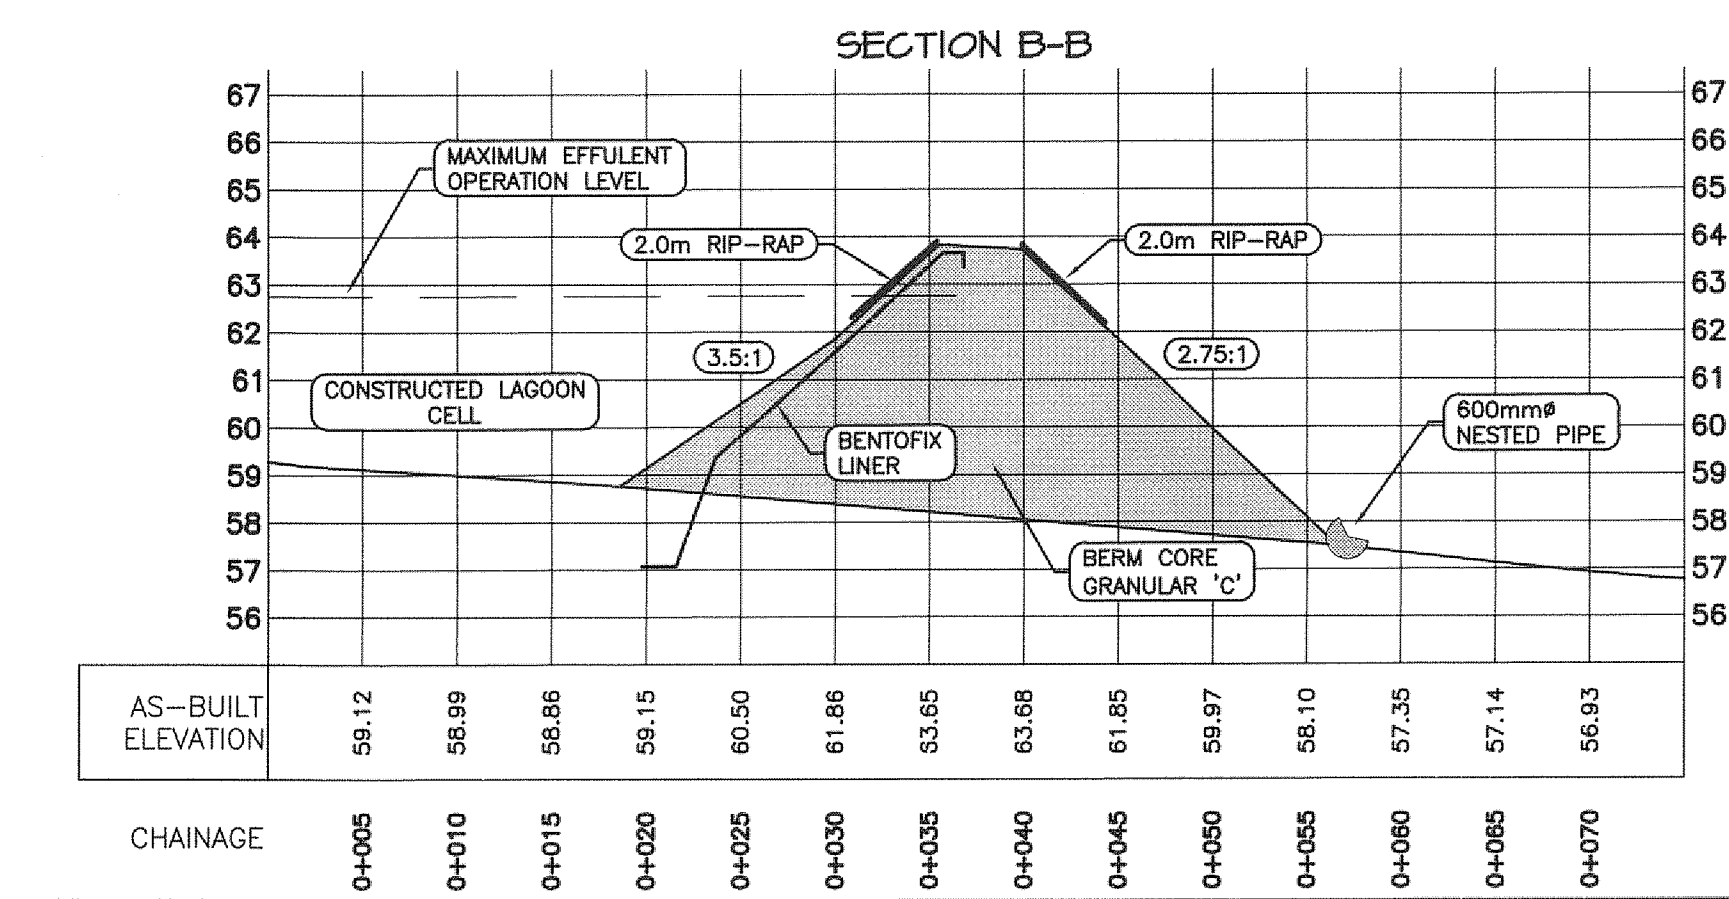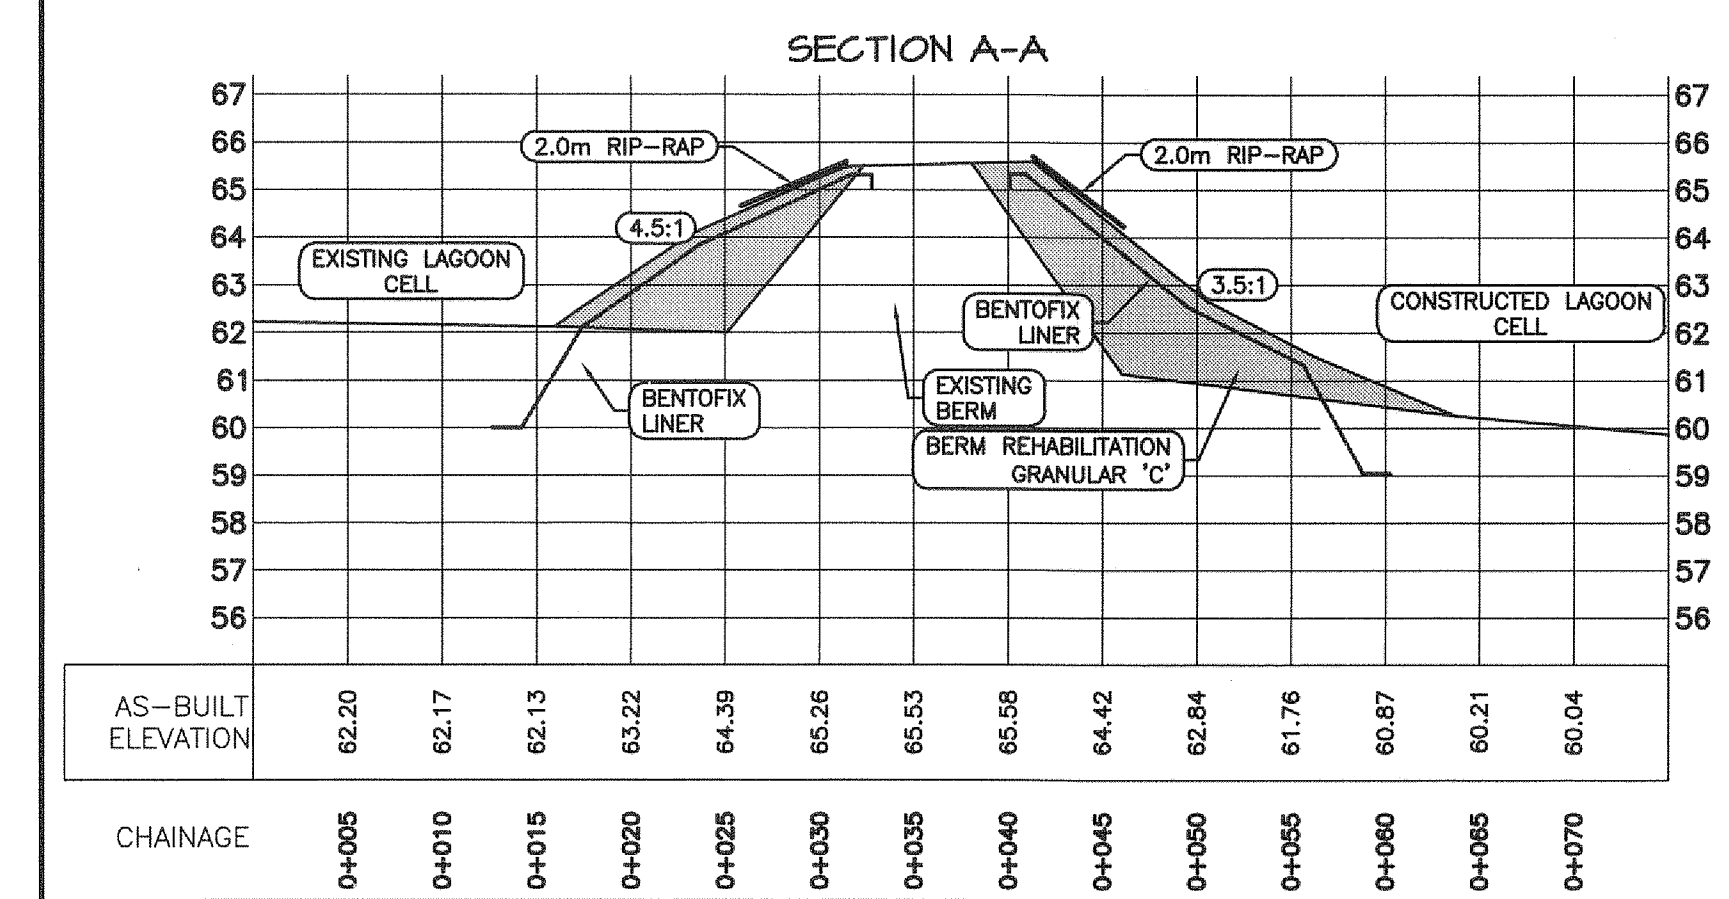


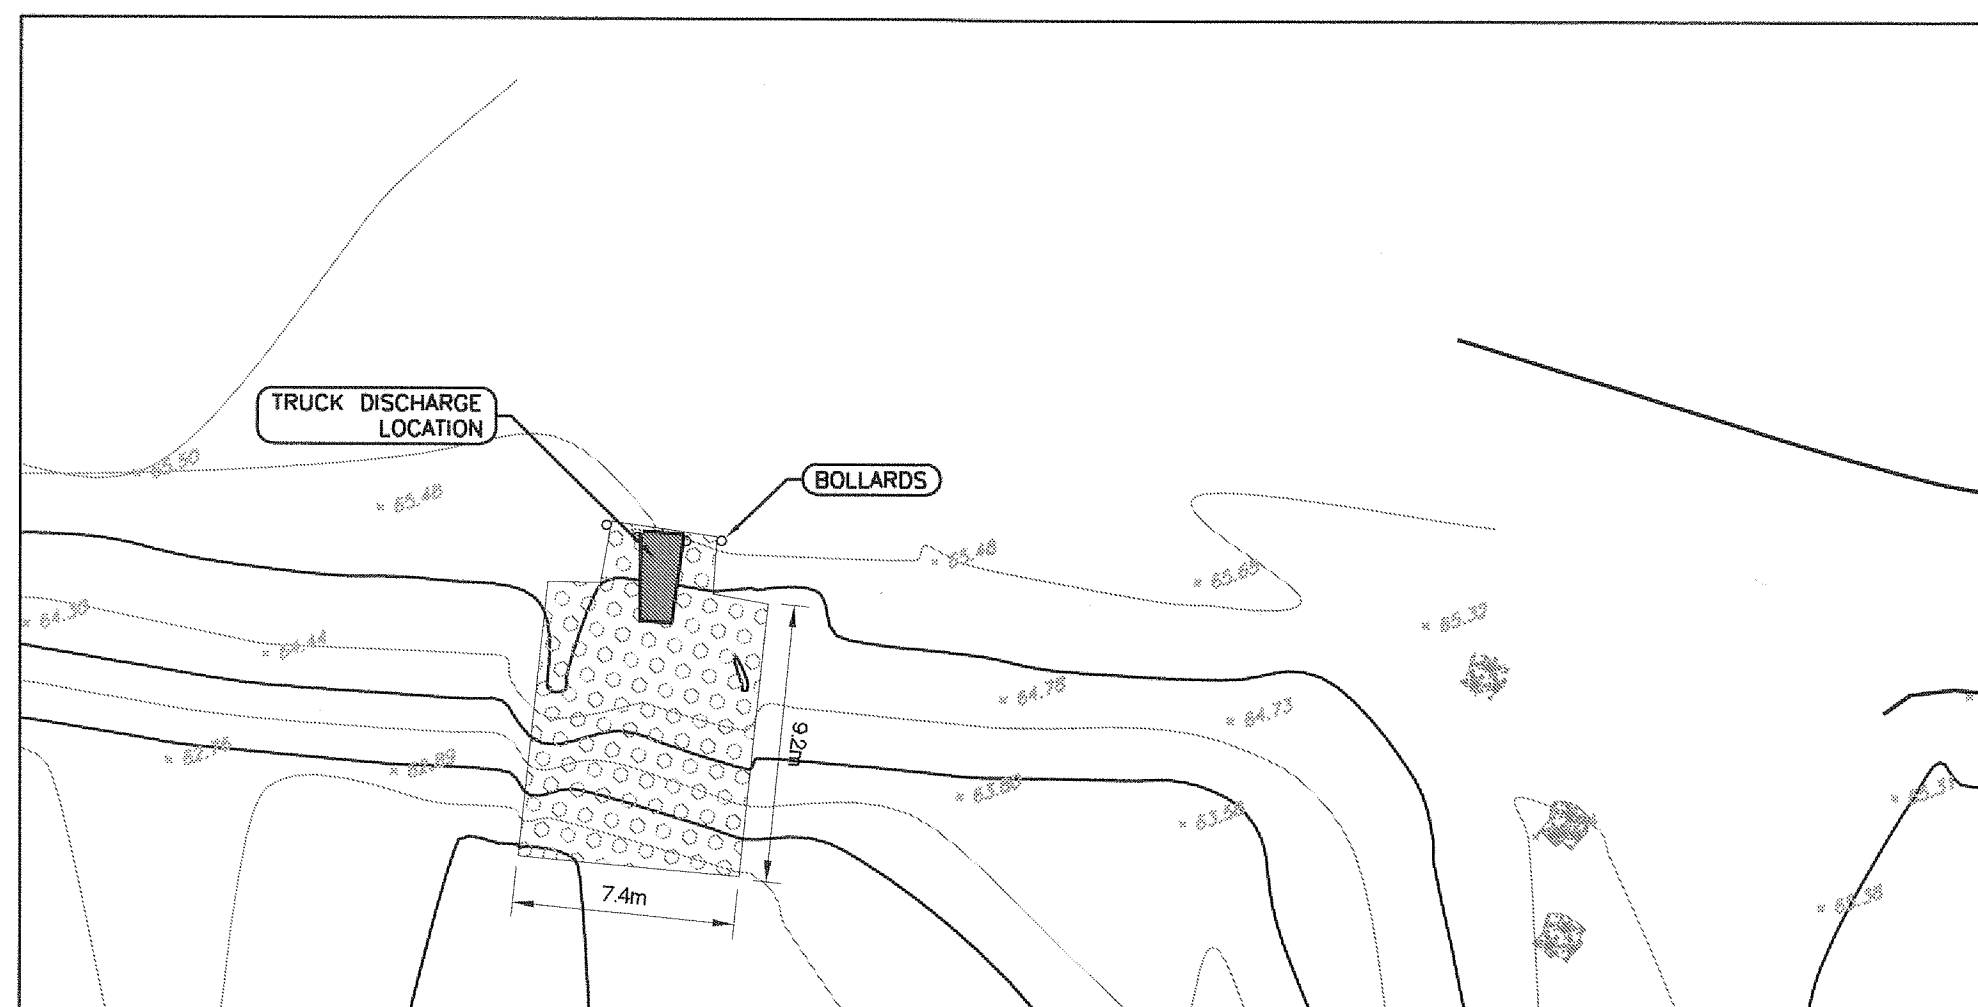




NORTH TRUCK DISCHARGE SITE PLAN

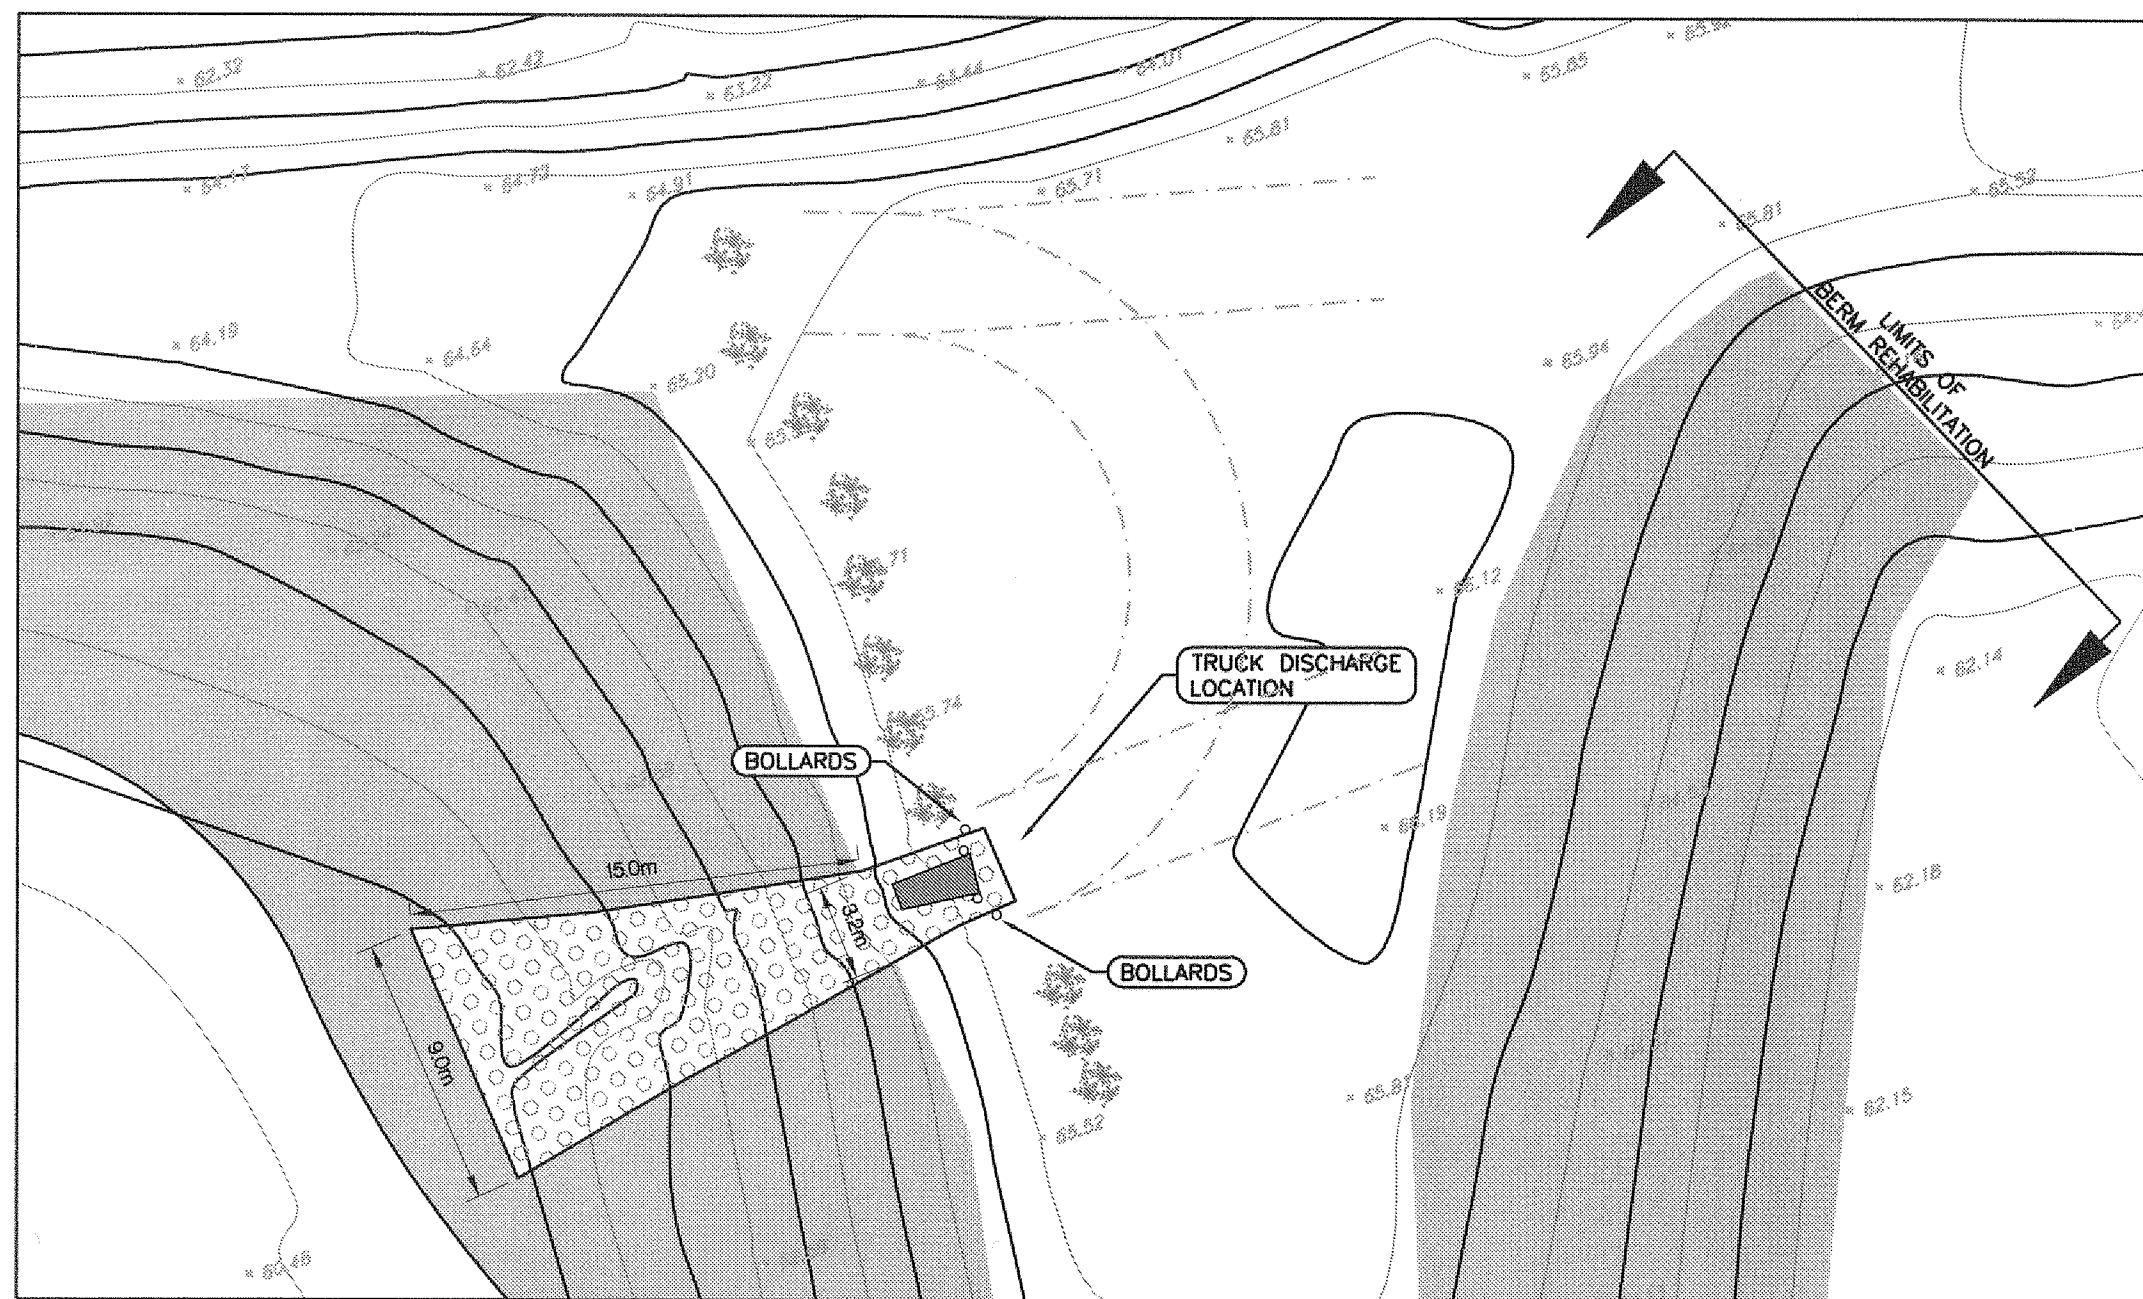

WEST TRUCK DISCHARGE SITE PLAN

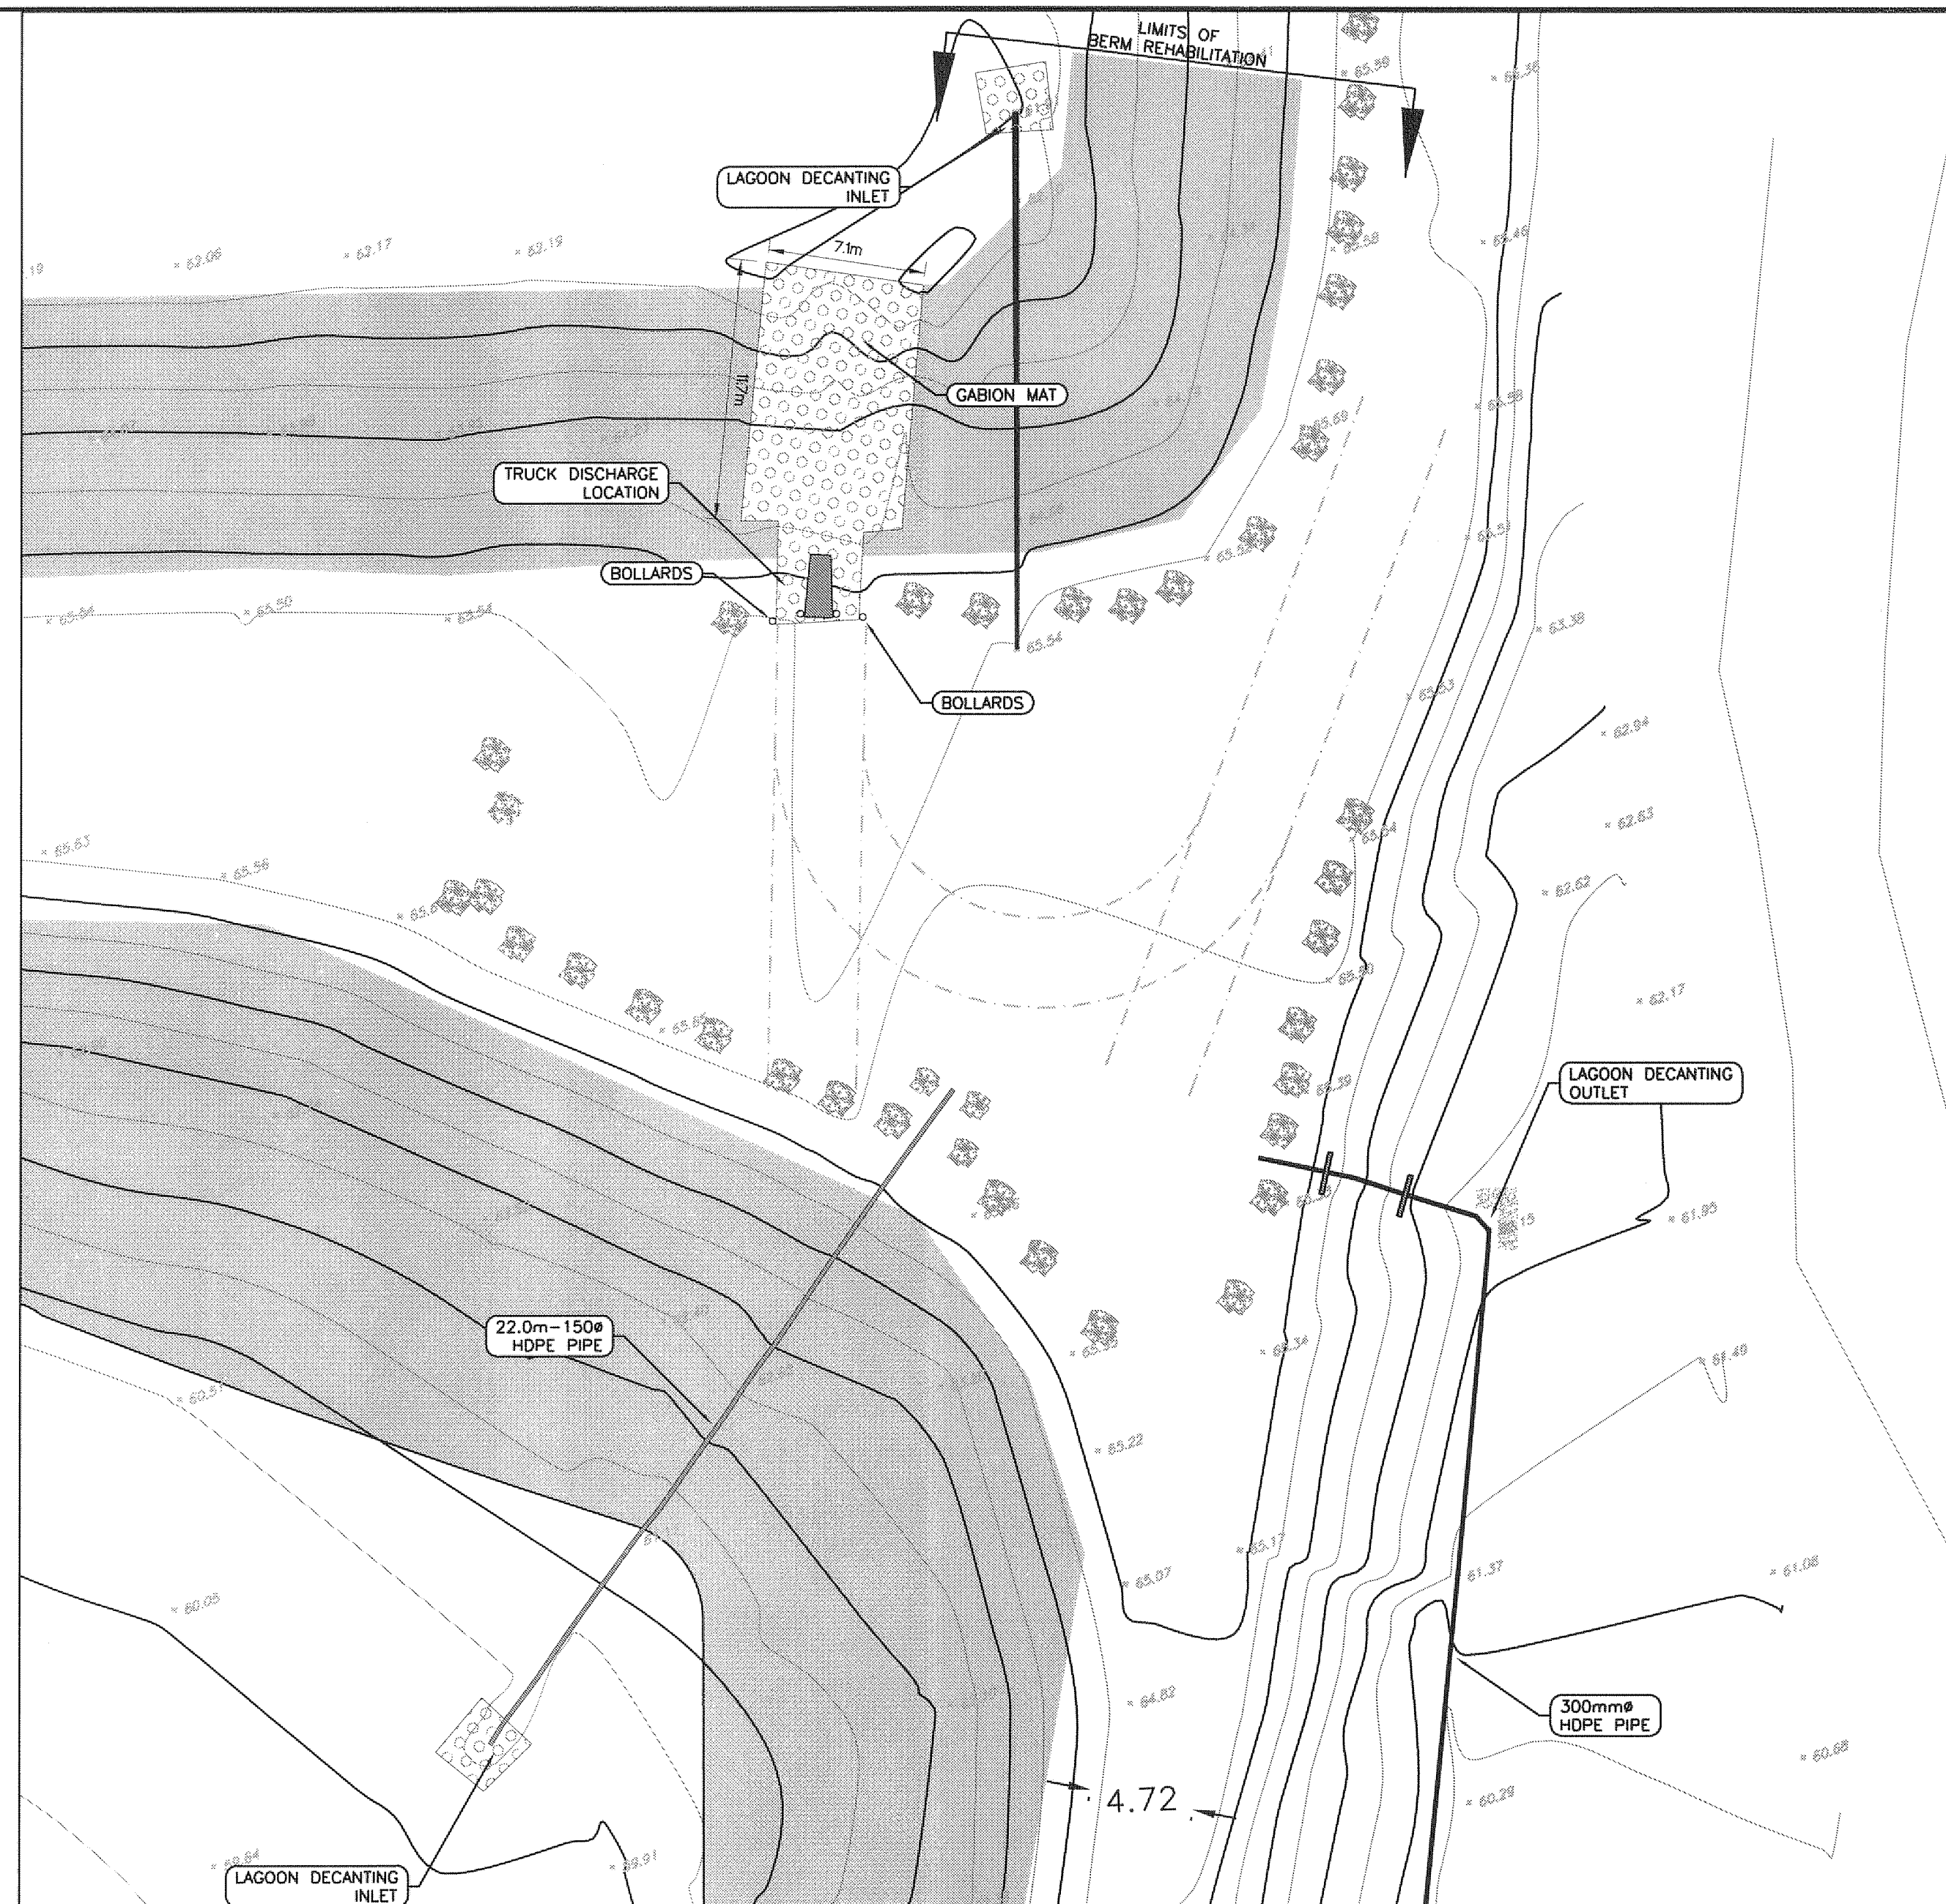

SOUTH TRUCK DISCHARGE SITE PLAN

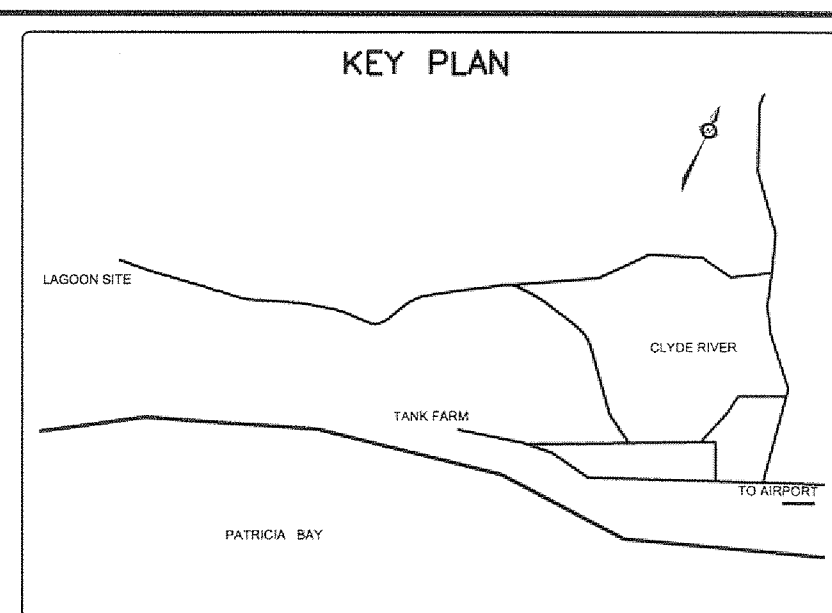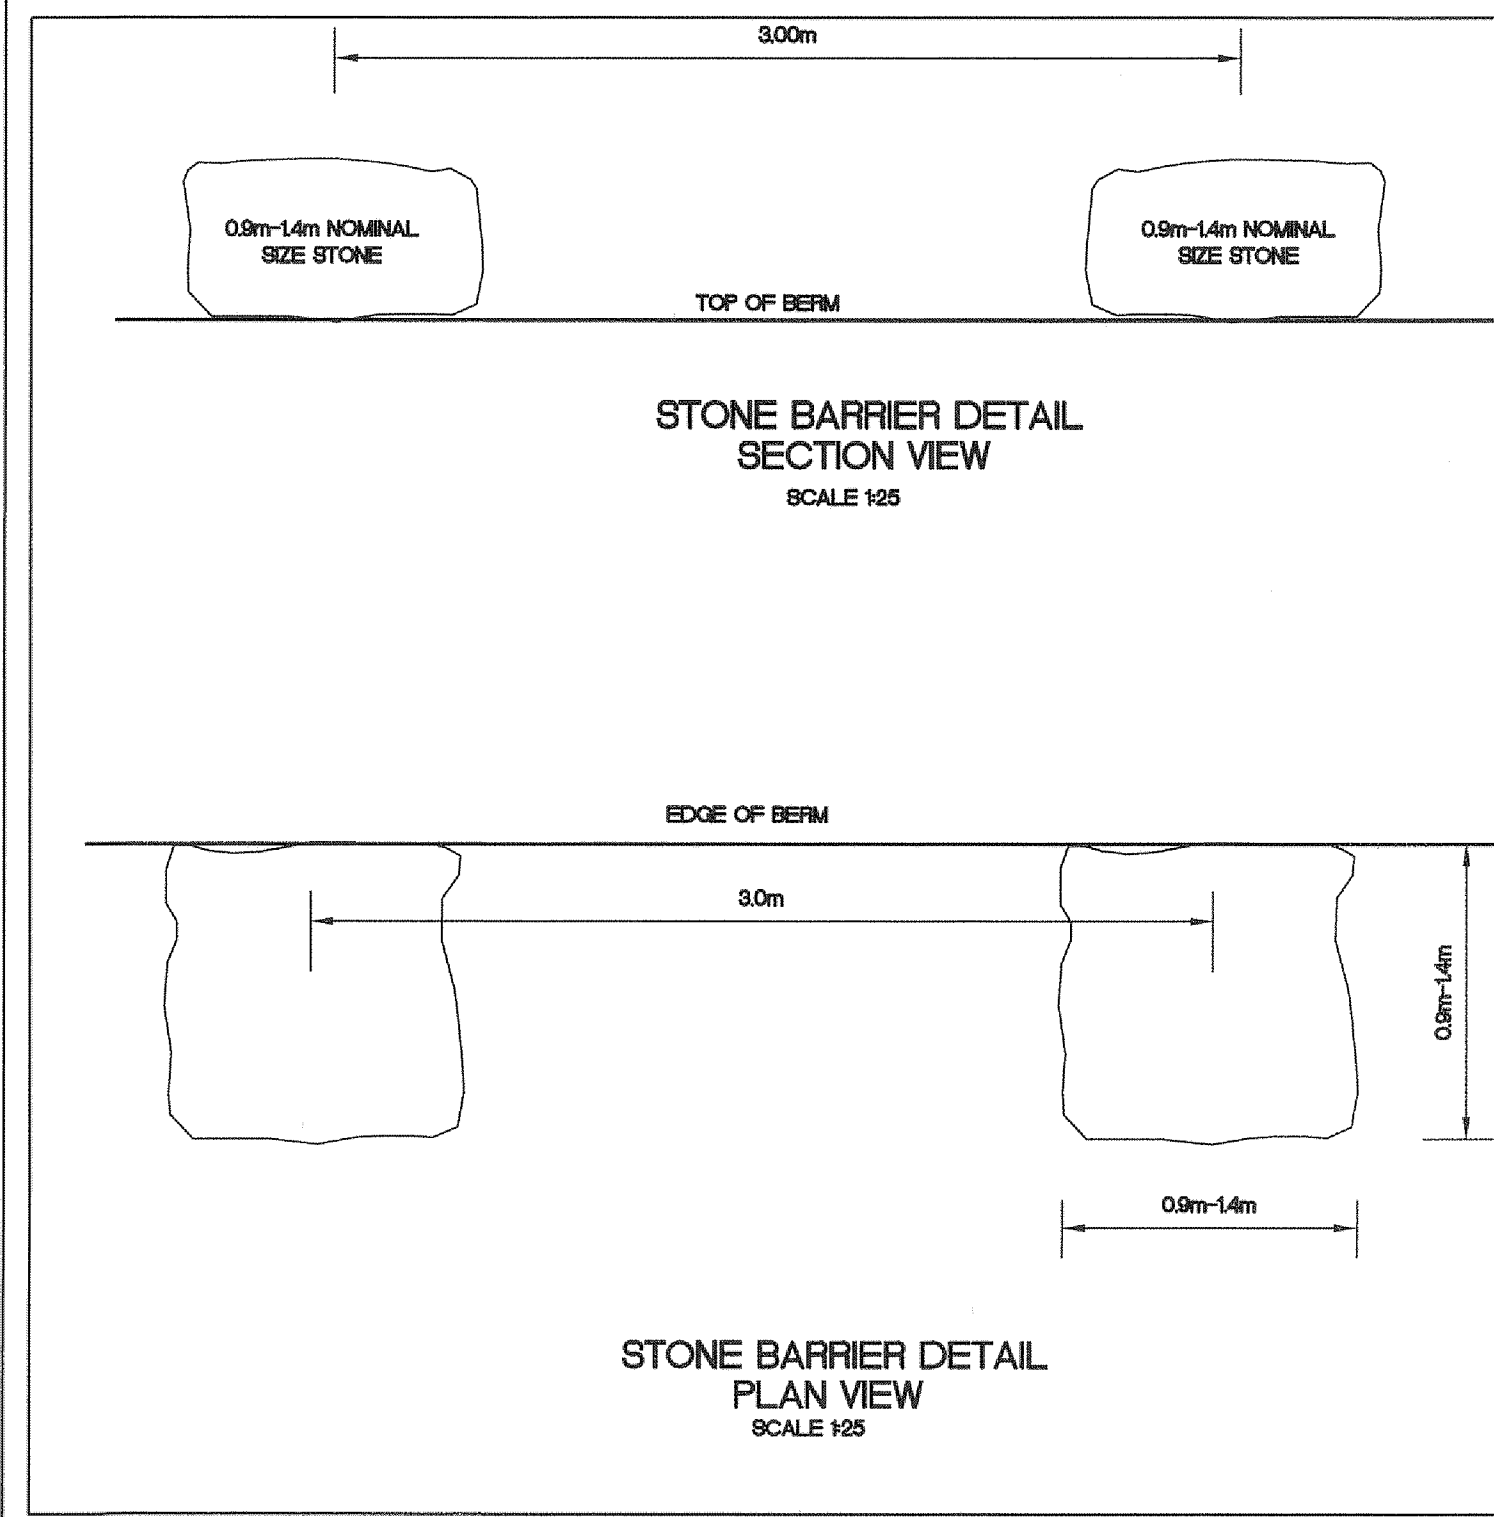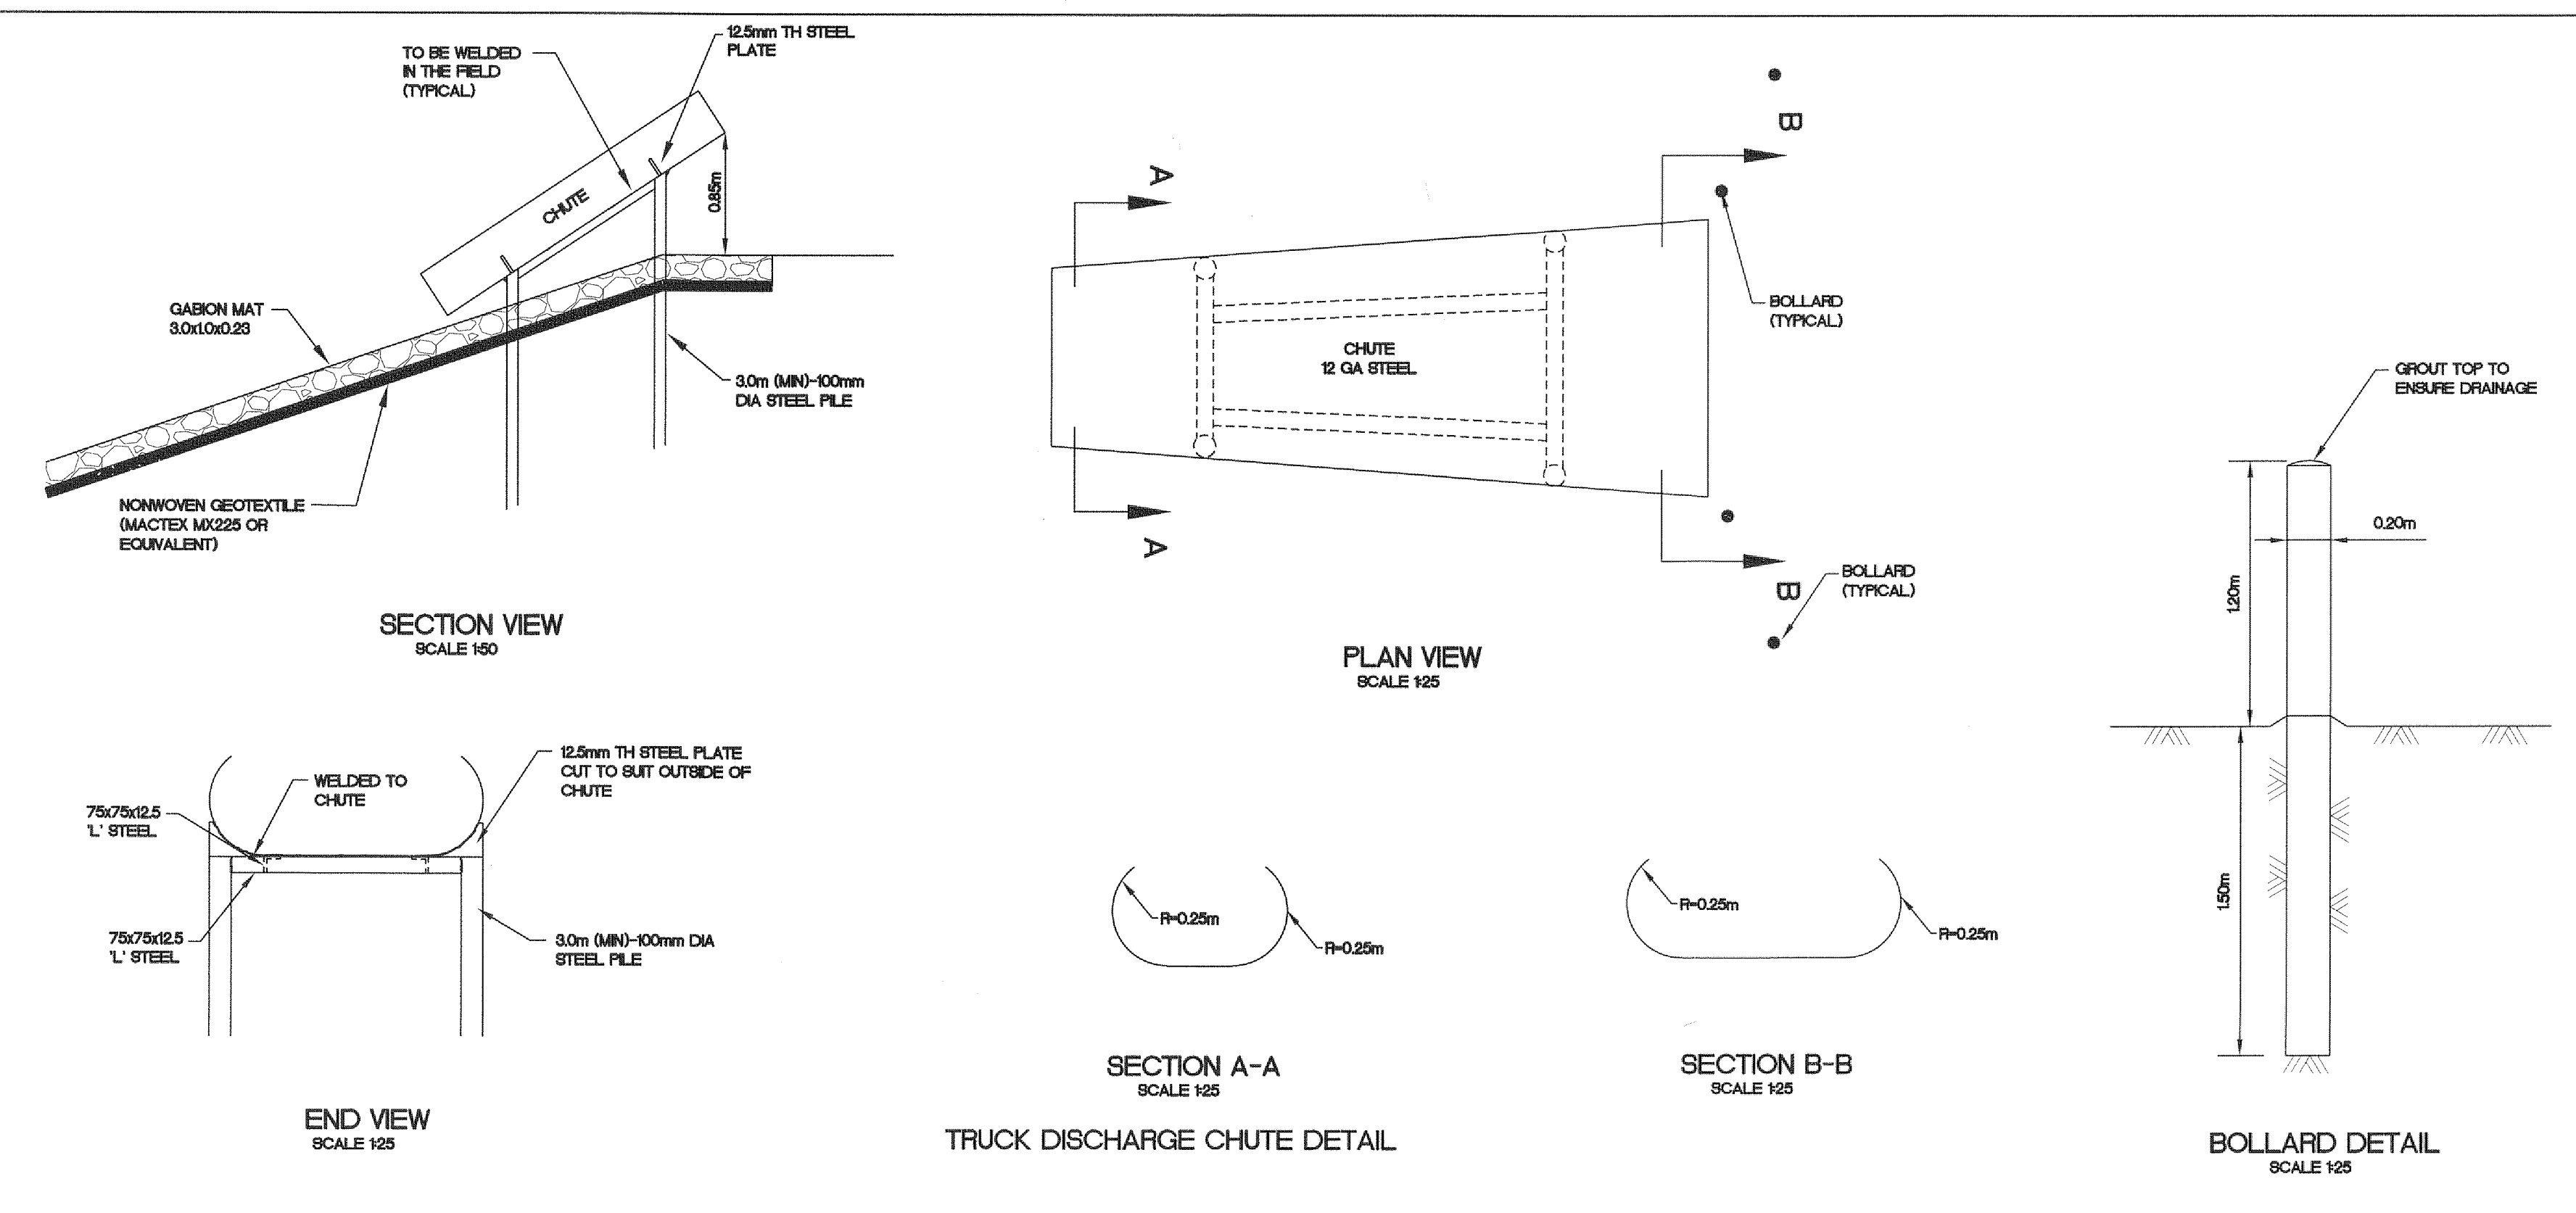

AS-CONSTRUCTED
2010

PERMIT OF PRACTICE
TROW ASSOCIATES INC.
Signature: *[Signature]*
Date: *June 19, 2011*
PERMIT NUMBER: P184
The Association of Professional Engineers
Geologists and Geophysicists of the NWT/NUN

BENCH MARK
BM 1 ELEV. = 65.16
RE-BAR SET NEAR THE INTERSECTION OF THE LAGOON ACCESS ROAD AND METAL DUMP ACCESS ROAD, NORTH-EAST OF THE LAGOON SITE.











No.	DESCRIPTION	DATE	BY	APP'D
5	AS-CONSTRUCTED	02/12/10	MEB	SLB
4	REV DEWATERING INLET	10/08/09	MMR	SLB
3	ISSUED FOR CONSTRUCTION	15/06/09	MMR	SLB
2	REVISED FOR TENDER	28/05/08	MMR	SLB
1	ISSUED FOR TENDER	28/04/08	MMR	SLB



Trow Associates Inc.
100-2650 Queensview Drive PHONE: (613) 688-1899
Ottawa, Ont. K2B 8H6 FAX: (613) 225-7337

CLIENT
GOVERNMENT OF NUNAVUT

PROJECT		CLYDE RIVER WASTEWATER LAGOON	
TITLE		TRUCK DISCHARGE SITE PLANS	
design by	SAD	project no.	OTCD000190554
drawn by	MEB	drawing no.	TD1
checked by	S.L.B.		
date	30/08/2007		
scale	1:250		

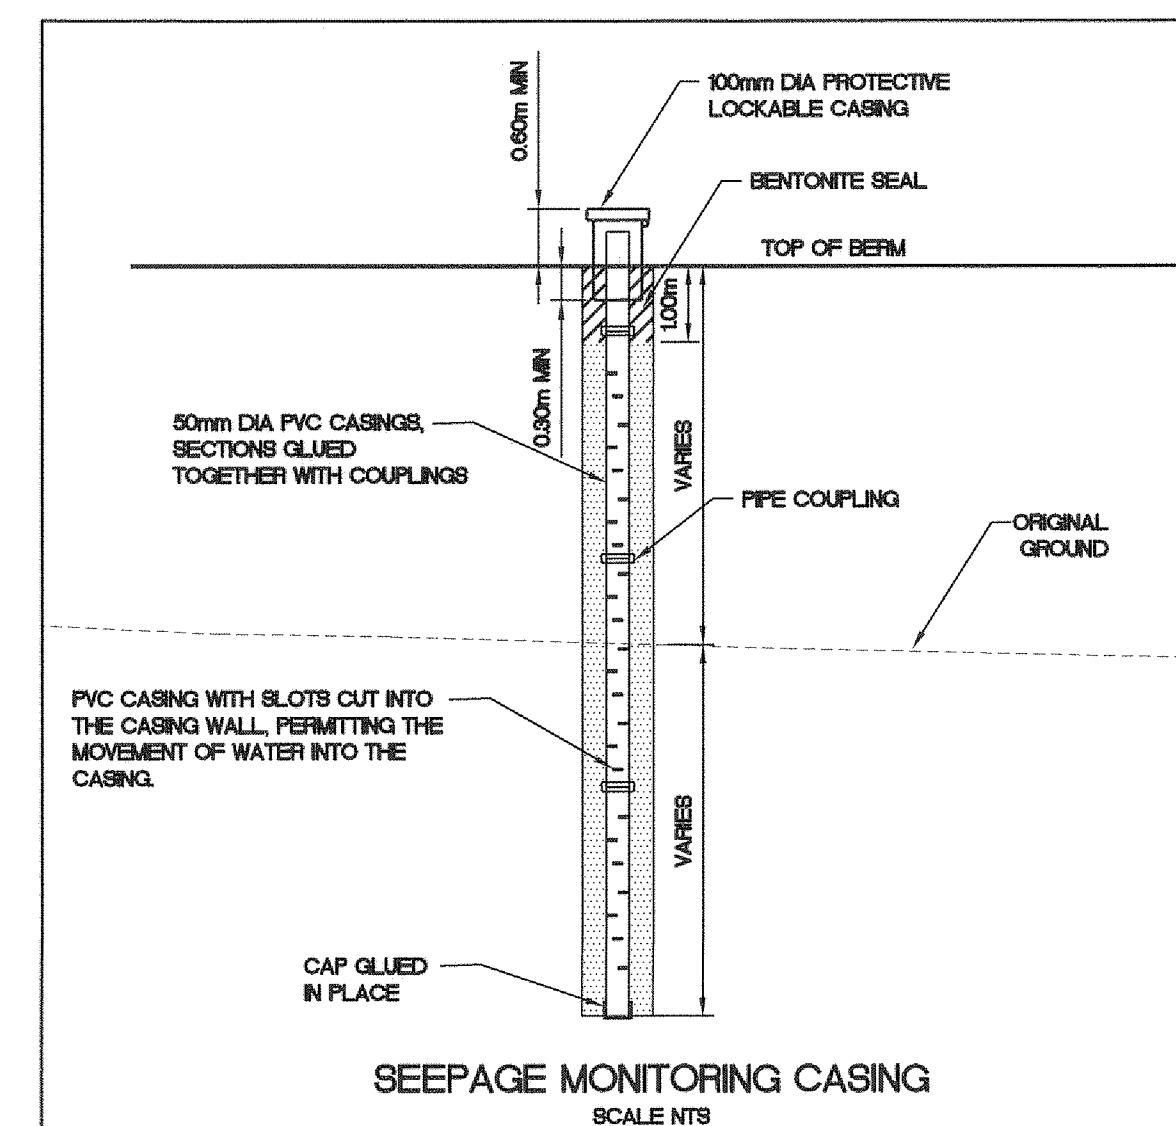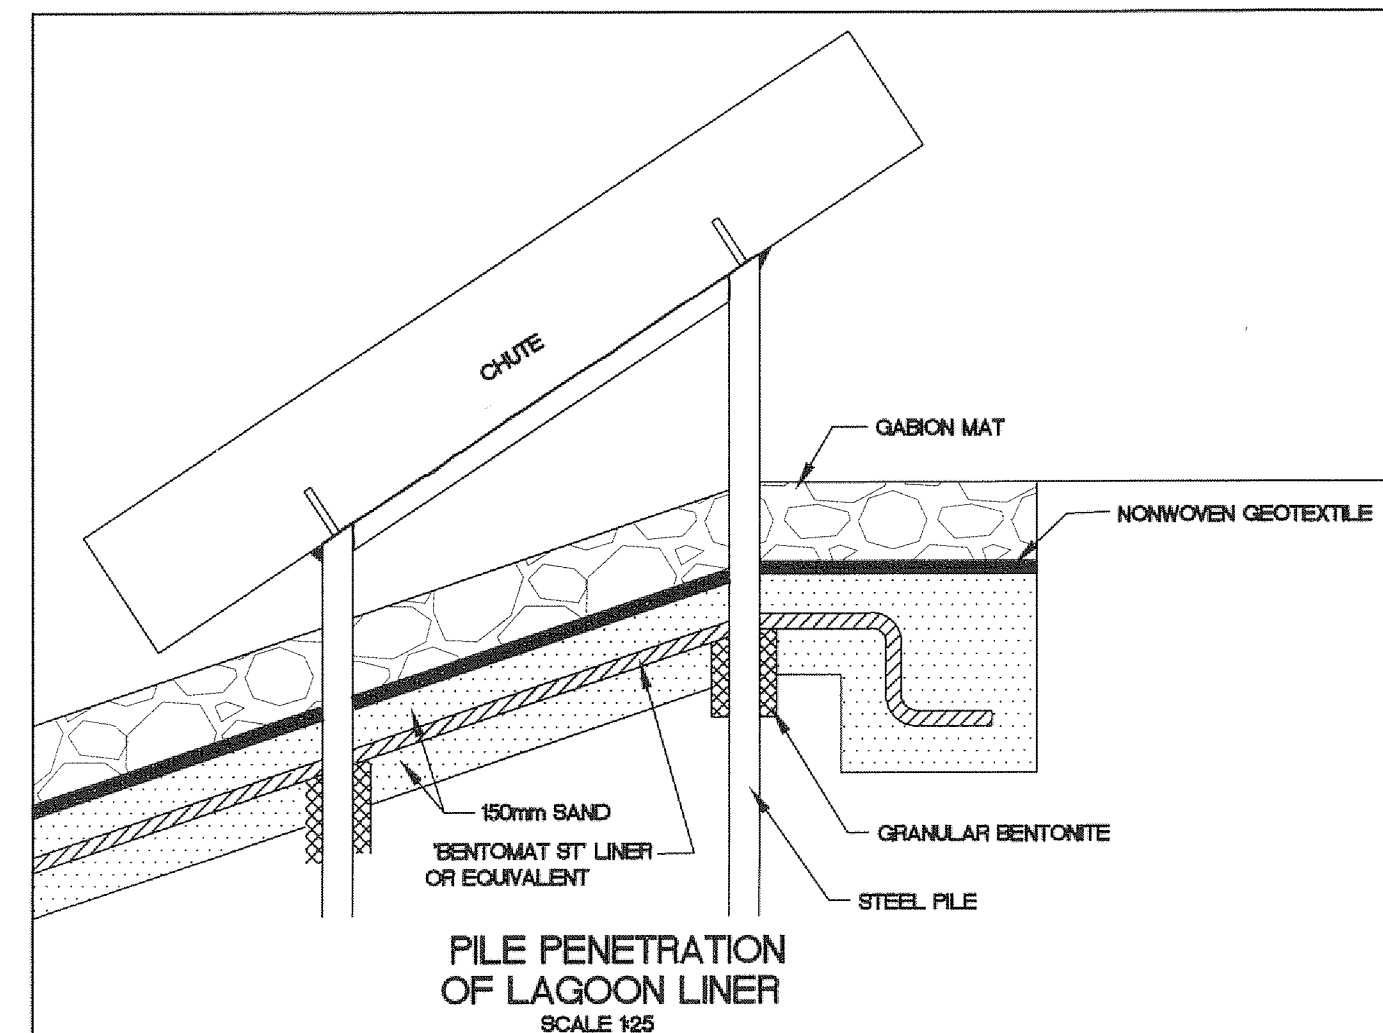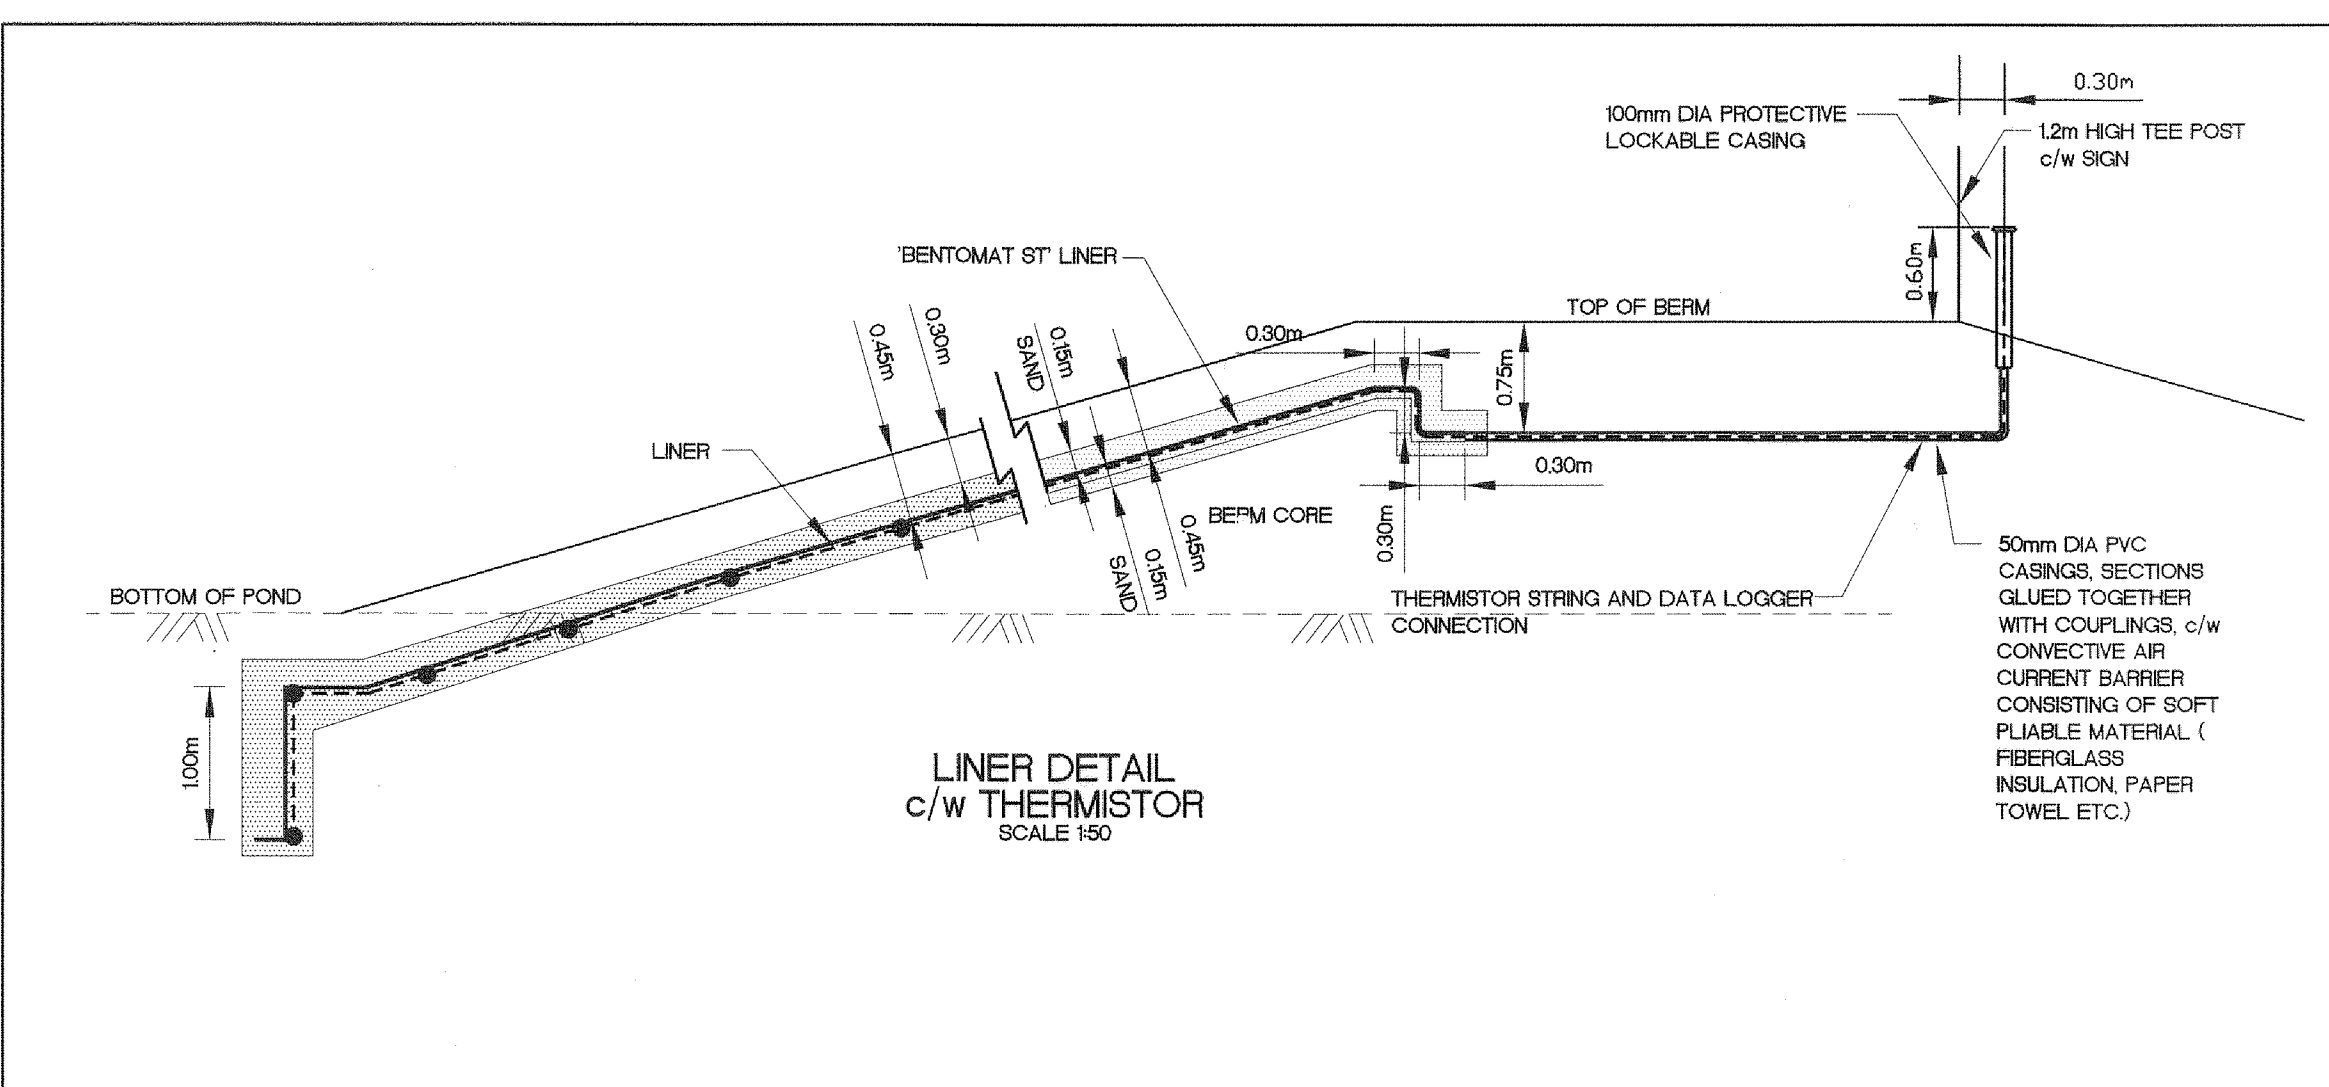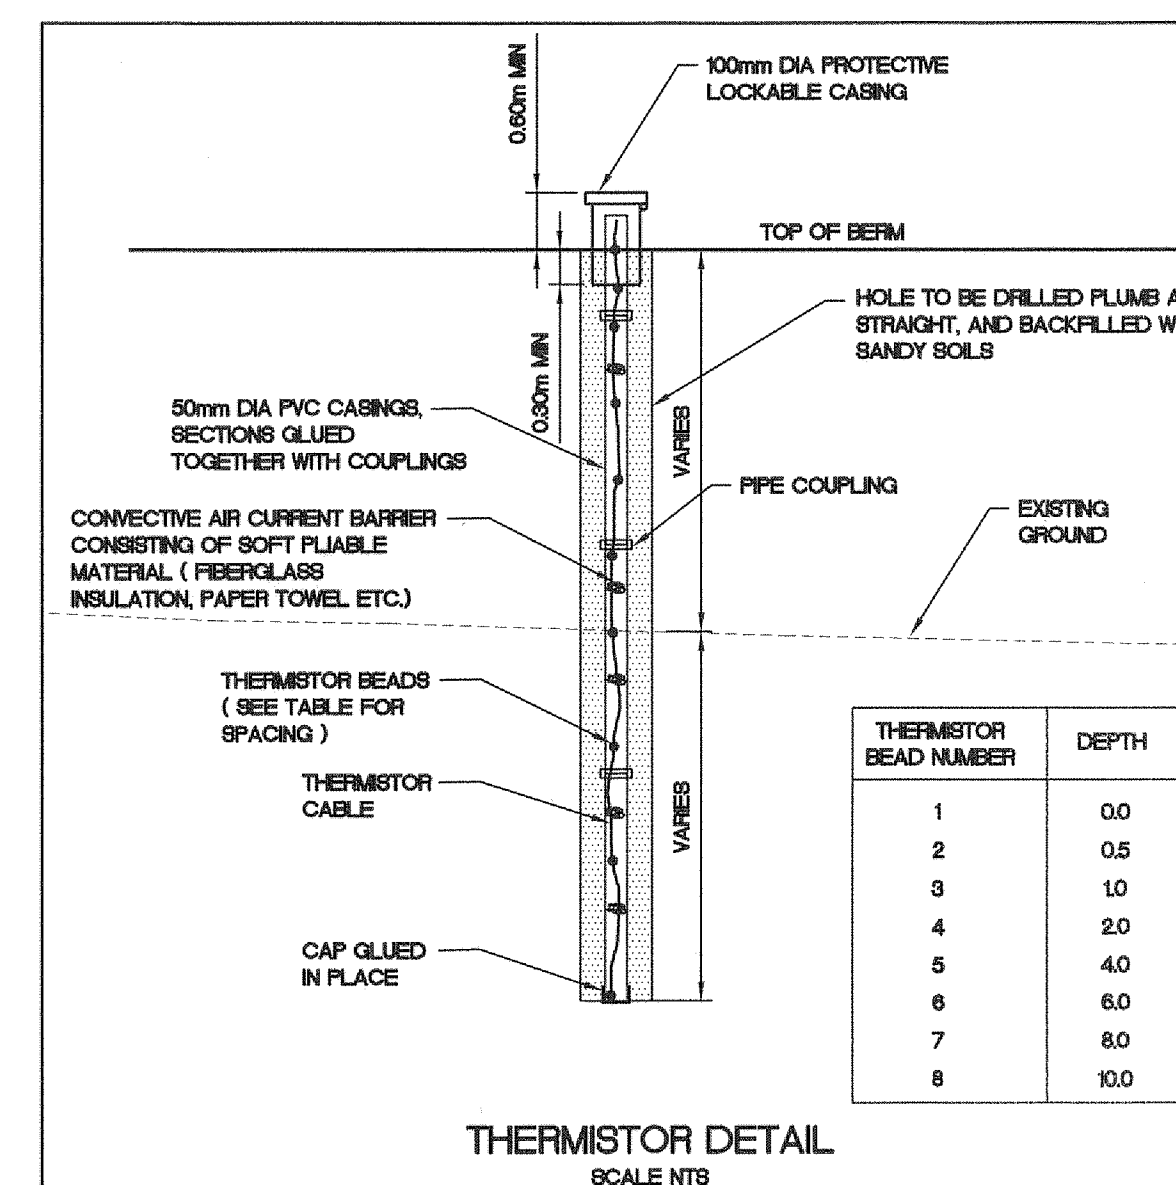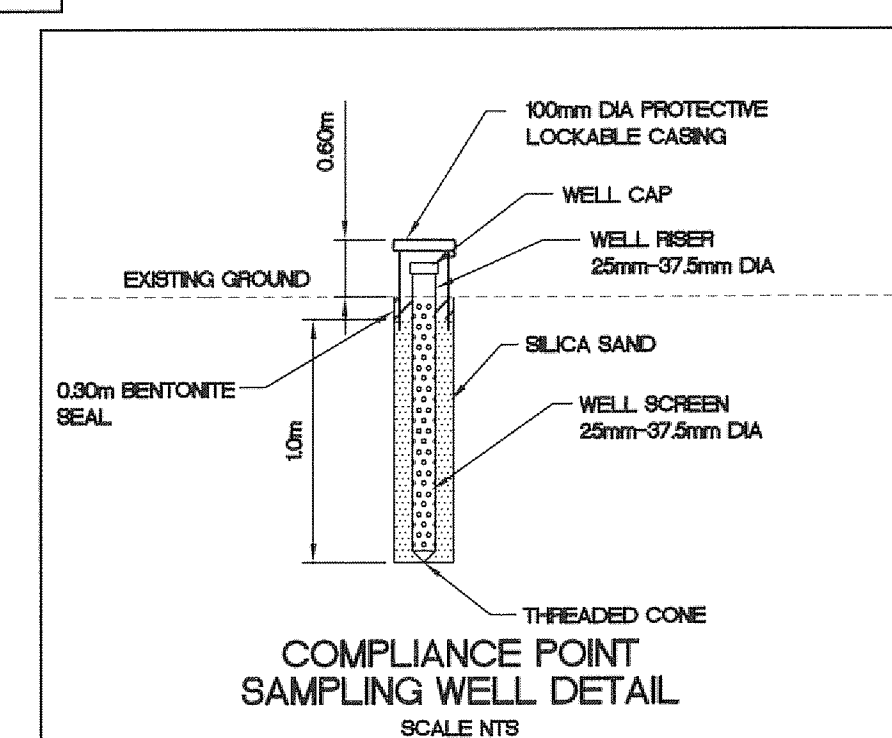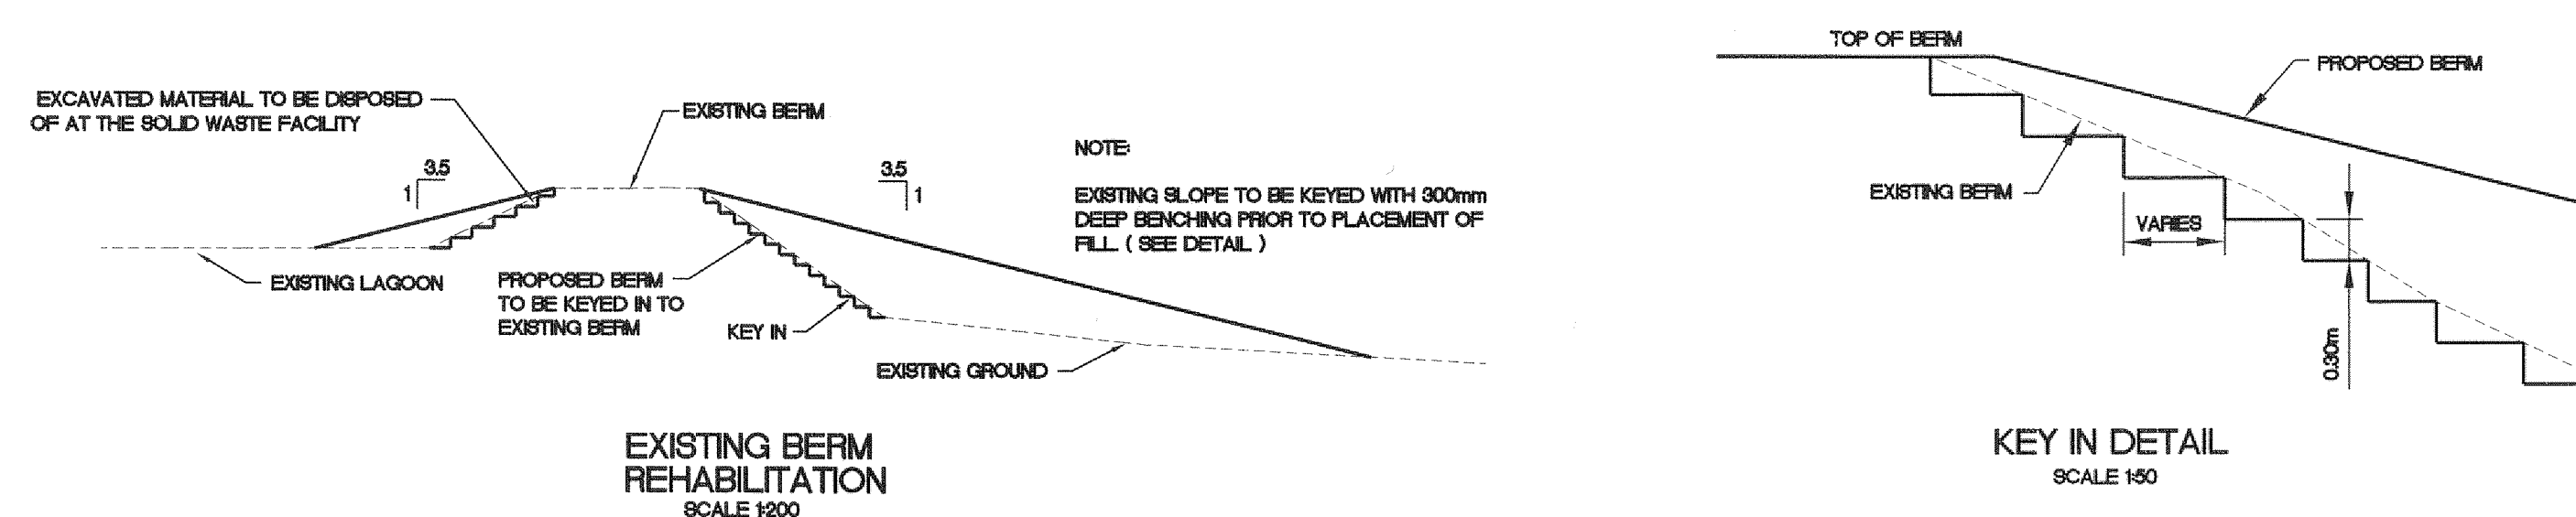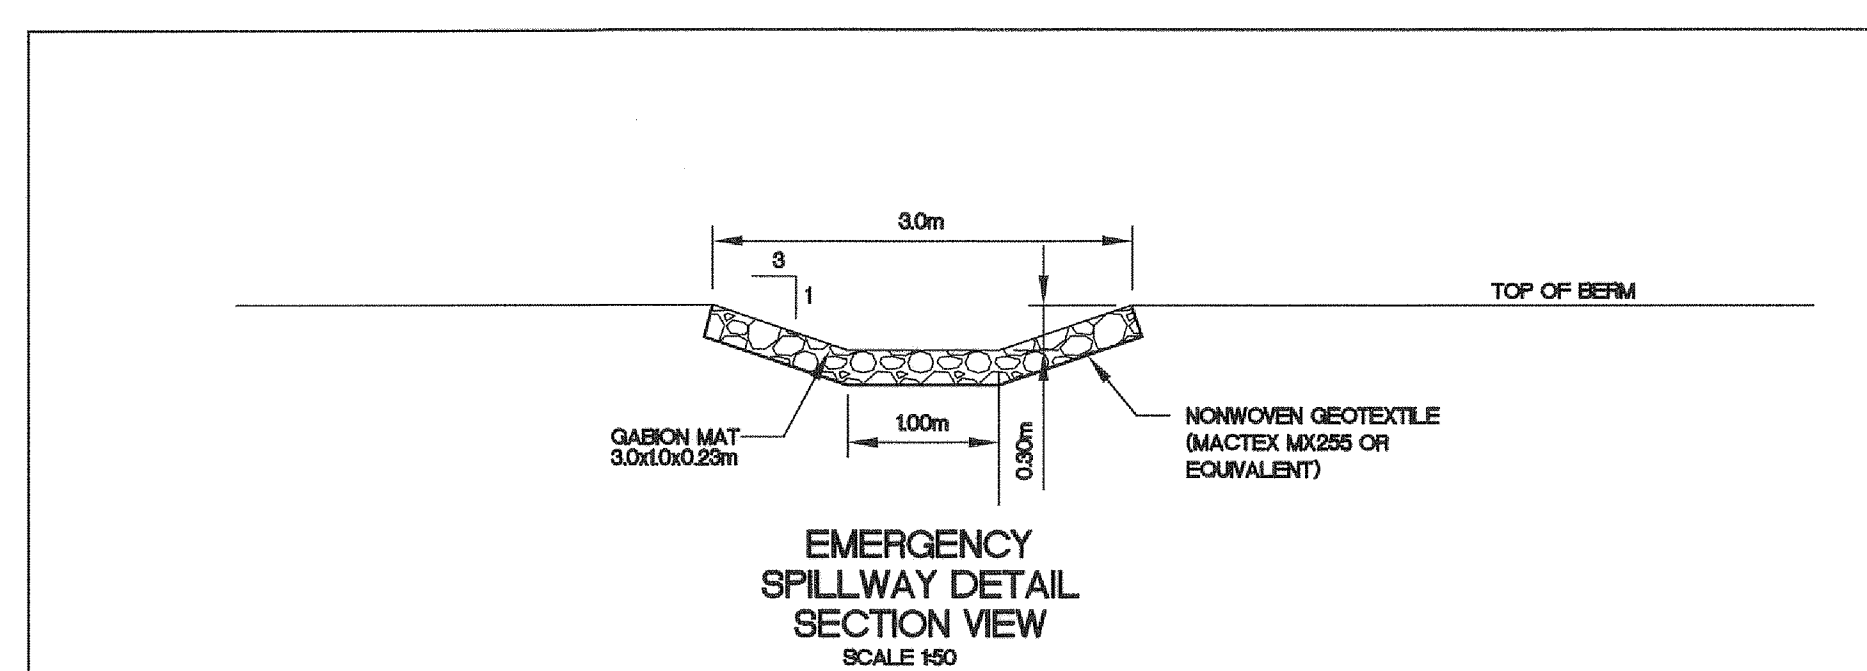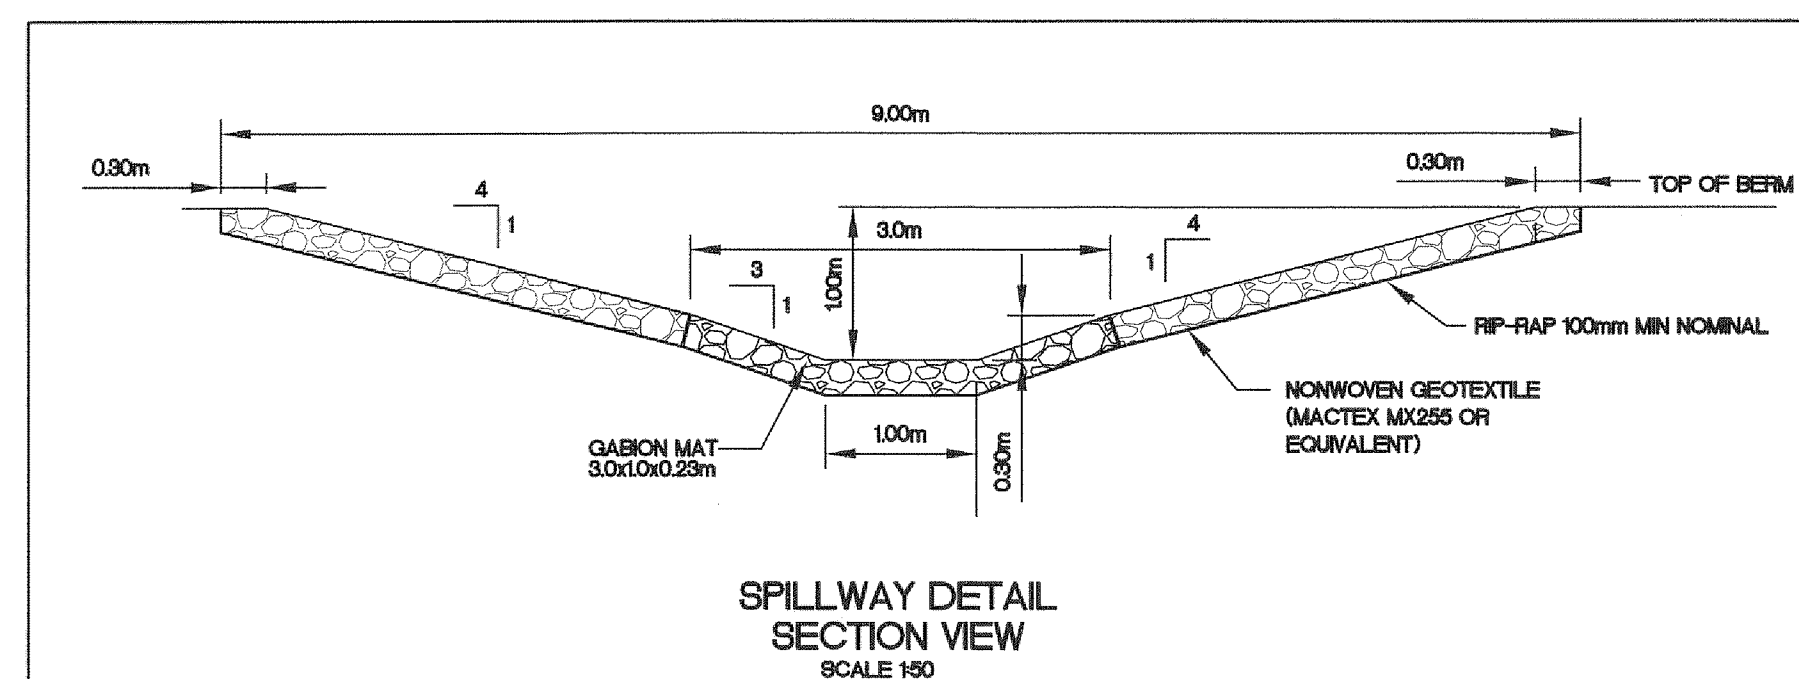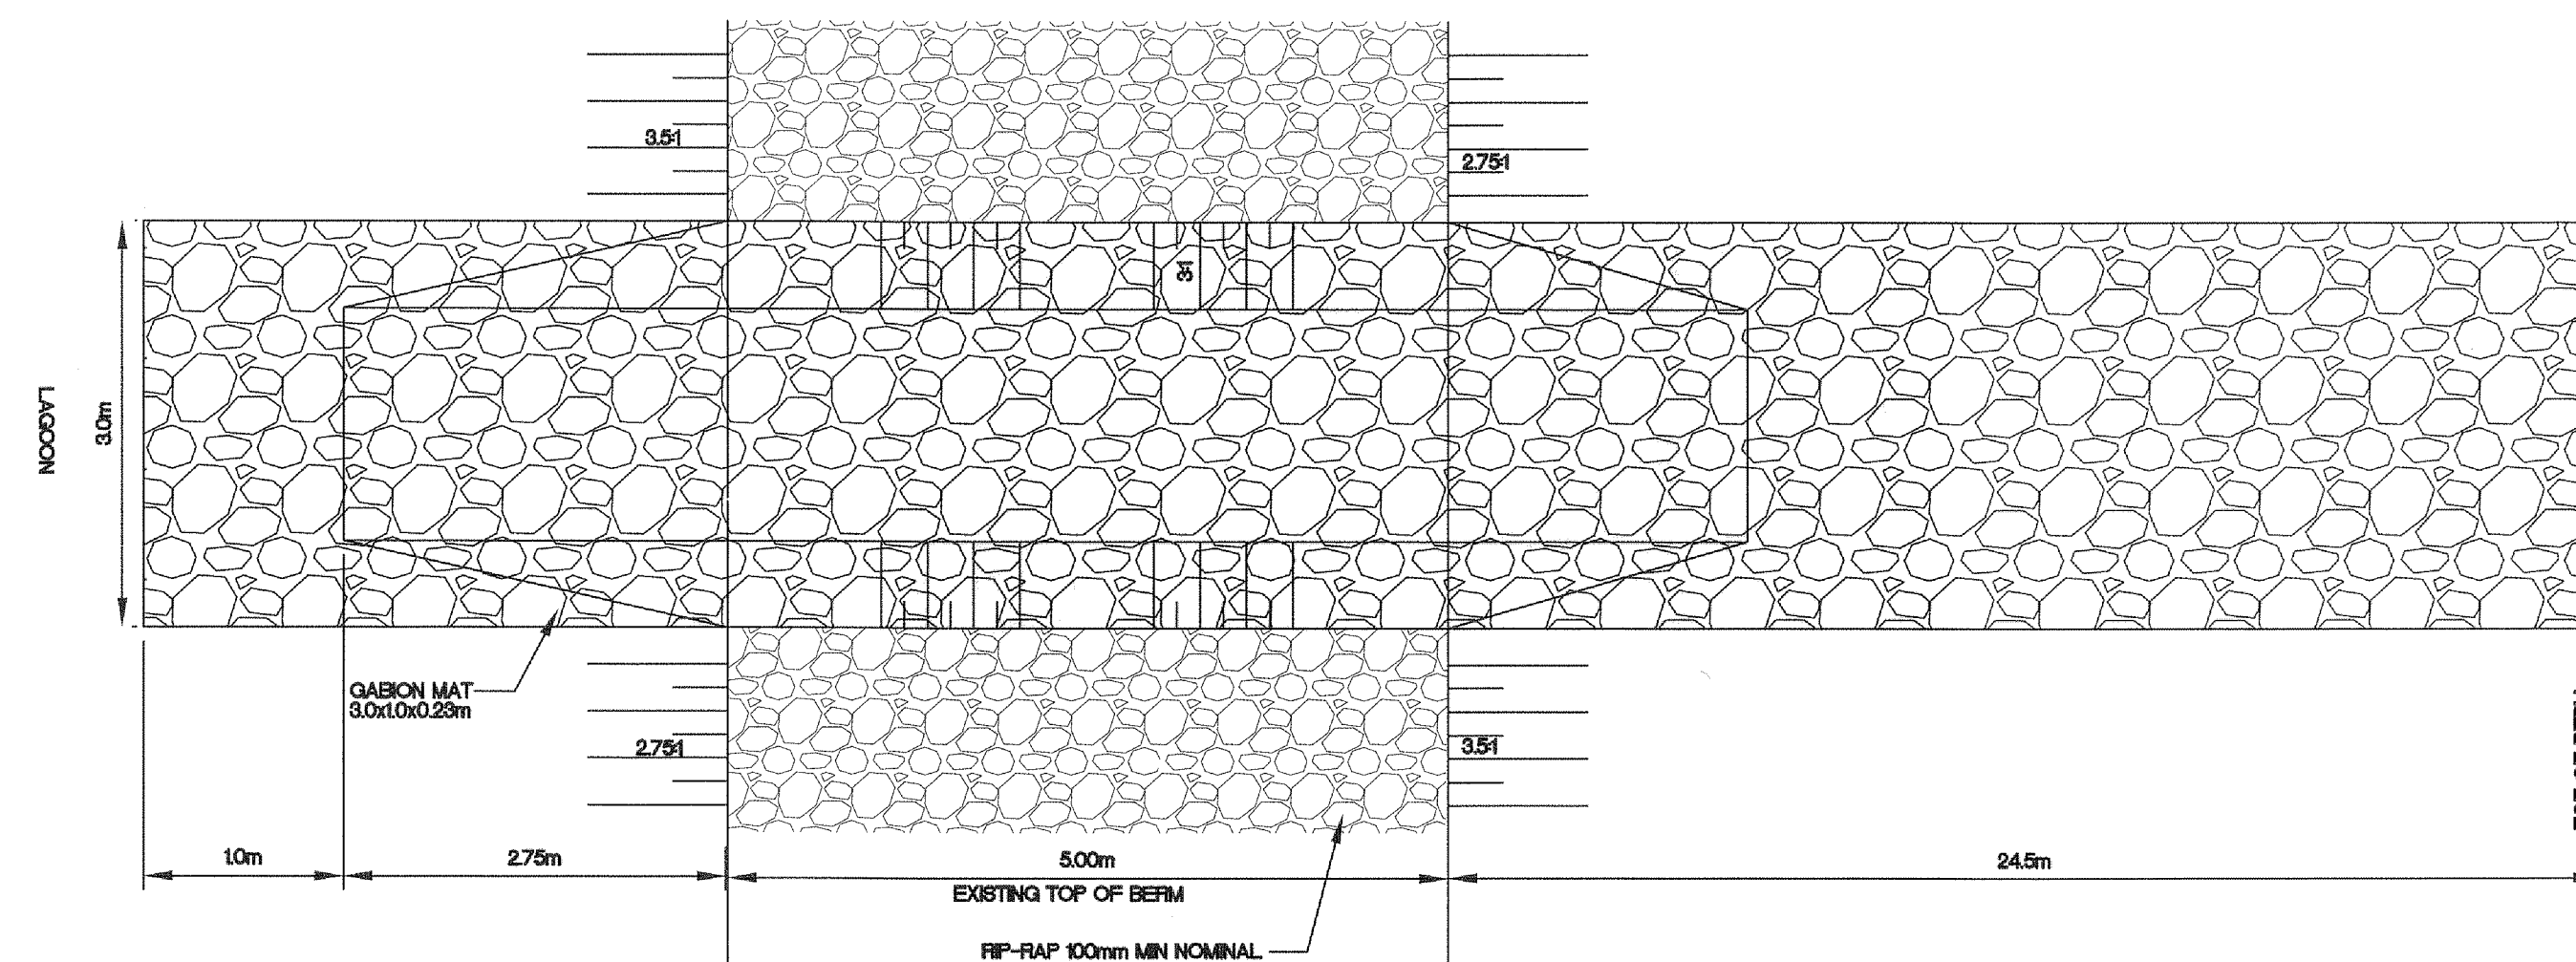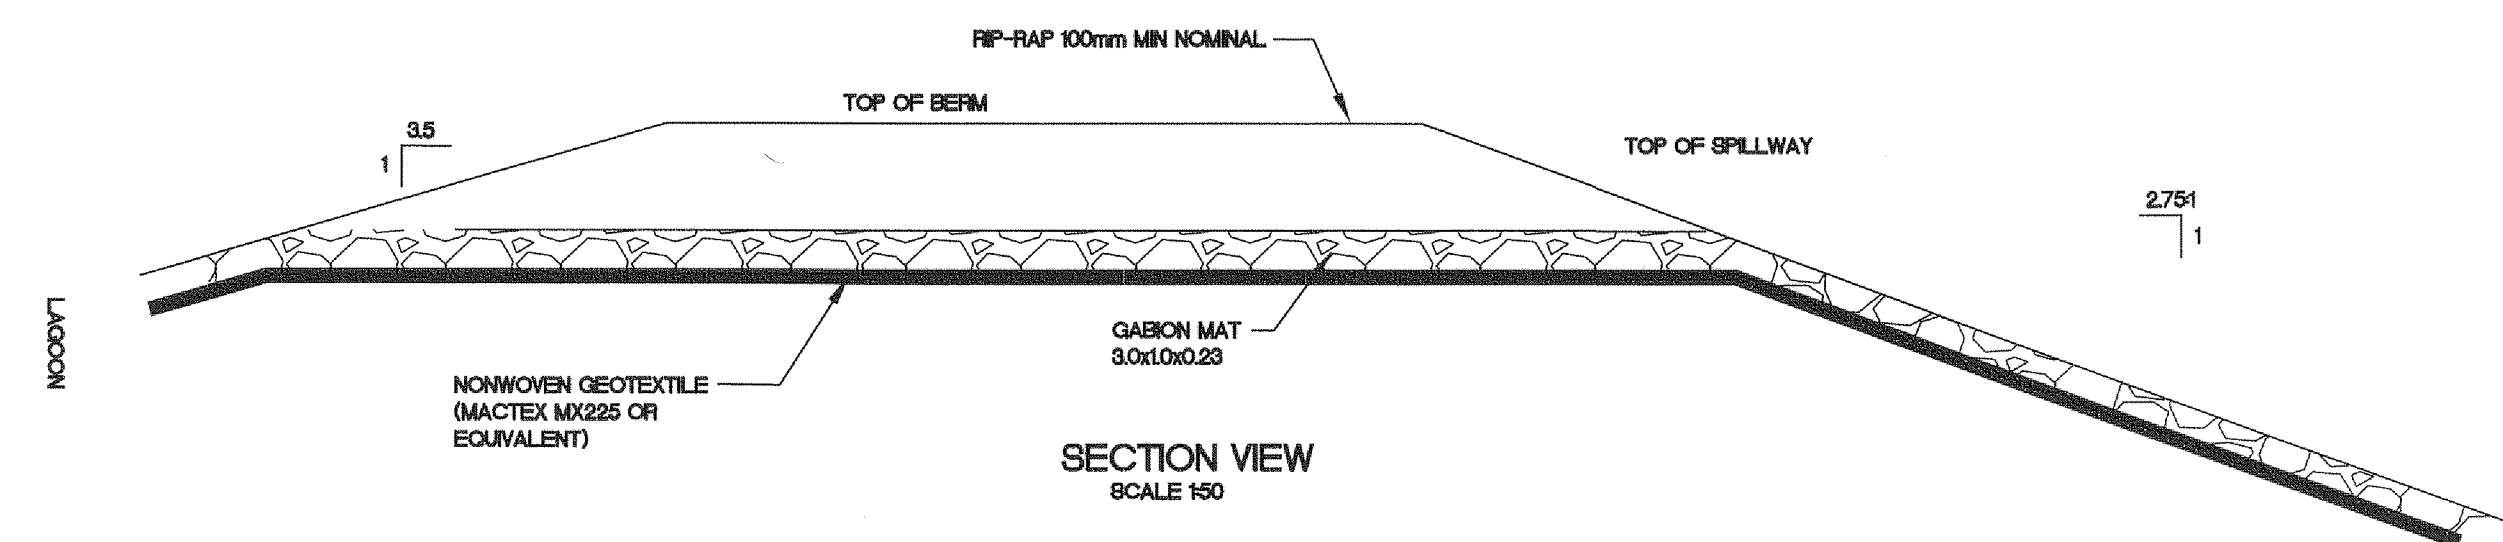

AS-CONSTRUCTED
2010

PERMIT OF PRACTICE
TROW ASSOCIATES INC.


Signature *Steve Bender*

Date *Jan 17, 2011*

PERMIT NUMBER: P184

The Association of Professional Engineers
Geologists and Geophysicists of the NWT/NU

4	AS--CONSTRUCTED	02/12/10	MEB	SLB
3	ISSUED FOR CONSTRUCTION	15/06/09	MMR	SLB
2	REVISED FOR TENDER	28/05/08	MMR	SLB
1	ISSUED FOR TENDER	28/04/08	MMR	SLB
No.	DESCRIPTION	DATE	BY	APP'D

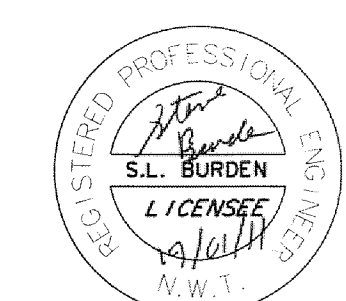

 **Trow** Associates Inc.

100-2650 Queensview Drive PHONE: (613) 688-1899
Ottawa, Ont. K2B 8H6 FAX: (613) 225-7337









CLIENT

GOVERNMENT OF NUNAVUT

PROJECT CLYDE RIVER
WASTE WATER
LAGOON

TITLE	DETAILS
-------	---------


design by	S.A.D.	project no. OTCD19055A drawing no. DE-1
drawn by	M.M.R.	
checked by	S.L.B.	
date	14/12/07	
scale	AS SHOWN	

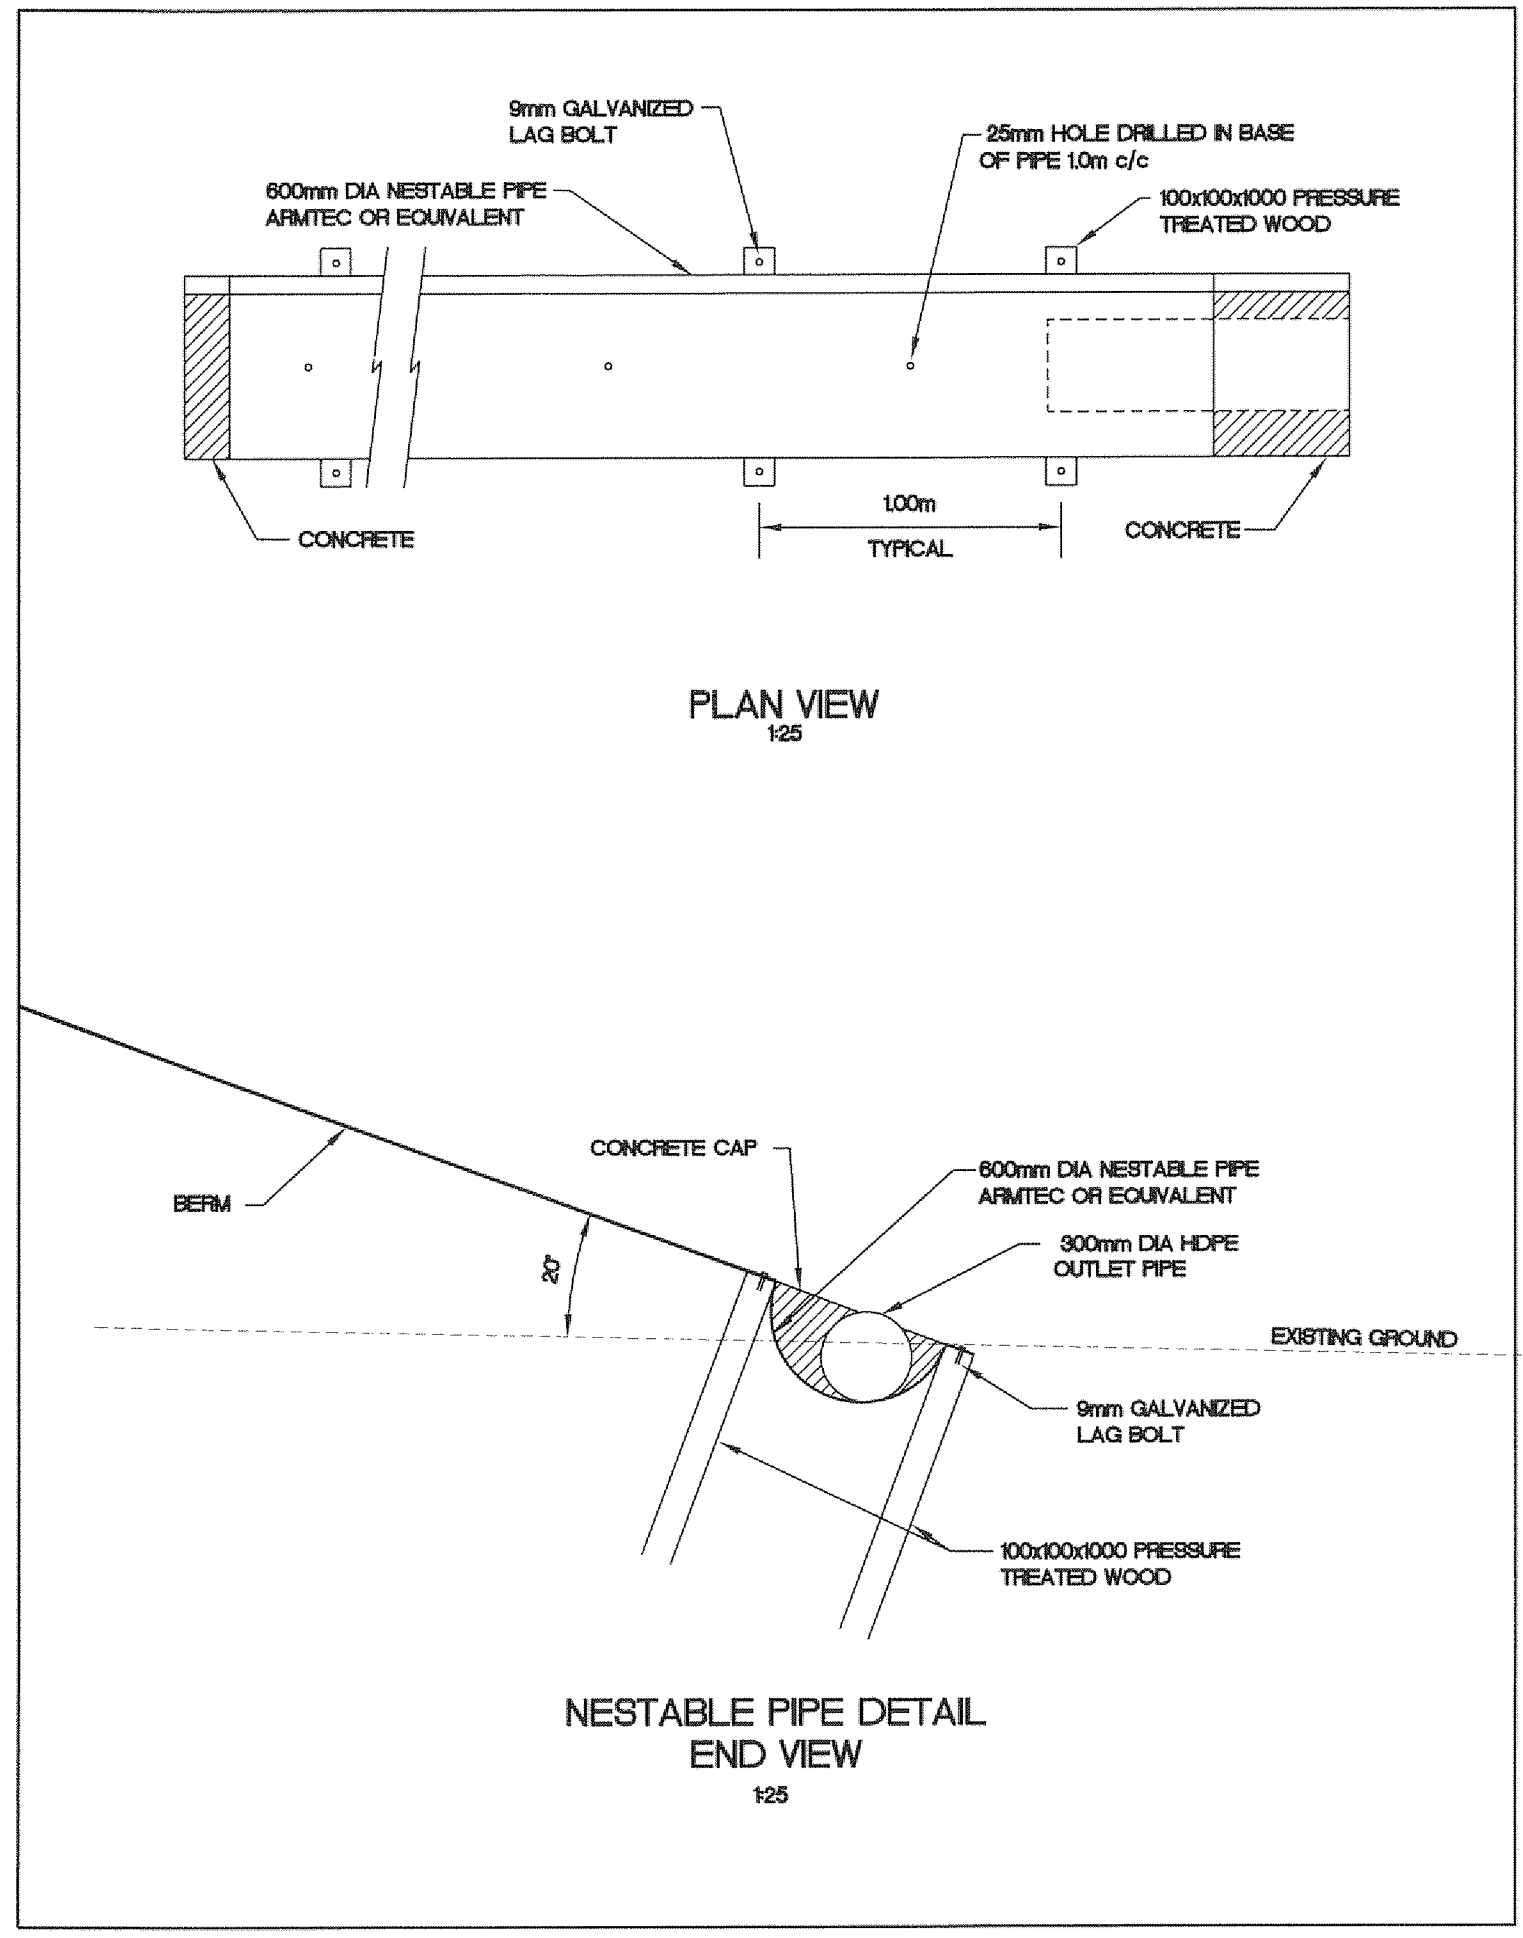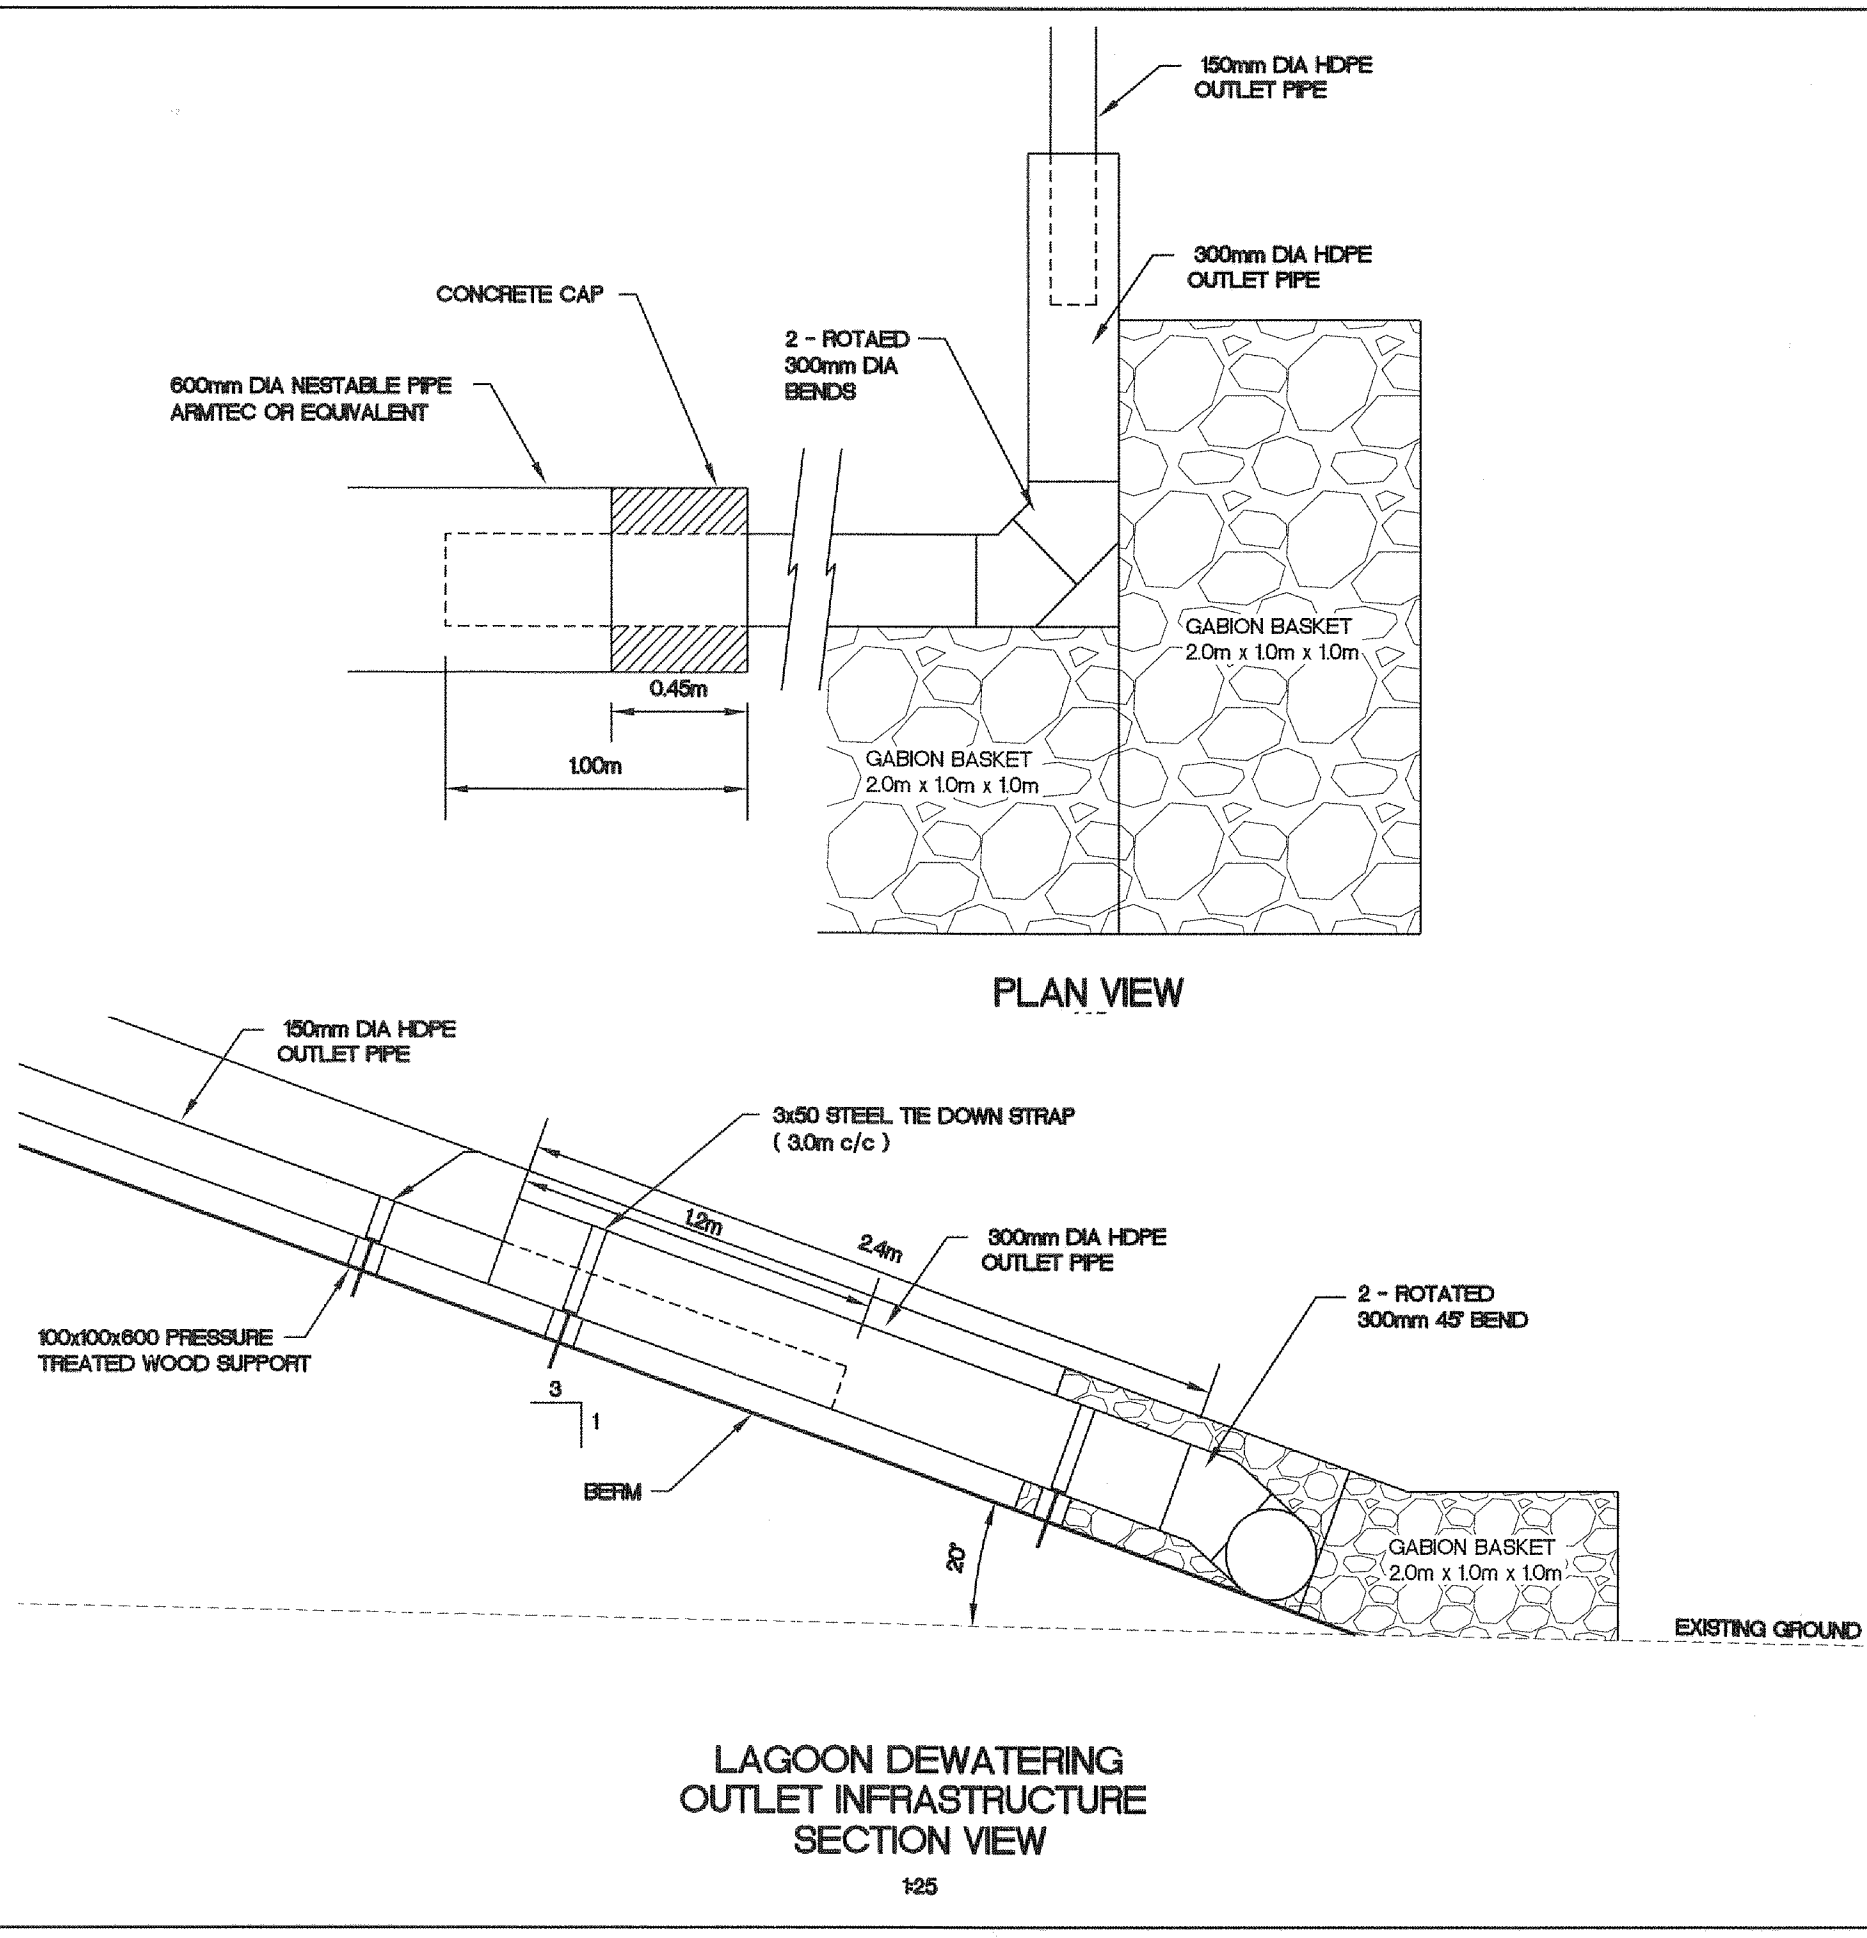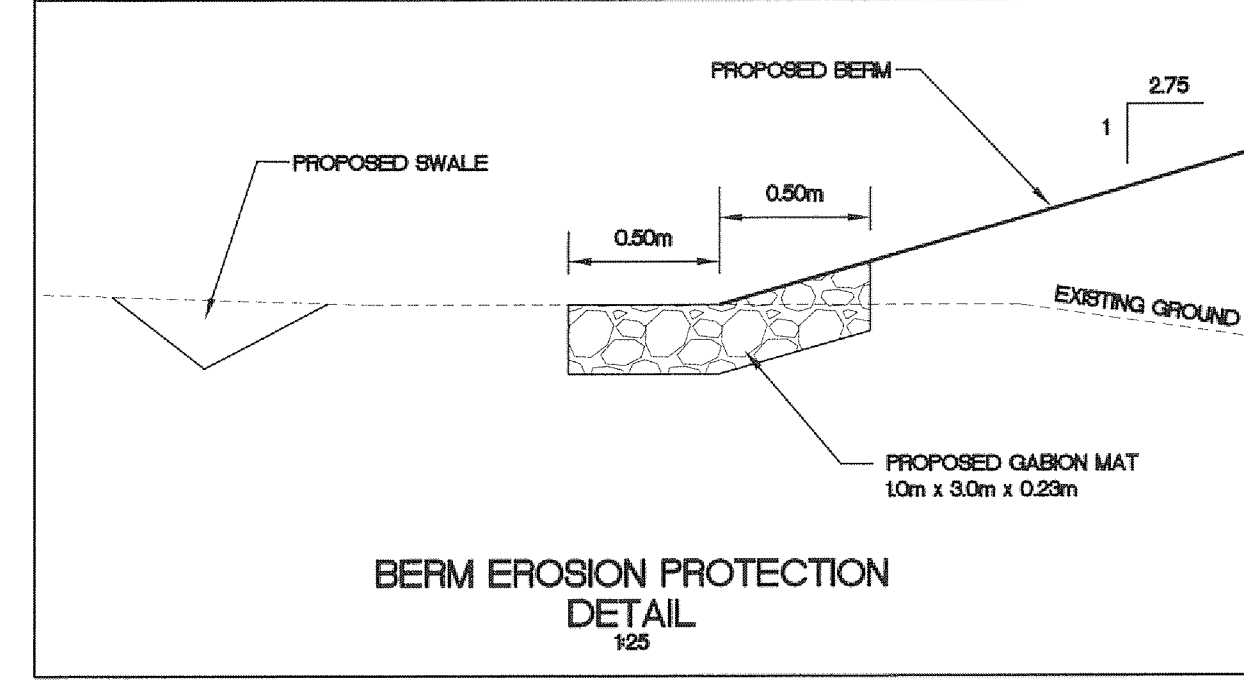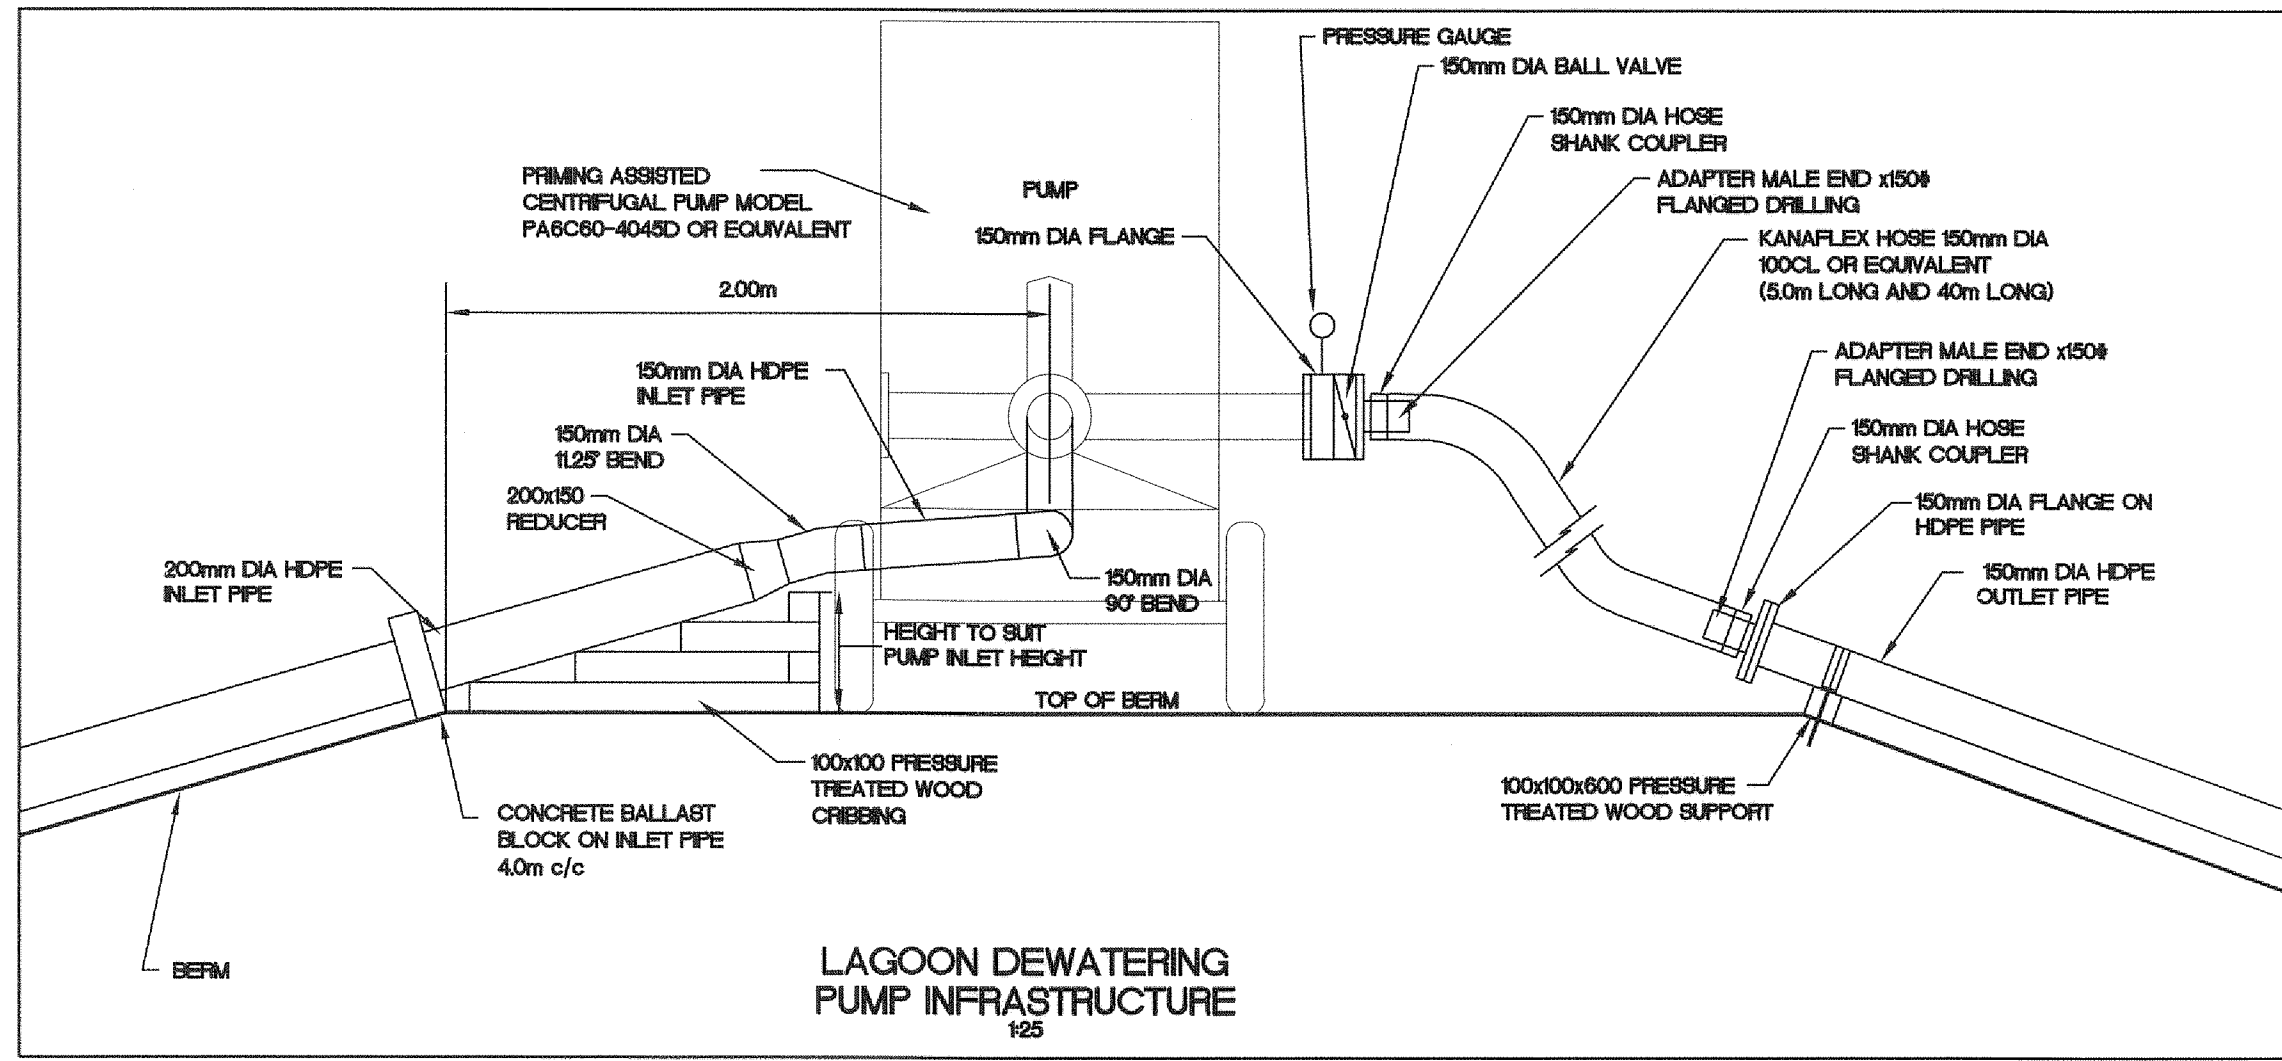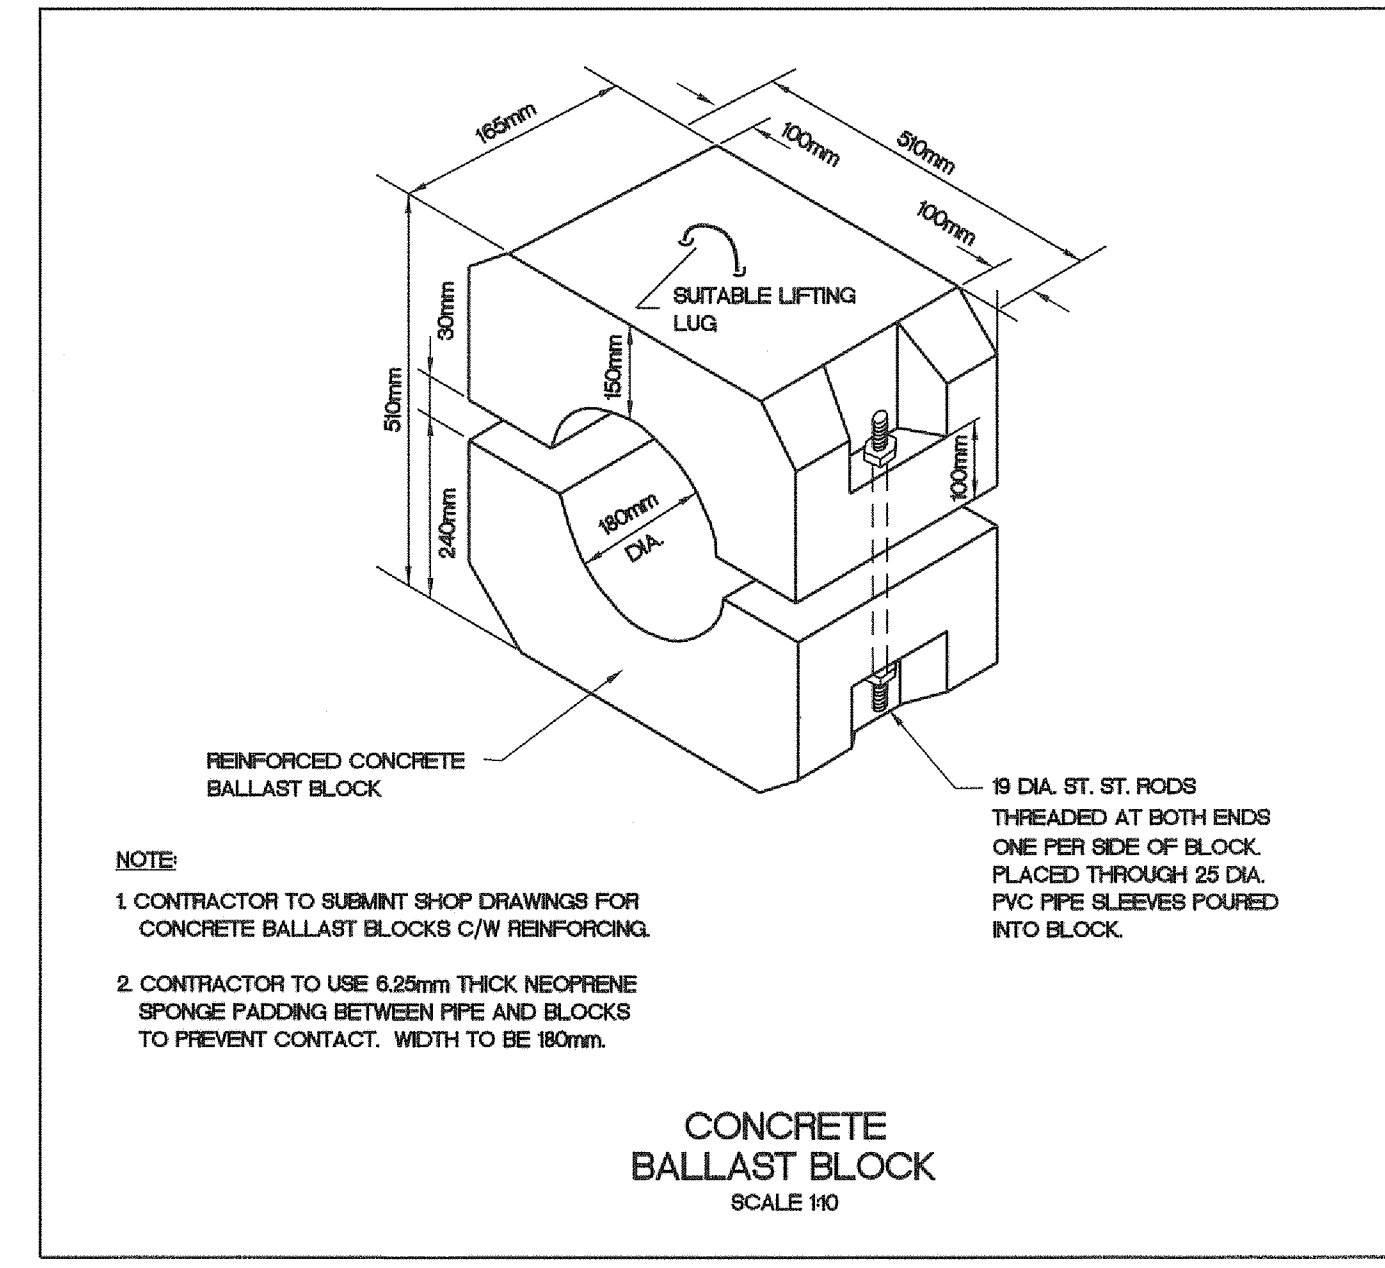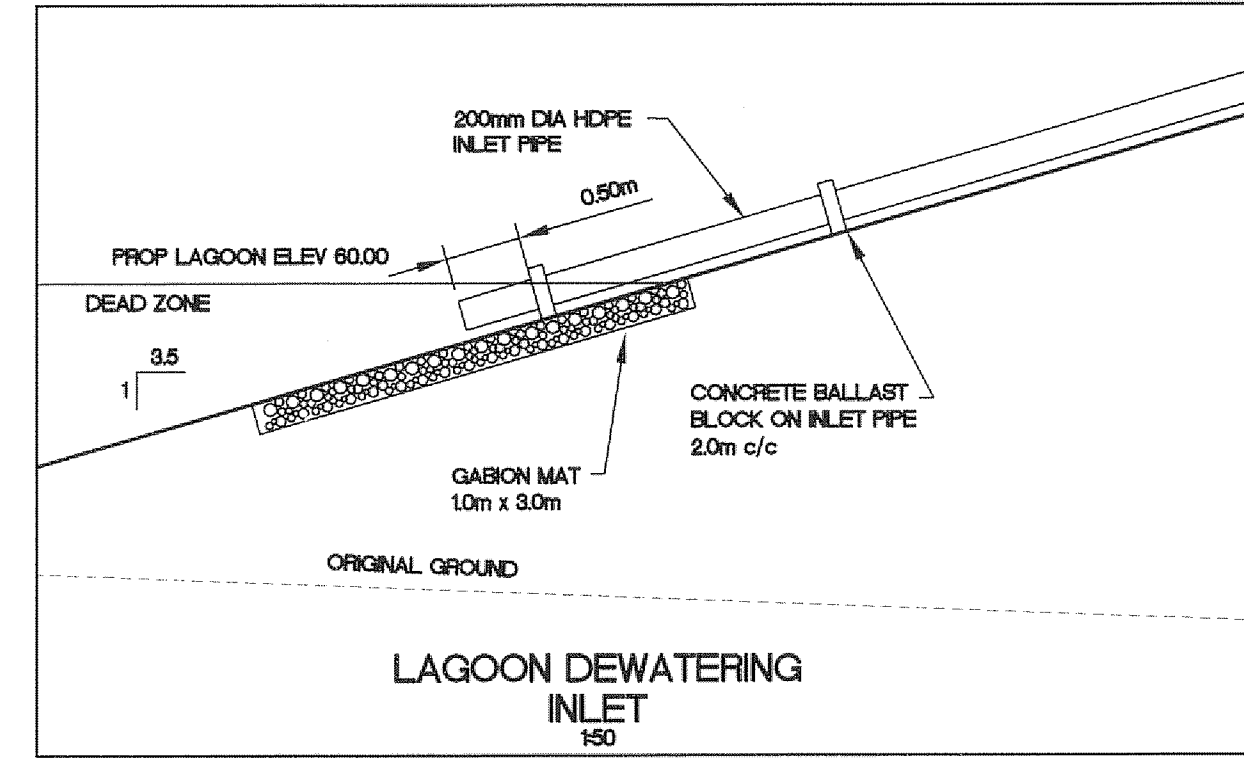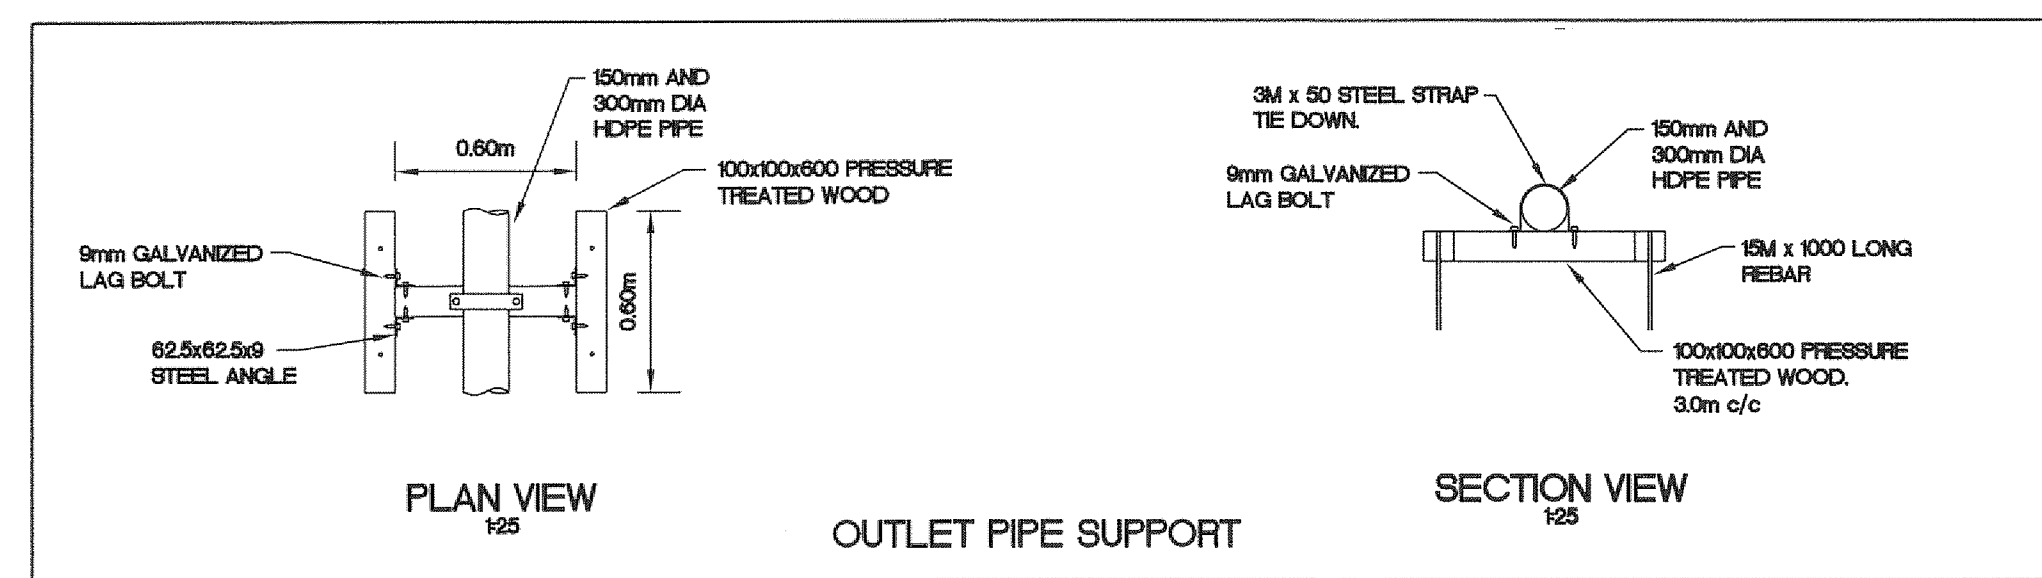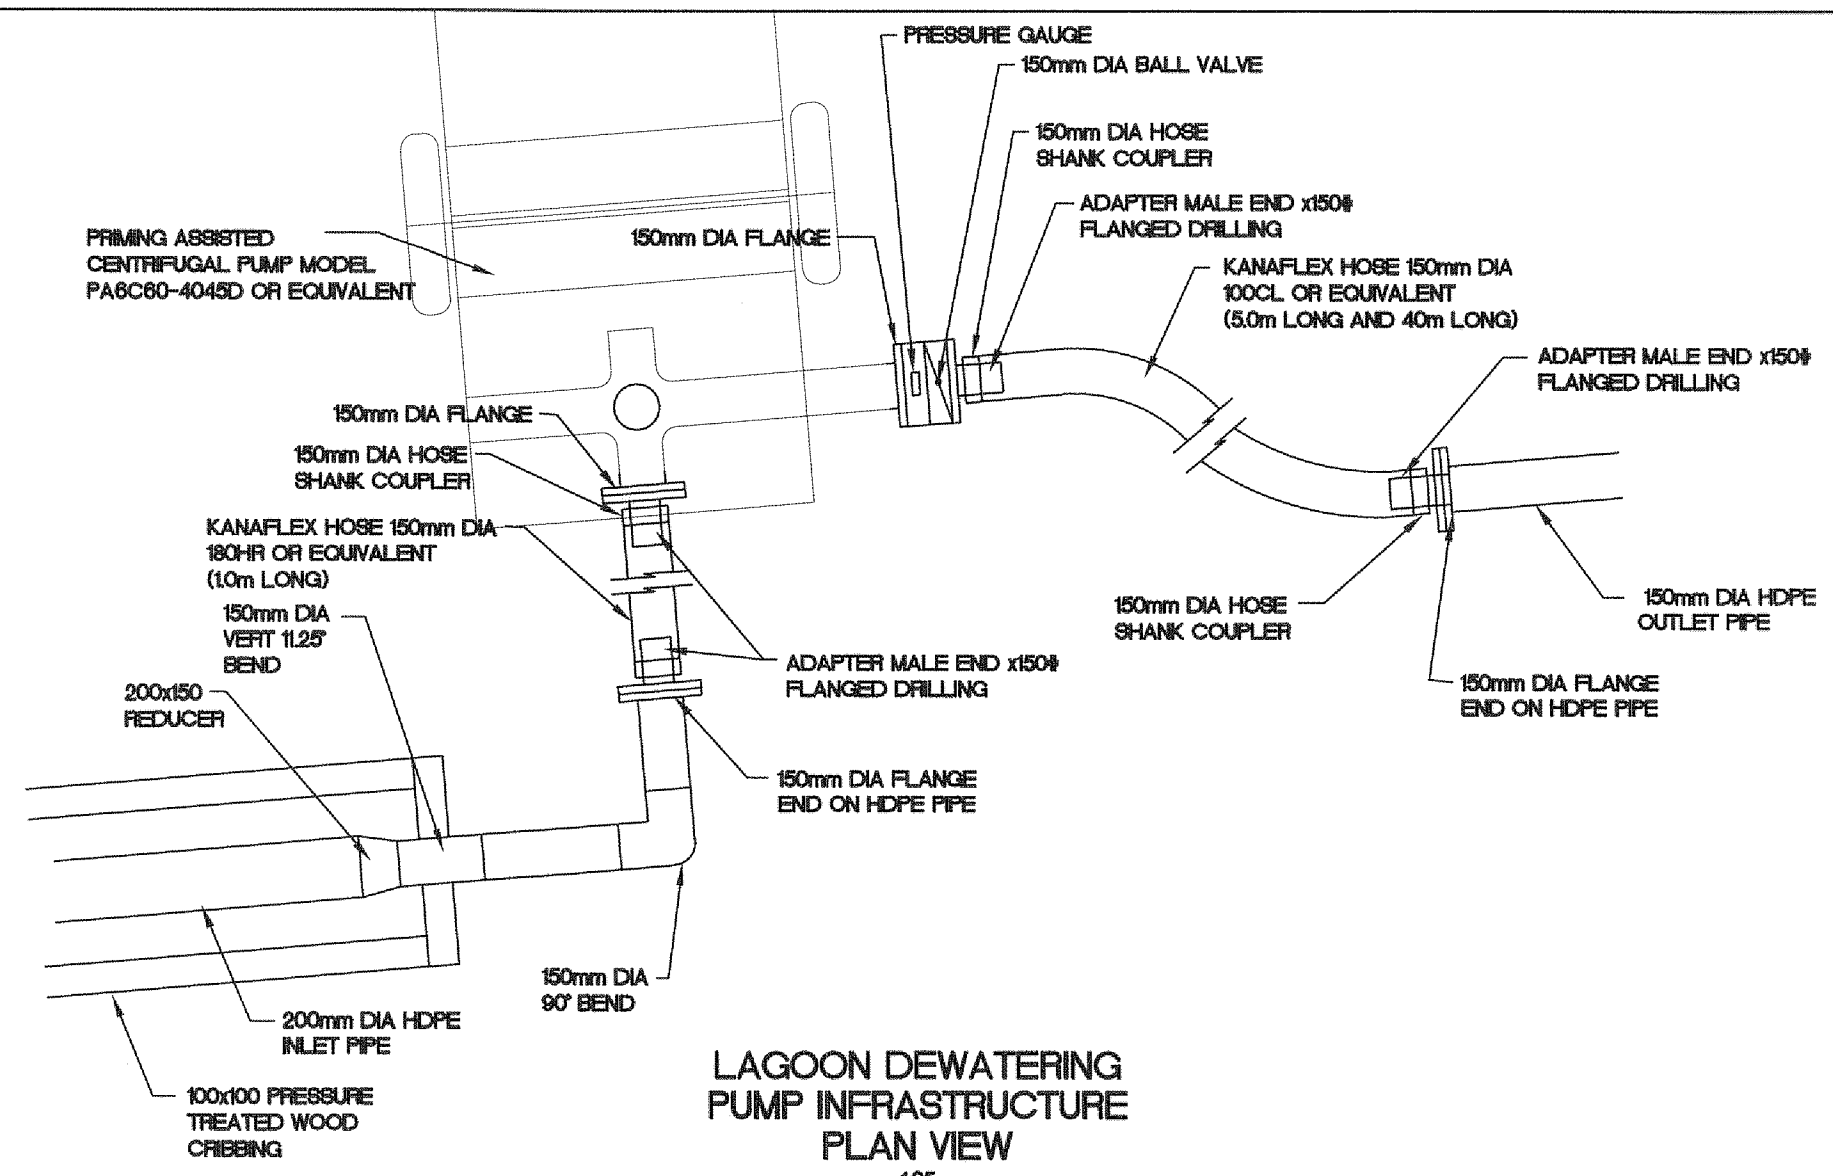

AS-CONSTRUCTED
2010

PERMIT OF PRACTICE
TROW ASSOCIATES INC.
Signature: *[Signature]*
Date: *Jan 19, 2011*
PERMIT NUMBER: P184
The Association of Professional Engineers
Geologists and Geophysicists of the NWT/NY



No.	DESCRIPTION	DATE	BY	APP'D
4	AS-CONSTRUCTED	02/12/10	MEB	SLB
3	ISSUED FOR CONSTRUCTION	15/06/09	MMR	SLB
2	REVISED FOR TENDER	28/05/08	MMR	SLB
1	ISSUED FOR TENDER	28/04/08	MMR	SLB

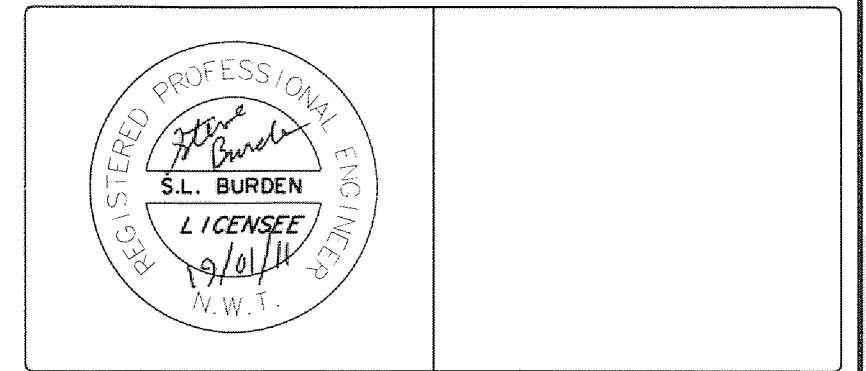

Trow Associates Inc.
100-2650 Queensview Drive Phone: (613) 688-1899
Ottawa, Ont. K2B 8H6 Fax: (613) 225-7337


CLIENT
GOVERNMENT OF NUNAVUT

PROJECT		CLYDE RIVER WASTE WATER LAGOON	
TITLE			
DETAILS			
design by	S.A.D.	project no.	OTCD19055A
drawn by	M.M.R.	drawing no.	DE-2
checked by	S.L.B.		
date	14/12/07		
scale	AS SHOWN		

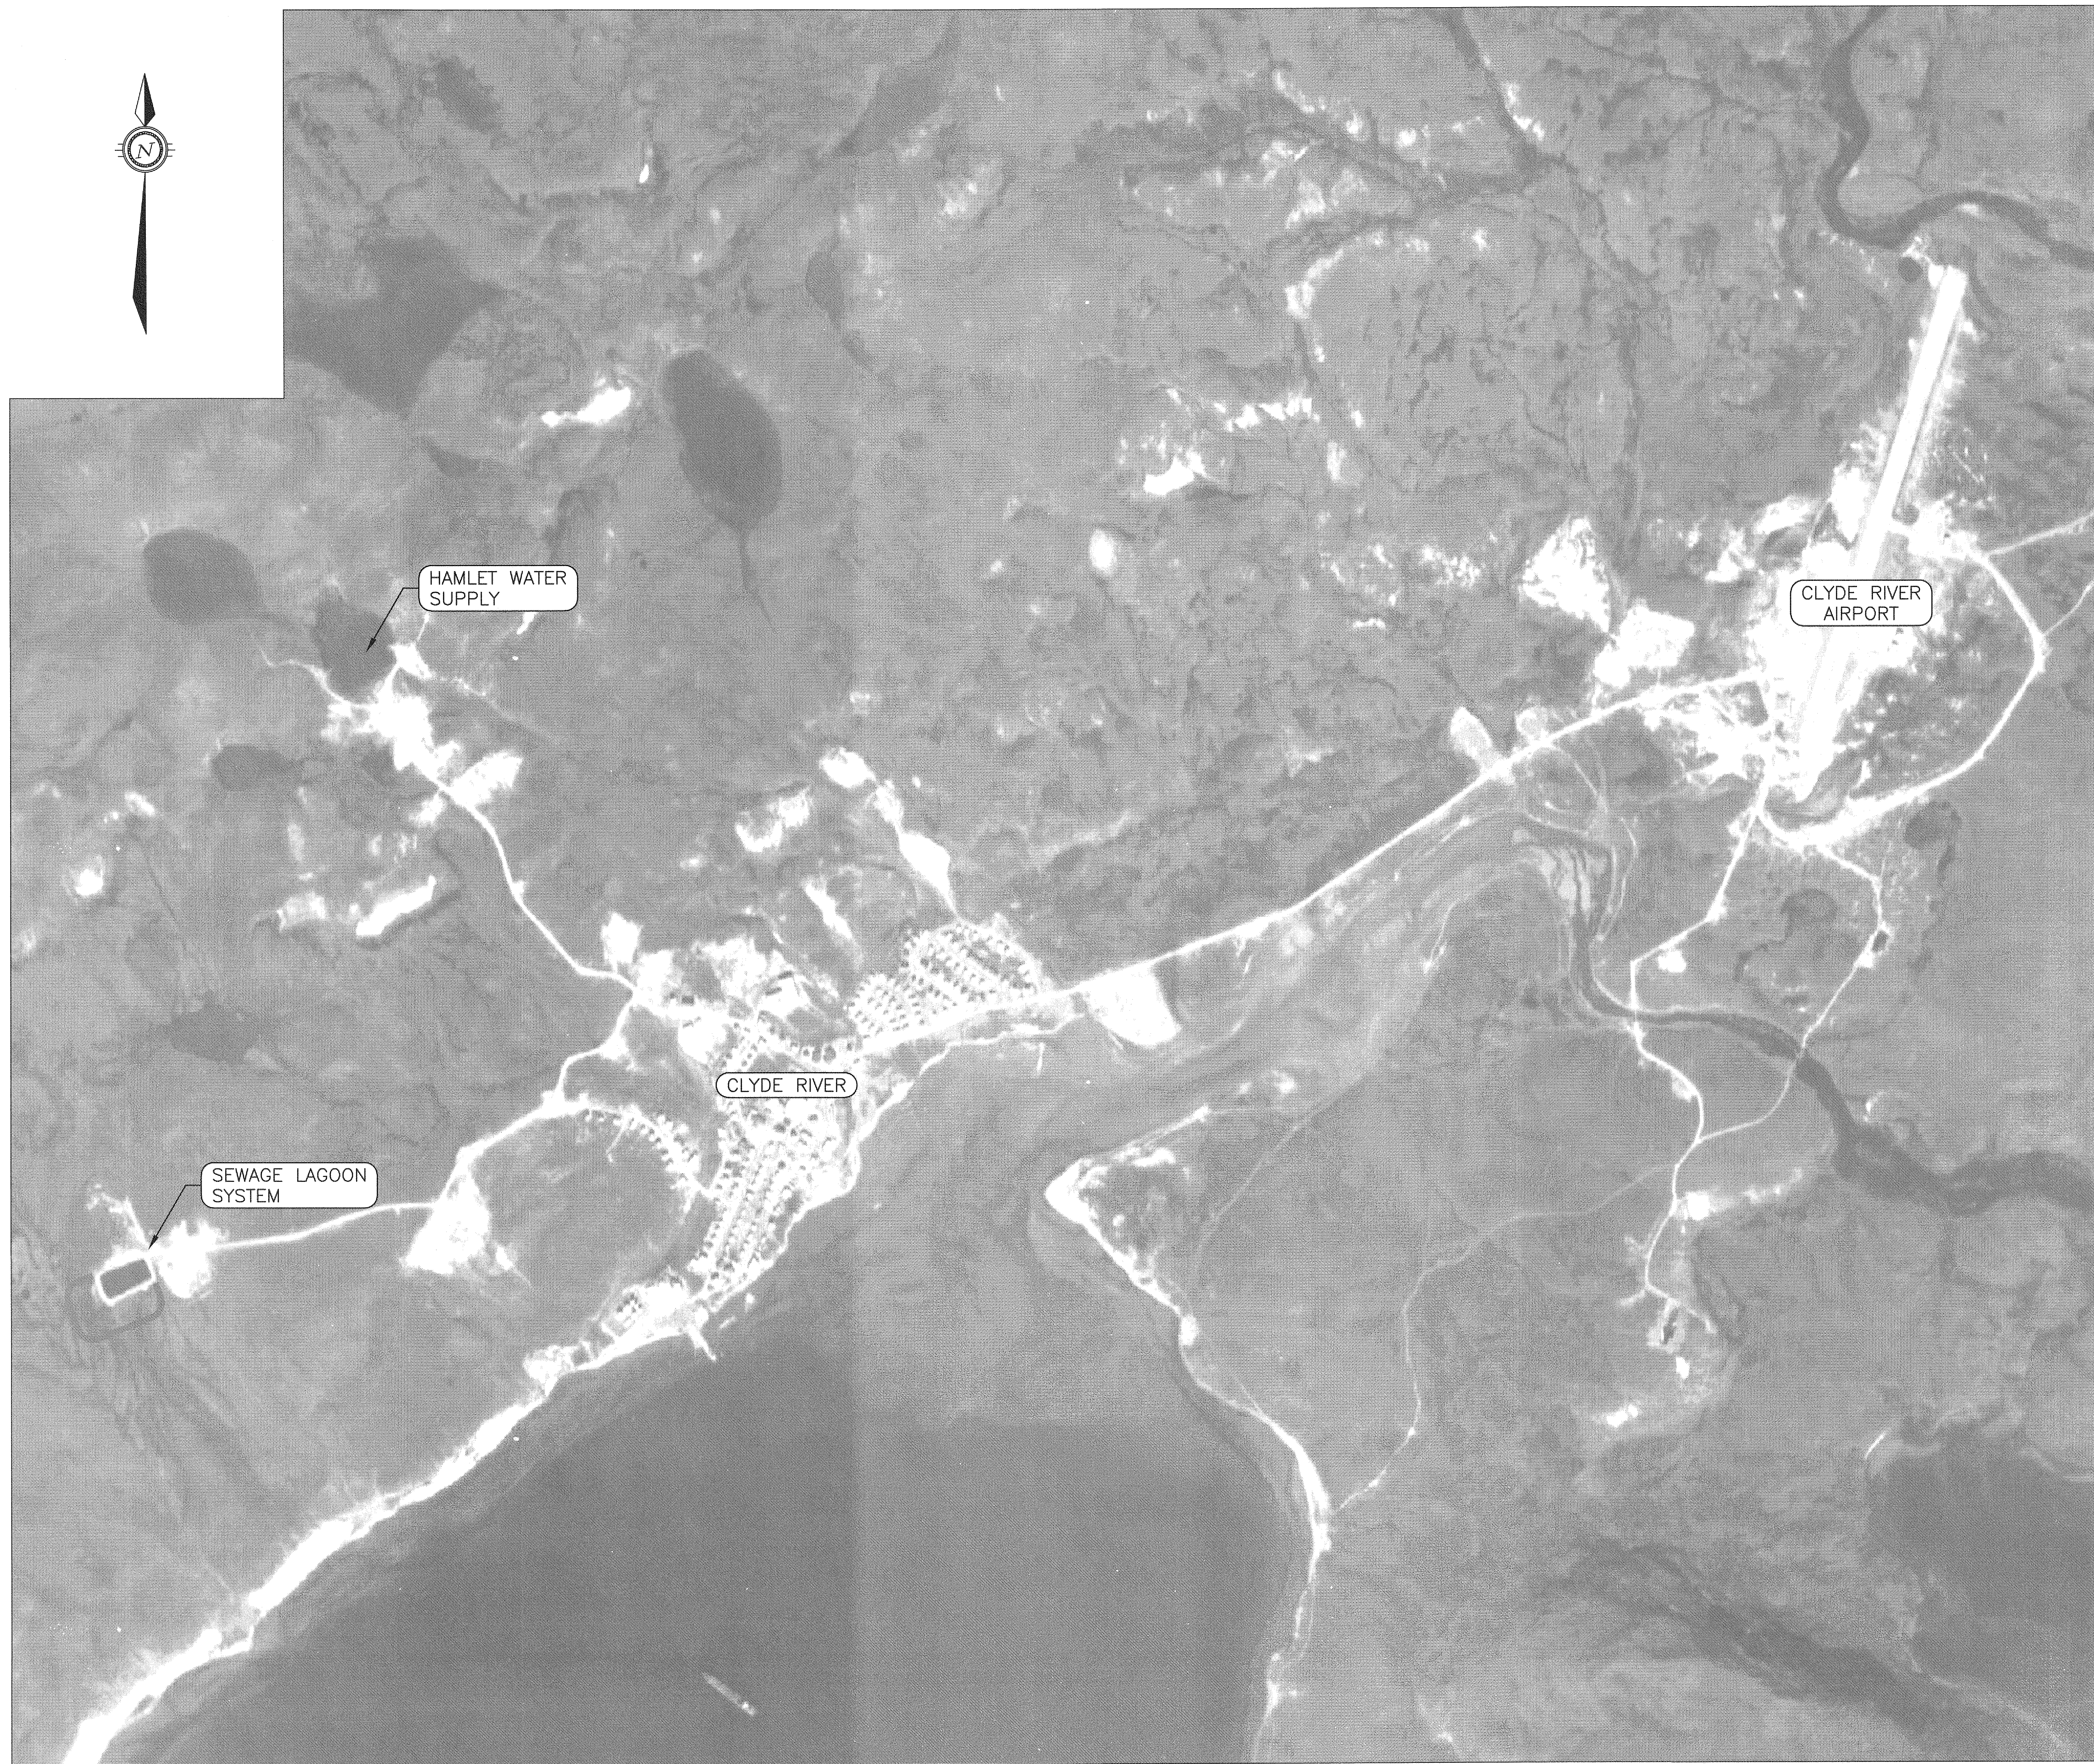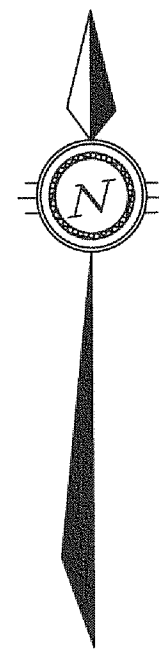

PERMIT OF PRACTICE
TROW ASSOCIATES INC.
Signature Slava Burden
Date Jan 19, 2011
PERMIT NUMBER: P184
The Association of Professional Engineers
Geologists and Geophysicists of the NWT/NU

1	AS-CONSTRUCTED	02/12/10	MEB	SLB
No.	DESCRIPTION	DATE	BY	APP'D
R E V I S I O N S				

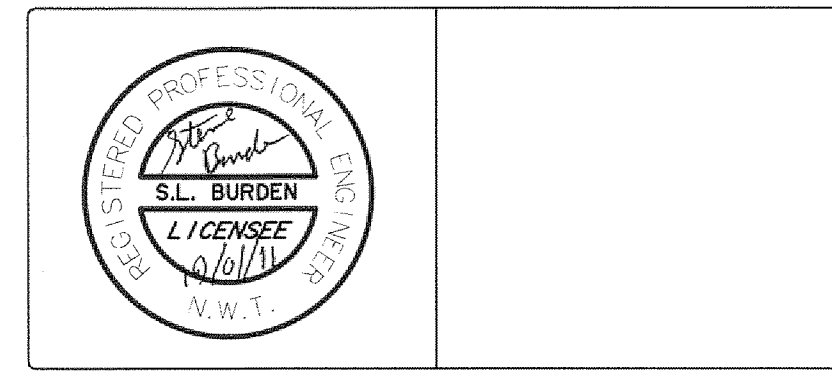

 **Trow Associates Inc.**
100-2650 Queensview Drive PHONE: (613) 688-1899
Ottawa, Ont. K2B 6H6 FAX: (613) 225-7337

CLIENT
GOVERNMENT OF NUNAVUT

PROJECT
CLYDE RIVER
WASTEWATER LAGOON
TITLE
CLYDE RIVER
MUNICIPAL LOCATION PLAN

design by	SAD	project no.	OTCD000190554
drawn by	MEB	drawing no.	T-1
checked by	SLB		
date	11/02/2008		
scale	HORIZ 1:5000		