
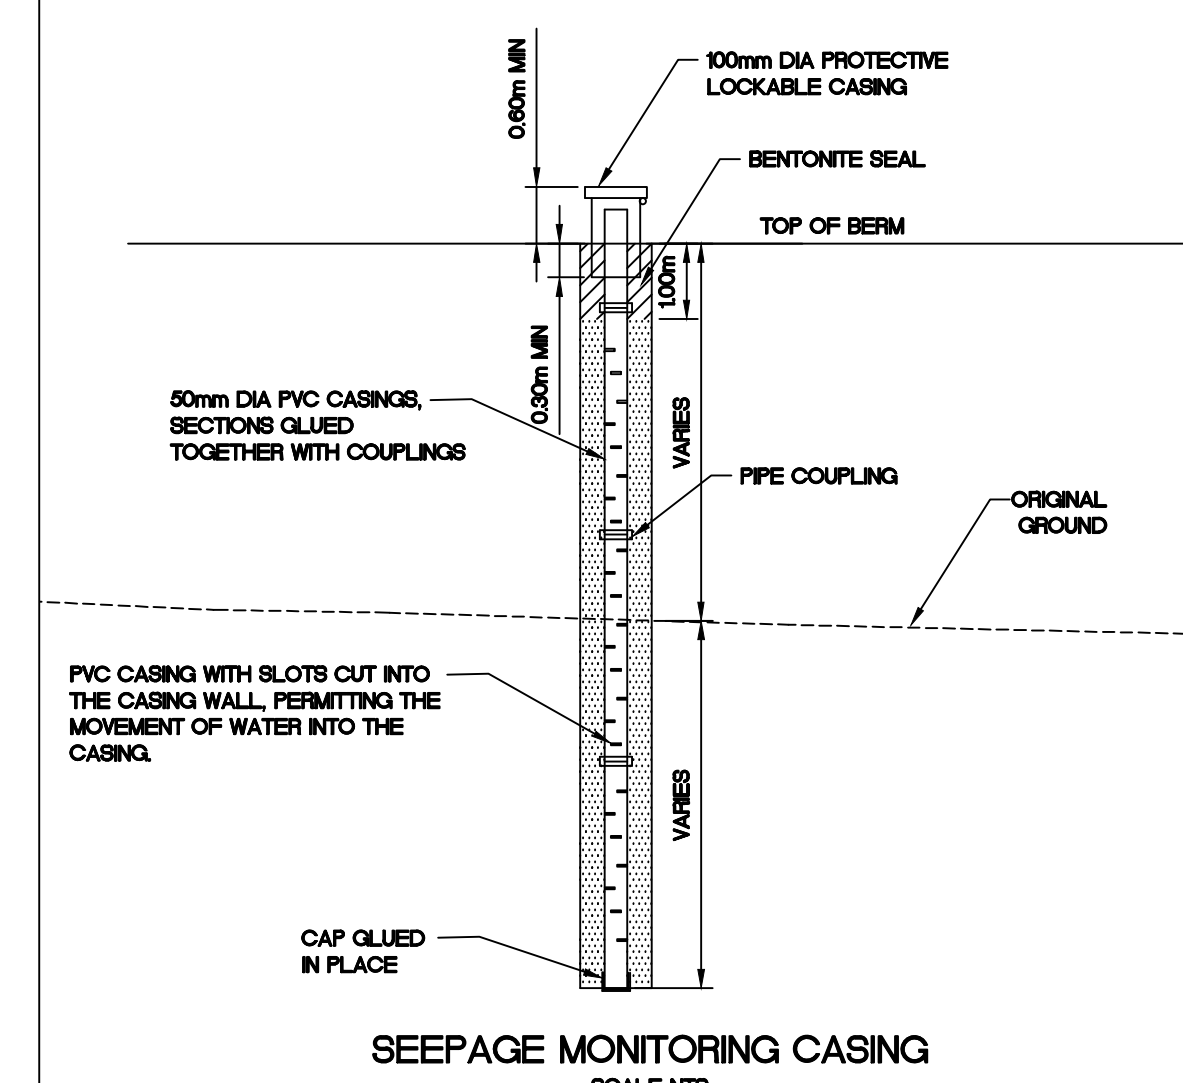
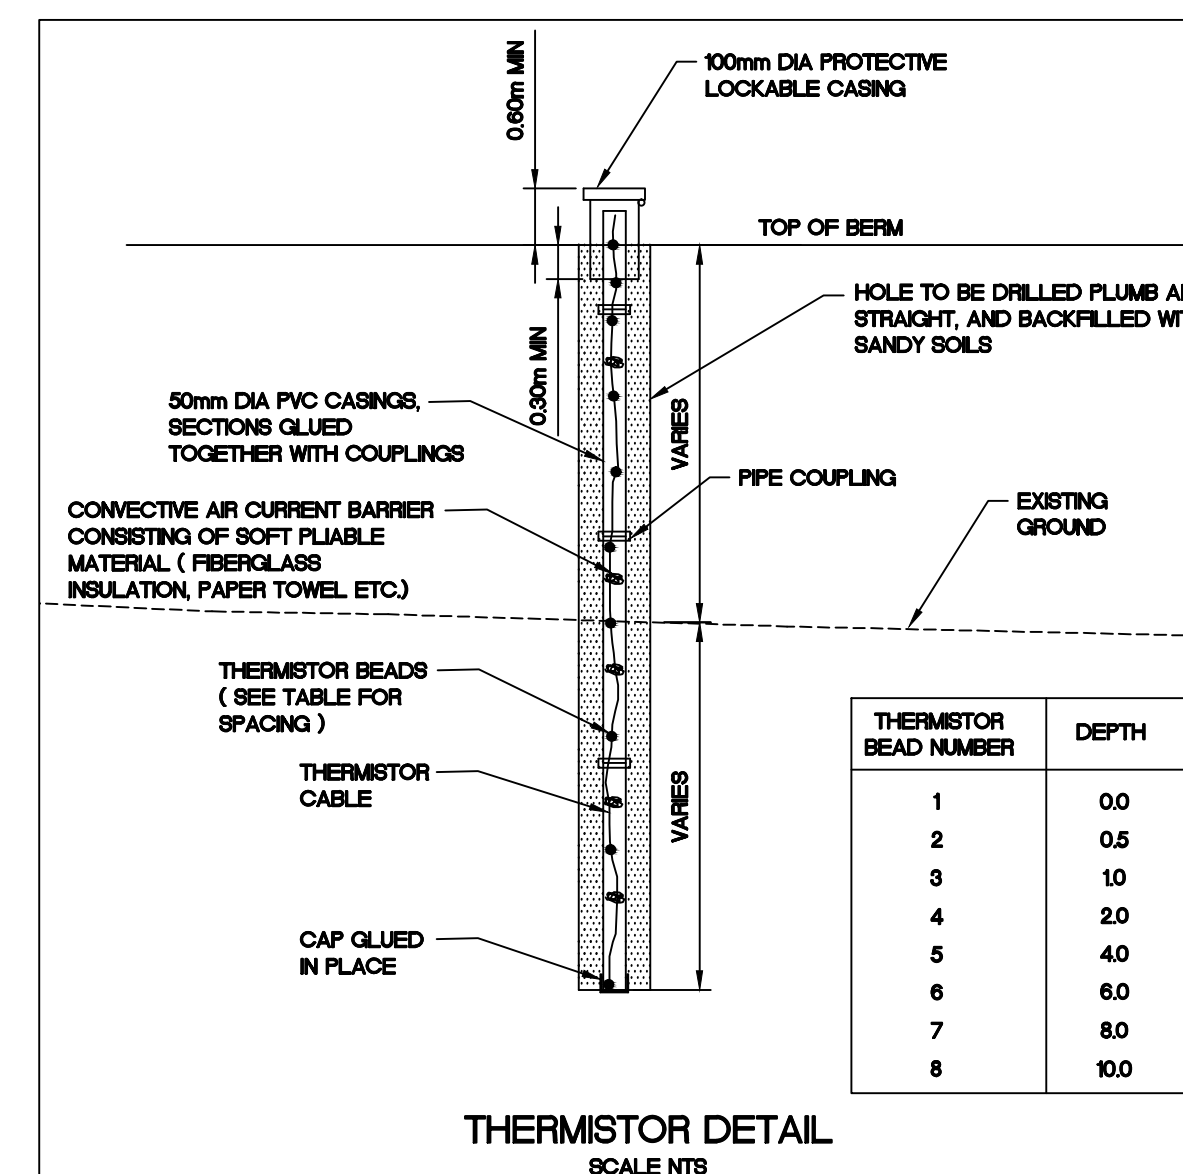
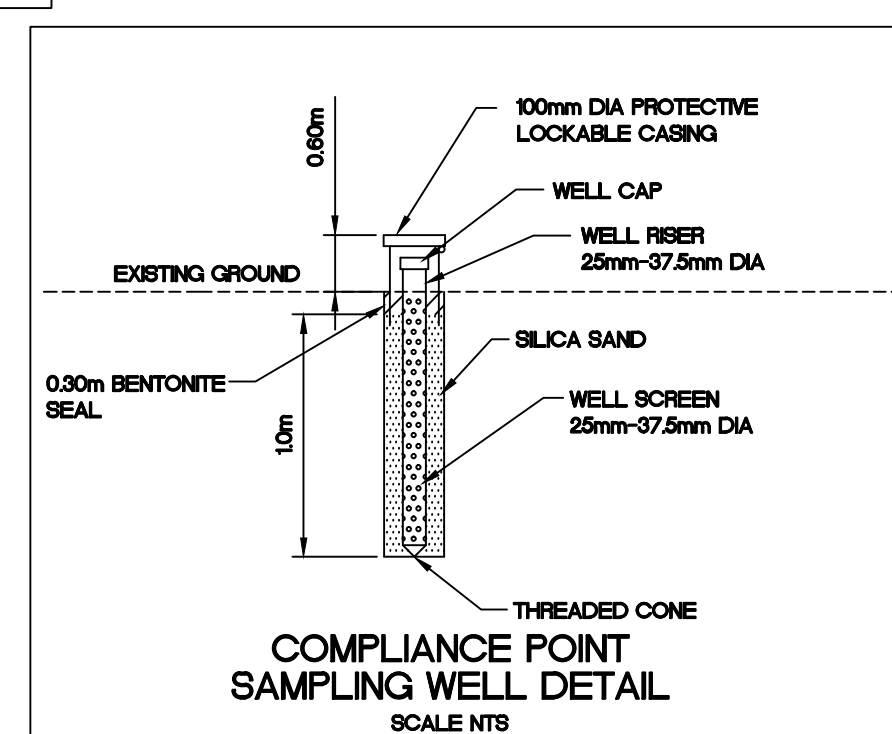
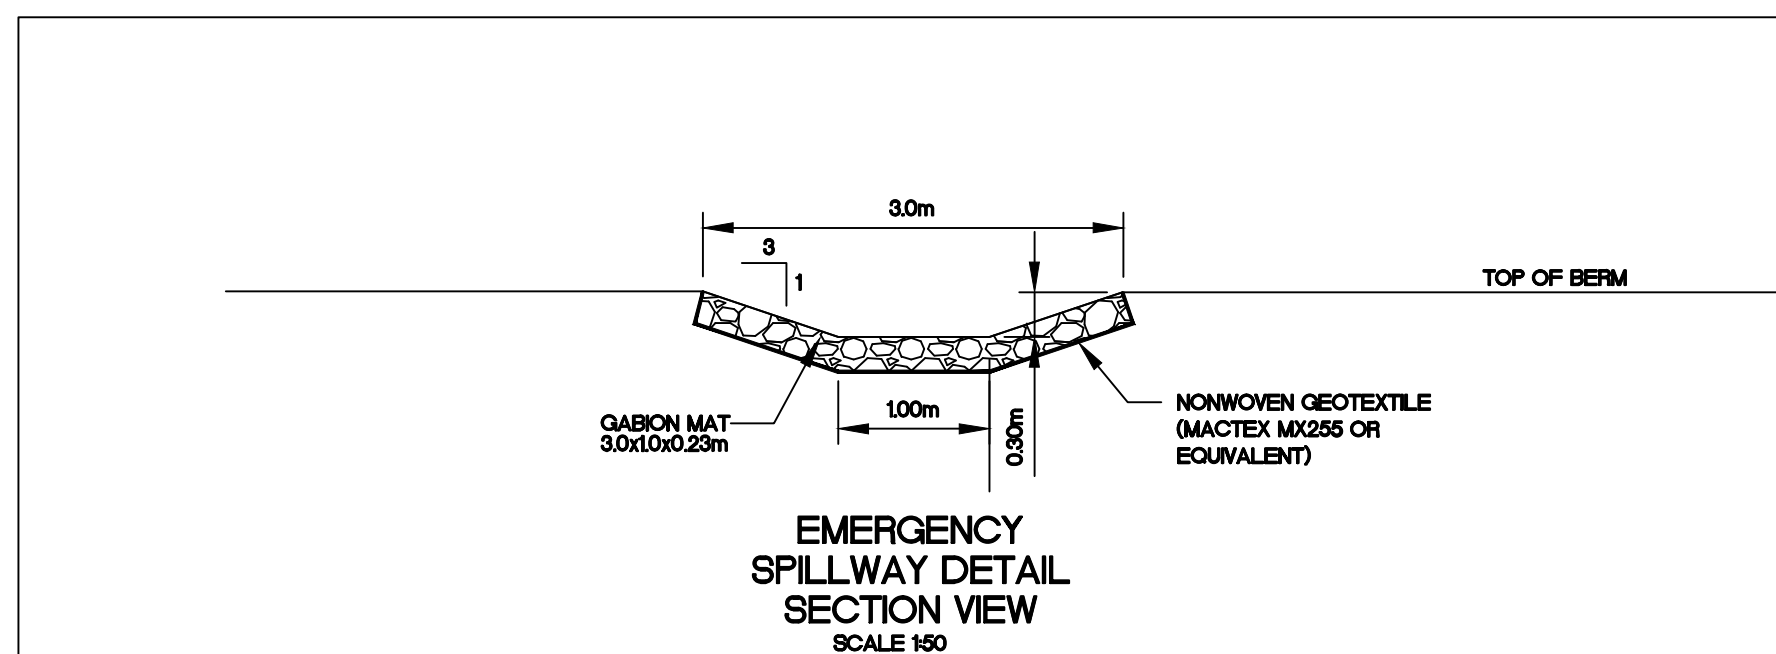
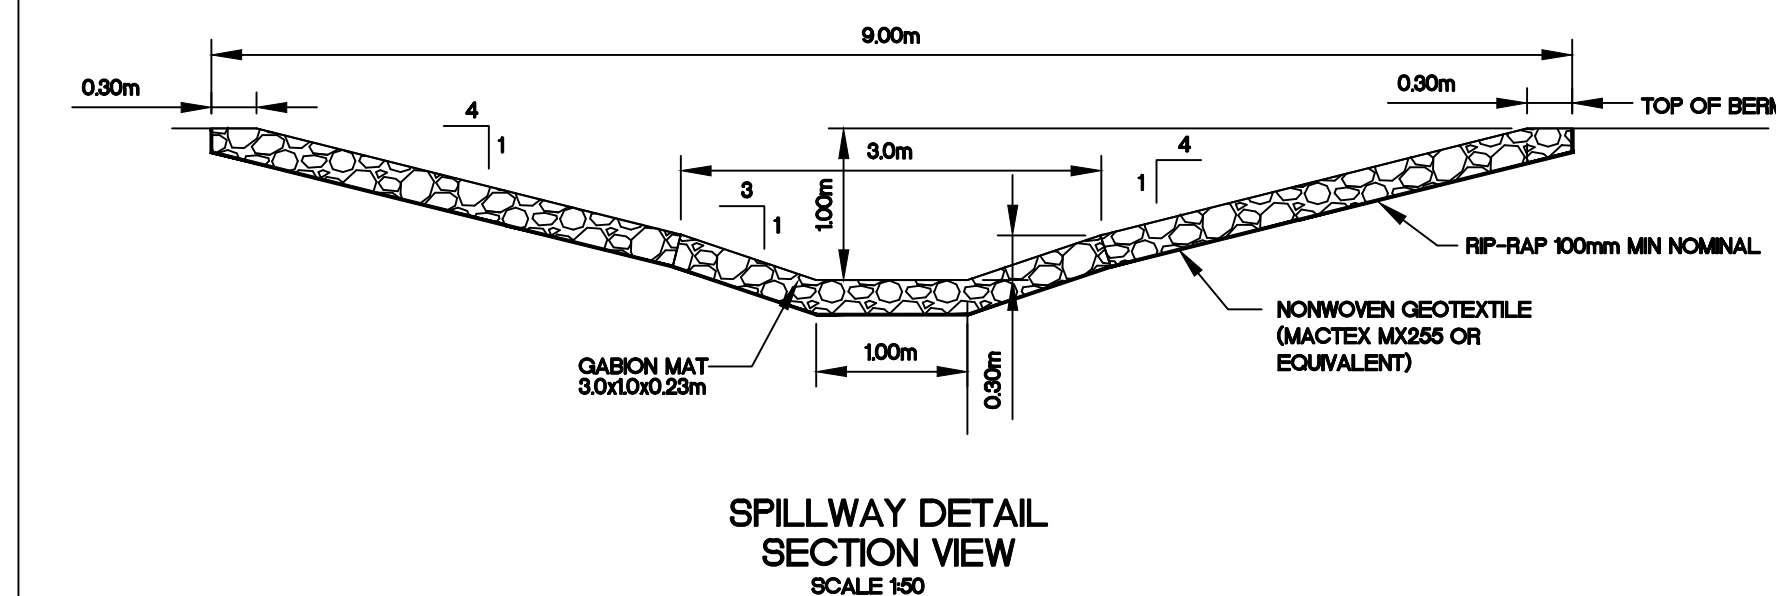
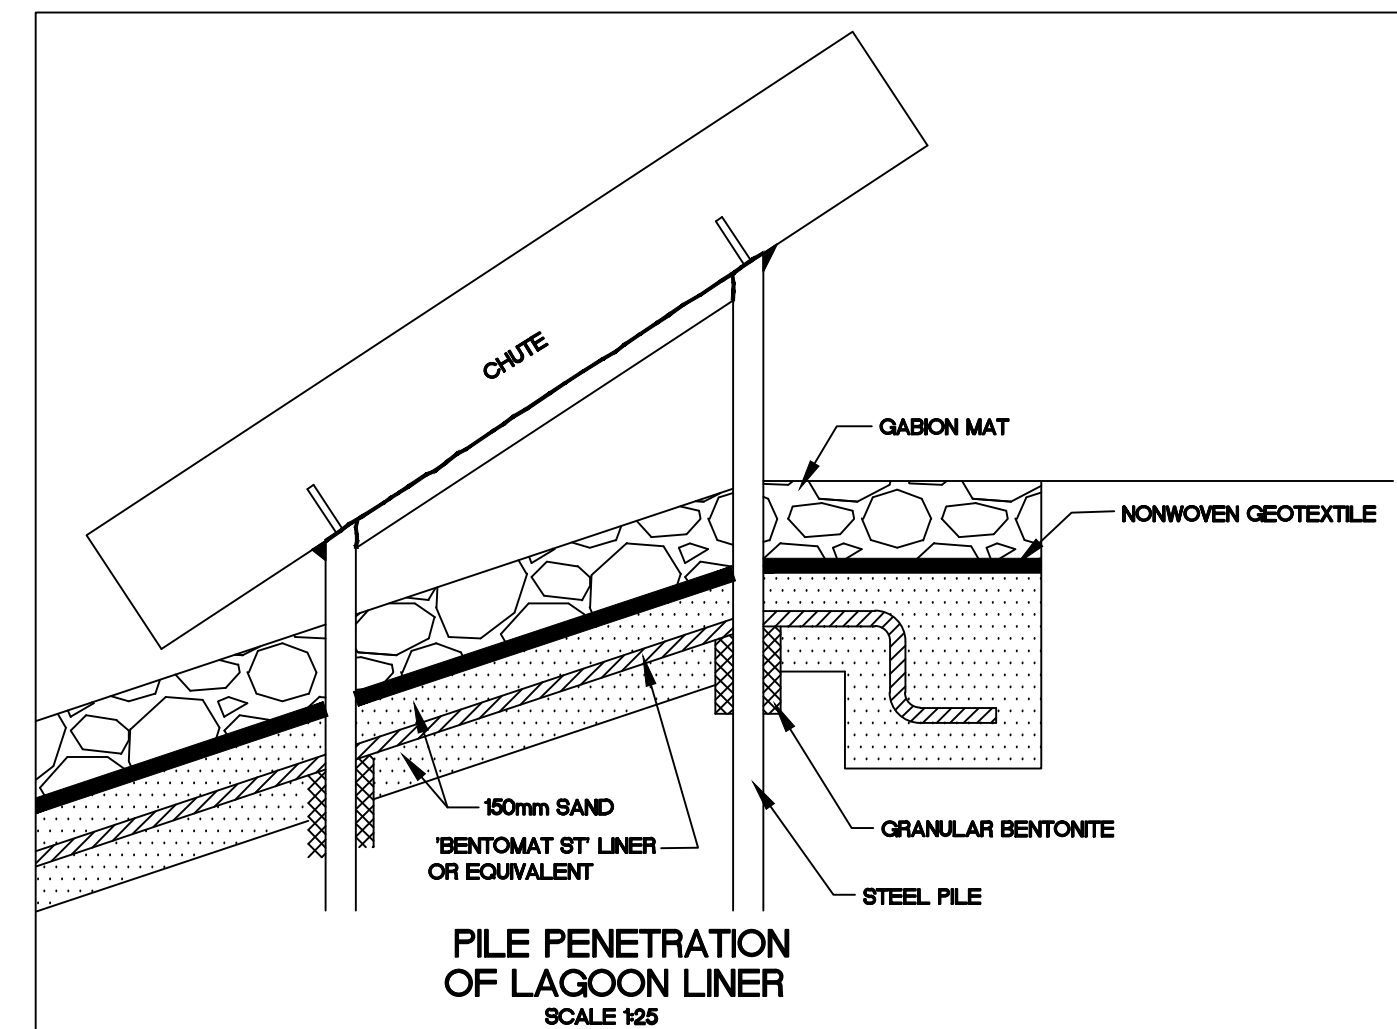
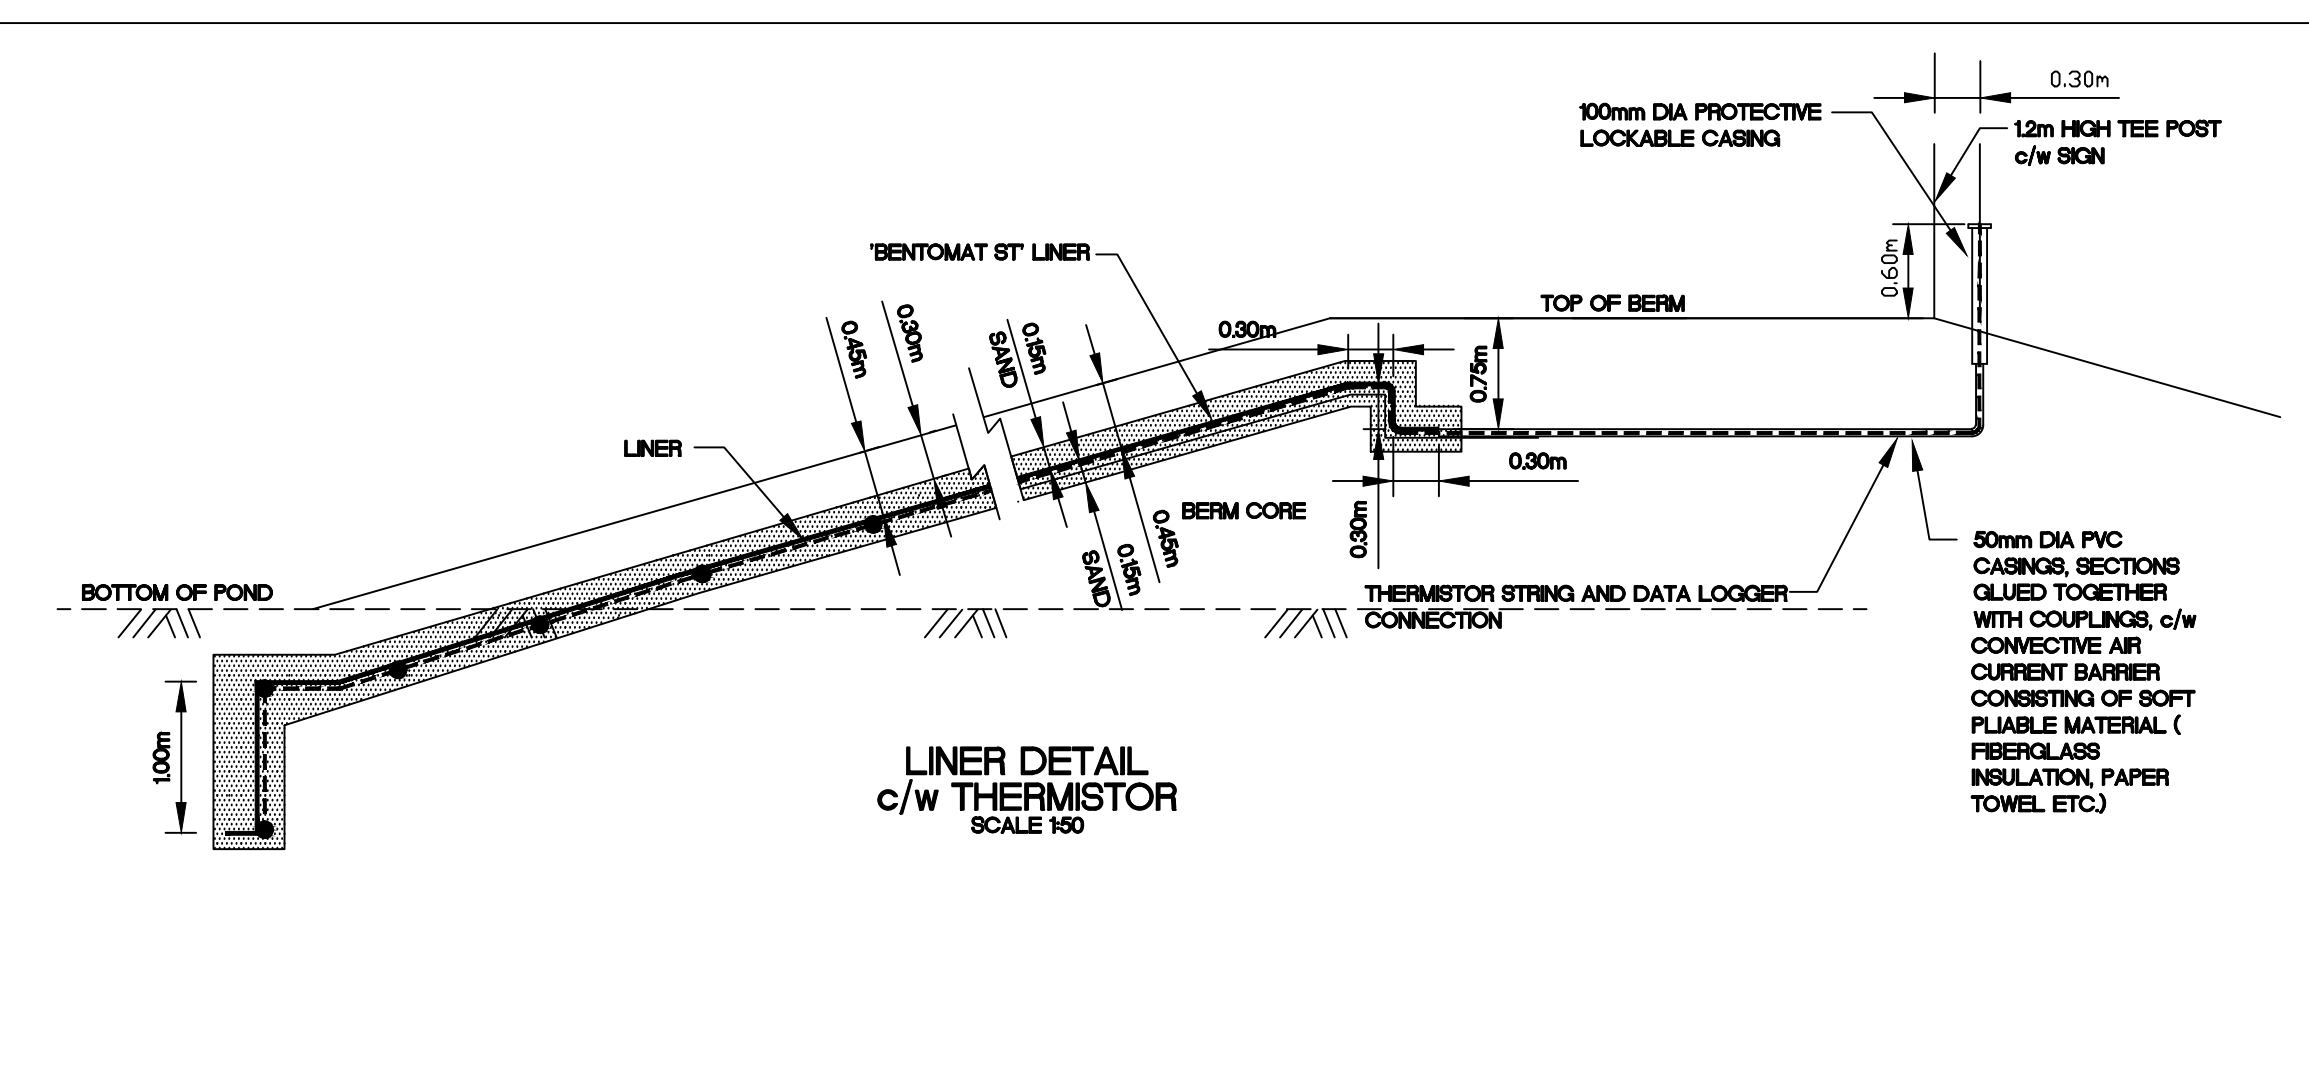
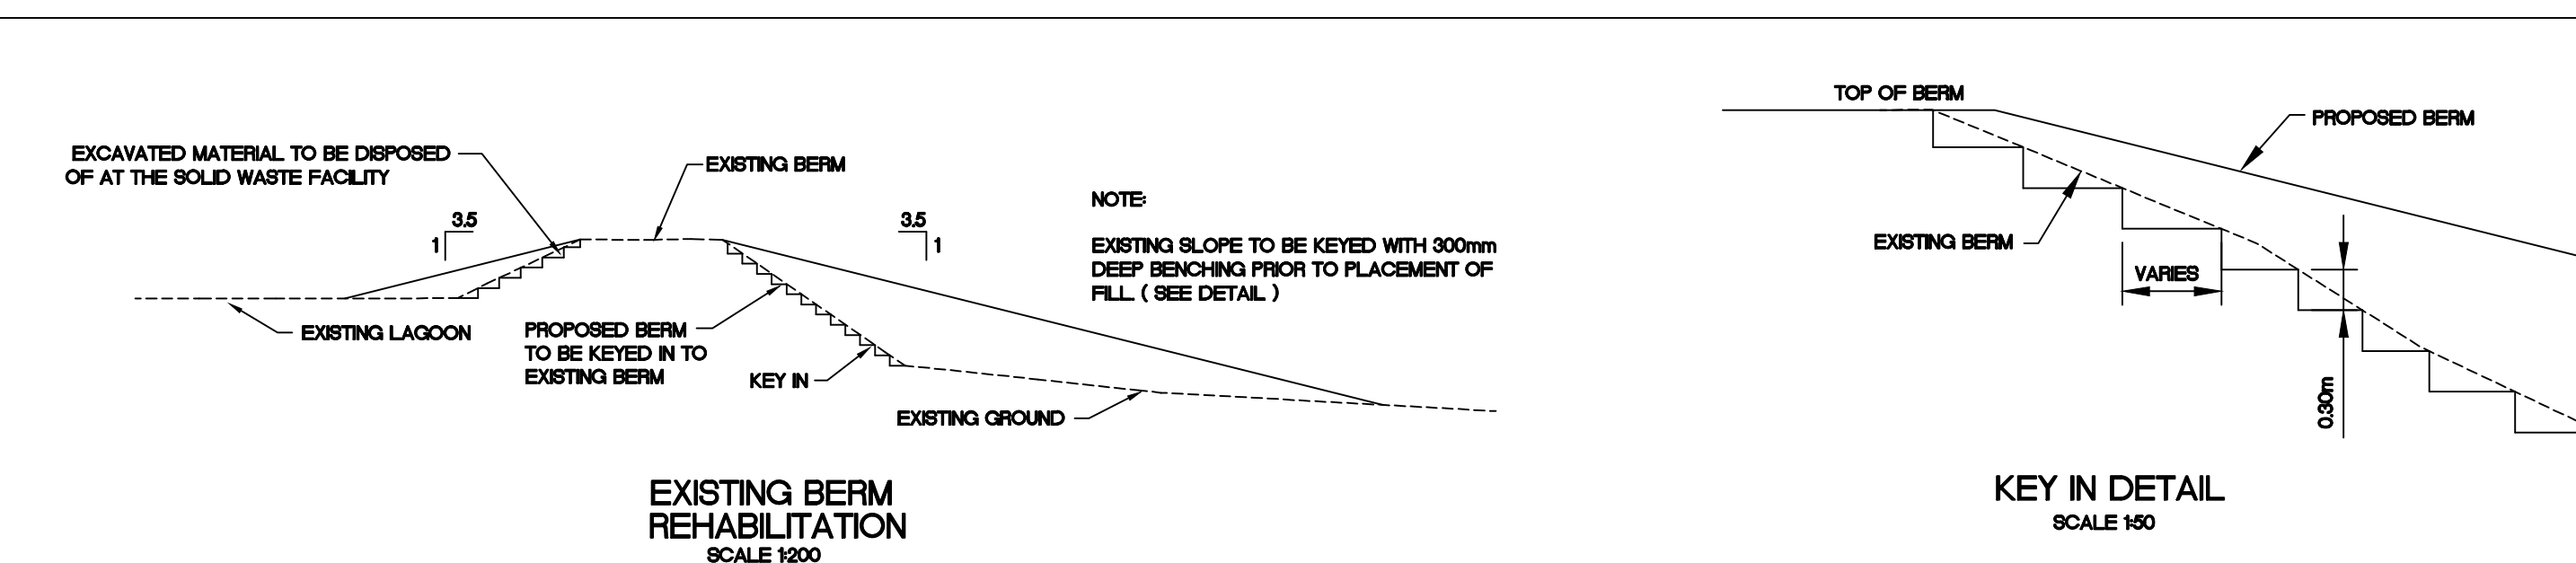
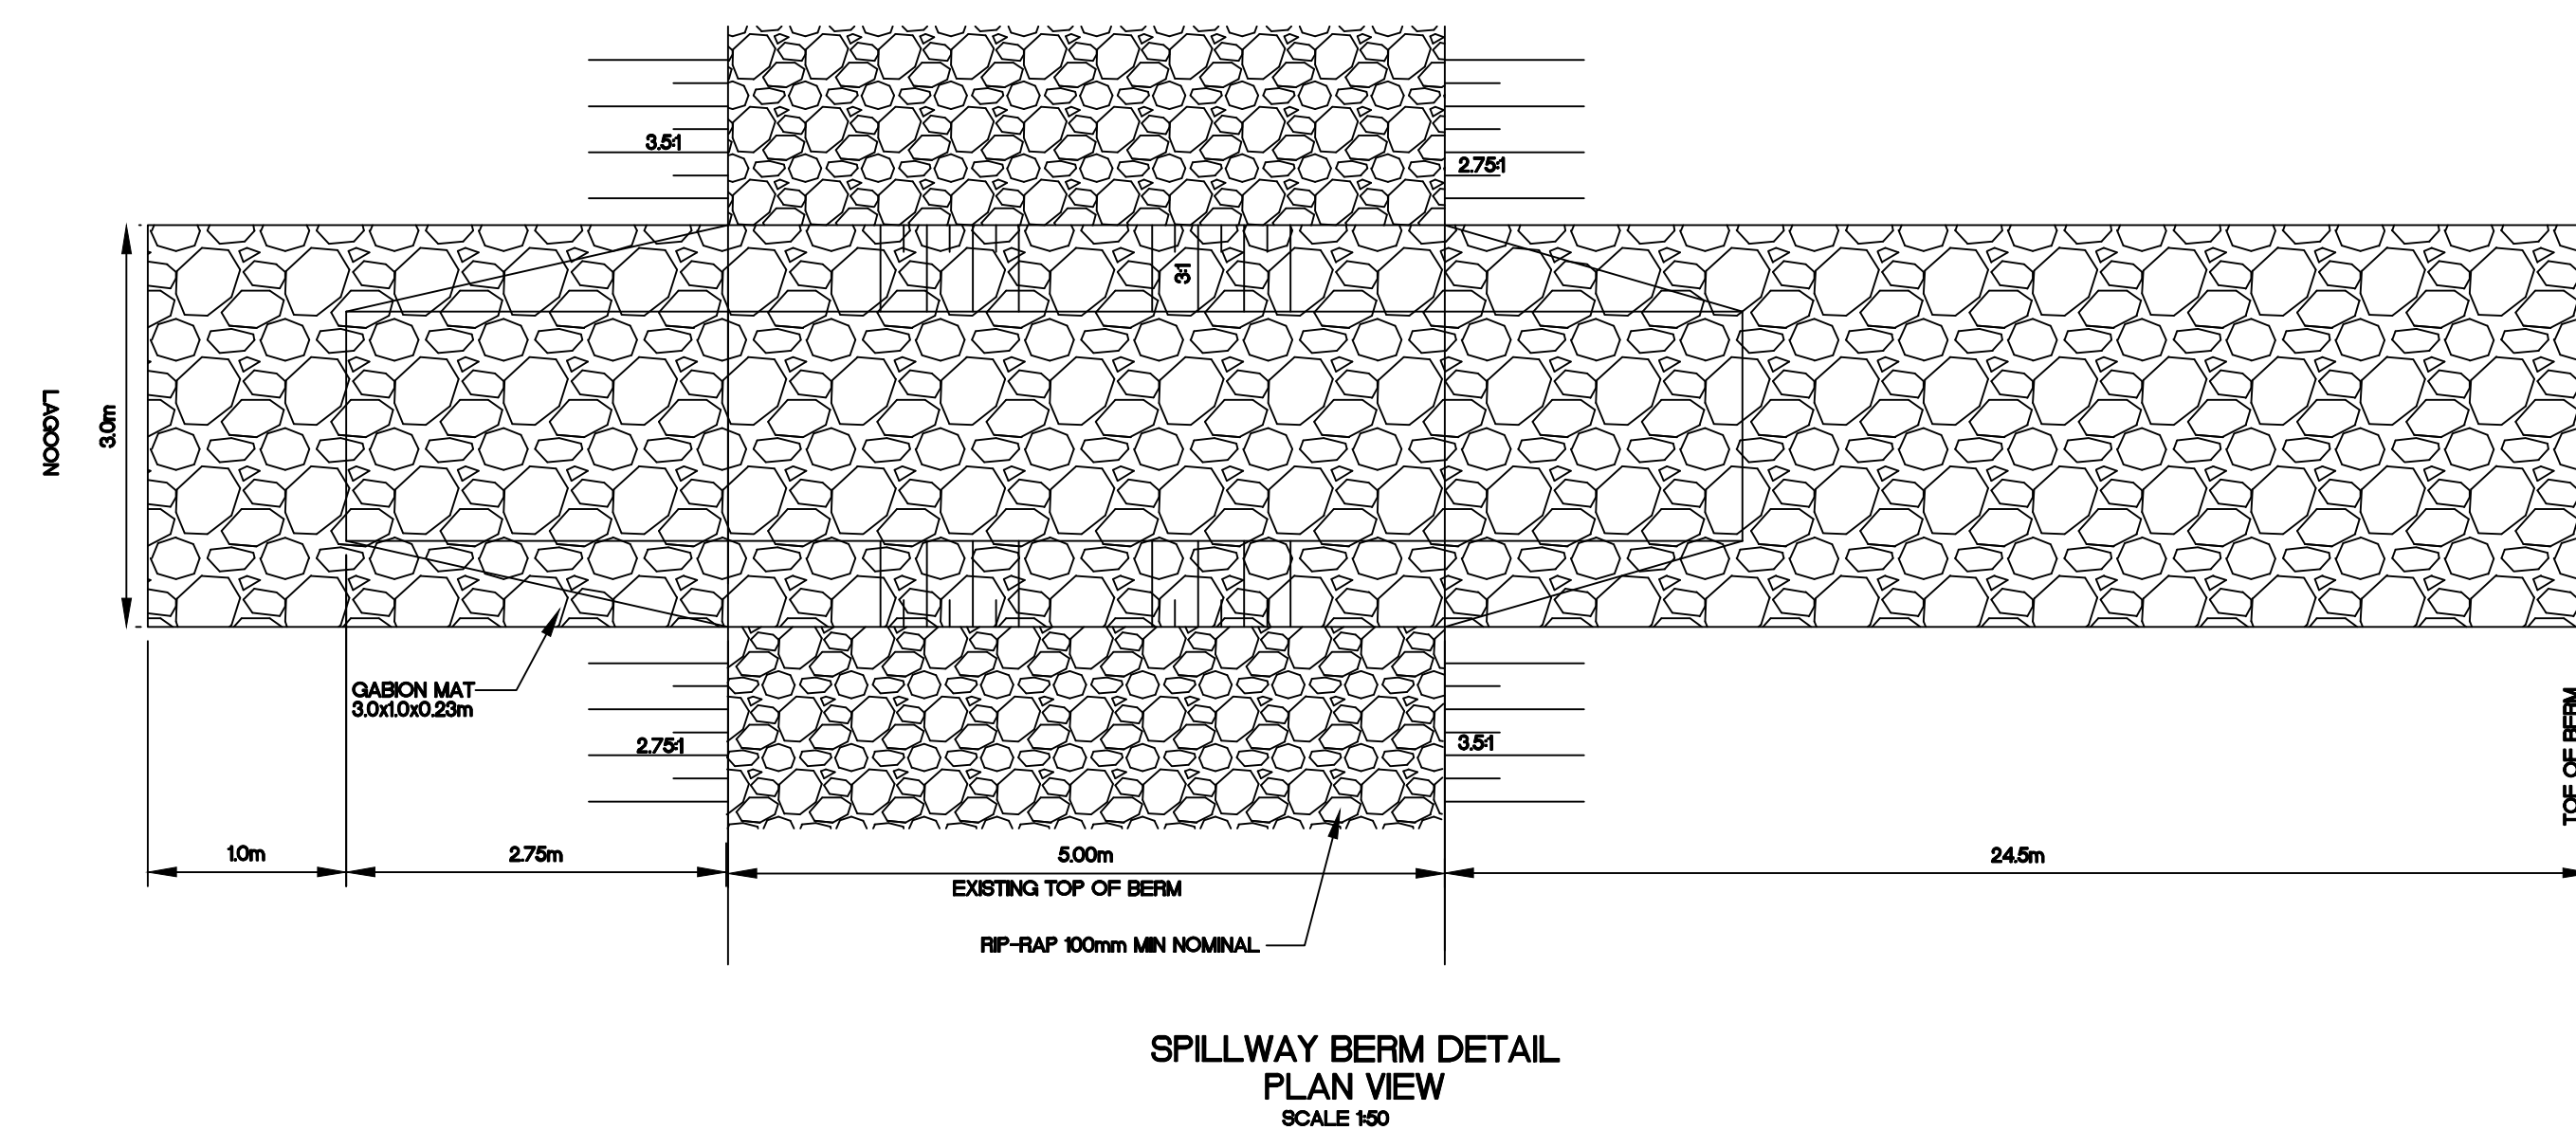


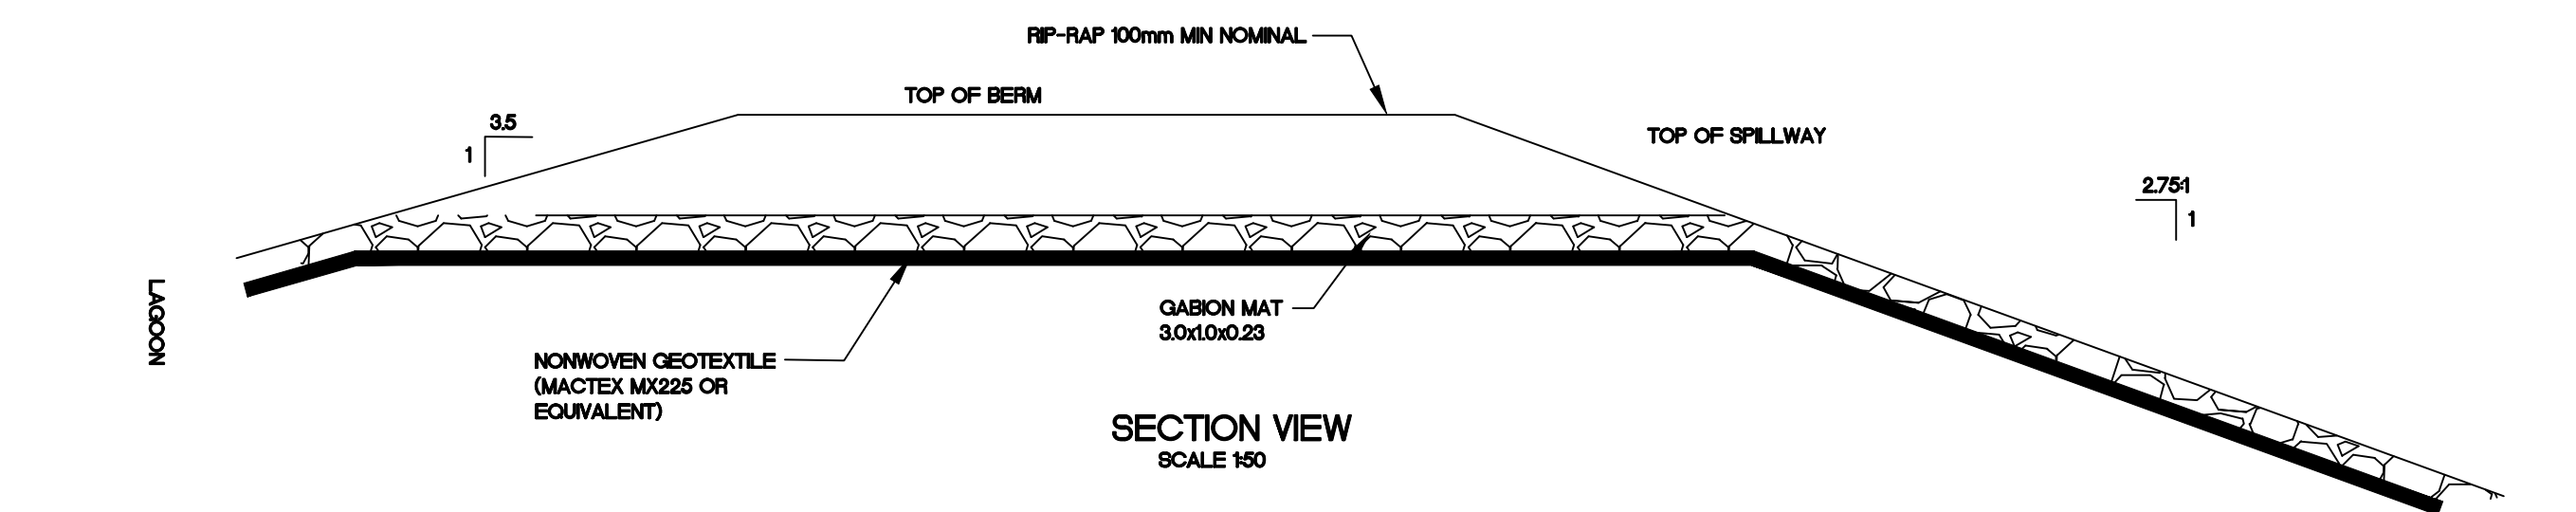

AS-CONSTRUCTED
2011

PERMIT OF PRACTICE
TROW ASSOCIATES INC.


Signature _____

Date _____

PERMIT NUMBER: P184

**The Association of Professional Engineers
Geologists and Geophysicists of the NWT/NU**

5	AS-CONSTRUCTED 2011	18/11/11	MEB	SLB	
4	AS-CONSTRUCTED	02/12/10	MEB	SLB	
3	ISSUED FOR CONSTRUCTION	15/06/09	MMR	SLB	
2	REVISED FOR TENDER	28/05/08	MMR	SLB	
1	ISSUED FOR TENDER	28/04/08	MMR	SLB	
No.	DESCRIPTION	DATE	BY	APP'D	
R E V I S I O N S					

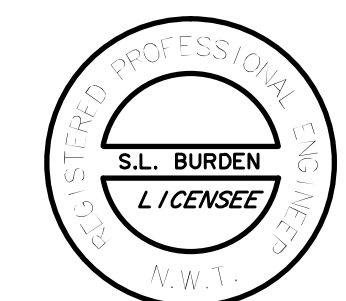

 **Trow** Associates Inc.

100-2650 Queensview Drive PHONE: (613) 688-1899
Ottawa, Ont. K2B 8H6 FAX: (613) 225-7337

CLIENT

GOVERNMENT OF NUNAVUT

PROJECT

CLYDE RIVER
WASTE WATER
LAGOON

DETAILS	
---------	--

design by	S.A.D.	project no. OTCD19055A drawing no. DE-1
drawn by	M.M.R.	
checked by	S.L.B.	
date	14/12/07	
scale	AS SHOWN	