AS-CONSTRUCTED
2011


PERMIT OF PRACTICE
TROW ASSOCIATES INC.


Signature _____

Date _____

PERMIT NUMBER: P184
 The Association of Professional Engineers
 Geologists and Geophysicists of the NWT/NU

5	AS--CONSTRUCTED 2011	18/11/11	MEB	SLB
4	AS--CONSTRUCTED	02/12/10	MEB	SLB
3	ISSUED FOR CONSTRUCTION	15/06/09	MMR	SLB
2	REVISED FOR TENDER	28/05/08	MMR	SLB
1	ISSUED FOR TENDER	28/04/08	MMR	SLB
No.	DESCRIPTION	DATE	BY	APP'D
R E V I S I O N S				

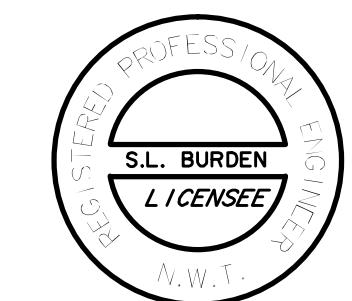

 **Trow** Associates Inc.
100-2650 Queensview Drive PHONE: (613) 688-1899
Ottawa, Ont. K2B 8H6 FAX: (613) 225-7337

CLIENT

GOVERNMENT OF NUNAVUT

PROJECT	CLYDE RIVER WASTE WATER LAGOON
---------	--------------------------------------

DETAILS

design by	S.A.D.	project no. OTCD19055A drawing no. <div style="color: red; font-size: 2em; font-weight: bold;">DE-2</div>
drown by	M.M.R.	
checked by	S.L.B.	
date	14/12/07	
scale	AS SHOWN	