



# GOVERNMENT OF NUNAVUT

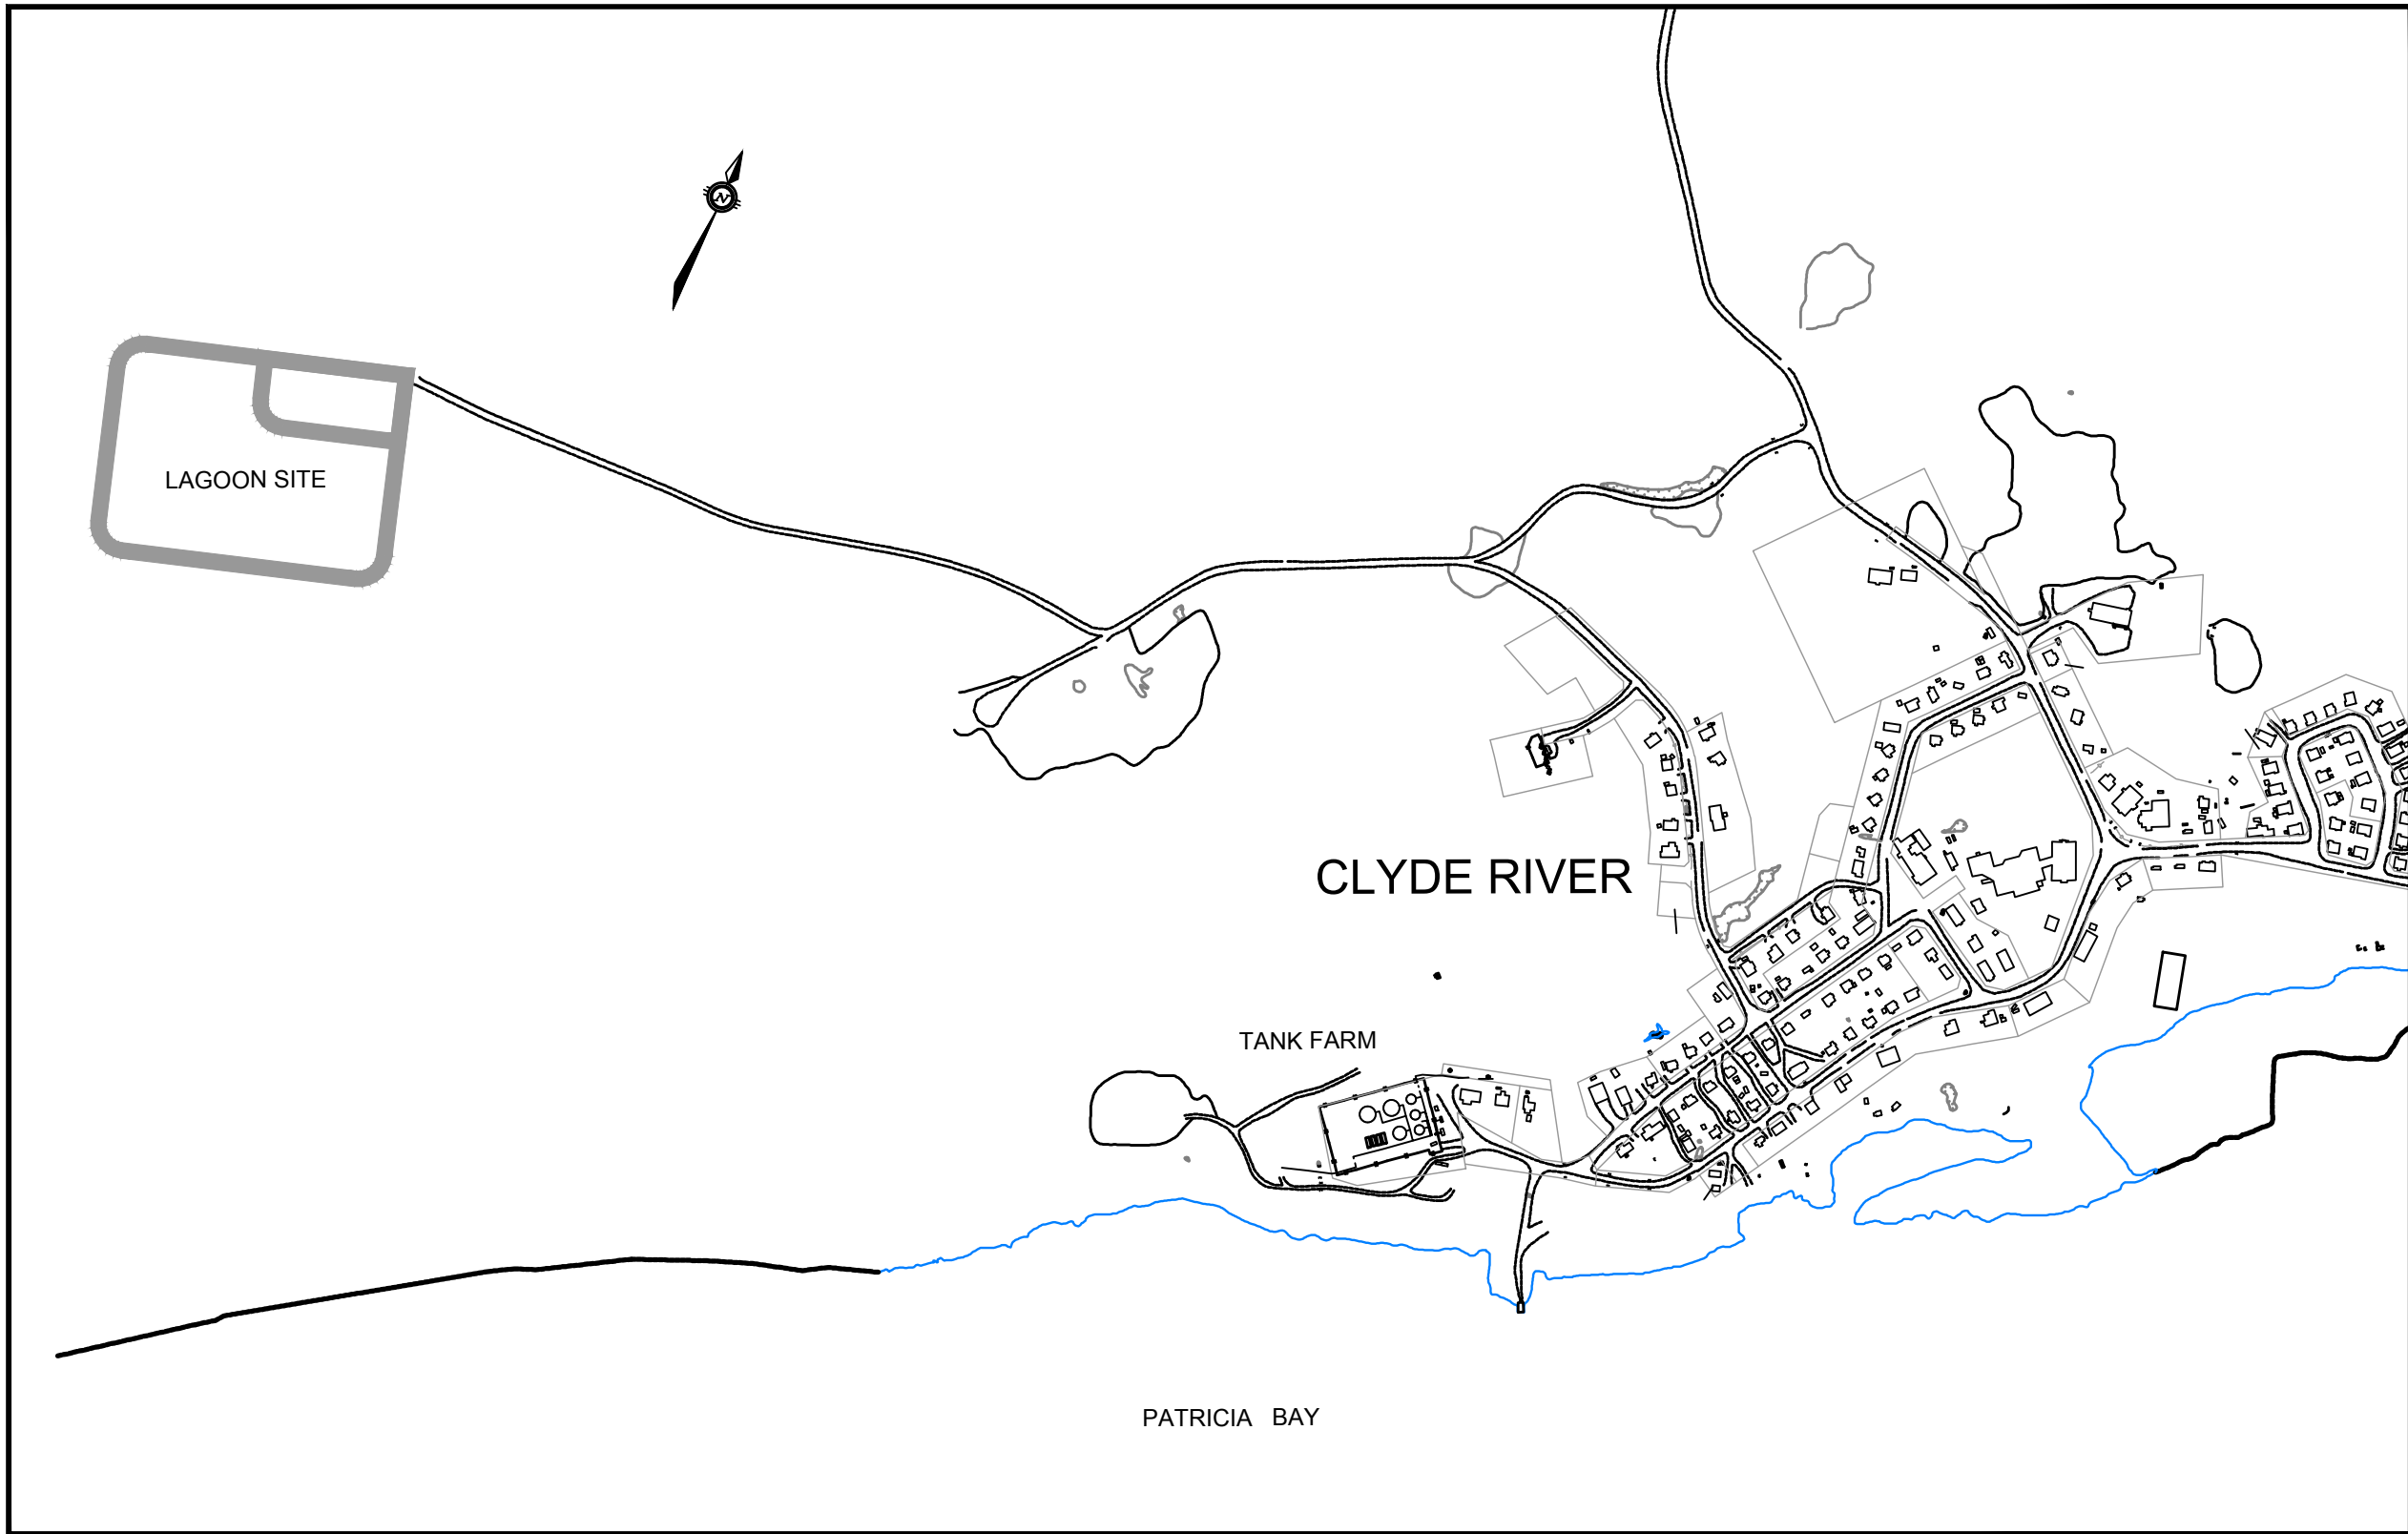

INDEX OF INCLUDED DRAWINGS

DRAWING NO.	REVISION	DESCRIPTION
		COVER
OTCD00019055A-SP1	REV 6	OVERALL SITE PLAN
OTCD00019055A-SP2	REV 6	SITE PLAN
OTCD00019055A-TD1	REV 7	TRUCK DISCHARGE SITE PLANS
OTCD00019055A-DE1	REV 6	DETAILS
OTCD00019055A-DE2	REV 6	DETAILS
OTCD00019055A-T1	REV 3	MUNICIPAL LOCATION PLAN

## CLYDE RIVER WASTEWATER LAGOON (NEW SEWAGE LAGOON AND REHABILITATE EXISTING LAGOON)

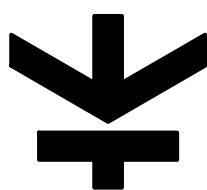

Trow Associates Inc.

100-2650 Queensview Drive  
Ottawa, Ont. K2B 8H6

PHONE: (613) 688-1899  
FAX: (613) 225-7337

**AS-BUILT**

DATE: DECEMBER 31st, 2011

AS-BUILT INFORMATION PROVIDED BY KUDLIK CONSTRUCTION LTD. OCTOBER 25 2011